
**LAYOUT - ST185-AB-cabin - top view, front of the car to the RIGHT, driver side UP (R140 / R153). Not to scale; lengths in mm (estimates until measured at the car).**

Each segment: length | wires in it | DR-25 heat-shrink size for its bundle (est. from the wire ODs). Lengths per wire (path + 100 mm at each end) are in the pinout table.

^ DRIVER SIDE (LH) at the top / PASSENGER SIDE (RH) at the bottom v

FRONT -->

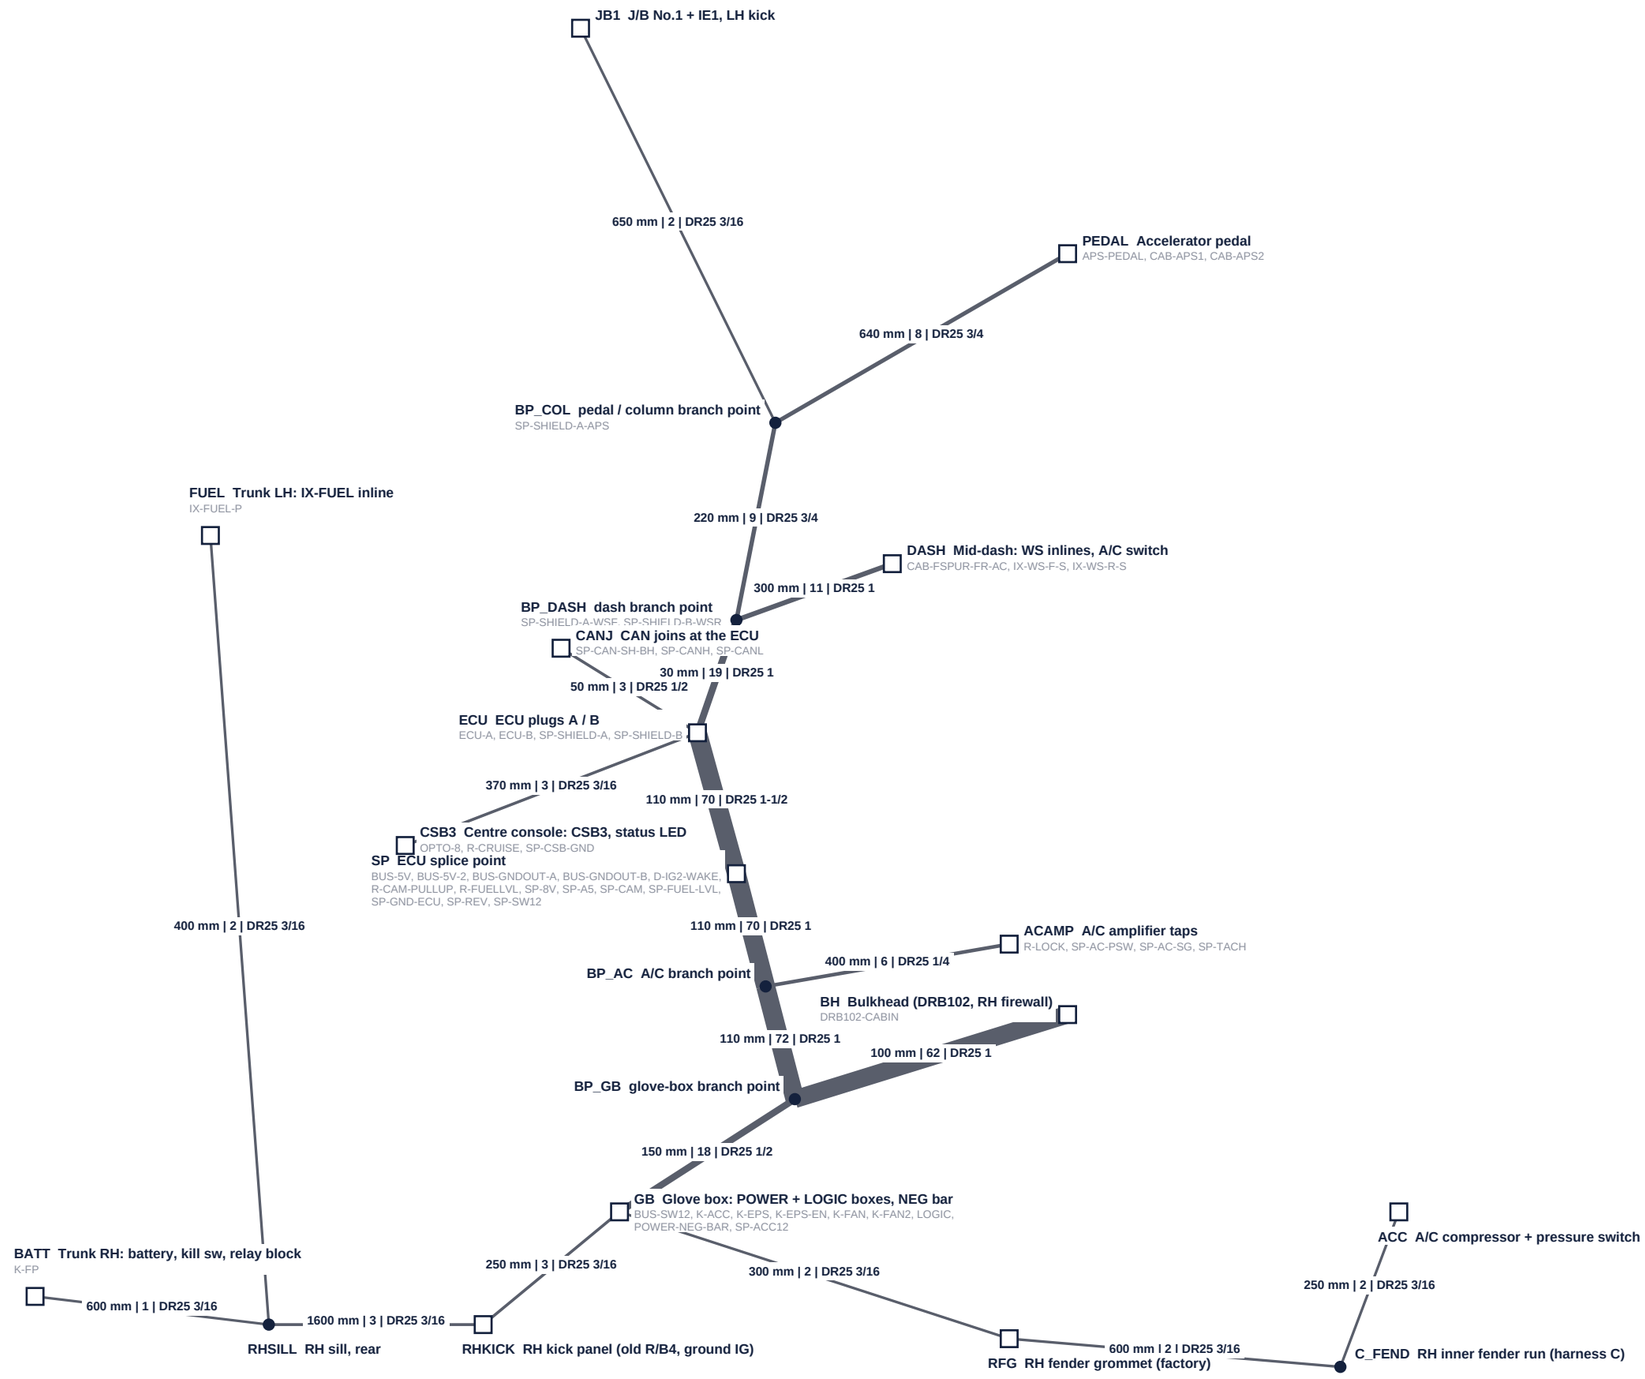


## SEGMENTS

| FROM | TO | MM | WIRES | BUNDLE | DR-25 |
|---|---|---|---|---|---|
| ECU | SP | 110 | 70 | 23.6 | DR-25-1-1/2-0 |
| SP | BP_AC | 110 | 70 | 19.0 | DR-25-1-0 |
| BP_AC | BP_GB | 110 | 72 | 19.2 | DR-25-1-0 |
| BP_GB | BH | 100 | 62 | 17.8 | DR-25-1-0 |
| BP_GB | GB | 150 | 18 | 10.0 | DR-25-1/2-0 |
| GB | RHKICK | 250 | 3 | 3.5 | DR-25-3/16-0 |
| RHKICK | RHSILL | 1600 | 3 | 3.5 | DR-25-3/16-0 |
| RHSILL | FUEL | 400 | 2 | 2.7 | DR-25-3/16-0 |
| BP_AC | ACAMP | 400 | 6 | 4.8 | DR-25-1/4-0 |
| ECU | BP_DASH | 30 | 19 | 20.6 | DR-25-1-0 |
| BP_DASH | DASH | 300 | 11 | 17.9 | DR-25-1-0 |
| BP_DASH | BP_COL | 220 | 9 | 13.6 | DR-25-3/4-0 |
| BP_COL | PEDAL | 640 | 8 | 15.3 | DR-25-3/4-0 |
| BP_COL | JB1 | 650 | 2 | 2.7 | DR-25-3/16-0 |
| ECU | CSB3 | 370 | 3 | 3.7 | DR-25-3/16-0 |
| ECU | CANJ | 50 | 3 | 9.4 | DR-25-1/2-0 |
| GB | RFG | 300 | 2 | 2.7 | DR-25-3/16-0 |
| RFG | C_FEND | 600 | 2 | 2.7 | DR-25-3/16-0 |
| C_FEND | ACC | 250 | 2 | 2.7 | DR-25-3/16-0 |
| RHSILL | BATT | 600 | 1 | 2.2 | DR-25-3/16-0 |

## NODES

ECU ECU plugs A / B (centre dash, factory ECM spot)
SP ECU splice point (bussed DT plugs + soldered splices)
BP_AC A/C branch
BP_GB glove-box branch
BH DRB102 bulkhead, cabin half (RH firewall)
GB Glove box: POWER + LOGIC boxes (every cabin fuse and relay), NEG bar, SW12 bus, blower lead
RHKICK RH kick panel (old R/B No.4 spot): ST1 / heater taps, ground IG
RHSILL RH sill, rear end (the run turns across the trunk)
FUEL Trunk LH: IX-FUEL inline to the fuel sender
ACAMP A/C amplifier (A18) taps
BP_DASH dash branch
DASH Mid-dash above the ECU: front + rear WS inlines, A/C switch lead
BP_COL pedal / column branch
PEDAL Accelerator pedal (driver footwell)
JB1 J/B No.1 + cowl plug IE1, LH kick panel: IG2 / tail / turn taps, door switch lead, ground ID (Routes 2, 7, 15)
CSB3 Centre console: CSB3 under the centre cluster, its switch inputs and opto board; alarm status LED (Routes 12, 14)
CANJ CAN trunk at the ECU: CAN H / L joins, ECU 120 ohm end (Route 8)
RFG Existing factory RH fender grommet, RH front inner fender corner: harness C, alarm siren + hood pin, alternator IG ...
BATT Trunk RH rear corner: battery, kill switch, battery relay block (FP 40 A fuse + fuel pump relay K-FP) (Route 1 point...
C_FEND Harness C: down the RH inner fender (A/C branch, EPS pump) (Route 2 rev 12)
ACC A/C compressor A4 clutch lead + dual pressure switch A5 (Route 2 point 7)

The ECU splice point (SP) is ONE place by the ECU plugs (Dan 2026-10-19): +5 V on BUS-5V + BUS-5V-2, Gnd Out A24 on BUS-GNDOUT-A, B22 on BUS-GNDOUT-B (bussed DEUTSCH DT, DECISIONS R169 parts), +8 V, switched 12 V, the A5 feed and the ECU power ground soldered there. The ECU ground runs alone to the POWER box NEG bar (R216).

## REVISIONS

| REV | DATE | BY | DESCRIPTION |
|---|---|---|---|
| I | 2026-10-27 | DG | Crank and cam each run in one shielded Raychem cable (2-core / 3-core). The CAN-Lambda bra... |
| J | 2026-10-28 | DG | ECU engine harness layout tree built from Route 16 (Dan's device spots and branches, DECISIO... |
| K | 2026-10-29 | DG | Ignition coil ground goes straight to the glove-box POWER box NEG bar through bulkhead cavity ... |
| L | 2026-10-29 | DG | Every connector part-way along a line or run breaks out at least 6 in (152 mm) off it; the last conn... |

**ST185-harness - every wiring harness of the car, one drawing set**

Layout - ST185-AB-cabin

| DRAWING NO. | REV | SHEET | SIZE | DRAWN | DATE |
|---|---|---|---|---|---|
| ST185-harness-LAY | L | 1 OF 35 | 432 x 279 mm | DG | 2026-10-29 |

## LAYOUT - ST185-AB-engine - ROUTE 16 ENGINE MAIN, as approved (1 of 1)


1993 EWD (EWD160U) book p.36, Electrical Wiring Routing, 3S-GTE engine compartment; coordinates in PDF points of Connector__Ground_and_Splice.pdf page 1 (st185-celica-repair-manual).

# ELECTRICAL WIRING ROUTING


▭ : Location of Connector Joining Wire Harness and Wire Harness

▽ : Location of Ground Points

[3S-GTE]

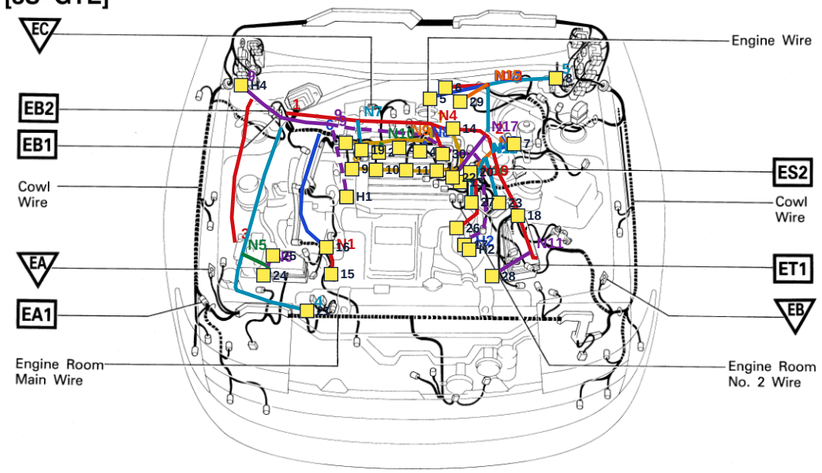


○ : Location of Splice Points

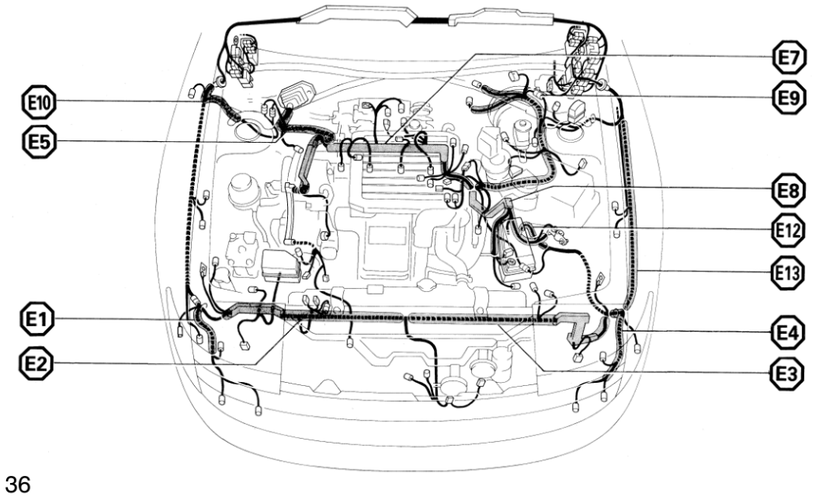


36

### APPROVED LINES

- 1 Main trunk
- 2 Driver-side drop
- 3 Passenger fender drop
- 4 Passenger front run
- 5 Driver firewall spur
- 6 Belt-end drop
- 7 Head loom, rear
- 8 Head loom, front
- 9 Alt and starter
- 9 Alt and starter, low behind the engine
- 9 Alt and starter, low behind the engine
- N1 Crank Pos Branch
- N2 ETB Branch
- N3 Oil Press Branch
- N5 EPS Stub 1
- N6 EPS Stub 2
- N7 Knock Stub
- N4 CLNT-P Branch
- N8 INJ 4 stub
- N9 INJ 3 stub
- N10 INJ 2 stub
- N11 Charge IAT stub
- N12 Boost Sol Branch
- N13 MAP branch
- N14 IAT branch
- N15 FLEX branch
- N16 ECT branch
- N17 VSS branch
- N18 Rev Switch branch
- N19 Turbo Speed branch
- H2 Starter B+ stud stub

### DEVICES

alternator
starter
1 INJ-1
2 INJ-2
3 INJ-3
4 INJ-4
5 IAT
6 MAP
7 ETB
8 FUEL-P
9 COIL-1
10 COIL-2
11 COIL-3
12 COIL-4
13 ECT
14 CAM
15 CRANK
16 CAN-LAMBDA
17 STARTER
18 Engine block ground stud (lugs 1-3)
19 KNOCK-1
20 OIL-P
21 OIL-T
22 VSS
23 REV-SW
24 MRS-B
25 MRS-C
26 TURBO-SPD
27 BOOST-SOL
28 CHARGE-IAT
29 FLEX
30 CLNT-P
H1 Alternator B+ stud and 3-pin plug
H2 Starter B+ stud
H4 RADLOK + / - engine side

### REVISIONS

| REV | DATE | BY | DESCRIPTION |
|---|---|---|---|
| I | 2026-10-27 | DG | Crank and cam each run in one shielded Raychem cable (2-core / 3-core). The CAN-Lambda bra... |
| J | 2026-10-28 | DG | ECU engine harness layout tree built from Route 16 (Dan's device spots and branches, DECISIO... |
| K | 2026-10-29 | DG | Ignition coil ground goes straight to the glove-box POWER box NEG bar through bulkhead cavity ... |
| L | 2026-10-29 | DG | Every connector part-way along a line or run breaks out at least 6 in (152 mm) off it; the last conn... |

**ST185-harness - every wiring harness of the car, one drawing set**

Layout - ST185-AB-engine - ROUTE-16-ENGINE-MAIN

| DRAWING NO. | REV | SHEET | SIZE | DRAWN | DATE |
|---|---|---|---|---|---|
| ST185-harness-LAY | L | 2 OF 35 | 432 x 279 mm | DG | 2026-10-29 |


ST185 Celica (living-relation) - generated by docs/harness/tools/build_drawings.py from docs/harness/MASTER-wirelist.csv; not to scale

**LAYOUT - ST185-CabinPower - top view, front of the car to the RIGHT, driver side UP (R140 / R153). Not to scale; lengths in mm (estimates until measured at the car).**

Each segment: length | wires in it | DR-25 heat-shrink size for its bundle (est. from the wire ODs). Lengths per wire (path + 100 mm at each end) are in the pinout table.

^ DRIVER SIDE (LH) at the top / PASSENGER SIDE (RH) at the bottom v

FRONT -->

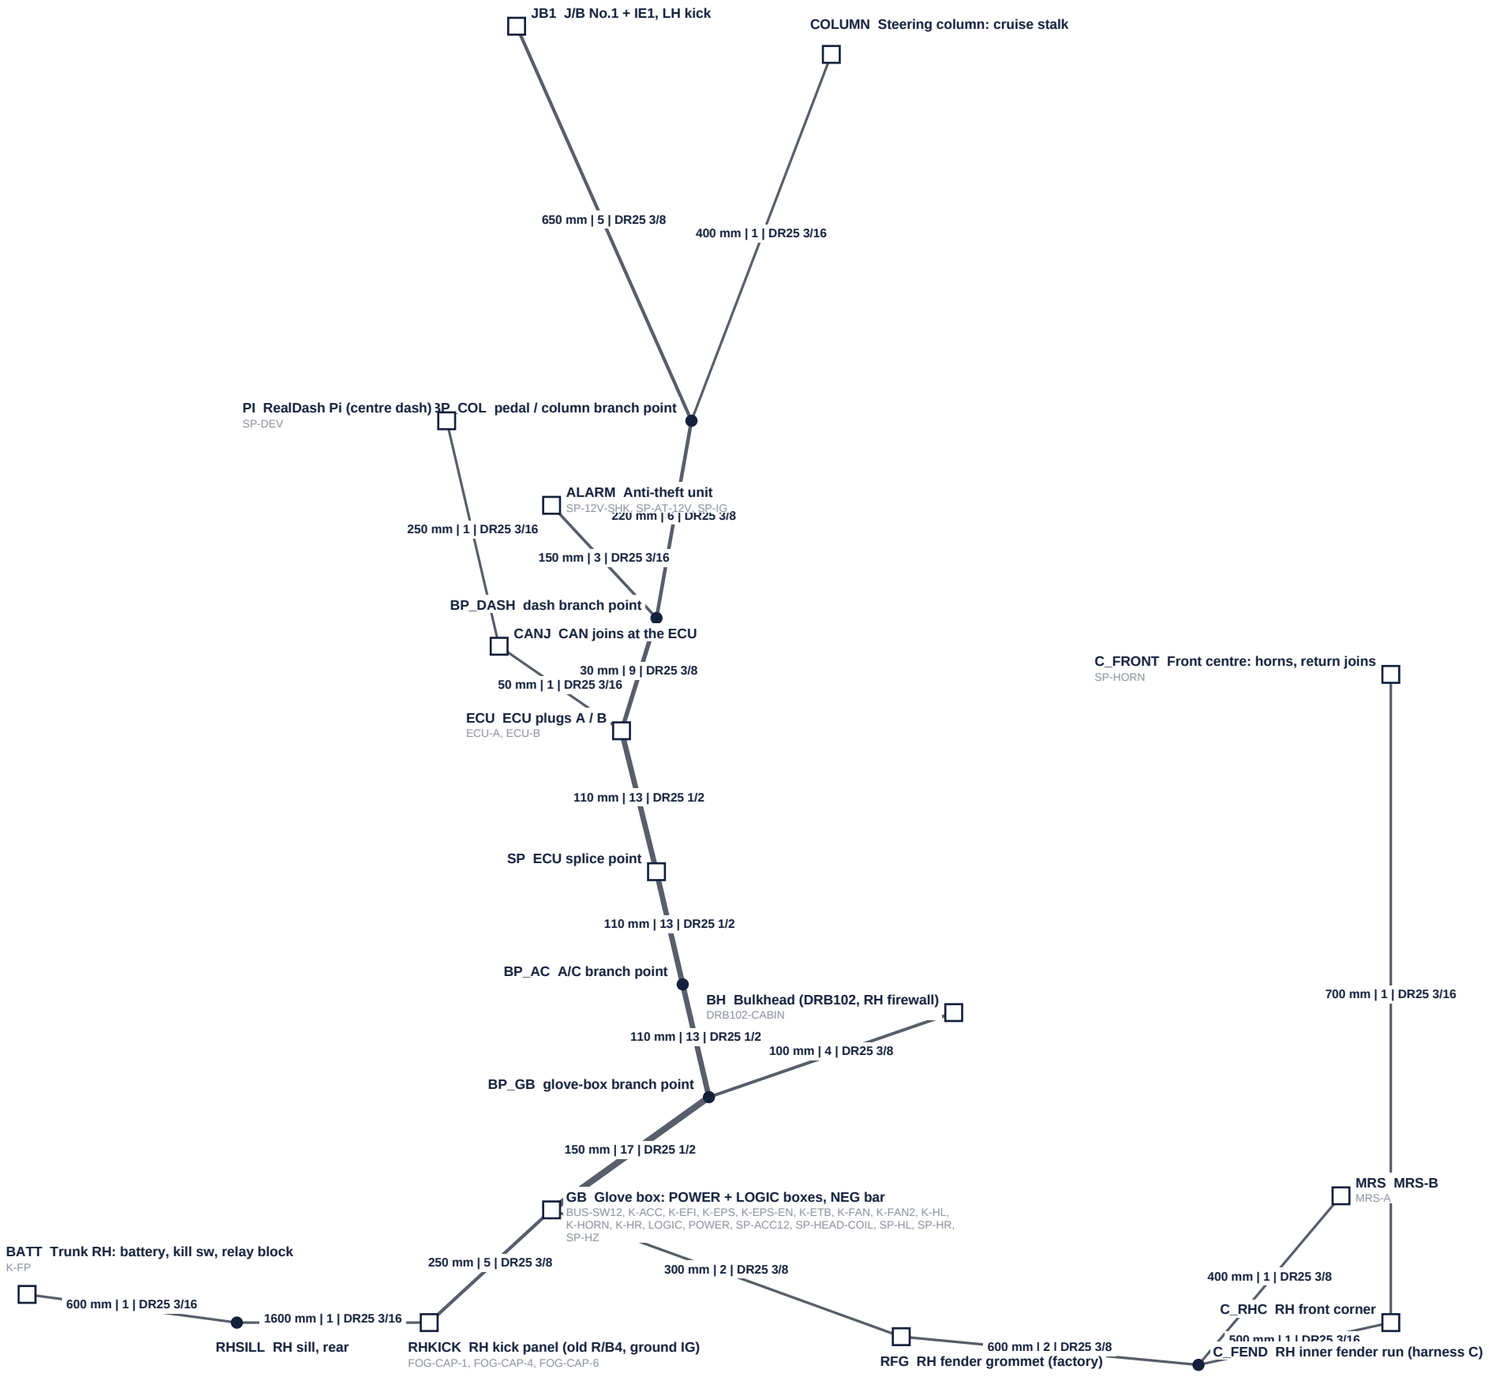


## SEGMENTS

| FROM | TO | MM | WIRES | BUNDLE | DR-25 |
|---|---|---|---|---|---|
| ECU | SP | 110 | 13 | 8.8 | DR-25-1/2-0 |
| SP | BP_AC | 110 | 13 | 8.8 | DR-25-1/2-0 |
| BP_AC | BP_GB | 110 | 13 | 8.8 | DR-25-1/2-0 |
| BP_GB | BH | 100 | 4 | 6.1 | DR-25-3/8-0 |
| BP_GB | GB | 150 | 17 | 10.8 | DR-25-1/2-0 |
| GB | RHKICK | 250 | 5 | 8.0 | DR-25-3/8-0 |
| RHKICK | RHSILL | 1600 | 1 | 2.2 | DR-25-3/16-0 |
| ECU | BP_DASH | 30 | 9 | 7.6 | DR-25-3/8-0 |
| BP_DASH | BP_COL | 220 | 6 | 6.9 | DR-25-3/8-0 |
| BP_COL | JB1 | 650 | 5 | 6.5 | DR-25-3/8-0 |
| BP_DASH | ALARM | 150 | 3 | 3.3 | DR-25-3/16-0 |
| ECU | CANJ | 50 | 1 | 2.5 | DR-25-3/16-0 |
| CANJ | PI | 250 | 1 | 2.5 | DR-25-3/16-0 |
| BP_COL | COLUMN | 400 | 1 | 2.2 | DR-25-3/16-0 |
| GB | RFG | 300 | 2 | 6.7 | DR-25-3/8-0 |
| RFG | C_FEND | 600 | 2 | 6.7 | DR-25-3/8-0 |
| C_FEND | MRS | 400 | 1 | 6.1 | DR-25-3/8-0 |
| C_FEND | C_RHC | 500 | 1 | 2.9 | DR-25-3/16-0 |
| C_RHC | C_FRONT | 700 | 1 | 2.9 | DR-25-3/16-0 |
| RHSILL | BATT | 600 | 1 | 2.2 | DR-25-3/16-0 |

## NODES

ECU ECU plugs A / B (centre dash, factory ECM spot)
SP ECU splice point (bussed DT plugs + soldered splices)
BP_AC A/C branch
BP_GB glove-box branch
BH DRB102 bulkhead, cabin half (RH firewall)
GB Glove box: POWER + LOGIC boxes (every cabin fuse and relay), NEG bar, SW12 bus, blower lead
RHKICK RH kick panel (old R/B No.4 spot): ST1 / heater taps, ground IG
RHSILL RH sill, rear end (the run turns across the trunk)
BP_DASH dash branch
BP_COL pedal / column branch
JB1 J/B No.1 + cowl plug IE1, LH kick panel: IG2 / tail / turn taps, door switch lead, ground ID (Routes 2, 7, 15)
ALARM Anti-theft unit (centre dash, left of the ECU)
CANJ CAN trunk at the ECU: CAN H / L joins, ECU 120 ohm end (Route 8)
PI RealDash Pi + USB-CAN adapter, centre dash, and the dash 12 V split (Route 8)
COLUMN Steering column: cruise stalk C14 flying leads (Route 12, spot approximate)
RFG Existing factory RH fender grommet, RH front inner fender corner: harness C, alarm siren + hood pin, alternator IG ...
BATT Trunk RH rear corner: battery, kill switch, battery relay block (FP 40 A fuse + fuel pump relay K-FP) (Route 1 point...
C_FEND Harness C: down the RH inner fender (A/C branch, EPS pump) (Route 2 rev 12)
C_RHC RH front corner: headlamp H2, turn / clearance F8, retract motor R3, washer W1, hood pin, ground EA (Route 2 ...
C_FRONT Core support, front centre: horn split, both horns (DT 2-way each), headlamp / retract / clearance return joins ...
MRS MRS-B (Route 16 device 24 on N5)

The ECU splice point (SP) is ONE place by the ECU plugs (Dan 2026-10-19): +5 V on BUS-5V + BUS-5V-2, Gnd Out A24 on BUS-GNDOUT-A, B22 on BUS-GNDOUT-B (bussed DEUTSCH DT, DECISIONS R169 parts), +8 V, switched 12 V, the A5 feed and the ECU power ground soldered there. The ECU ground runs alone to the POWER box NEG bar (R216).

## REVISIONS

| REV | DATE | BY | DESCRIPTION |
|---|---|---|---|
| I | 2026-10-27 | DG | Crank and cam each run in one shielded Raychem cable (2-core / 3-core). The CAN-Lambda bra... |
| J | 2026-10-28 | DG | ECU engine harness layout tree built from Route 16 (Dan's device spots and branches, DECISIO... |
| K | 2026-10-29 | DG | Ignition coil ground goes straight to the glove-box POWER box NEG bar through bulkhead cavity ... |
| L | 2026-10-29 | DG | Every connector part-way along a line or run breaks out at least 6 in (152 mm) off it; the last conn... |

**ST185-harness - every wiring harness of the car, one drawing set**

Layout - ST185-CabinPower

| DRAWING NO. | REV | SHEET | SIZE | DRAWN | DATE |
|---|---|---|---|---|---|
| ST185-harness-LAY | L | 3 OF 35 | 432 x 279 mm | DG | 2026-10-29 |

## LAYOUT - ST185-EngineRoom-C - ROUTE 17 FRONT, as approved (1 of 1)


1993 EWD book p.36 (3S-GTE engine compartment); PDF points of Connector__Ground_and_Splice.pdf page 1 (st185-celica-repair-manual).

### ELECTRICAL WIRING ROUTING


▭ : Location of Connector Joining Wire Harness and Wire Harness

▽ : Location of Ground Points

[3S-GTE]

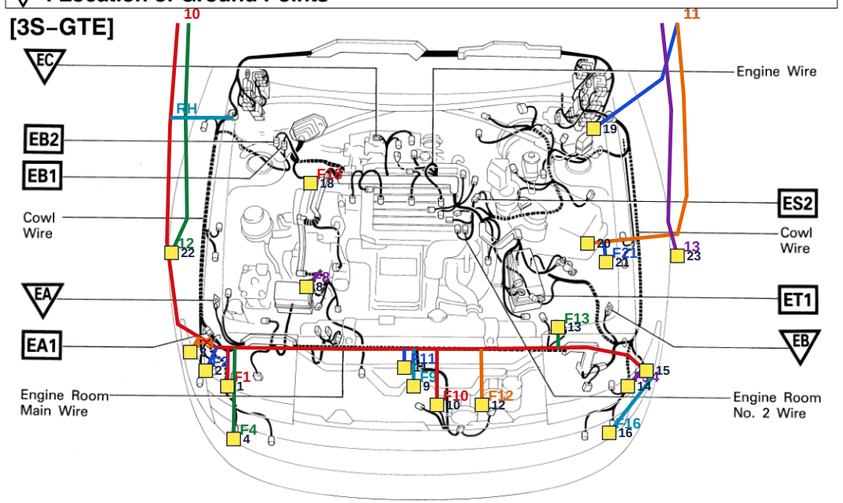


○ : Location of Splice Points

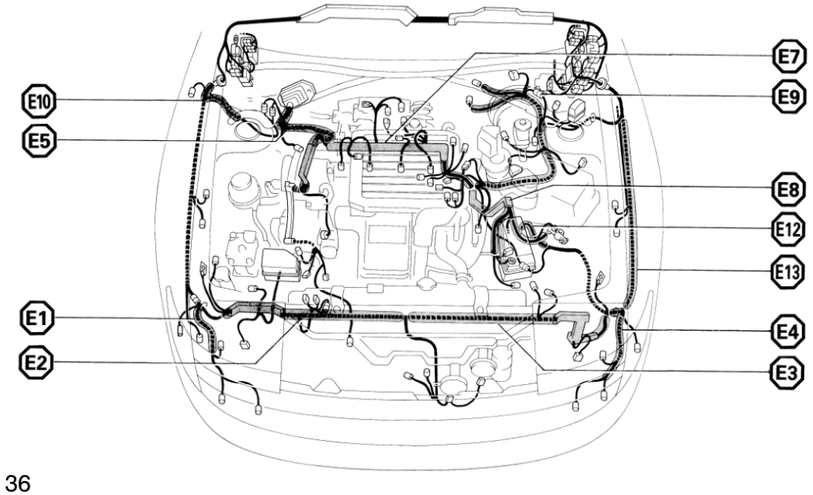


36

### APPROVED LINES

- 10 Front run
- 11 Driver fender run (wiper)
- 11 Driver fender run (siren branch)
- 12 Wheel-speed RH
- 13 Wheel-speed LH
- RH fender grommet
- F1 RH headlight stub
- F2 RH pop-up motor stub
- F3 Washer pump stub
- F4 RH turn + clearance stub
- F8 A/C compressor clutch stub
- F9 Condenser fan stub
- F10 Ambient air temp sensor stub
- F11 Alarm hood pin stub
- F12 Horns stub
- F13 Radiator fan stub
- F14 LH headlight stub
- F16 LH turn + clearance stub
- F18 A/C dual pressure switch stub
- F21 Jump studs stub

### DEVICES

1 RH headlight
2 RH pop-up motor
3 Washer pump
4 RH turn + clearance
8 A/C compressor clutch
9 Condenser fan
10 Ambient air temp sensor
11 Alarm hood pin
12 Horns (2)
13 Radiator fan
14 LH headlight
15 LH pop-up motor
16 LH turn + clearance
18 A/C dual pressure switch (via RH fender grommet)
19 Wiper motor (driver fender run)
20 Alarm siren (old battery spot)
21 Jump studs (OPTIONAL, owning harness open)
22 RH front wheel speed sensor (own harness to VRC / ...
23 LH front wheel speed sensor (own harness to VRC / E...

### REVISIONS

| REV | DATE | BY | DESCRIPTION |
|---|---|---|---|
| I | 2026-10-27 | DG | Crank and cam each run in one shielded Raychem cable (2-core / 3-core). The CAN-Lambda bra... |
| J | 2026-10-28 | DG | ECU engine harness layout tree built from Route 16 (Dan's device spots and branches, DECISIO... |
| K | 2026-10-29 | DG | Ignition coil ground goes straight to the glove-box POWER box NEG bar through bulkhead cavity ... |
| L | 2026-10-29 | DG | Every connector part-way along a line or run breaks out at least 6 in (152 mm) off it; the last conn... |

**ST185-harness - every wiring harness of the car, one drawing set**


Layout - ST185-EngineRoom-C - ROUTE-17-FRONT

| DRAWING NO. | REV | SHEET | SIZE | DRAWN | DATE |
|---|---|---|---|---|---|
| ST185-harness-LAY | L | 4 OF 35 | 432 x 279 mm | DG | 2026-10-29 |

ST185 Celica (living-relation) - generated by docs/harness/tools/build_drawings.py from docs/harness/MASTER-wirelist.csv; not to scale

**LAYOUT - ST185-HeavyDC - ROUTE 1 HEAVYDC, as approved (1 of 7)**

Fig. 1 · Rev 4 (Dan): battery box moved to the passenger-side rear corner of the trunk (far side in this view, approximate); H1/H2 rerouted from there. Body, liftback, TIS 1993 EWD ·Electrical Wiring Routing· p.46 (st185-celica-repair-manual: electrical/circuits/tis1993-wiring-routing-2.pdf, sheet 11). Car front is at left; the near side is the driver (LH) side. The red line runs on the far (passenger, RH) side, so it is drawn approximately on this perspec...

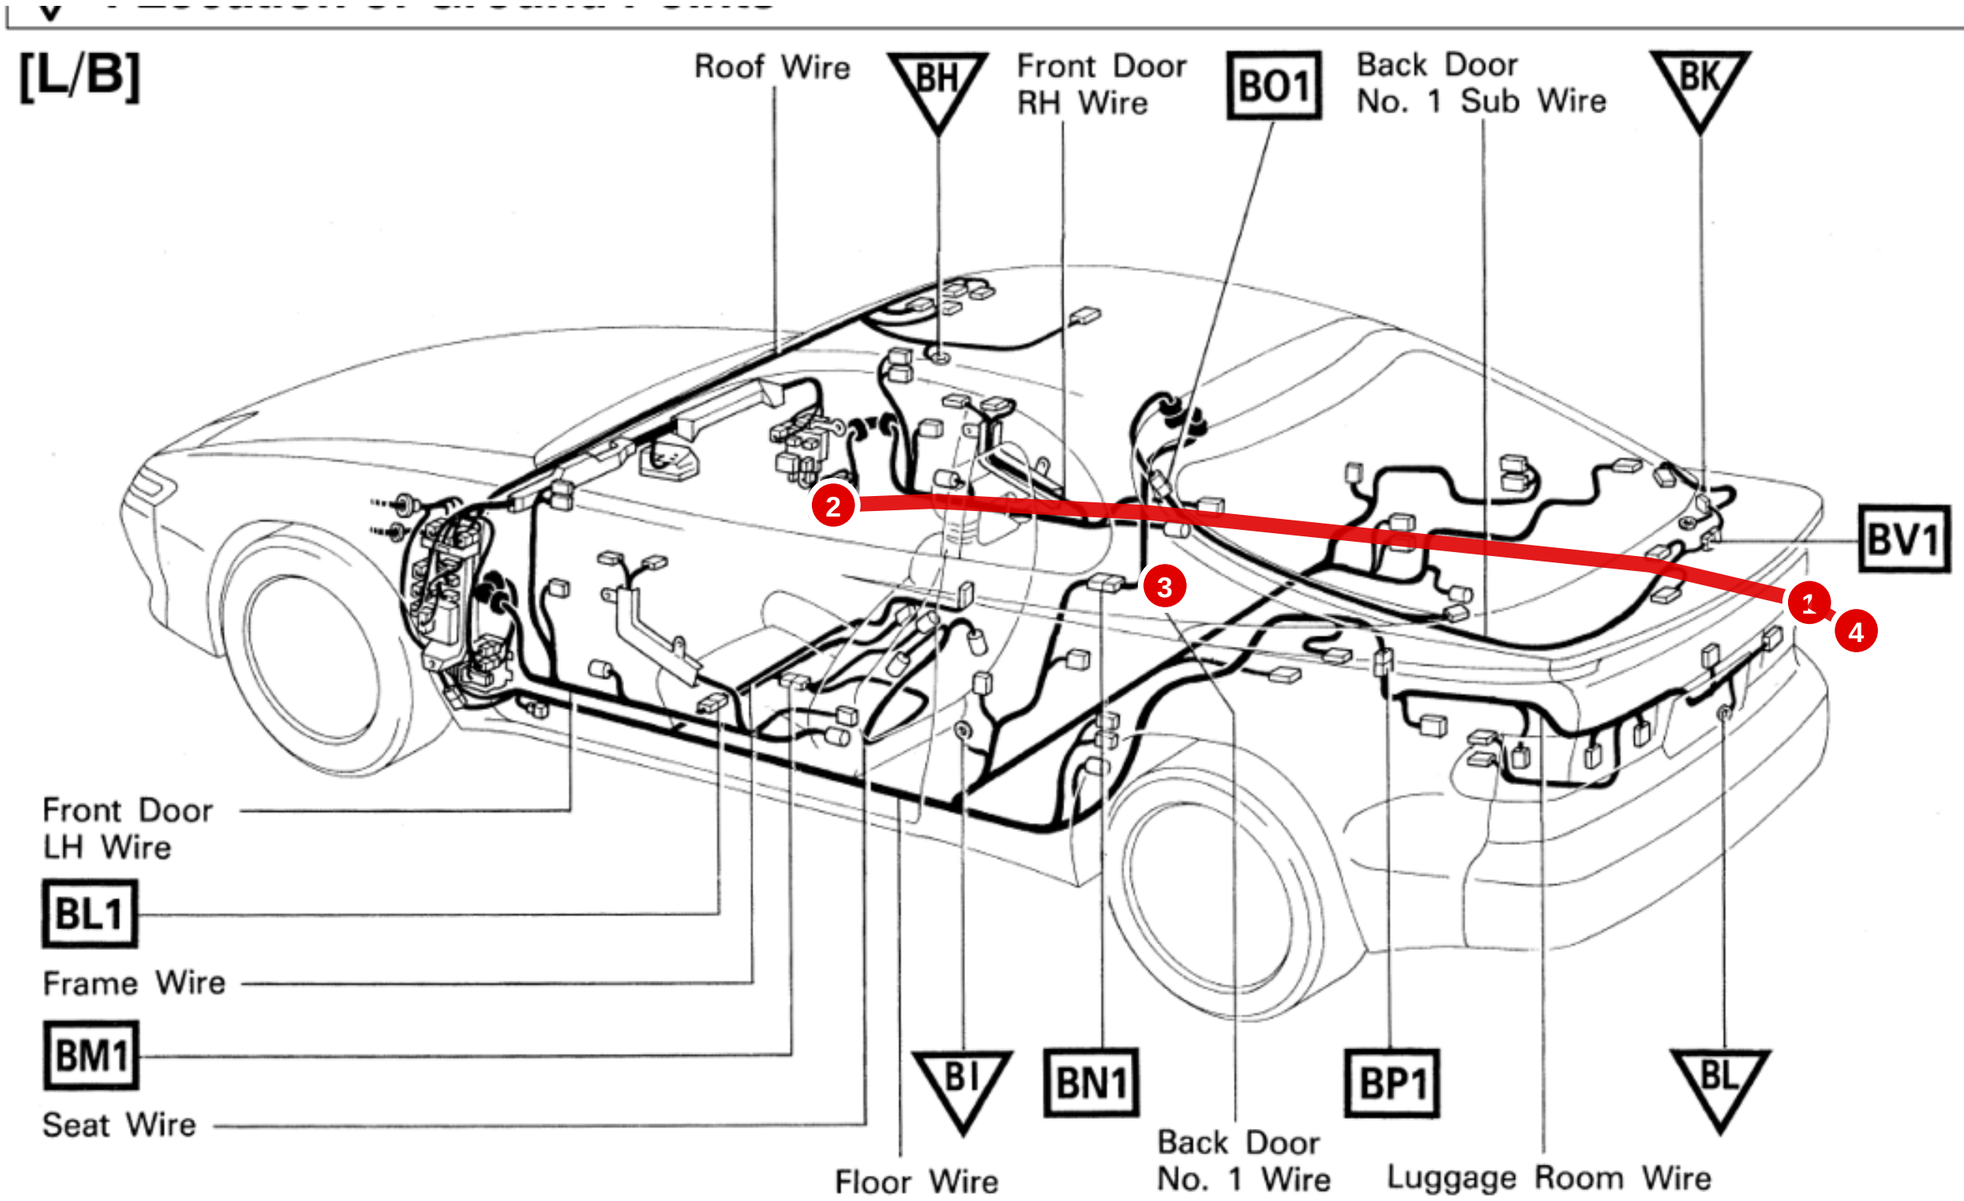


**REVISIONS**

| REV | DATE | BY | DESCRIPTION |
|---|---|---|---|
| I | 2026-10-27 | DG | Crank and cam each run in one shielded Raychem cable (2-core / 3-core). The CAN-Lambda bra... |
| J | 2026-10-28 | DG | ECU engine harness layout tree built from Route 16 (Dan's device spots and branches, DECISIO... |
| K | 2026-10-29 | DG | Ignition coil ground goes straight to the glove-box POWER box NEG bar through bulkhead cavity ... |
| L | 2026-10-29 | DG | Every connector part-way along a line or run breaks out at least 6 in (152 mm) off it; the last conn... |

**ST185-harness - every wiring harness of the car, one drawing set**

Layout - ST185-HeavyDC - ROUTE-1-HEAVYDC


| DRAWING NO. | REV | SHEET | SIZE | DRAWN | DATE |
|---|---|---|---|---|---|
| ST185-harness-LAY | L | 5 OF 35 | 432 x 279 mm | DG | 2026-10-29 |

ST185 Celica (living-relation) - generated by docs/harness/tools/build_drawings.py from docs/harness/MASTER-wirelist.csv; not to scale

**LAYOUT - ST185-HeavyDC - ROUTE 1 HEAVYDC, as approved (2 of 7)**

Top view for the figure above · same route, same colors. Drawn to match the figure above (approximate); this figure·s part is bright, the rest of the route is faded. Blue squares: B = bulkhead A/B (DRB102, RH firewall), R / L = RH / LH fender pass-throughs (Route 9 rev 2). Top view base: 1993 Celica repair manual RM305U1, Introduction, ·Vehicle Lift and Support Locations·, p. IN·24 (st185-celica-repair-manual\manuals\RM305U1 - Introduction - V...

## DRIVER (LH) SIDE

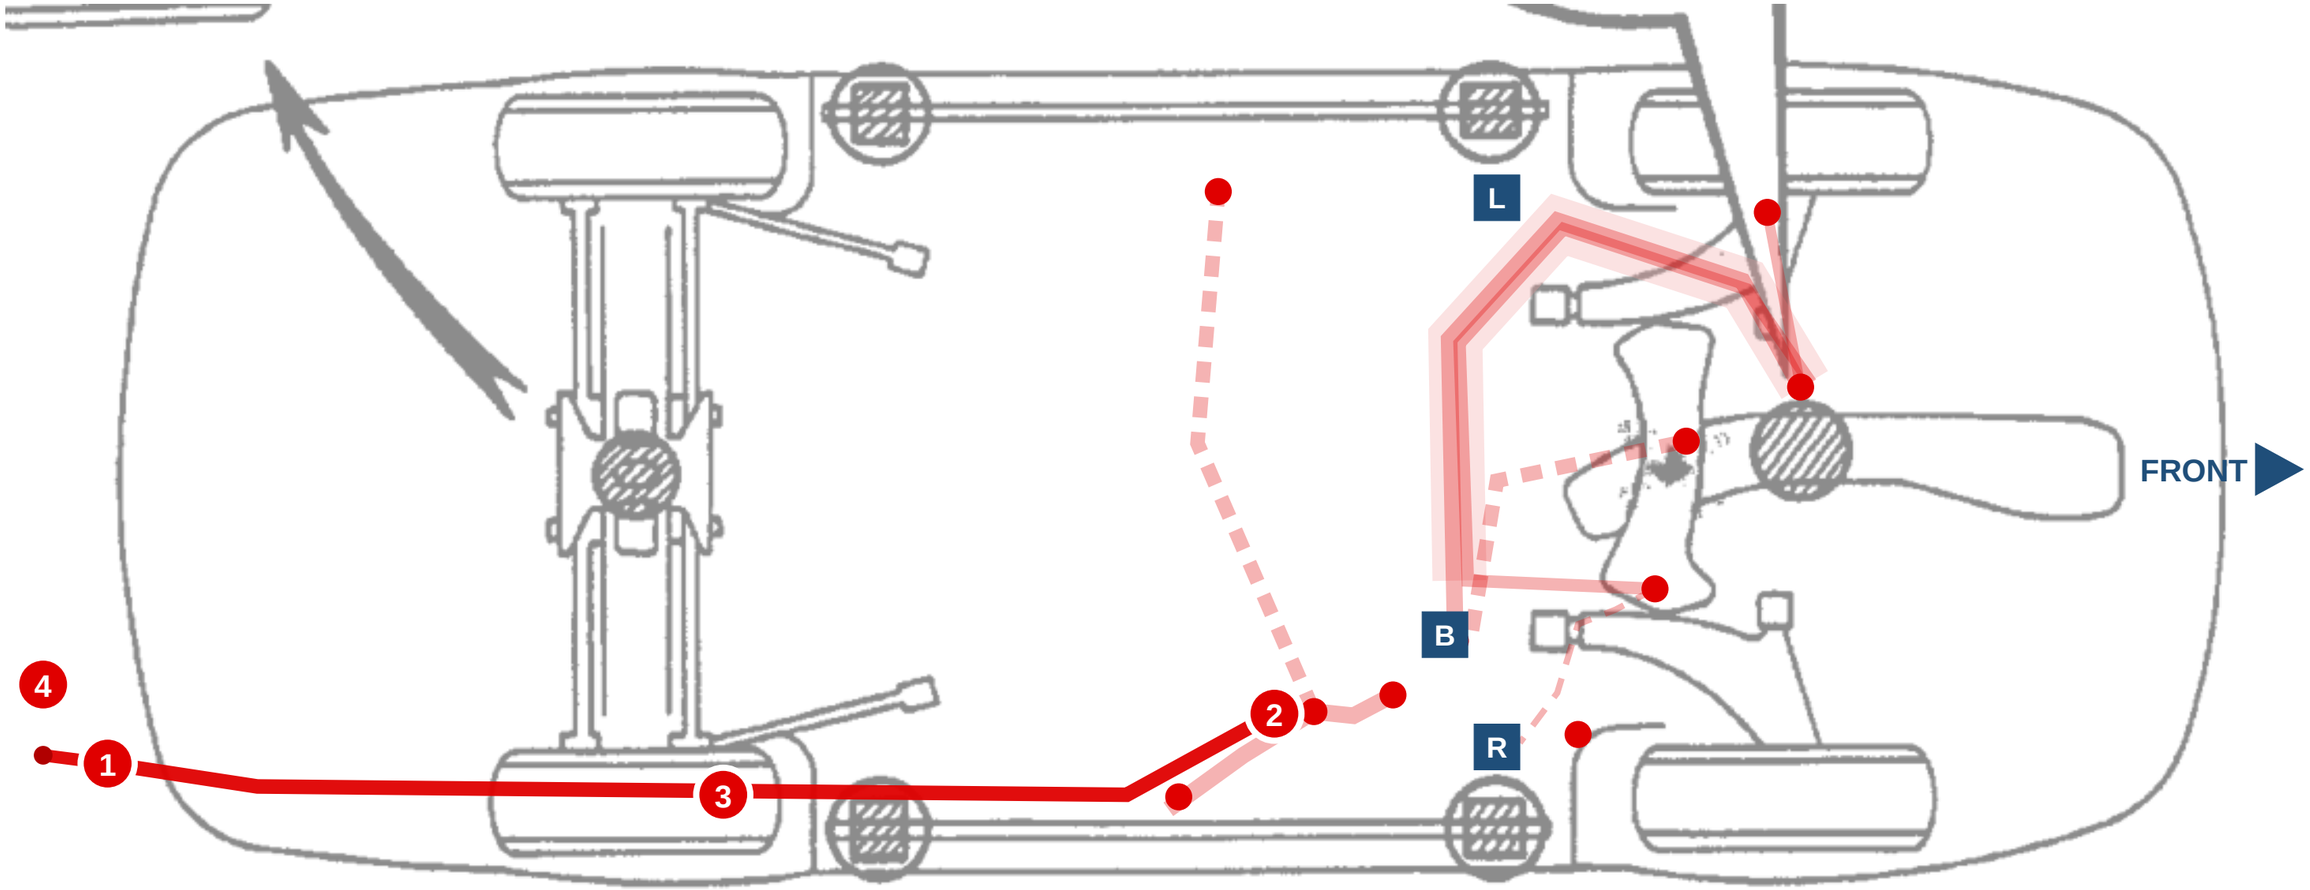


## PASSENGER (RH) SIDE

**REVISIONS**

| REV | DATE | BY | DESCRIPTION |
|---|---|---|---|
| I | 2026-10-27 | DG | Crank and cam each run in one shielded Raychem cable (2-core / 3-core). The CAN-Lambda bra... |
| J | 2026-10-28 | DG | ECU engine harness layout tree built from Route 16 (Dan's device spots and branches, DECISIO... |
| K | 2026-10-29 | DG | Ignition coil ground goes straight to the glove-box POWER box NEG bar through bulkhead cavity ... |
| L | 2026-10-29 | DG | Every connector part-way along a line or run breaks out at least 6 in (152 mm) off it; the last conn... |

**ST185-harness - every wiring harness of the car, one drawing set**


Layout - ST185-HeavyDC - ROUTE-1-HEAVYDC

| DRAWING NO. | REV | SHEET | SIZE | DRAWN | DATE |
|---|---|---|---|---|---|
| ST185-harness-LAY | L | 6 OF 35 | 432 x 279 mm | DG | 2026-10-29 |

ST185 Celica (living-relation) - generated by docs/harness/tools/build_drawings.py from docs/harness/MASTER-wirelist.csv; not to scale

**LAYOUT - ST185-HeavyDC - ROUTE 1 HEAVYDC, as approved (3 of 7)**

Fig. 2 · Instrument panel, TIS 1993 EWD ·Relay Locations· p.18 (tis1993-relay-locations.pdf, sheet 1). R/B No.4 / No.3 mark the right kick panel; J/B No.1 / R/B No.2 the left kick. Solid = +, dashed = ground. The exact POWER box mount spot in the glove box is still to be measured. Deleted parts still drawn on this factory page: Circuit Opening Relay, Center Airbag Sensor, Cruise Control ECU · not used.

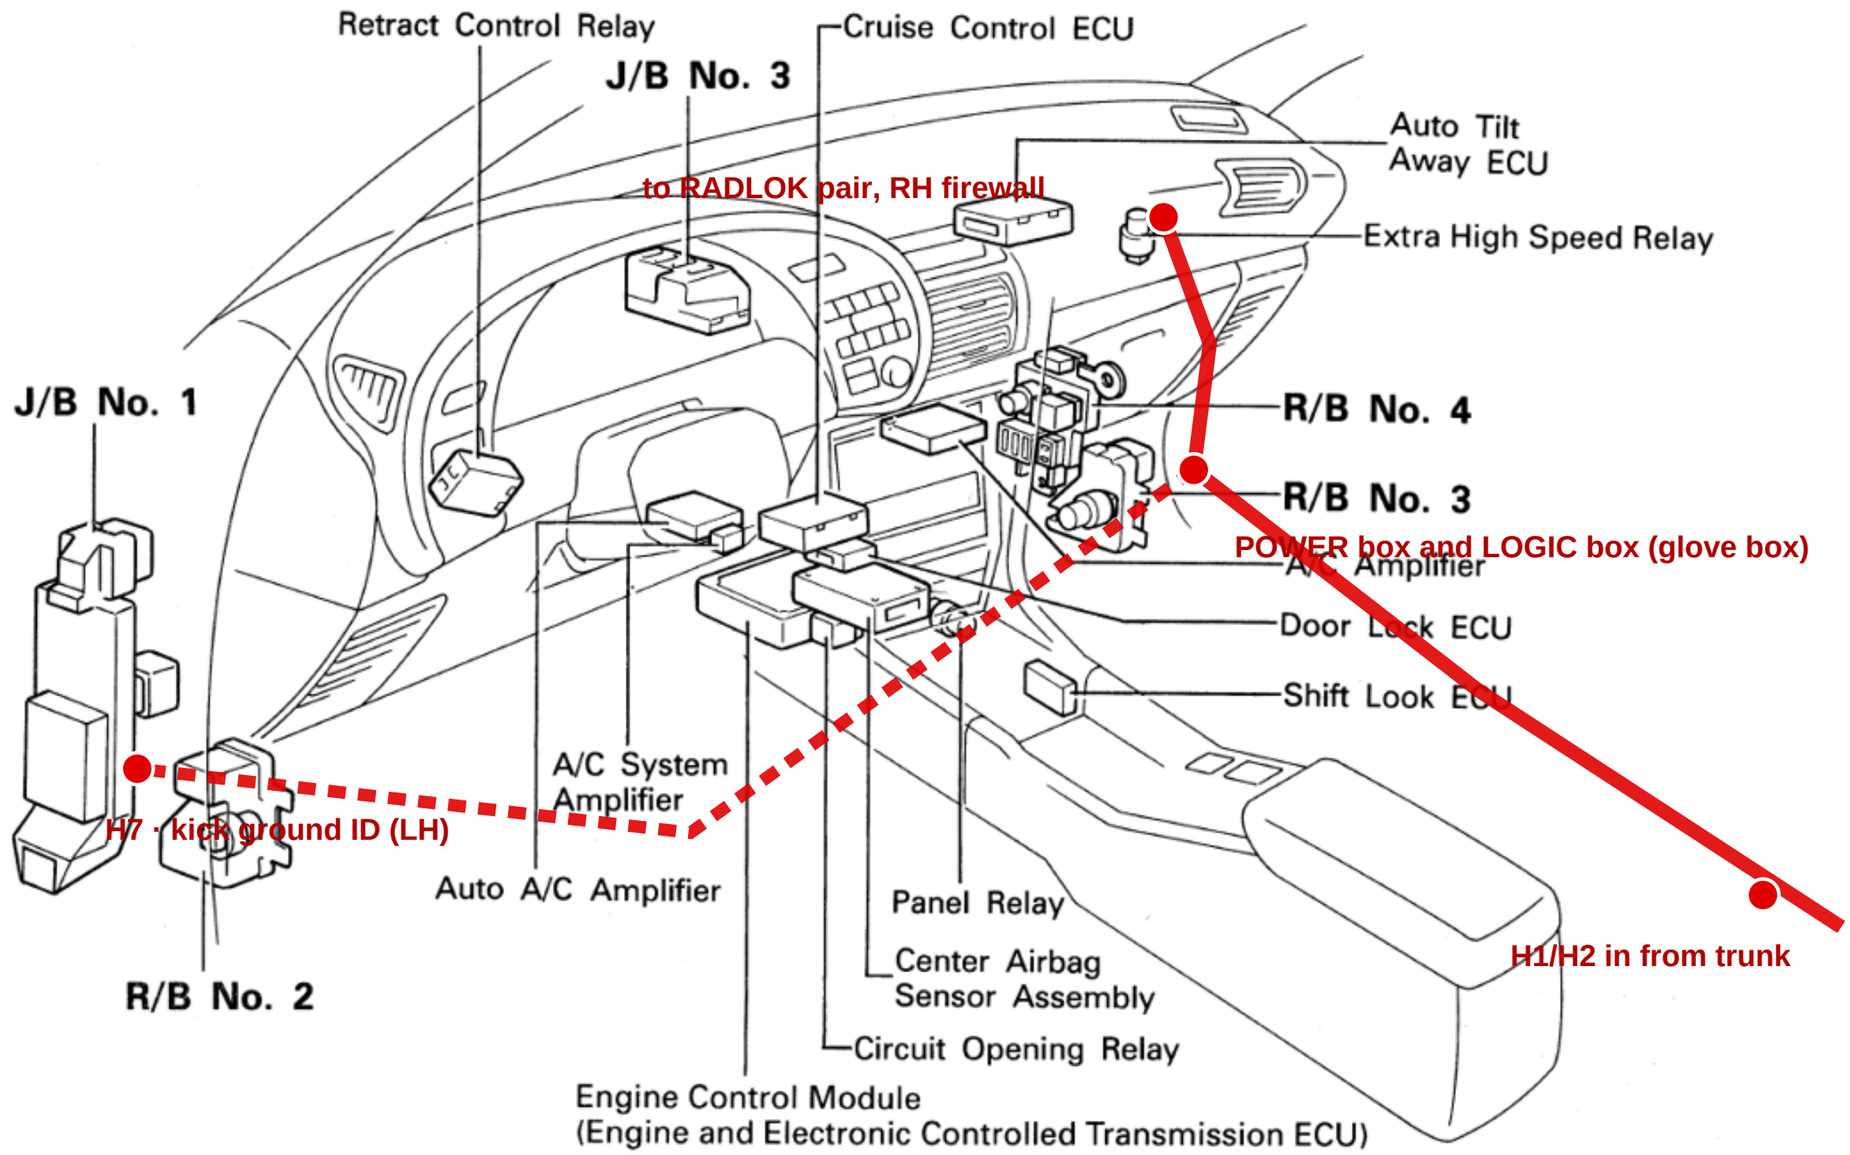


| REVISIONS | | | |
|---|---|---|---|
| REV | DATE | BY | DESCRIPTION |
| I | 2026-10-27 | DG | Crank and cam each run in one shielded Raychem cable (2-core / 3-core). The CAN-Lambda bra... |
| J | 2026-10-28 | DG | ECU engine harness layout tree built from Route 16 (Dan's device spots and branches, DECISIO... |
| K | 2026-10-29 | DG | Ignition coil ground goes straight to the glove-box POWER box NEG bar through bulkhead cavity ... |
| L | 2026-10-29 | DG | Every connector part-way along a line or run breaks out at least 6 in (152 mm) off it; the last conn... |

**ST185-harness - every wiring harness of the car, one drawing set**


Layout - ST185-HeavyDC - ROUTE-1-HEAVYDC

| DRAWING NO. | REV | SHEET | SIZE | DRAWN | DATE |
|---|---|---|---|---|---|
| ST185-harness-LAY | L | 7 OF 35 | 432 x 279 mm | DG | 2026-10-29 |

ST185 Celica (living-relation) - generated by docs/harness/tools/build_drawings.py from docs/harness/MASTER-wirelist.csv; not to scale

**LAYOUT - ST185-HeavyDC - ROUTE 1 HEAVYDC, as approved (4 of 7)**

Top view for the figure above · same route, same colors. Projected from the figure above (approximate); this figure·s part is bright, the rest of the route is faded. Blue squares: B = bulkhead A/B (DRB102, RH firewall), R / L = RH / LH fender pass-throughs (Route 9 rev 2). Top view base: 1993 Celica repair manual RM305U1, Introduction, ·Vehicle Lift and Support Locations·, p. IN·24 (st185-celica-repair-manual\manuals\RM305U1 - Introduction - Ve...

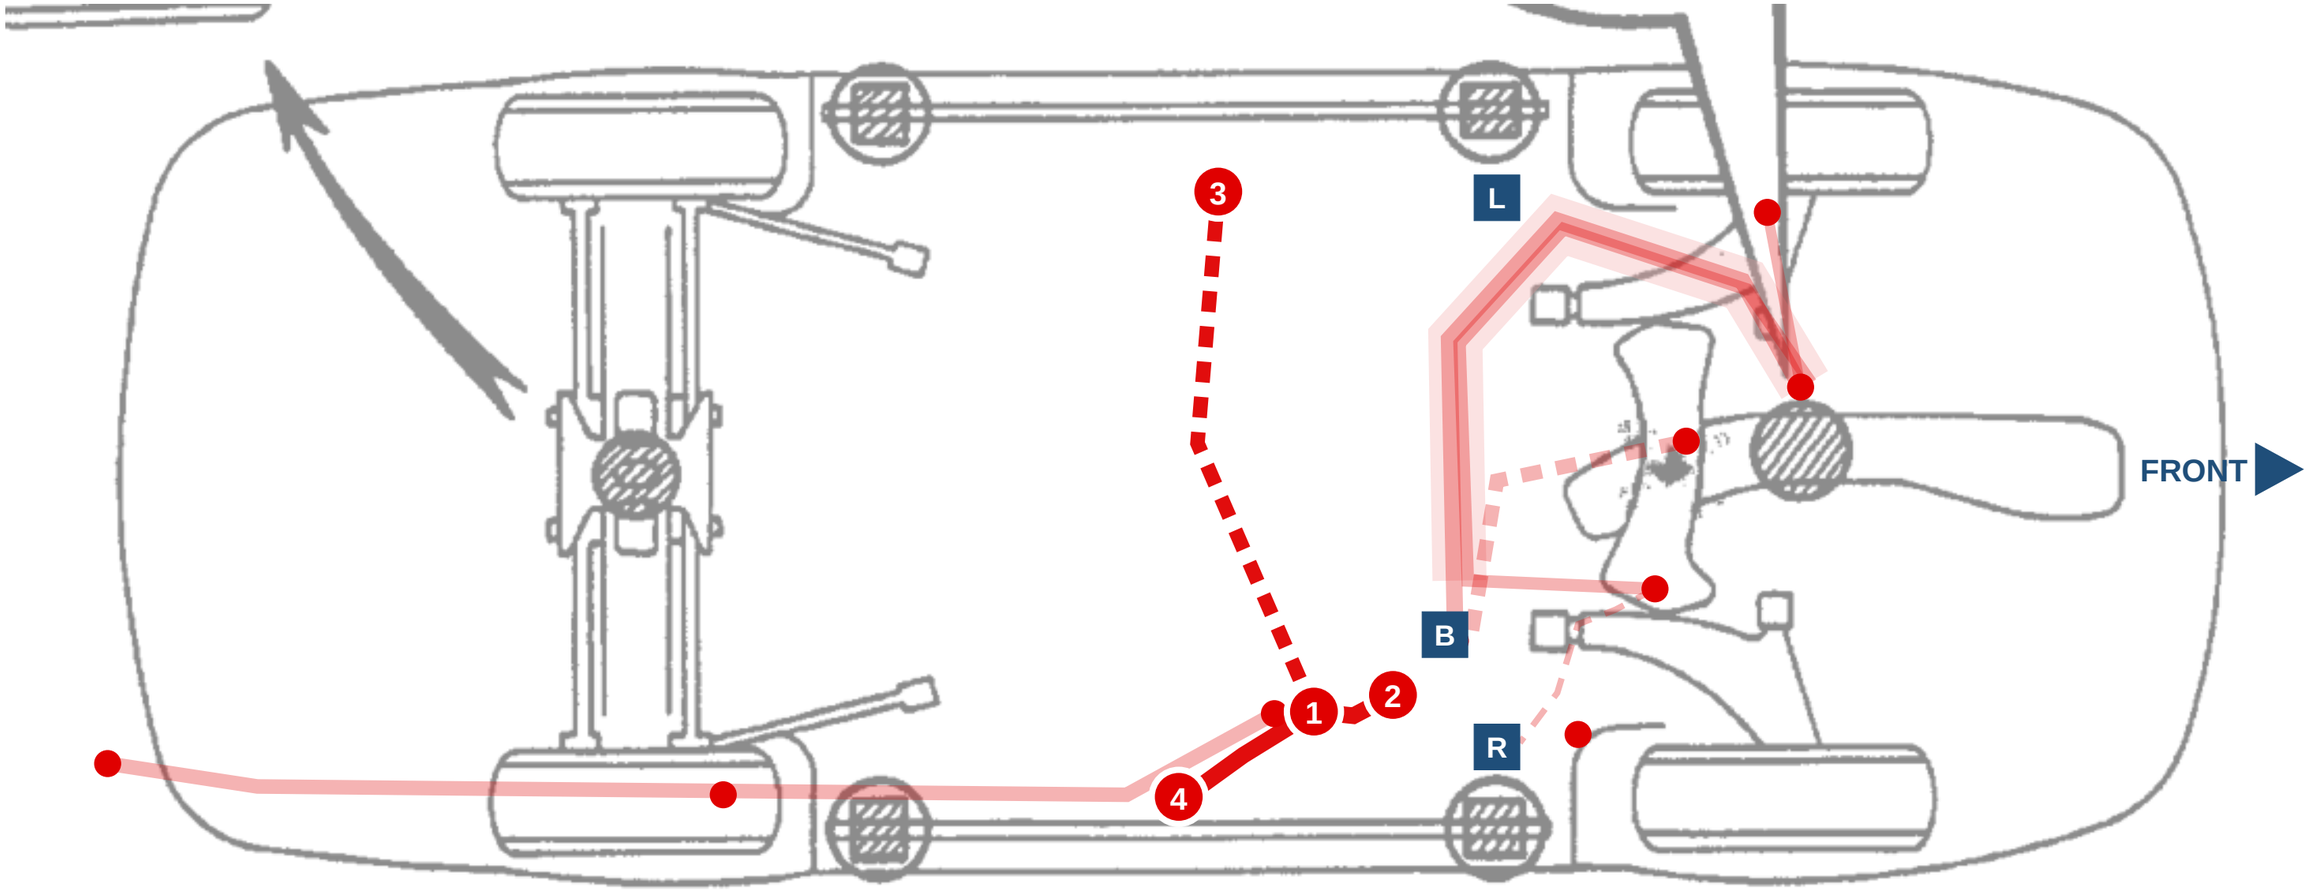


| REVISIONS | | | |
|---|---|---|---|
| REV | DATE | BY | DESCRIPTION |
| I | 2026-10-27 | DG | Crank and cam each run in one shielded Raychem cable (2-core / 3-core). The CAN-Lambda bra... |
| J | 2026-10-28 | DG | ECU engine harness layout tree built from Route 16 (Dan's device spots and branches, DECISIO... |
| K | 2026-10-29 | DG | Ignition coil ground goes straight to the glove-box POWER box NEG bar through bulkhead cavity ... |
| L | 2026-10-29 | DG | Every connector part-way along a line or run breaks out at least 6 in (152 mm) off it; the last conn... |

**ST185-harness - every wiring harness of the car, one drawing set**


Layout - ST185-HeavyDC - ROUTE-1-HEAVYDC

| DRAWING NO. | REV | SHEET | SIZE | DRAWN | DATE |
|---|---|---|---|---|---|
| ST185-harness-LAY | L | 8 OF 35 | 432 x 279 mm | DG | 2026-10-29 |

ST185 Celica (living-relation) - generated by docs/harness/tools/build_drawings.py from docs/harness/MASTER-wirelist.csv; not to scale

**LAYOUT - ST185-HeavyDC - ROUTE 1 HEAVYDC, as approved (5 of 7)**

Fig. 3 · Rev 4 (Dan·s mark-up): starter moved to where Dan points (lower-middle of the engine); H4 (RADLOK +) and H5 (alternator B+) now run as one bundle (pink band) along the firewall and down to the starter; H8 jump post rerouted from the new starter spot; alternator IG/L/S small wires (rev 4 proposal: spare positions on the B half of the bulkhead · superseded 2026·10·13: they leave through the existing factory RH fender grommet (point 4), s...

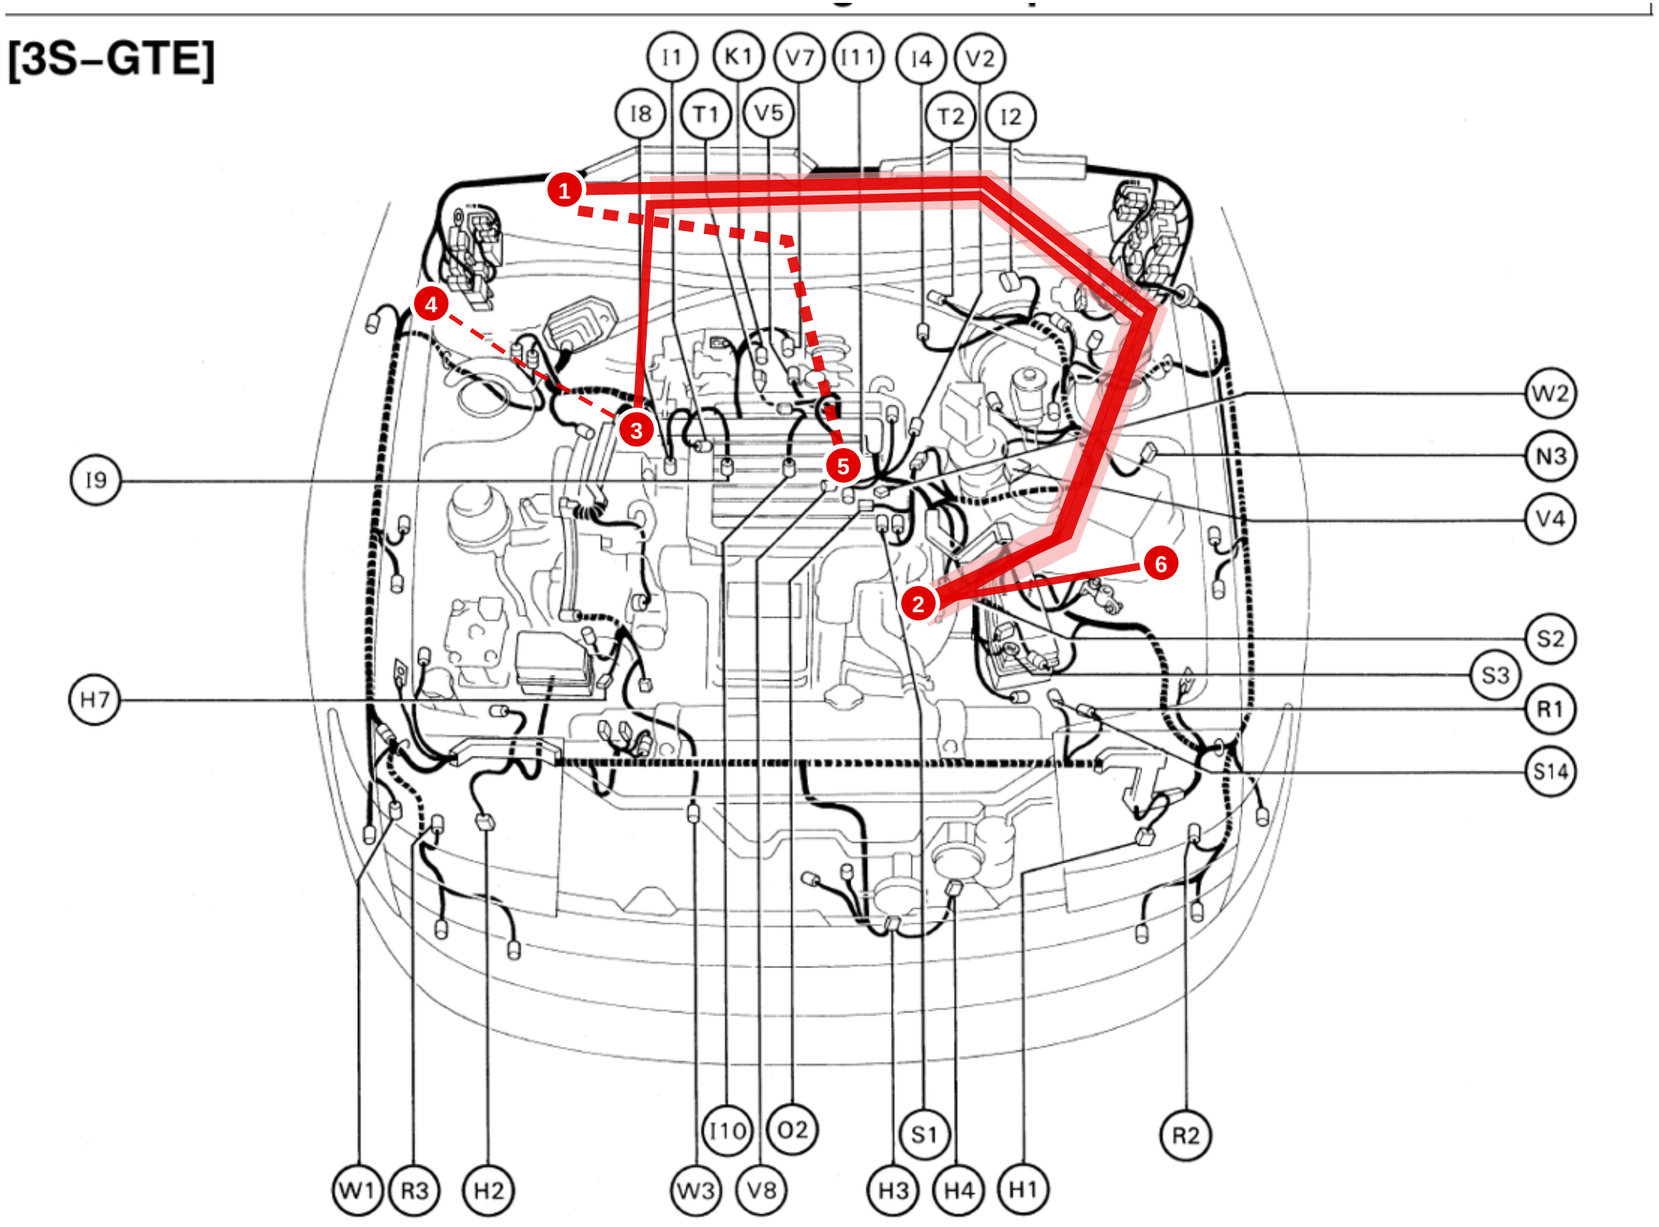


| REVISIONS | | | |
|---|---|---|---|
| REV | DATE | BY | DESCRIPTION |
| I | 2026-10-27 | DG | Crank and cam each run in one shielded Raychem cable (2-core / 3-core). The CAN-Lambda bra... |
| J | 2026-10-28 | DG | ECU engine harness layout tree built from Route 16 (Dan's device spots and branches, DECISIO... |
| K | 2026-10-29 | DG | Ignition coil ground goes straight to the glove-box POWER box NEG bar through bulkhead cavity ... |
| L | 2026-10-29 | DG | Every connector part-way along a line or run breaks out at least 6 in (152 mm) off it; the last conn... |

**ST185-harness - every wiring harness of the car, one drawing set**


Layout - ST185-HeavyDC - ROUTE-1-HEAVYDC

| DRAWING NO. | REV | SHEET | SIZE | DRAWN | DATE |
|---|---|---|---|---|---|
| ST185-harness-LAY | L | 9 OF 35 | 432 x 279 mm | DG | 2026-10-29 |

ST185 Celica (living-relation) - generated by docs/harness/tools/build_drawings.py from docs/harness/MASTER-wirelist.csv; not to scale

**LAYOUT - ST185-HeavyDC - ROUTE 1 HEAVYDC, as approved (6 of 7)**

Top view for the figure above · same route, same colors. Projected from the figure above (approximate); this figure·s part is bright, the rest of the route is faded. Blue squares: B = bulkhead A/B (DRB102, RH firewall), R / L = RH / LH fender pass-throughs (Route 9 rev 2). Top view base: 1993 Celica repair manual RM305U1, Introduction, ·Vehicle Lift and Support Locations·, p. IN·24 (st185-celica-repair-manual\manuals\RM305U1 - Introduction - Ve...

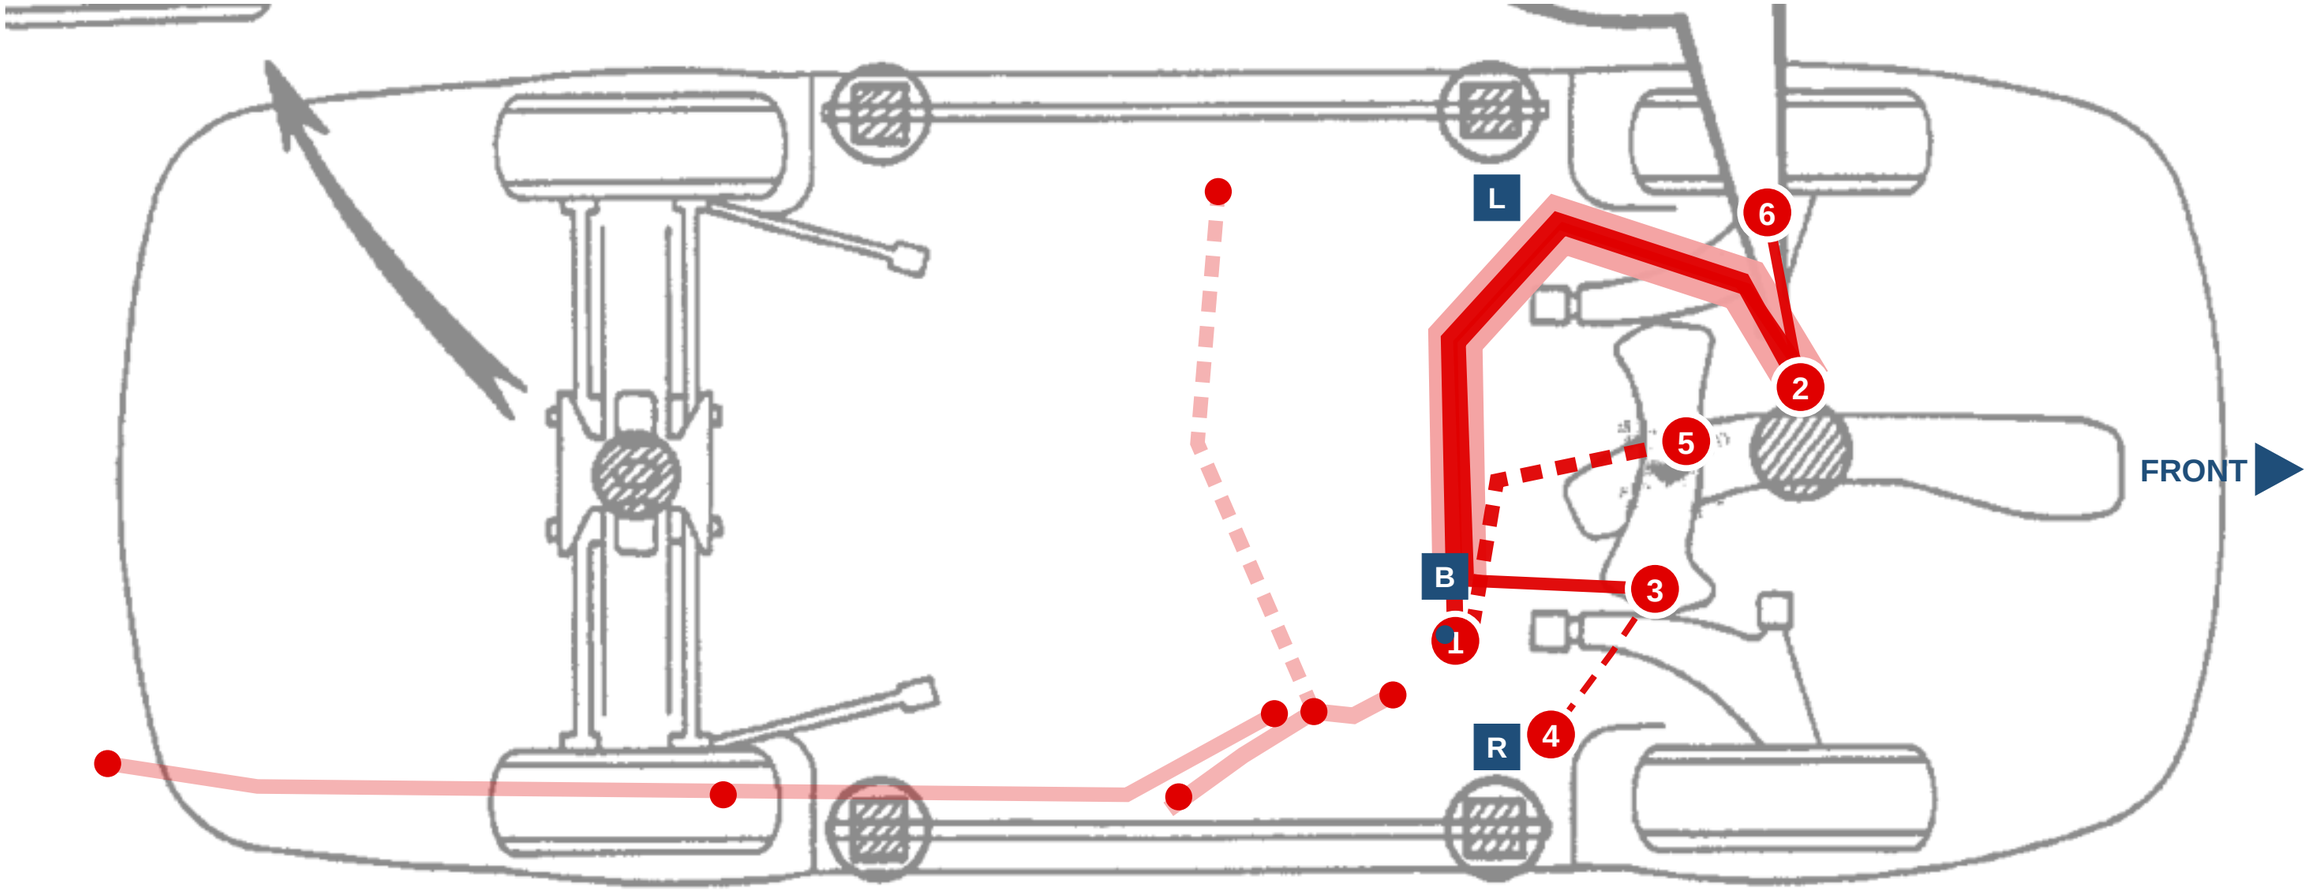


| REVISIONS | | | |
|---|---|---|---|
| REV | DATE | BY | DESCRIPTION |
| I | 2026-10-27 | DG | Crank and cam each run in one shielded Raychem cable (2-core / 3-core). The CAN-Lambda bra... |
| J | 2026-10-28 | DG | ECU engine harness layout tree built from Route 16 (Dan's device spots and branches, DECISIO... |
| K | 2026-10-29 | DG | Ignition coil ground goes straight to the glove-box POWER box NEG bar through bulkhead cavity ... |
| L | 2026-10-29 | DG | Every connector part-way along a line or run breaks out at least 6 in (152 mm) off it; the last conn... |

**ST185-harness - every wiring harness of the car, one drawing set**

Layout - ST185-HeavyDC - ROUTE-1-HEAVYDC


| DRAWING NO. | REV | SHEET | SIZE | DRAWN | DATE |
|---|---|---|---|---|---|
| ST185-harness-LAY | L | 10 OF 35 | 432 x 279 mm | DG | 2026-10-29 |

ST185 Celica (living-relation) - generated by docs/harness/tools/build_drawings.py from docs/harness/MASTER-wirelist.csv; not to scale


**LAYOUT - ST185-HeavyDC - ROUTE 1 HEAVYDC, as approved (7 of 7)**

Fig. 4 · Alternator connectors, TIS 1993 EWD ·Charging· p.75 (tis1993-charging.pdf, sheet 2). The sheet shows the All-Trac/4WD·s own G2 (A), gray, 3-pin; the harness is drawn for the G2 (B) round 3-pin plug (Toyota 90980-10341 / 90980-11491, DECISIONS S18 / R17), pins in the table below. G1 (C) is the B terminal ring. EWD connector sheet, so no top view: the Fig. 3 top view already shows the alternator (point 3) and its small-wire exit (poin...


.C/4WD) G 2 (A) GRAY

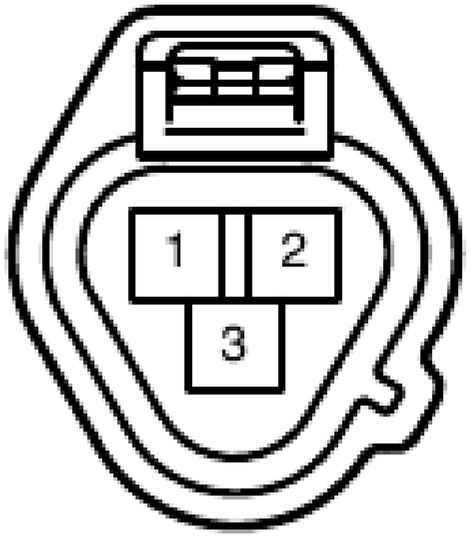


(2WD) G 2 (B) BLACK

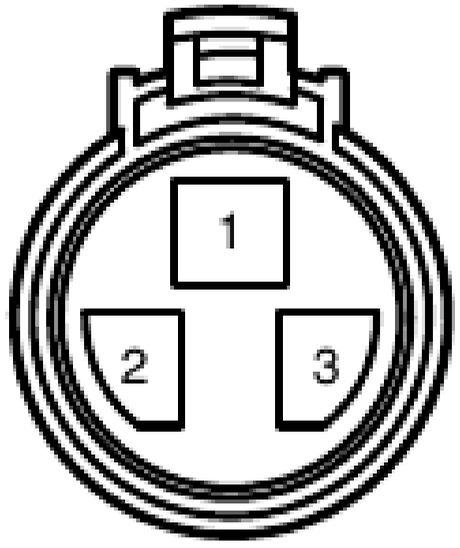


J 3

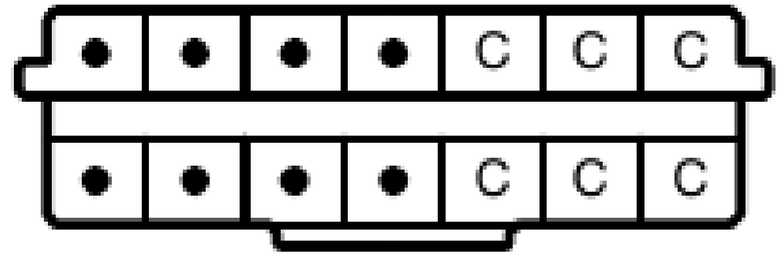


(HINT : SEE PAGE 7)

**REVISIONS**

| REV | DATE | BY | DESCRIPTION |
|---|---|---|---|
| I | 2026-10-27 | DG | Crank and cam each run in one shielded Raychem cable (2-core / 3-core). The CAN-Lambda bra... |
| J | 2026-10-28 | DG | ECU engine harness layout tree built from Route 16 (Dan's device spots and branches, DECISIO... |
| K | 2026-10-29 | DG | Ignition coil ground goes straight to the glove-box POWER box NEG bar through bulkhead cavity ... |
| L | 2026-10-29 | DG | Every connector part-way along a line or run breaks out at least 6 in (152 mm) off it; the last conn... |


**ST185-harness - every wiring harness of the car, one drawing set**

Layout - ST185-HeavyDC - ROUTE-1-HEAVYDC

| DRAWING NO. | REV | SHEET | SIZE | DRAWN | DATE |
|---|---|---|---|---|---|
| ST185-harness-LAY | L | 11 OF 35 | 432 x 279 mm | DG | 2026-10-29 |

**LAYOUT - ST185-CAN - ROUTE 8 CAN, as approved (1 of 4)**

Fig. 1 · Instrument panel, TIS 1993 EWD ·Relay Locations· p.18 (sheet 1). Red = the CAN trunk as one daisy-chained shielded twisted pair: ECU end (terminated) · CSB3 · center cluster · Pi/RealDash · bulkhead B · CAN-Lambda end (terminated, Fig. 2). Numbers match the key below. Cluster at the old combination-meter spot (J/B No.3 is behind it); CSB3 under the center cluster and the Pi at the center dash (Dan, 2026·10·10). Rev 2 reorders the c

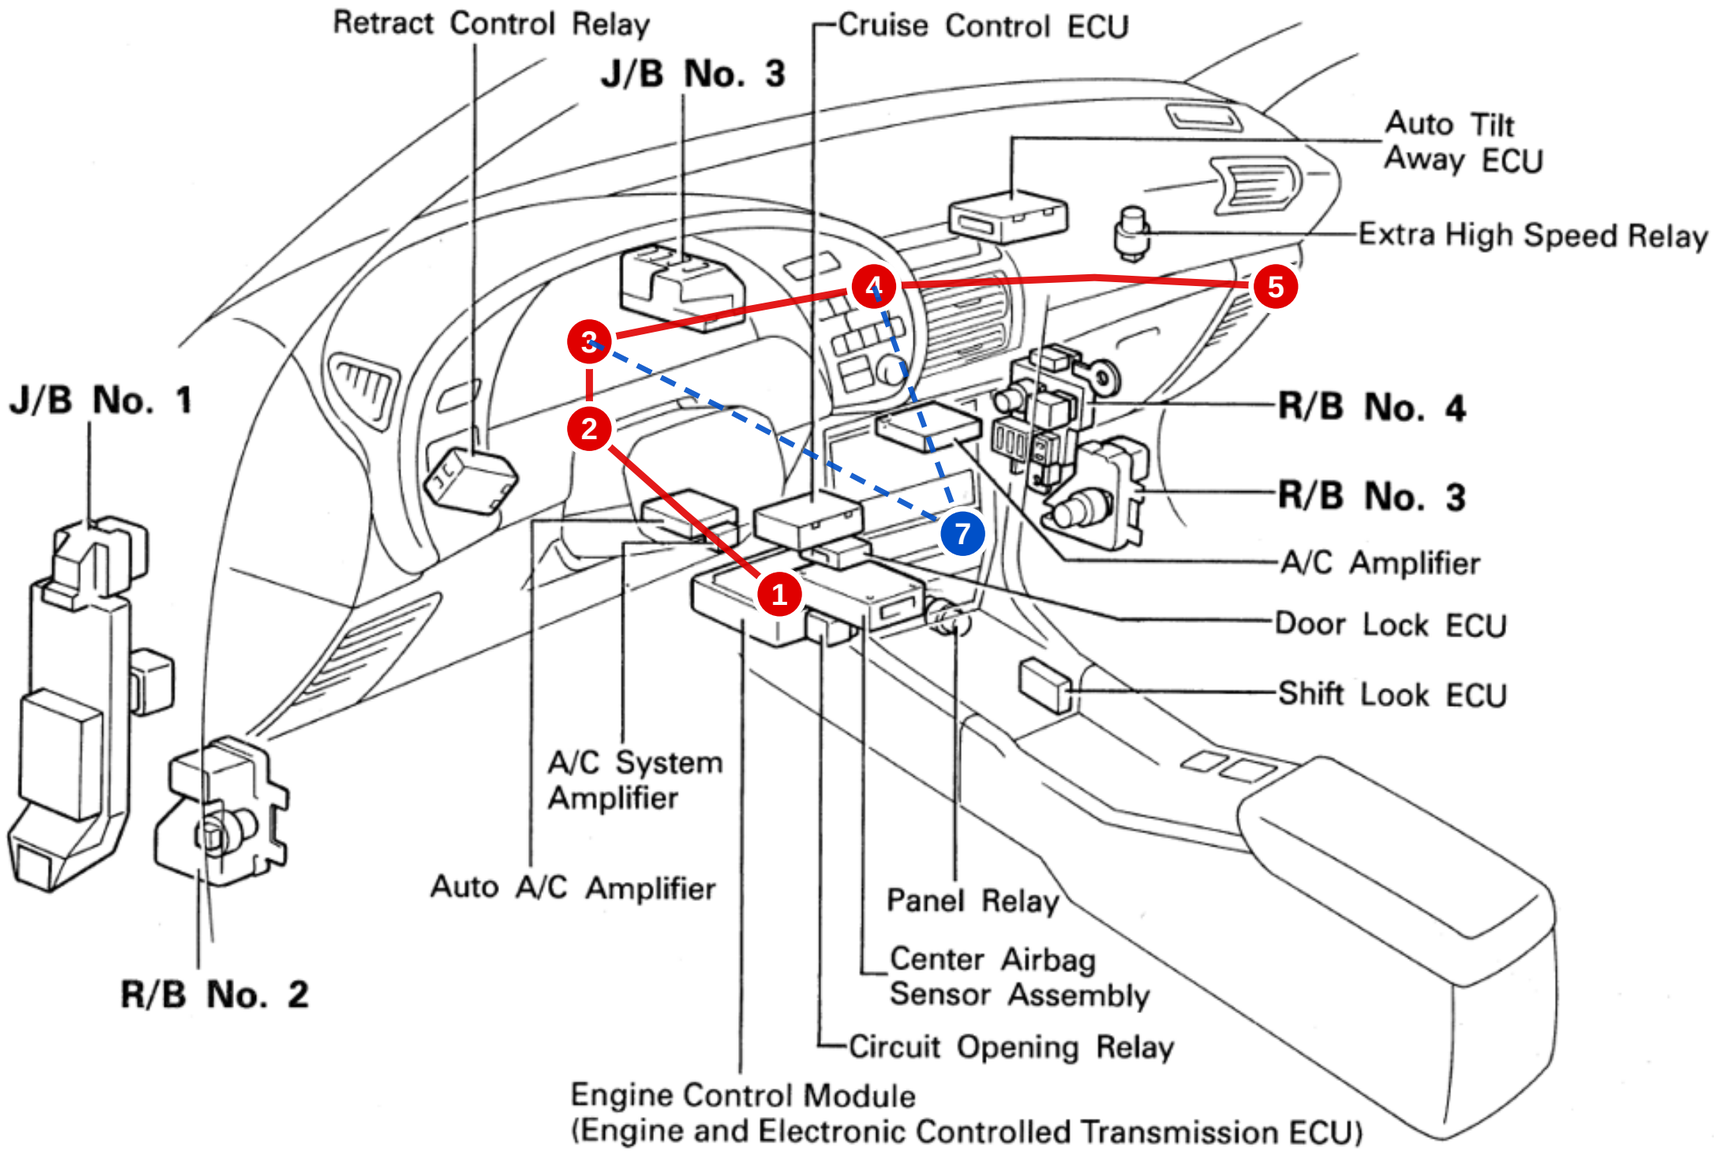


**REVISIONS**

| REV | DATE | BY | DESCRIPTION |
|---|---|---|---|
| I | 2026-10-27 | DG | Crank and cam each run in one shielded Raychem cable (2-core / 3-core). The CAN-Lambda bra... |
| J | 2026-10-28 | DG | ECU engine harness layout tree built from Route 16 (Dan's device spots and branches, DECISIO... |
| K | 2026-10-29 | DG | Ignition coil ground goes straight to the glove-box POWER box NEG bar through bulkhead cavity ... |
| L | 2026-10-29 | DG | Every connector part-way along a line or run breaks out at least 6 in (152 mm) off it; the last conn... |

**ST185-harness - every wiring harness of the car, one drawing set**

Layout - ST185-CAN - ROUTE-8-CAN


| DRAWING NO. | REV | SHEET | SIZE | DRAWN | DATE |
|---|---|---|---|---|---|
| ST185-harness-LAY | L | 12 OF 35 | 432 x 279 mm | DG | 2026-10-29 |

ST185 Celica (living-relation) - generated by docs/harness/tools/build_drawings.py from docs/harness/MASTER-wirelist.csv; not to scale

**LAYOUT - ST185-CAN - ROUTE 8 CAN, as approved (2 of 4)**

Top view for the figure above · same route, same colors. Projected from the figure above (approximate); this figure·s part is bright, the rest of the route is faded. Blue squares: B = bulkhead A/B (DRB102, RH firewall), R / L = RH / LH fender pass-throughs (Route 9 rev 2). Top view base: 1993 Celica repair manual RM305U1, Introduction, ·Vehicle Lift and Support Locations·, p. IN·24 (st185-celica-repair-manual\manuals\RM305U1 - Introduction - Ve...

## DRIVER (LH) SIDE

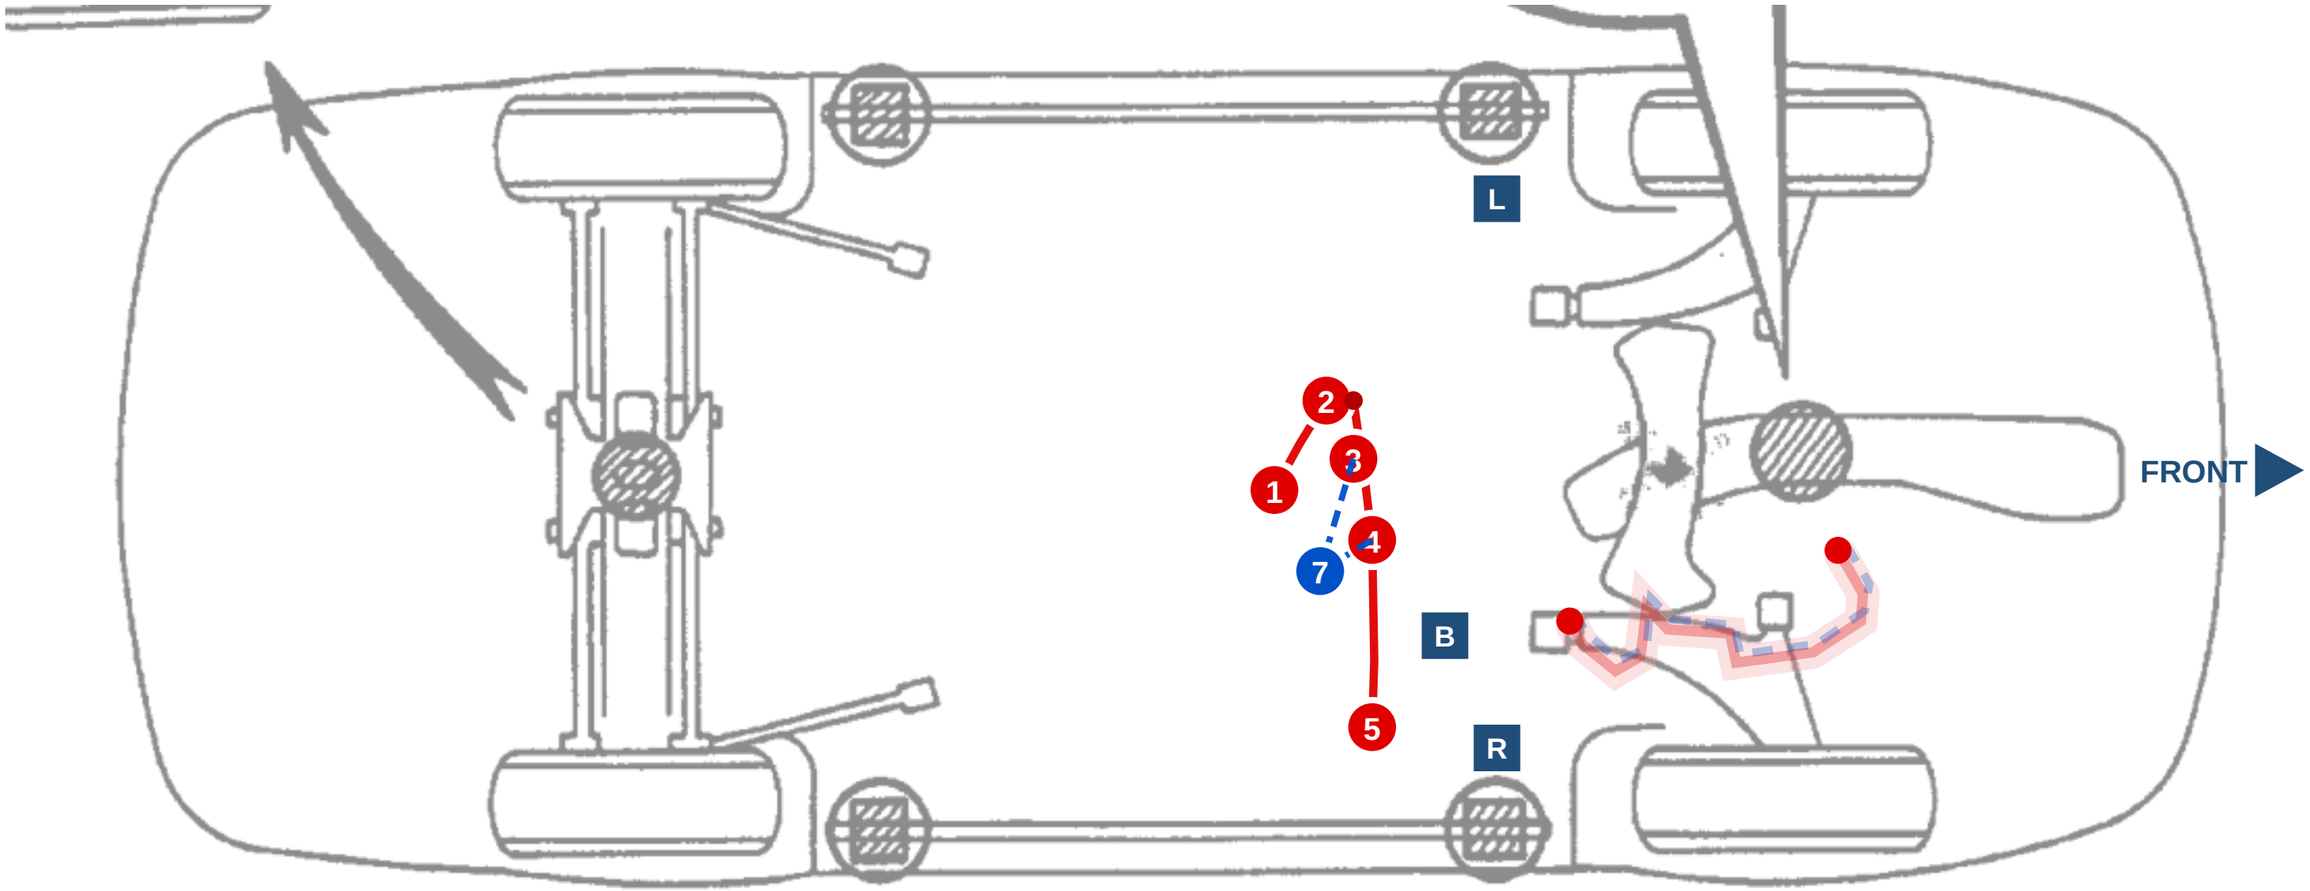


## PASSENGER (RH) SIDE

**REVISIONS**

| REV | DATE | BY | DESCRIPTION |
|---|---|---|---|
| I | 2026-10-27 | DG | Crank and cam each run in one shielded Raychem cable (2-core / 3-core). The CAN-Lambda bra... |
| J | 2026-10-28 | DG | ECU engine harness layout tree built from Route 16 (Dan's device spots and branches, DECISIO... |
| K | 2026-10-29 | DG | Ignition coil ground goes straight to the glove-box POWER box NEG bar through bulkhead cavity ... |
| L | 2026-10-29 | DG | Every connector part-way along a line or run breaks out at least 6 in (152 mm) off it; the last conn... |

**ST185-harness - every wiring harness of the car, one drawing set**


Layout - ST185-CAN - ROUTE-8-CAN

| DRAWING NO. | REV | SHEET | SIZE | DRAWN | DATE |
|---|---|---|---|---|---|
| ST185-harness-LAY | L | 13 OF 35 | 432 x 279 mm | DG | 2026-10-29 |

ST185 Celica (living-relation) - generated by docs/harness/tools/build_drawings.py from docs/harness/MASTER-wirelist.csv; not to scale

## LAYOUT - ST185-CAN - ROUTE 8 CAN, as approved (3 of 4)

Fig. 2 · Engine compartment, 3S-GTE, TIS 1993 EWD p.29 (sheet 2). Firewall at top, driver side on the right. Rev 4 (Dan·s blue mark-up): the CAN-Lambda run leaves bulkhead B (5), drops down along the existing factory harness through the middle of the bay, then turns over to the Link CAN-Lambda (6) · it does not cut straight across. Path is traced from Dan·s mark-up, so it·s approximate. red = CAN H / CAN L shielded twisted pair inside the s...

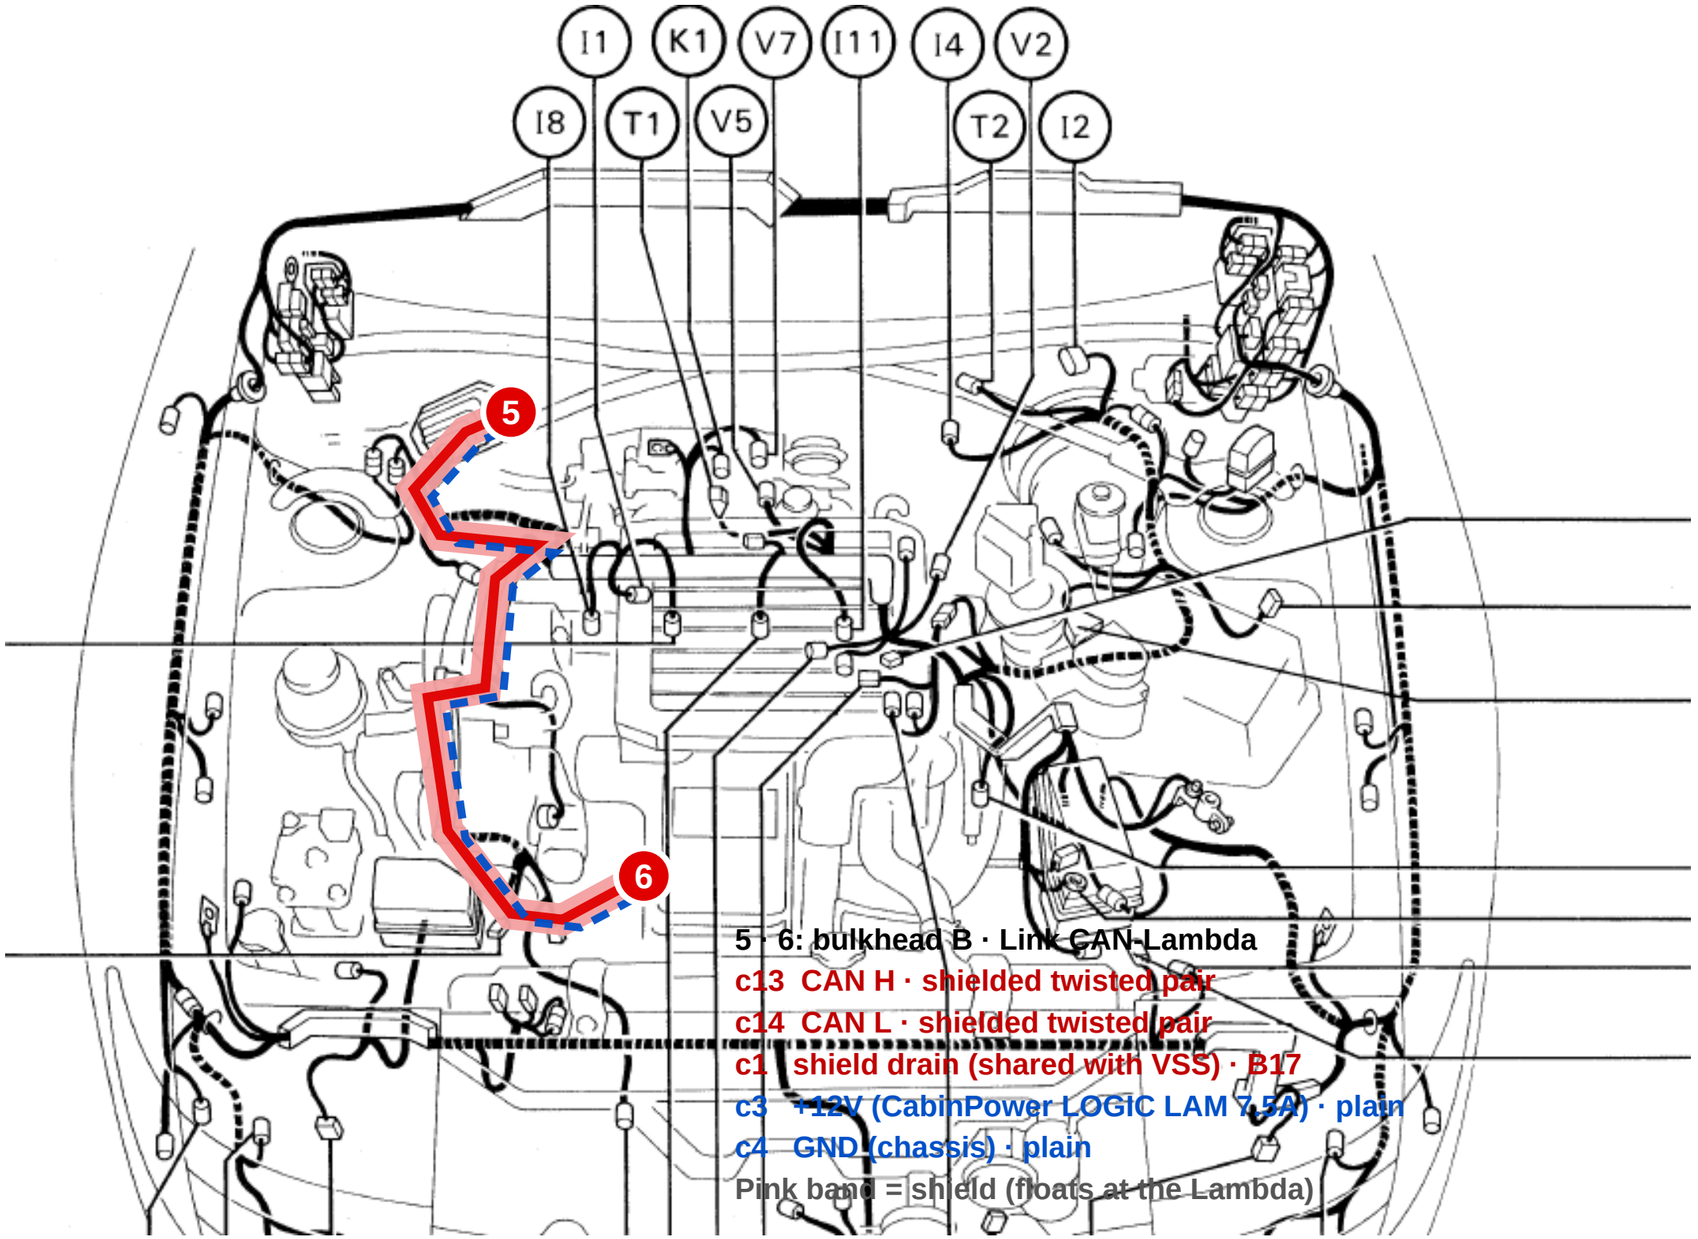


**REVISIONS**

| REV | DATE | BY | DESCRIPTION |
|---|---|---|---|
| I | 2026-10-27 | DG | Crank and cam each run in one shielded Raychem cable (2-core / 3-core). The CAN-Lambda bra... |
| J | 2026-10-28 | DG | ECU engine harness layout tree built from Route 16 (Dan's device spots and branches, DECISIO... |
| K | 2026-10-29 | DG | Ignition coil ground goes straight to the glove-box POWER box NEG bar through bulkhead cavity ... |
| L | 2026-10-29 | DG | Every connector part-way along a line or run breaks out at least 6 in (152 mm) off it; the last conn... |

**ST185-harness - every wiring harness of the car, one drawing set**


Layout - ST185-CAN - ROUTE-8-CAN

| DRAWING NO. | REV | SHEET | SIZE | DRAWN | DATE |
|---|---|---|---|---|---|
| ST185-harness-LAY | L | 14 OF 35 | 432 x 279 mm | DG | 2026-10-29 |

**LAYOUT - ST185-CAN - ROUTE 8 CAN, as approved (4 of 4)**

Top view for the figure above · same route, same colors. Projected from the figure above (approximate); this figure·s part is bright, the rest of the route is faded. Blue squares: B = bulkhead A/B (DRB102, RH firewall), R / L = RH / LH fender pass-throughs (Route 9 rev 2). Top view base: 1993 Celica repair manual RM305U1, Introduction, ·Vehicle Lift and Support Locations·, p. IN·24 (st185-celica-repair-manual\manuals\RM305U1 - Introduction - Ve...

## DRIVER (LH) SIDE

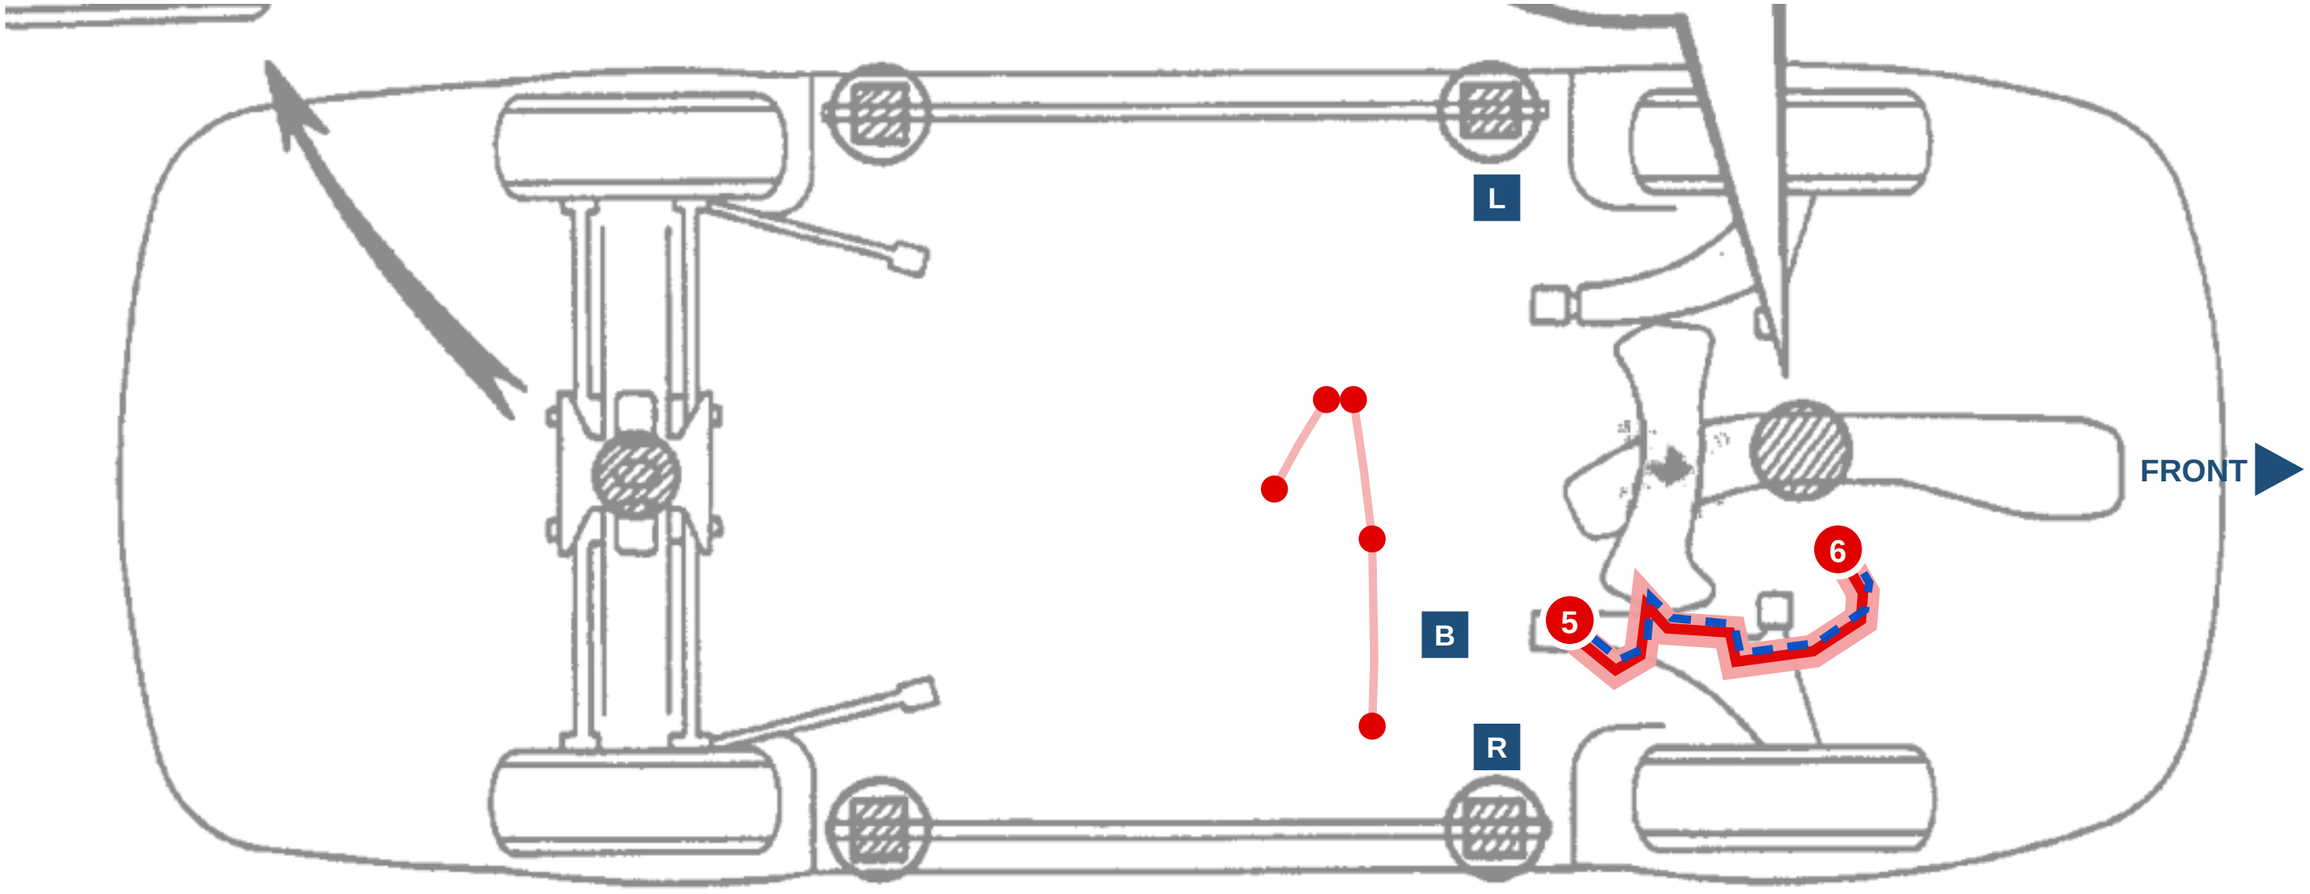


## PASSENGER (RH) SIDE

**REVISIONS**

| REV | DATE | BY | DESCRIPTION |
|---|---|---|---|
| I | 2026-10-27 | DG | Crank and cam each run in one shielded Raychem cable (2-core / 3-core). The CAN-Lambda bra... |
| J | 2026-10-28 | DG | ECU engine harness layout tree built from Route 16 (Dan's device spots and branches, DECISIO... |
| K | 2026-10-29 | DG | Ignition coil ground goes straight to the glove-box POWER box NEG bar through bulkhead cavity ... |
| L | 2026-10-29 | DG | Every connector part-way along a line or run breaks out at least 6 in (152 mm) off it; the last conn... |

**ST185-harness - every wiring harness of the car, one drawing set**


Layout - ST185-CAN - ROUTE-8-CAN

| DRAWING NO. | REV | SHEET | SIZE | DRAWN | DATE |
|---|---|---|---|---|---|
| ST185-harness-LAY | L | 15 OF 35 | 432 x 279 mm | DG | 2026-10-29 |

ST185 Celica (living-relation) - generated by docs/harness/tools/build_drawings.py from docs/harness/MASTER-wirelist.csv; not to scale

**LAYOUT - ST185-CSB3 - ROUTE 12 CSB3, as approved (1 of 2)**

Fig. 1 · Instrument panel, TIS 1993 EWD ·Relay Locations· p.18 (tis1993-relay-locations.pdf, sheet 1). Driver side left, glove box right. Deleted parts still drawn on this page are not used. Red solid = the CSB3 harness (plug + switch inputs). Dashed = wires that arrive broken off from other harnesses (reverse via bulkhead B, oil LED sink to ClusterLED, +12V / ground, +5V for the cruise ladder). CAN H/L to the CSB3 is in Route 8. The cruise stalk...

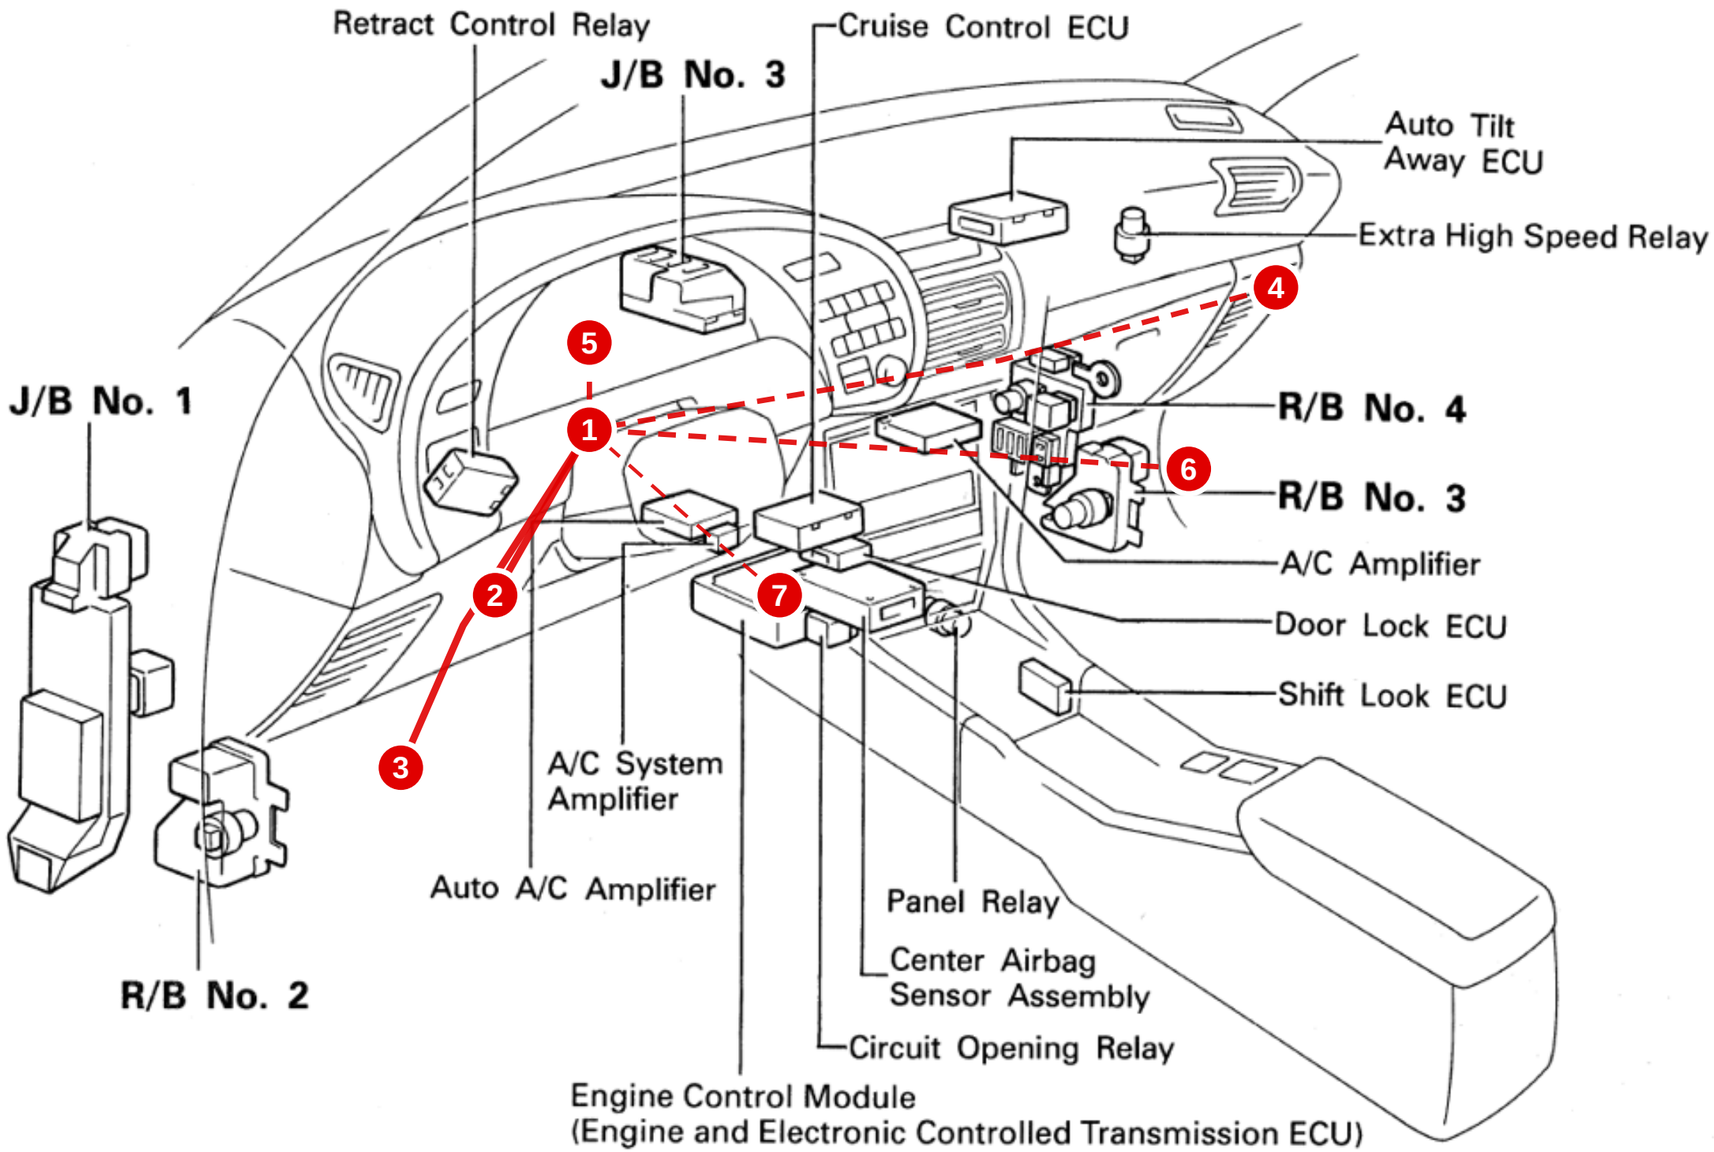


**REVISIONS**

| REV | DATE | BY | DESCRIPTION |
|---|---|---|---|
| I | 2026-10-27 | DG | Crank and cam each run in one shielded Raychem cable (2-core / 3-core). The CAN-Lambda bra... |
| J | 2026-10-28 | DG | ECU engine harness layout tree built from Route 16 (Dan's device spots and branches, DECISIO... |
| K | 2026-10-29 | DG | Ignition coil ground goes straight to the glove-box POWER box NEG bar through bulkhead cavity ... |
| L | 2026-10-29 | DG | Every connector part-way along a line or run breaks out at least 6 in (152 mm) off it; the last conn... |

**ST185-harness - every wiring harness of the car, one drawing set**

Layout - ST185-CSB3 - ROUTE-12-CSB3


| DRAWING NO. | REV | SHEET | SIZE | DRAWN | DATE |
|---|---|---|---|---|---|
| ST185-harness-LAY | L | 16 OF 35 | 432 x 279 mm | DG | 2026-10-29 |

ST185 Celica (living-relation) - generated by docs/harness/tools/build_drawings.py from docs/harness/MASTER-wirelist.csv; not to scale

**LAYOUT - ST185-CSB3 - ROUTE 12 CSB3, as approved (2 of 2)**

Top view for the figure above · same route, same colors. Projected from the figure above (approximate); this figure·s part is bright, the rest of the route is faded. Blue squares: B = bulkhead A/B (DRB102, RH firewall), R / L = RH / LH fender pass-throughs (Route 9 rev 2). Top view base: 1993 Celica repair manual RM305U1, Introduction, ·Vehicle Lift and Support Locations·, p. IN·24 (st185-celica-repair-manual\manuals\RM305U1 - Introduction - Ve...

## DRIVER (LH) SIDE

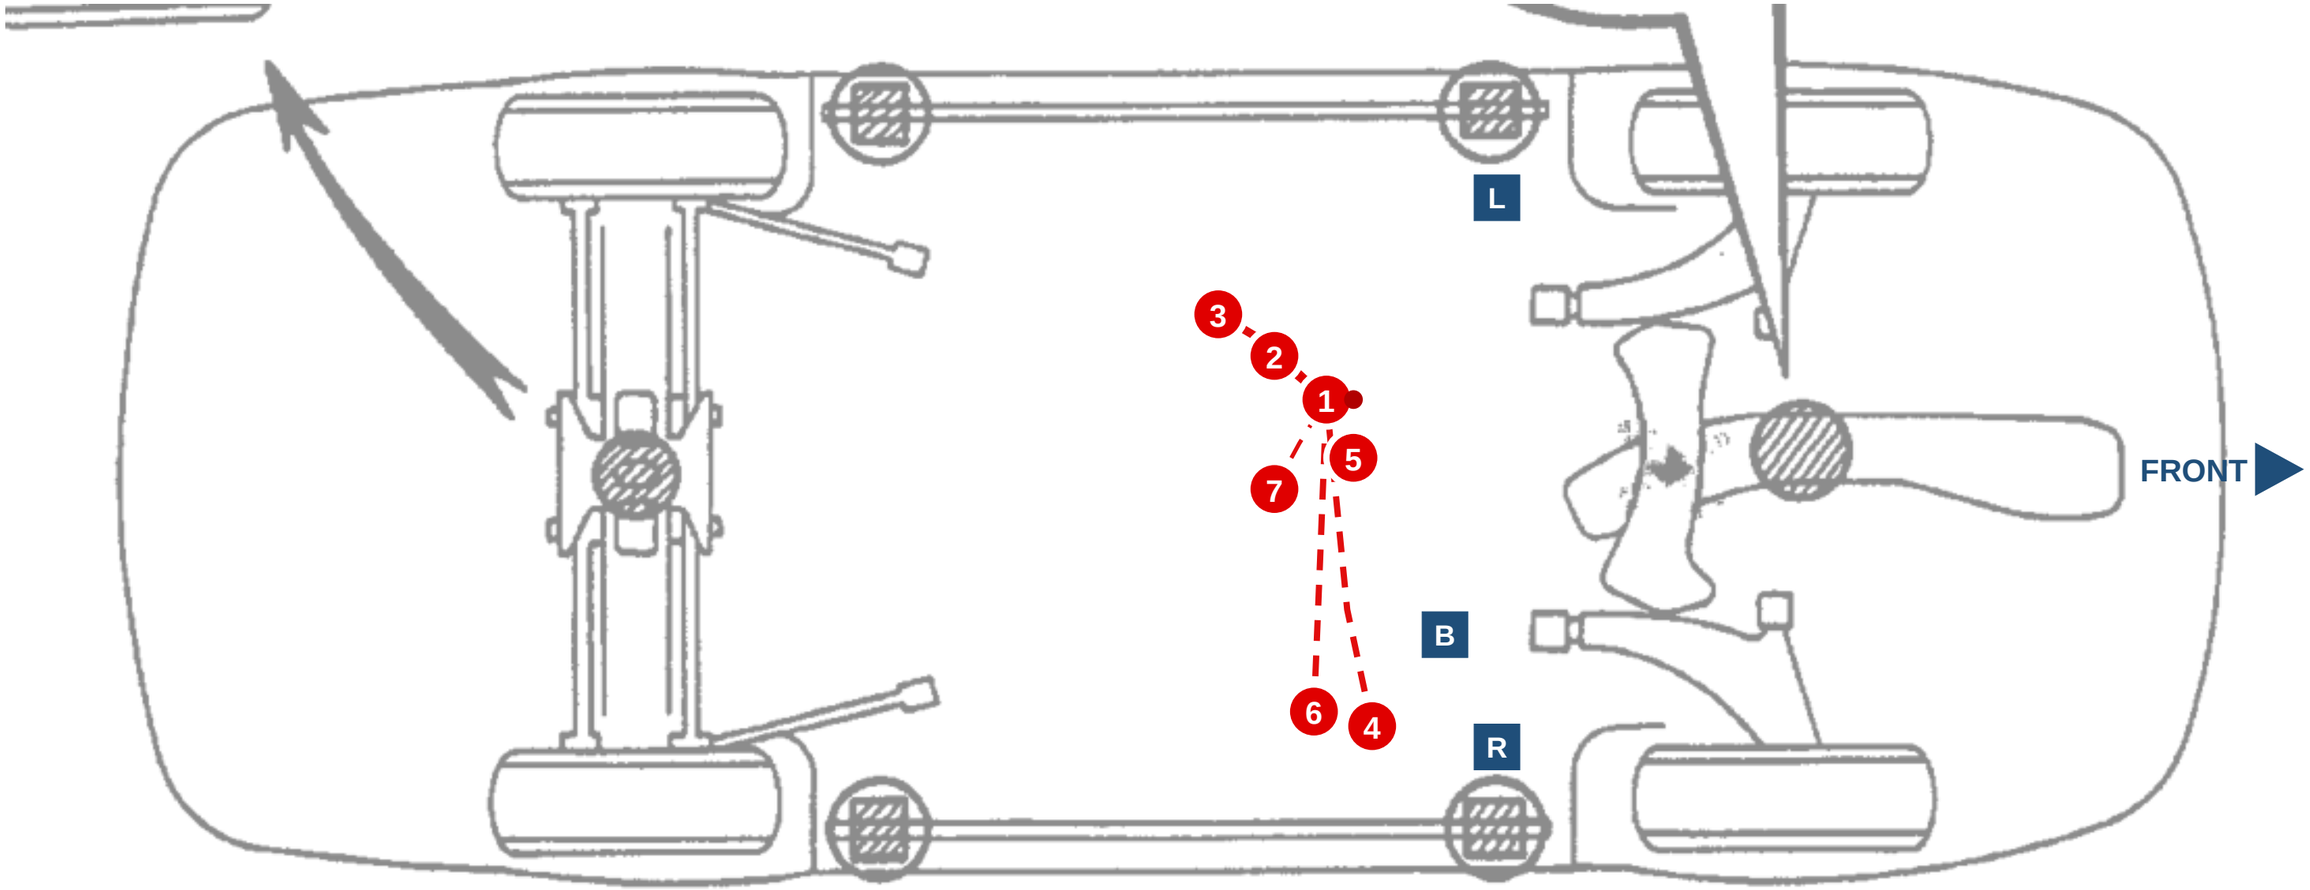


## PASSENGER (RH) SIDE

**REVISIONS**

| REV | DATE | BY | DESCRIPTION |
|---|---|---|---|
| I | 2026-10-27 | DG | Crank and cam each run in one shielded Raychem cable (2-core / 3-core). The CAN-Lambda bra... |
| J | 2026-10-28 | DG | ECU engine harness layout tree built from Route 16 (Dan's device spots and branches, DECISIO... |
| K | 2026-10-29 | DG | Ignition coil ground goes straight to the glove-box POWER box NEG bar through bulkhead cavity ... |
| L | 2026-10-29 | DG | Every connector part-way along a line or run breaks out at least 6 in (152 mm) off it; the last conn... |

**ST185-harness - every wiring harness of the car, one drawing set**


Layout - ST185-CSB3 - ROUTE-12-CSB3

| DRAWING NO. | REV | SHEET | SIZE | DRAWN | DATE |
|---|---|---|---|---|---|
| ST185-harness-LAY | L | 17 OF 35 | 432 x 279 mm | DG | 2026-10-29 |

ST185 Celica (living-relation) - generated by docs/harness/tools/build_drawings.py from docs/harness/MASTER-wirelist.csv; not to scale

**LAYOUT - ST185-AntiTheft - ROUTE 14 ANTITHEFT, as approved (1 of 4)**

Fig. 1 · Instrument panel, TIS 1993 EWD ·Relay Locations· p.18 (tis1993-relay-locations.pdf, sheet 1). Driver side left, glove box right. Deleted parts still drawn on this page are not used. Rev 2 (Dan·s answers, 2026·10·10): alarm module in the center dash just left of the ECU (1); immobiliser to ECU B27 (2); power from the glove-box LOGIC box (3); siren + hood-pin leads out through the existing factory RH fender grommet (harness C) (4, decided); s

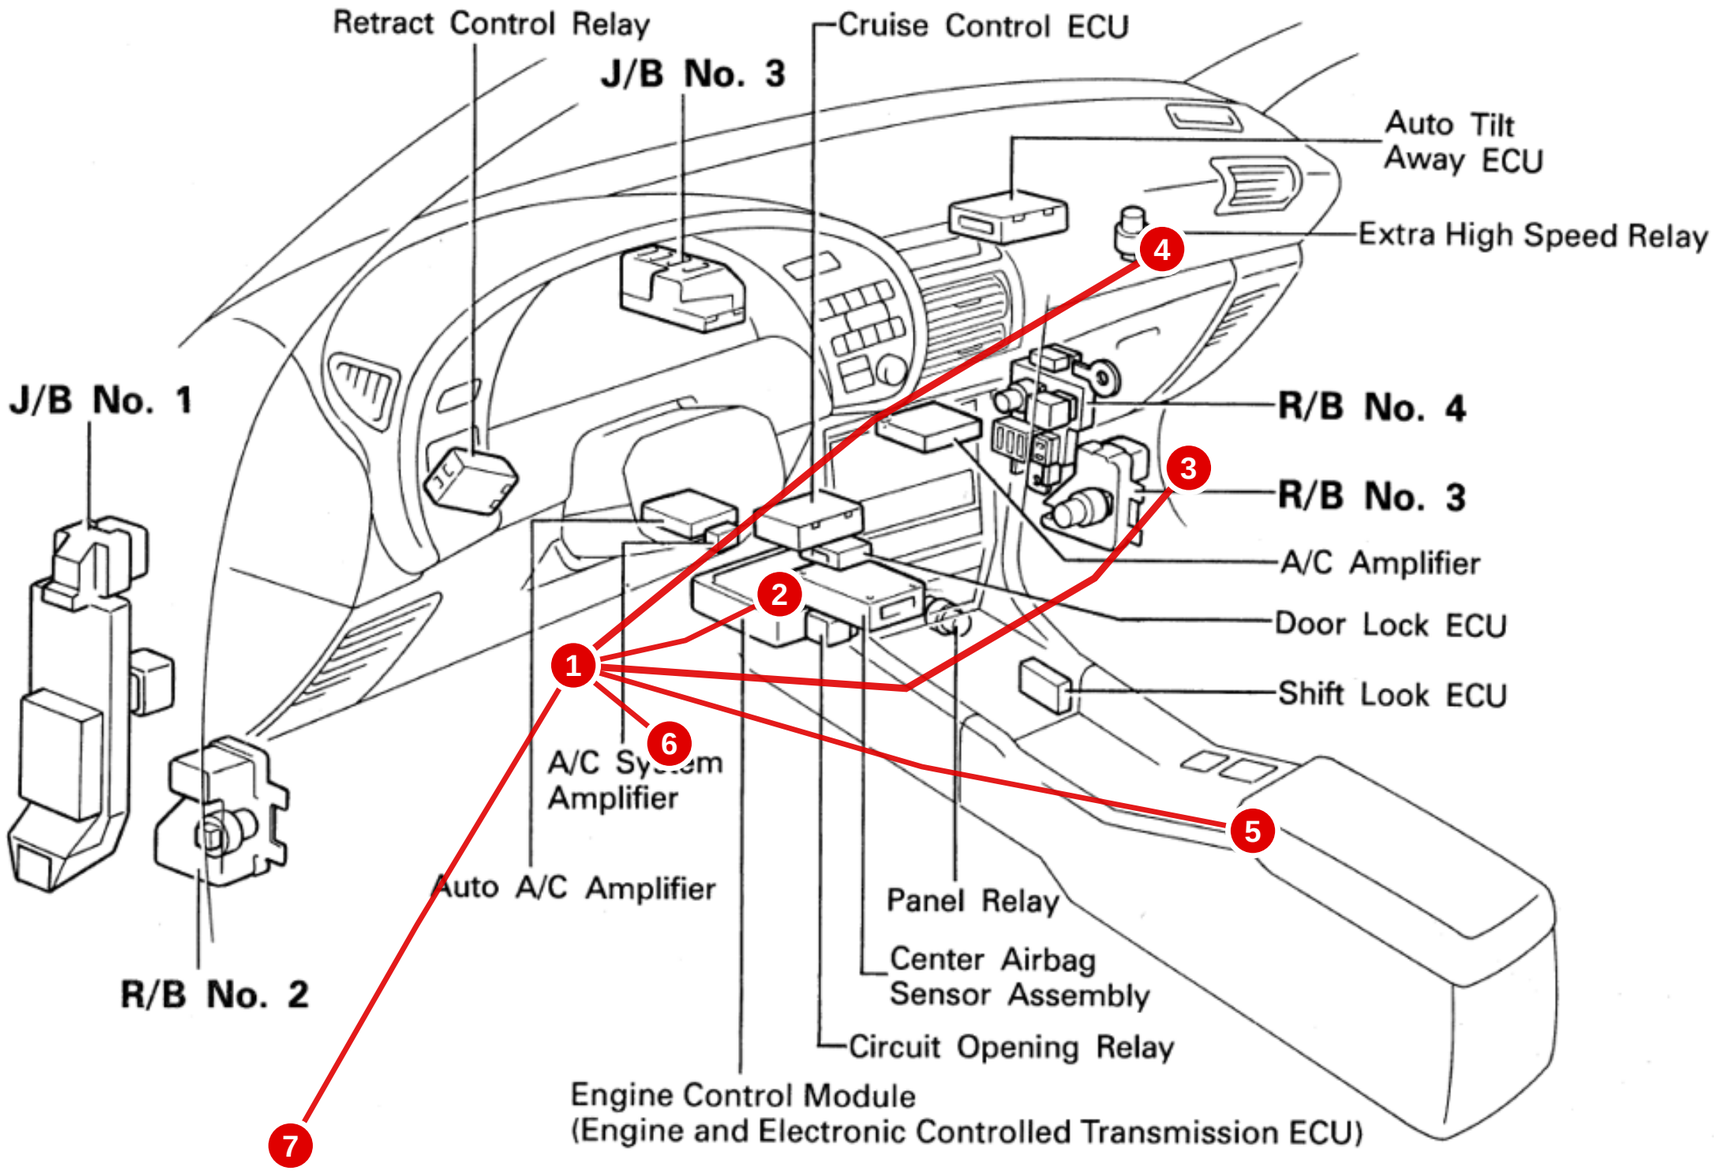


**REVISIONS**

| REV | DATE | BY | DESCRIPTION |
|---|---|---|---|
| I | 2026-10-27 | DG | Crank and cam each run in one shielded Raychem cable (2-core / 3-core). The CAN-Lambda bra... |
| J | 2026-10-28 | DG | ECU engine harness layout tree built from Route 16 (Dan's device spots and branches, DECISIO... |
| K | 2026-10-29 | DG | Ignition coil ground goes straight to the glove-box POWER box NEG bar through bulkhead cavity ... |
| L | 2026-10-29 | DG | Every connector part-way along a line or run breaks out at least 6 in (152 mm) off it; the last conn... |

**ST185-harness - every wiring harness of the car, one drawing set**

Layout - ST185-AntiTheft - ROUTE-14-ANTITHEFT


| DRAWING NO. | REV | SHEET | SIZE | DRAWN | DATE |
|---|---|---|---|---|---|
| ST185-harness-LAY | L | 18 OF 35 | 432 x 279 mm | DG | 2026-10-29 |

ST185 Celica (living-relation) - generated by docs/harness/tools/build_drawings.py from docs/harness/MASTER-wirelist.csv; not to scale

**LAYOUT - ST185-AntiTheft - ROUTE 14 ANTITHEFT, as approved (2 of 4)**

Top view for the figure above · same route, same colors. Projected from the figure above (approximate); this figure·s part is bright, the rest of the route is faded. Blue squares: B = bulkhead A/B (DRB102, RH firewall), R / L = RH / LH fender pass-throughs (Route 9 rev 2). Top view base: 1993 Celica repair manual RM305U1, Introduction, ·Vehicle Lift and Support Locations·, p. IN·24 (st185-celica-repair-manual\manuals\RM305U1 - Introduction - Ve...

## DRIVER (LH) SIDE

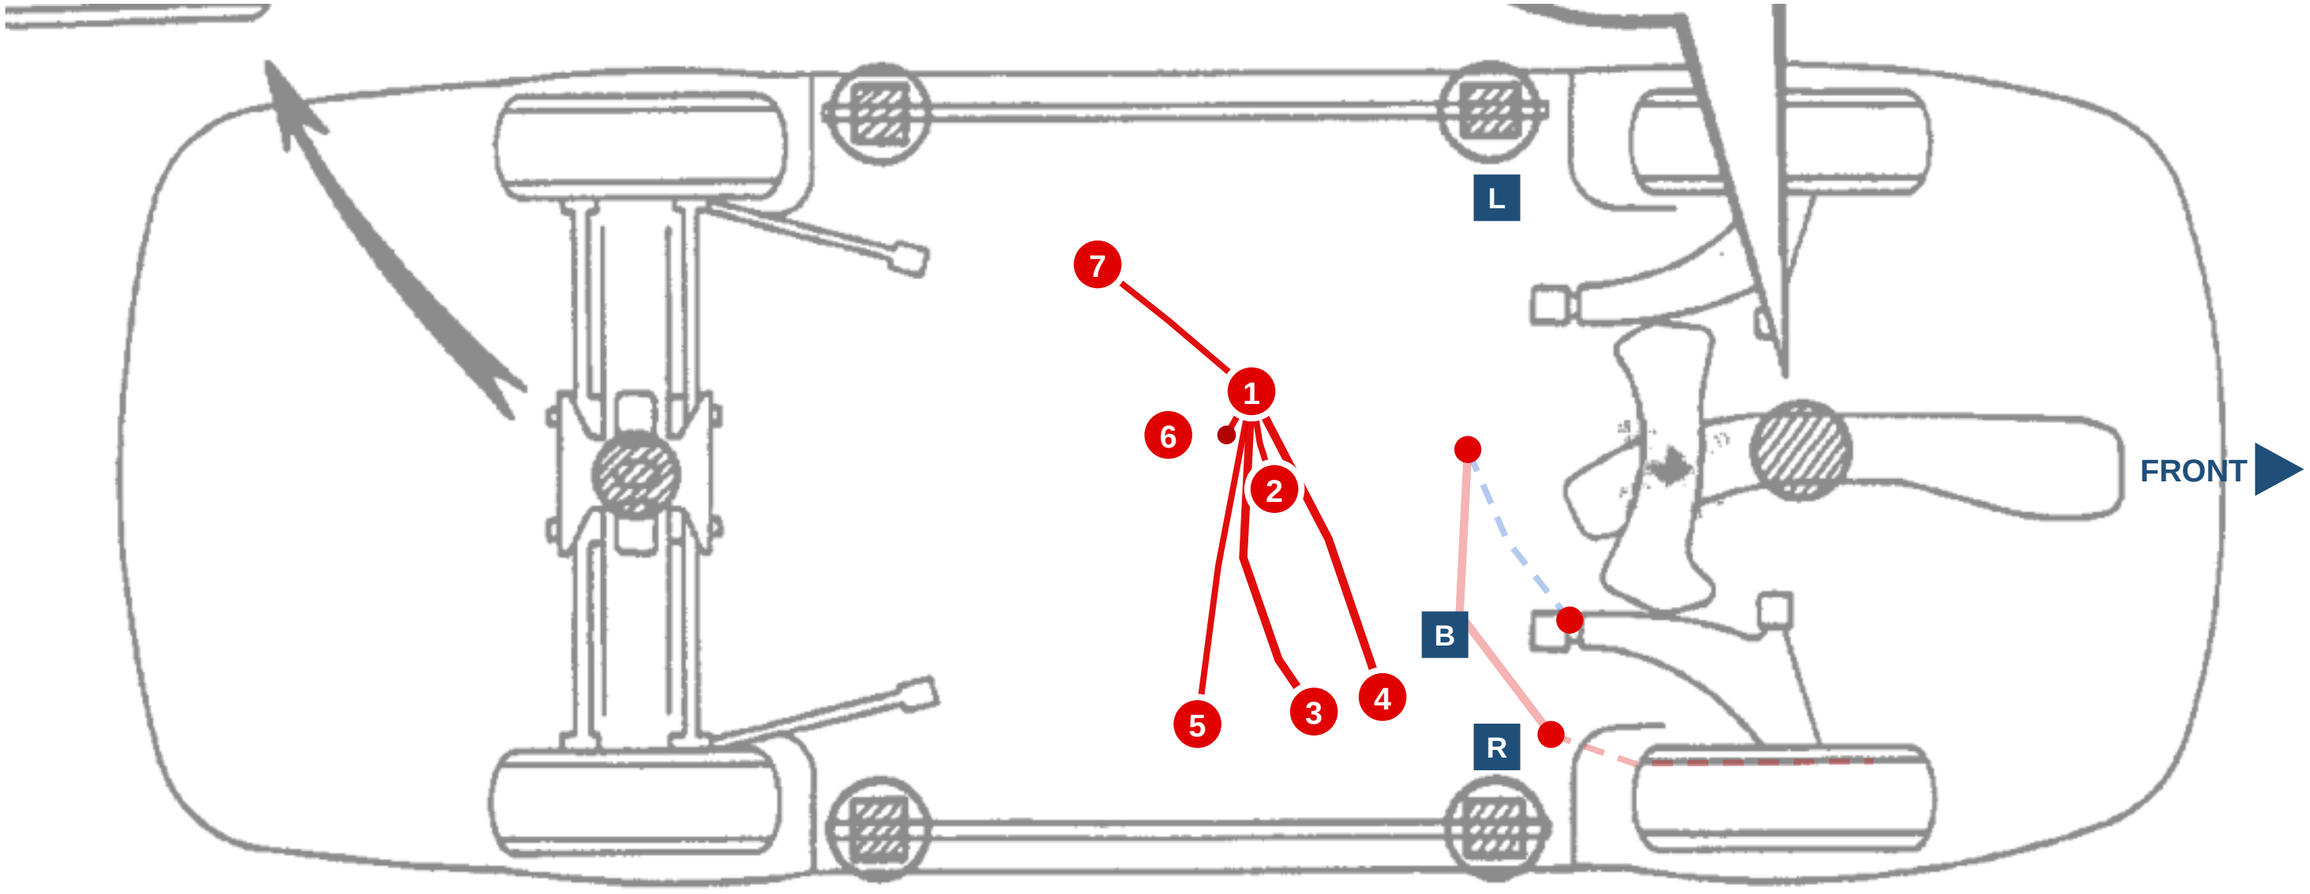


## PASSENGER (RH) SIDE

**REVISIONS**

| REV | DATE | BY | DESCRIPTION |
|---|---|---|---|
| I | 2026-10-27 | DG | Crank and cam each run in one shielded Raychem cable (2-core / 3-core). The CAN-Lambda bra... |
| J | 2026-10-28 | DG | ECU engine harness layout tree built from Route 16 (Dan's device spots and branches, DECISIO... |
| K | 2026-10-29 | DG | Ignition coil ground goes straight to the glove-box POWER box NEG bar through bulkhead cavity ... |
| L | 2026-10-29 | DG | Every connector part-way along a line or run breaks out at least 6 in (152 mm) off it; the last conn... |


**ST185-harness - every wiring harness of the car, one drawing set**

Layout - ST185-AntiTheft - ROUTE-14-ANTITHEFT

| DRAWING NO. | REV | SHEET | SIZE | DRAWN | DATE |
|---|---|---|---|---|---|
| ST185-harness-LAY | L | 19 OF 35 | 432 x 279 mm | DG | 2026-10-29 |

## LAYOUT - ST185-AntiTheft - ROUTE 14 ANTITHEFT, as approved (3 of 4)

Fig. 2 · Engine compartment, 3S-GTE, TIS 1993 EWD p.29 (tis1993-wiring-routing.pdf, sheet 2). Firewall at top, driver side on the right. Red solid = siren leads: in through the existing factory RH fender grommet (harness C) (4, top of the RH fender by the strut tower; decided, Dan: ·2. do it·), then along the firewall to the siren at the center of the firewall behind the engine (8). Red dashed = hood-pin lead riding harness C down the RH inner fend...

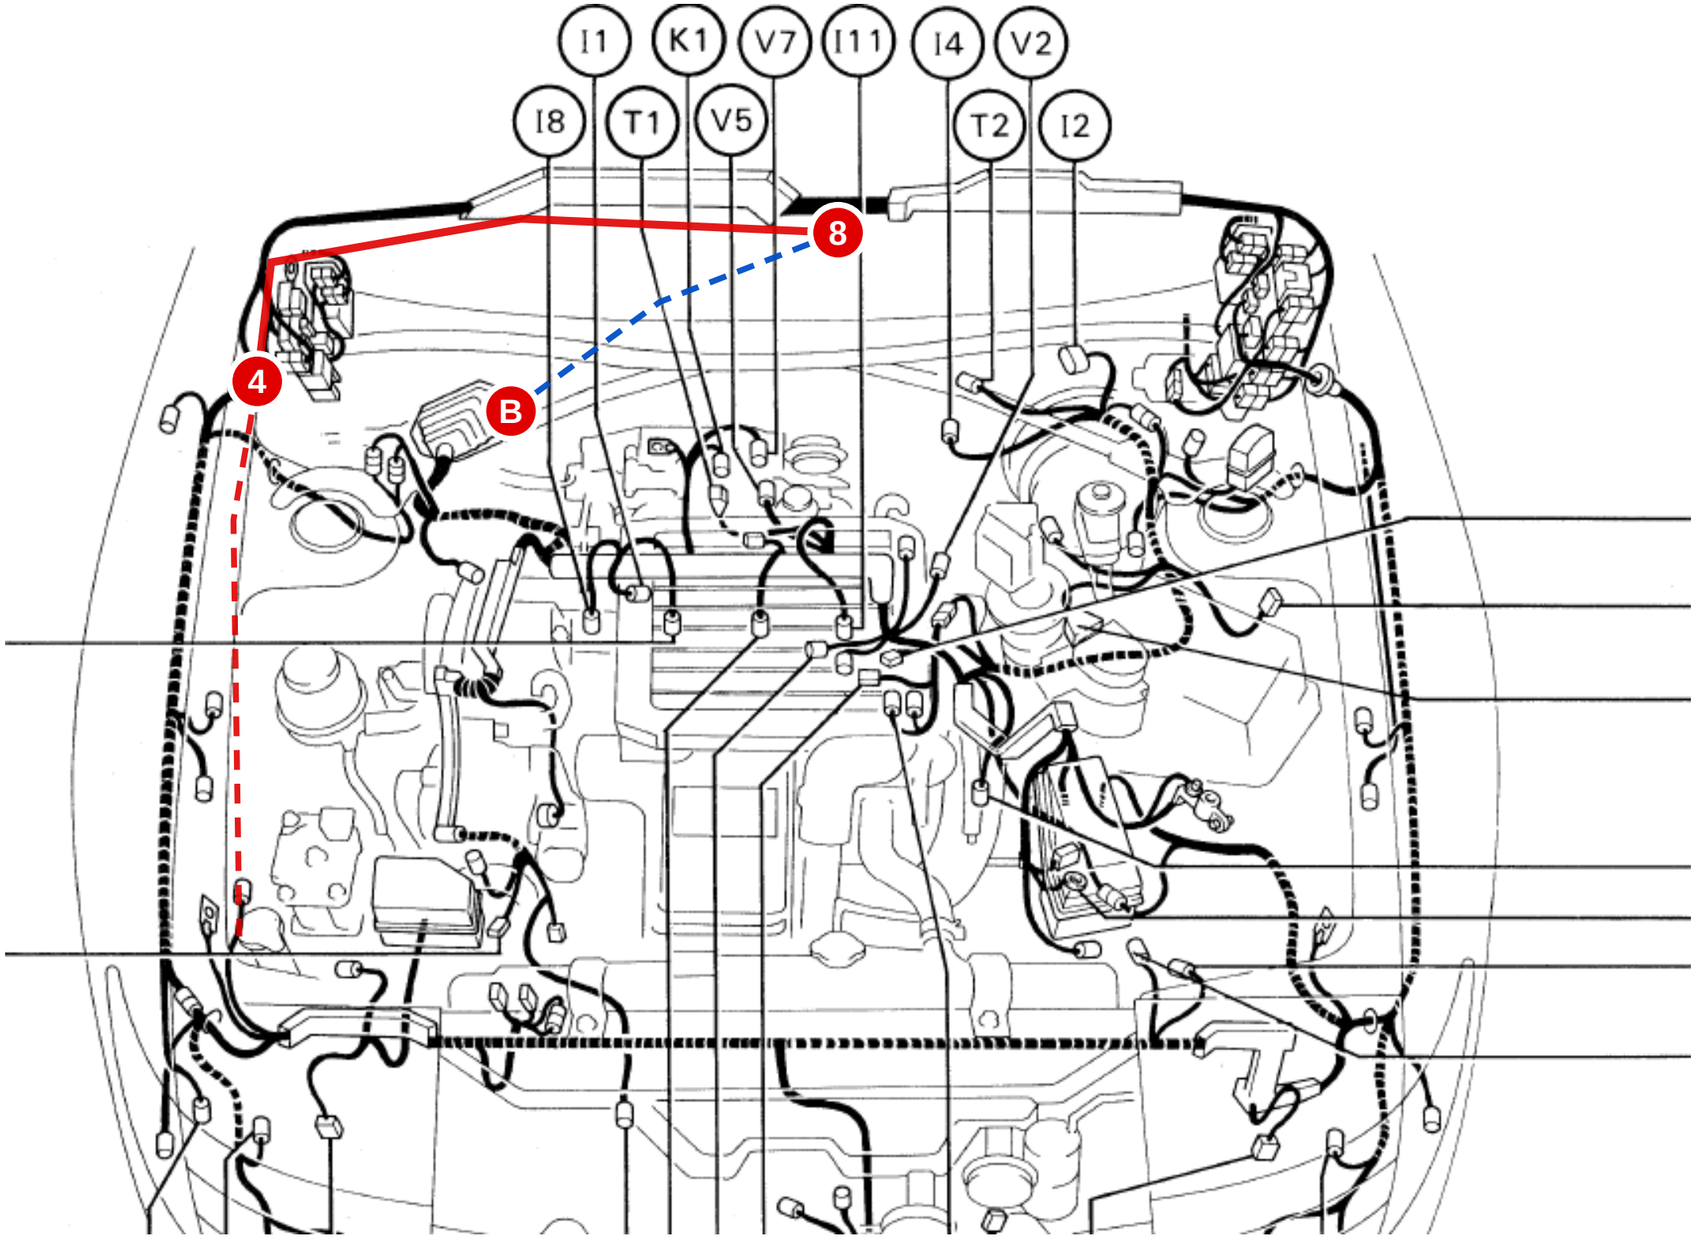


**REVISIONS**

| REV | DATE | BY | DESCRIPTION |
|---|---|---|---|
| I | 2026-10-27 | DG | Crank and cam each run in one shielded Raychem cable (2-core / 3-core). The CAN-Lambda bra... |
| J | 2026-10-28 | DG | ECU engine harness layout tree built from Route 16 (Dan's device spots and branches, DECISIO... |
| K | 2026-10-29 | DG | Ignition coil ground goes straight to the glove-box POWER box NEG bar through bulkhead cavity ... |
| L | 2026-10-29 | DG | Every connector part-way along a line or run breaks out at least 6 in (152 mm) off it; the last conn... |

**ST185-harness - every wiring harness of the car, one drawing set**


Layout - ST185-AntiTheft - ROUTE-14-ANTITHEFT

| DRAWING NO. | REV | SHEET | SIZE | DRAWN | DATE |
|---|---|---|---|---|---|
| ST185-harness-LAY | L | 20 OF 35 | 432 x 279 mm | DG | 2026-10-29 |

ST185 Celica (living-relation) - generated by docs/harness/tools/build_drawings.py from docs/harness/MASTER-wirelist.csv; not to scale

**LAYOUT - ST185-AntiTheft - ROUTE 14 ANTITHEFT, as approved (4 of 4)**

Top view for the figure above · same route, same colors. Projected from the figure above (approximate); this figure·s part is bright, the rest of the route is faded. Blue squares: B = bulkhead A/B (DRB102, RH firewall), R / L = RH / LH fender pass-throughs (Route 9 rev 2). Top view base: 1993 Celica repair manual RM305U1, Introduction, ·Vehicle Lift and Support Locations·, p. IN·24 (st185-celica-repair-manual\manuals\RM305U1 - Introduction - Ve...

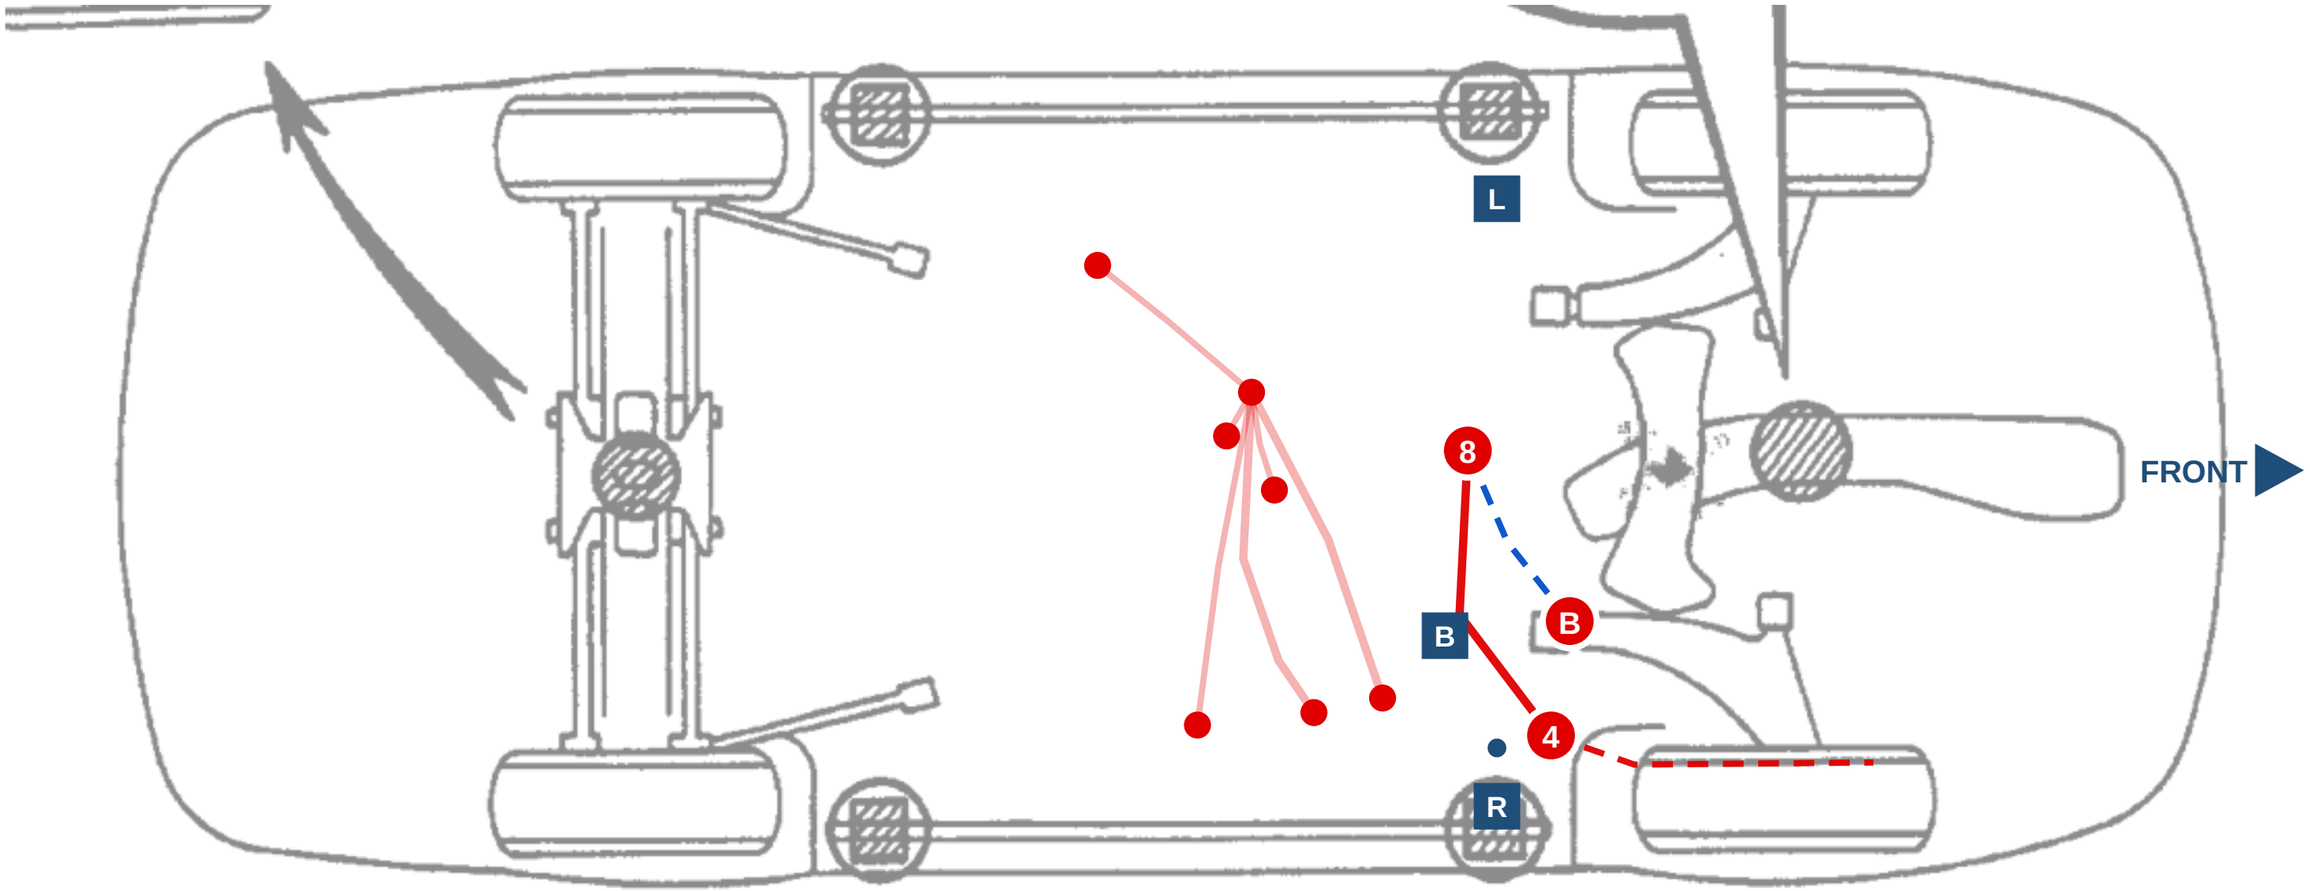


| REVISIONS | | | |
|---|---|---|---|
| REV | DATE | BY | DESCRIPTION |
| I | 2026-10-27 | DG | Crank and cam each run in one shielded Raychem cable (2-core / 3-core). The CAN-Lambda bra... |
| J | 2026-10-28 | DG | ECU engine harness layout tree built from Route 16 (Dan's device spots and branches, DECISIO... |
| K | 2026-10-29 | DG | Ignition coil ground goes straight to the glove-box POWER box NEG bar through bulkhead cavity ... |
| L | 2026-10-29 | DG | Every connector part-way along a line or run breaks out at least 6 in (152 mm) off it; the last conn... |

**ST185-harness - every wiring harness of the car, one drawing set**


Layout - ST185-AntiTheft - ROUTE-14-ANTITHEFT

| DRAWING NO. | REV | SHEET | SIZE | DRAWN | DATE |
|---|---|---|---|---|---|
| ST185-harness-LAY | L | 21 OF 35 | 432 x 279 mm | DG | 2026-10-29 |

ST185 Celica (living-relation) - generated by docs/harness/tools/build_drawings.py from docs/harness/MASTER-wirelist.csv; not to scale

**LAYOUT - ST185-ClusterLED - ROUTE 13 CLUSTERLED, as approved (1 of 2)**

Fig. 1 · Instrument panel, TIS 1993 EWD ·Relay Locations· p.18 (tis1993-relay-locations.pdf, sheet 1). Driver side left, glove box right. Deleted parts still drawn on this page are not used. Red solid = ClusterLED: the LED board at the old combination-meter spot (center cluster), tapping the factory meter connectors C11 / C12 with flying leads, and the LED common return to OEM ground ID at the left kick panel. Dashed = the oil-pressure LED sig...

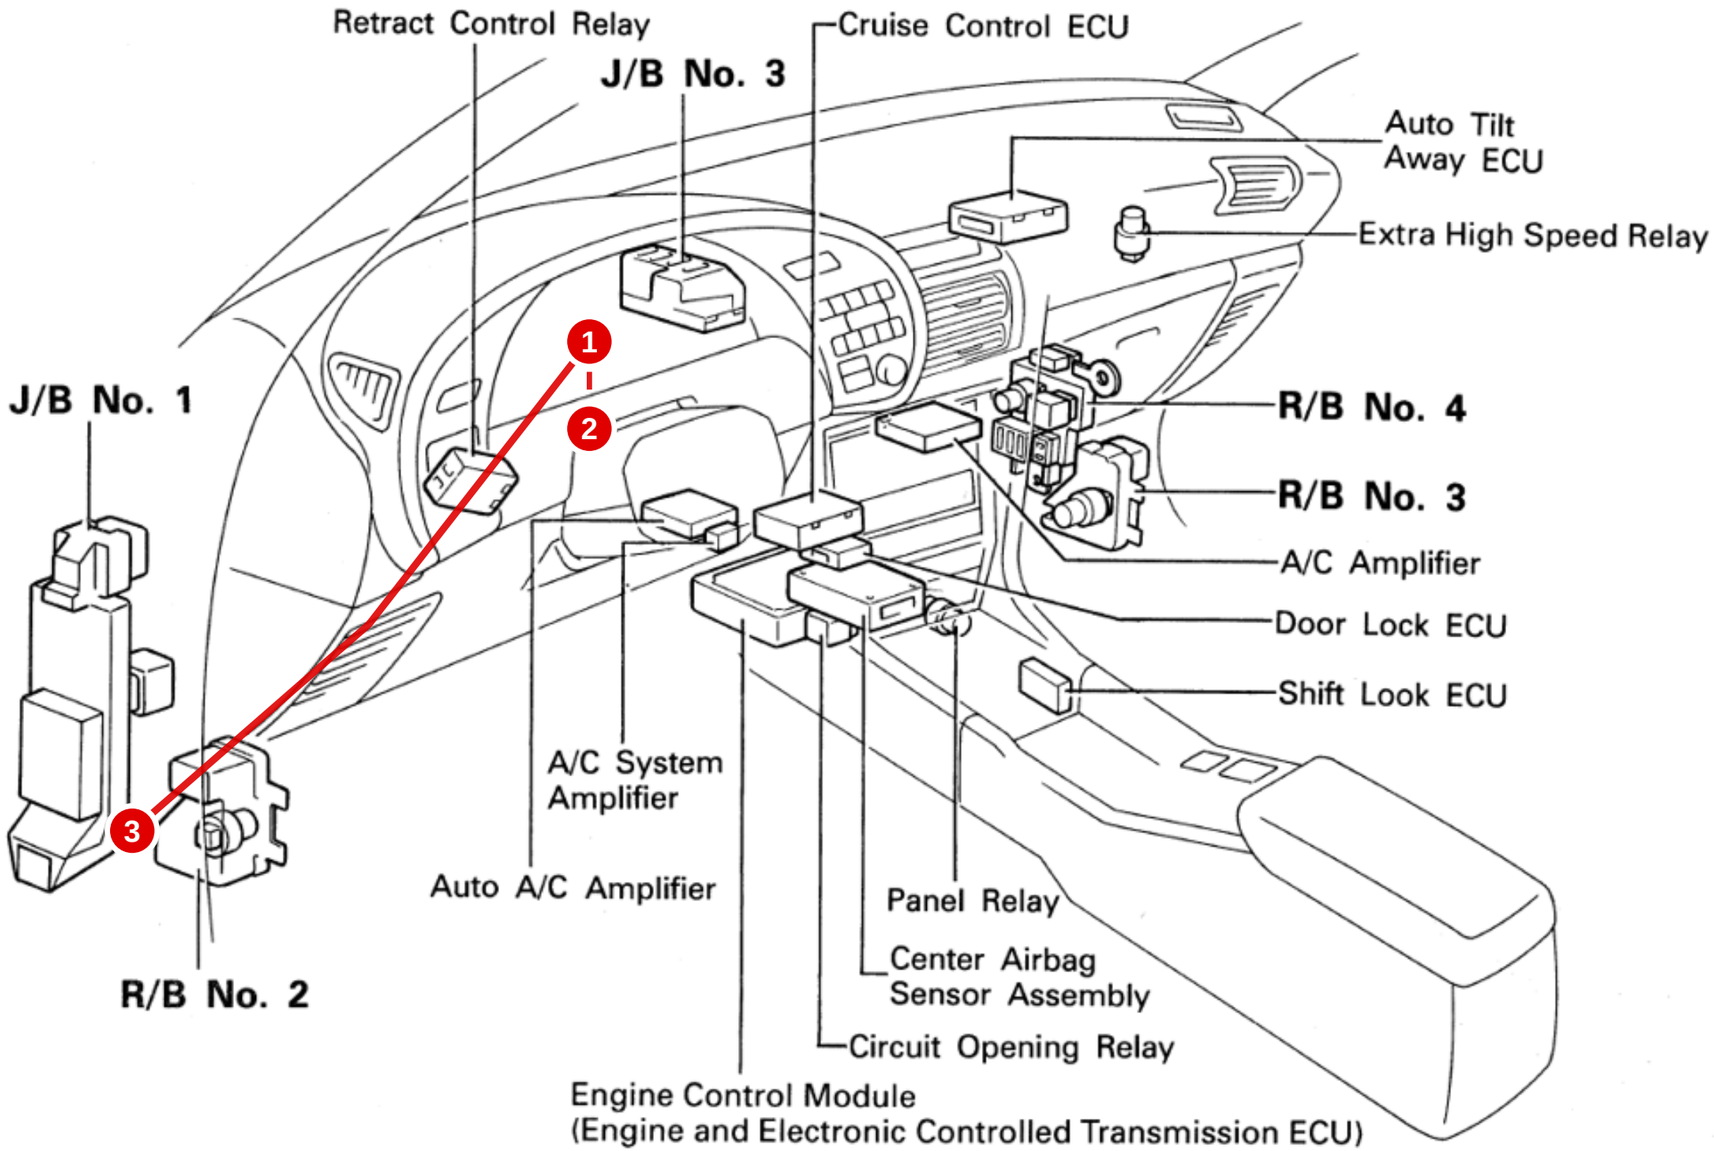


| REVISIONS | | | |
|---|---|---|---|
| REV | DATE | BY | DESCRIPTION |
| I | 2026-10-27 | DG | Crank and cam each run in one shielded Raychem cable (2-core / 3-core). The CAN-Lambda bra... |
| J | 2026-10-28 | DG | ECU engine harness layout tree built from Route 16 (Dan's device spots and branches, DECISIO... |
| K | 2026-10-29 | DG | Ignition coil ground goes straight to the glove-box POWER box NEG bar through bulkhead cavity ... |
| L | 2026-10-29 | DG | Every connector part-way along a line or run breaks out at least 6 in (152 mm) off it; the last conn... |

**ST185-harness - every wiring harness of the car, one drawing set**

Layout - ST185-ClusterLED - ROUTE-13-CLUSTERLED


| DRAWING NO. | REV | SHEET | SIZE | DRAWN | DATE |
|---|---|---|---|---|---|
| ST185-harness-LAY | L | 22 OF 35 | 432 x 279 mm | DG | 2026-10-29 |

ST185 Celica (living-relation) - generated by docs/harness/tools/build_drawings.py from docs/harness/MASTER-wirelist.csv; not to scale

**LAYOUT - ST185-ClusterLED - ROUTE 13 CLUSTERLED, as approved (2 of 2)**

Top view for the figure above · same route, same colors. Projected from the figure above (approximate); this figure·s part is bright, the rest of the route is faded. Blue squares: B = bulkhead A/B (DRB102, RH firewall), R / L = RH / LH fender pass-throughs (Route 9 rev 2). Top view base: 1993 Celica repair manual RM305U1, Introduction, ·Vehicle Lift and Support Locations·, p. IN·24 (st185-celica-repair-manual\manuals\RM305U1 - Introduction - Ve...

## DRIVER (LH) SIDE

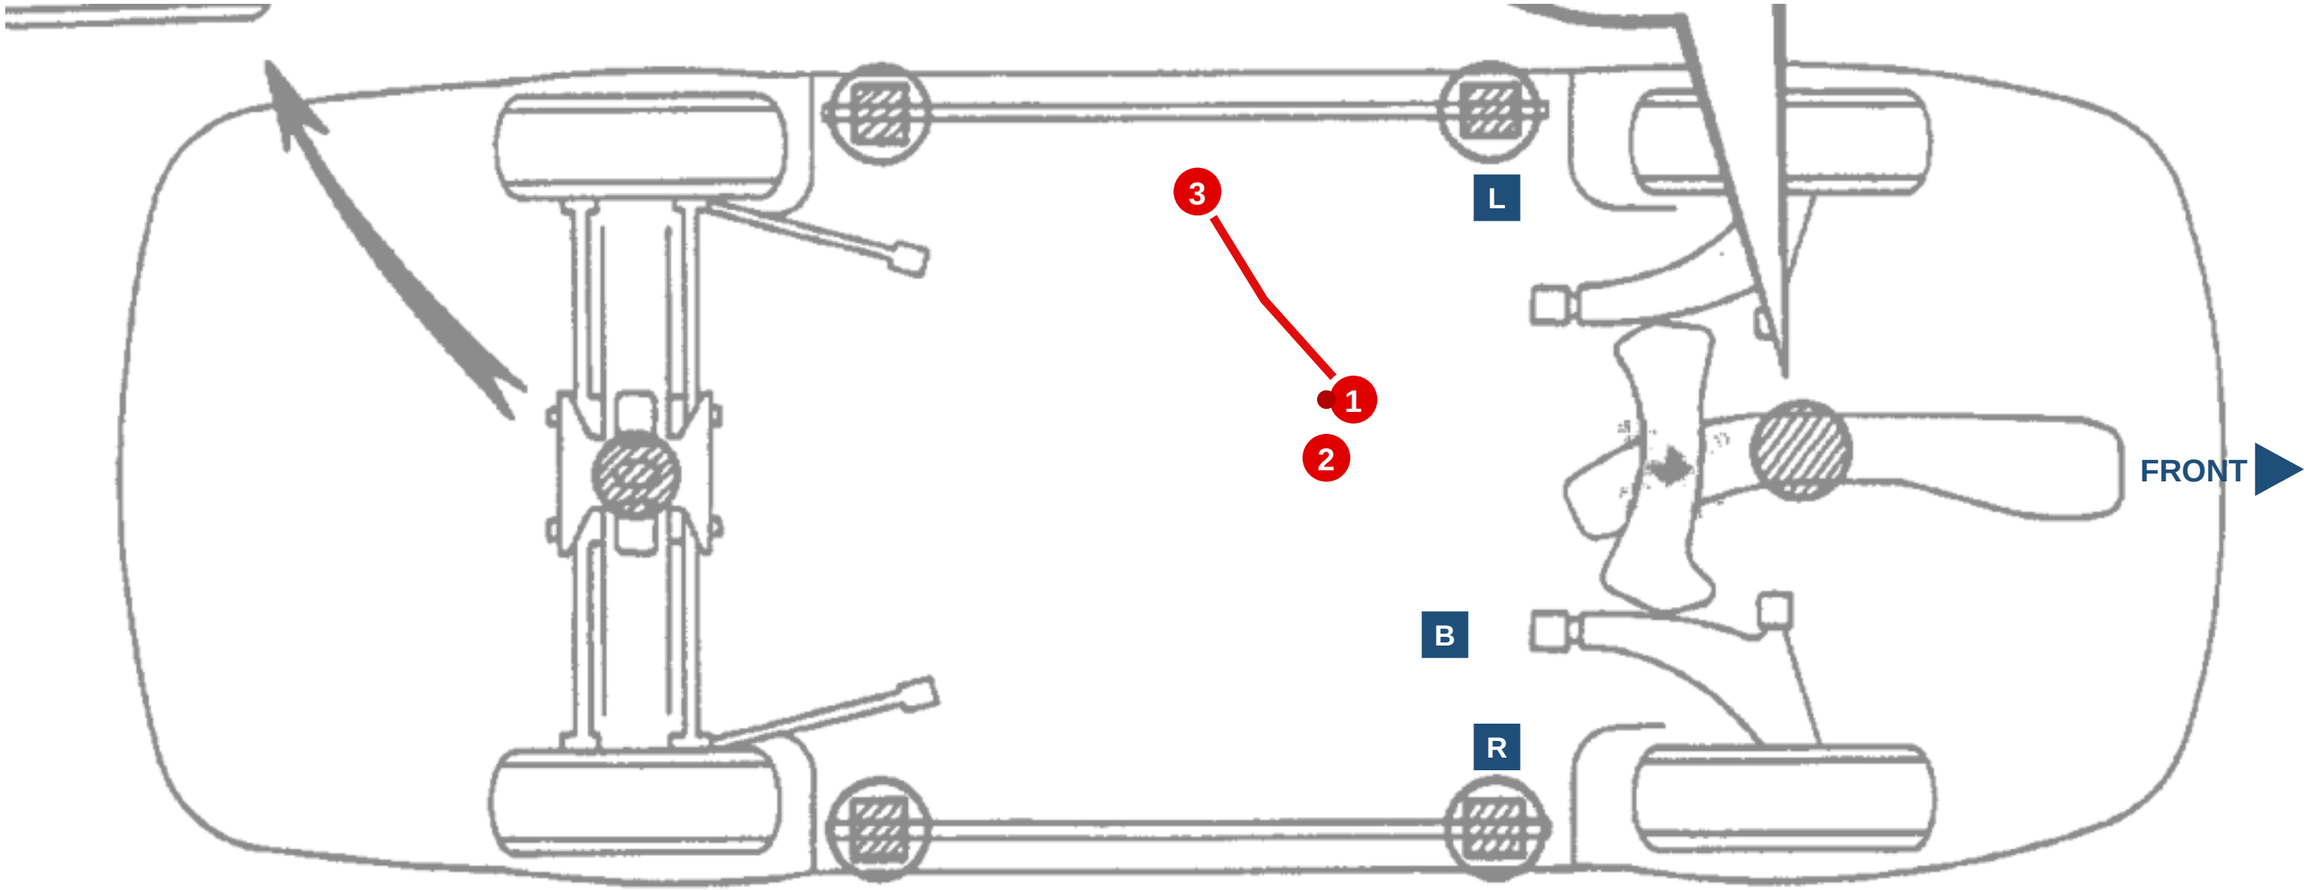


## PASSENGER (RH) SIDE

**REVISIONS**

| REV | DATE | BY | DESCRIPTION |
|---|---|---|---|
| I | 2026-10-27 | DG | Crank and cam each run in one shielded Raychem cable (2-core / 3-core). The CAN-Lambda bra... |
| J | 2026-10-28 | DG | ECU engine harness layout tree built from Route 16 (Dan's device spots and branches, DECISIO... |
| K | 2026-10-29 | DG | Ignition coil ground goes straight to the glove-box POWER box NEG bar through bulkhead cavity ... |
| L | 2026-10-29 | DG | Every connector part-way along a line or run breaks out at least 6 in (152 mm) off it; the last conn... |

**ST185-harness - every wiring harness of the car, one drawing set**


Layout - ST185-ClusterLED - ROUTE-13-CLUSTERLED

| DRAWING NO. | REV | SHEET | SIZE | DRAWN | DATE |
|---|---|---|---|---|---|
| ST185-harness-LAY | L | 23 OF 35 | 432 x 279 mm | DG | 2026-10-29 |

ST185 Celica (living-relation) - generated by docs/harness/tools/build_drawings.py from docs/harness/MASTER-wirelist.csv; not to scale

**LAYOUT - ST185-WheelSpeed-Front - ROUTE 9 WHEELSPEED FRONT, as approved (1 of 4)**

Fig. 2 · Engine compartment, 3S-GTE, TIS 1993 EWD ·Position of Parts in Engine Compartment· p.28 (tis1993-wiring-routing.pdf, sheet 1). Firewall at top, driver side on the right. Rev 2 (Dan·s blue mark-up): each fender pass-through is at the top of the fender near the firewall, at the connector cluster by the strut tower (2 driver side, 4 passenger side). From there each sensor cable runs down along the existing fender harness (the dashed factory ...

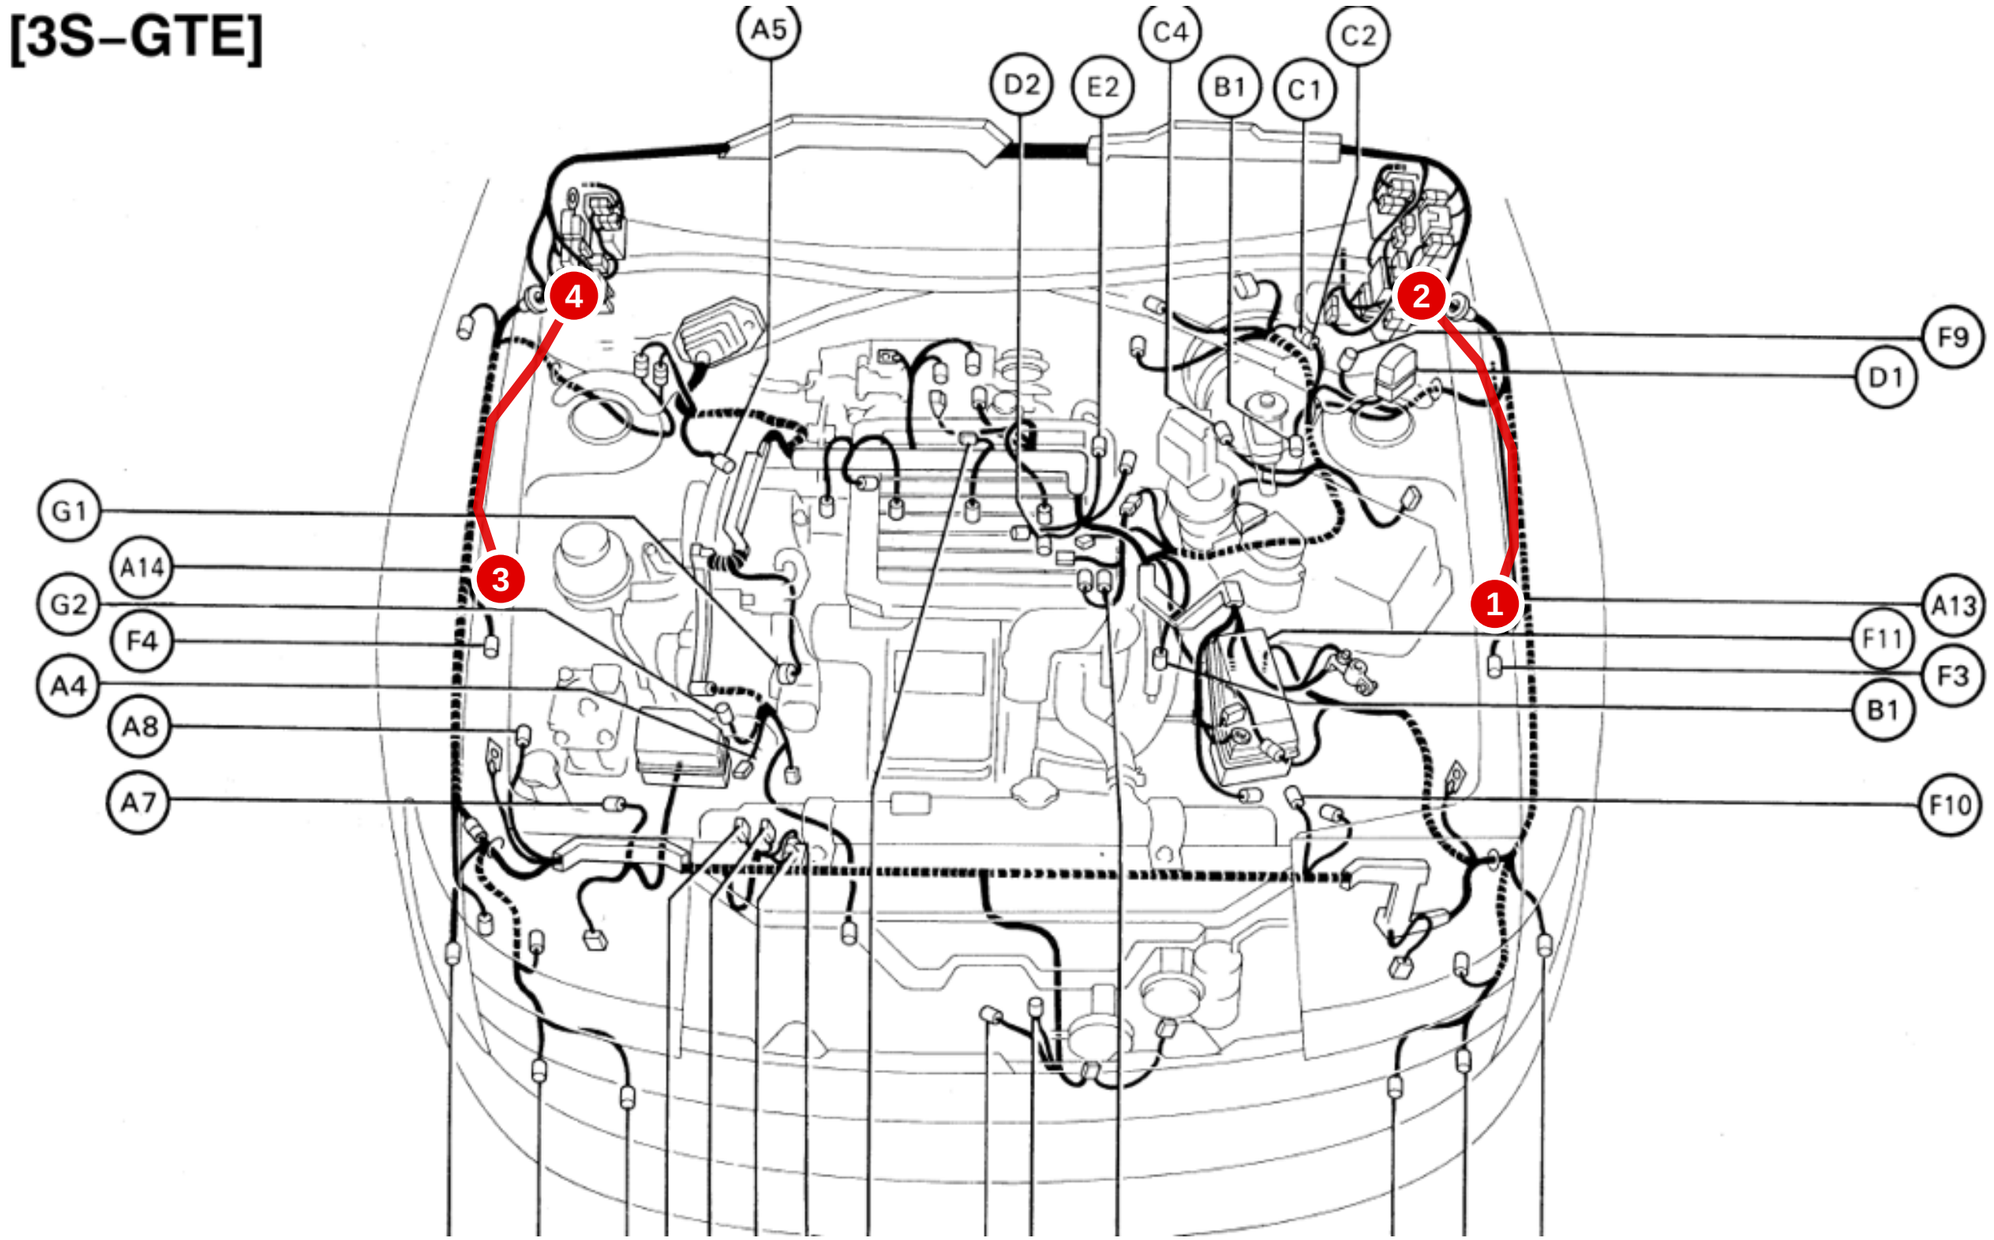


| REVISIONS | | | |
|---|---|---|---|
| REV | DATE | BY | DESCRIPTION |
| I | 2026-10-27 | DG | Crank and cam each run in one shielded Raychem cable (2-core / 3-core). The CAN-Lambda bra... |
| J | 2026-10-28 | DG | ECU engine harness layout tree built from Route 16 (Dan's device spots and branches, DECISIO... |
| K | 2026-10-29 | DG | Ignition coil ground goes straight to the glove-box POWER box NEG bar through bulkhead cavity ... |
| L | 2026-10-29 | DG | Every connector part-way along a line or run breaks out at least 6 in (152 mm) off it; the last conn... |

**ST185-harness - every wiring harness of the car, one drawing set**

Layout - ST185-WheelSpeed-Front - ROUTE-9-WHEELSPEED-FRONT


| DRAWING NO. | REV | SHEET | SIZE | DRAWN | DATE |
|---|---|---|---|---|---|
| ST185-harness-LAY | L | 24 OF 35 | 432 x 279 mm | DG | 2026-10-29 |

ST185 Celica (living-relation) - generated by docs/harness/tools/build_drawings.py from docs/harness/MASTER-wirelist.csv; not to scale

**LAYOUT - ST185-WheelSpeed-Front - ROUTE 9 WHEELSPEED FRONT, as approved (2 of 4)**

Top view for the figure above · same route, same colors. Projected from the figure above (approximate); this figure·s part is bright, the rest of the route is faded. Blue squares: B = bulkhead A/B (DRB102, RH firewall), R / L = RH / LH fender pass-throughs (Route 9 rev 2). Top view base: 1993 Celica repair manual RM305U1, Introduction, ·Vehicle Lift and Support Locations·, p. IN·24 (st185-celica-repair-manual\manuals\RM305U1 - Introduction - Ve...

## DRIVER (LH) SIDE

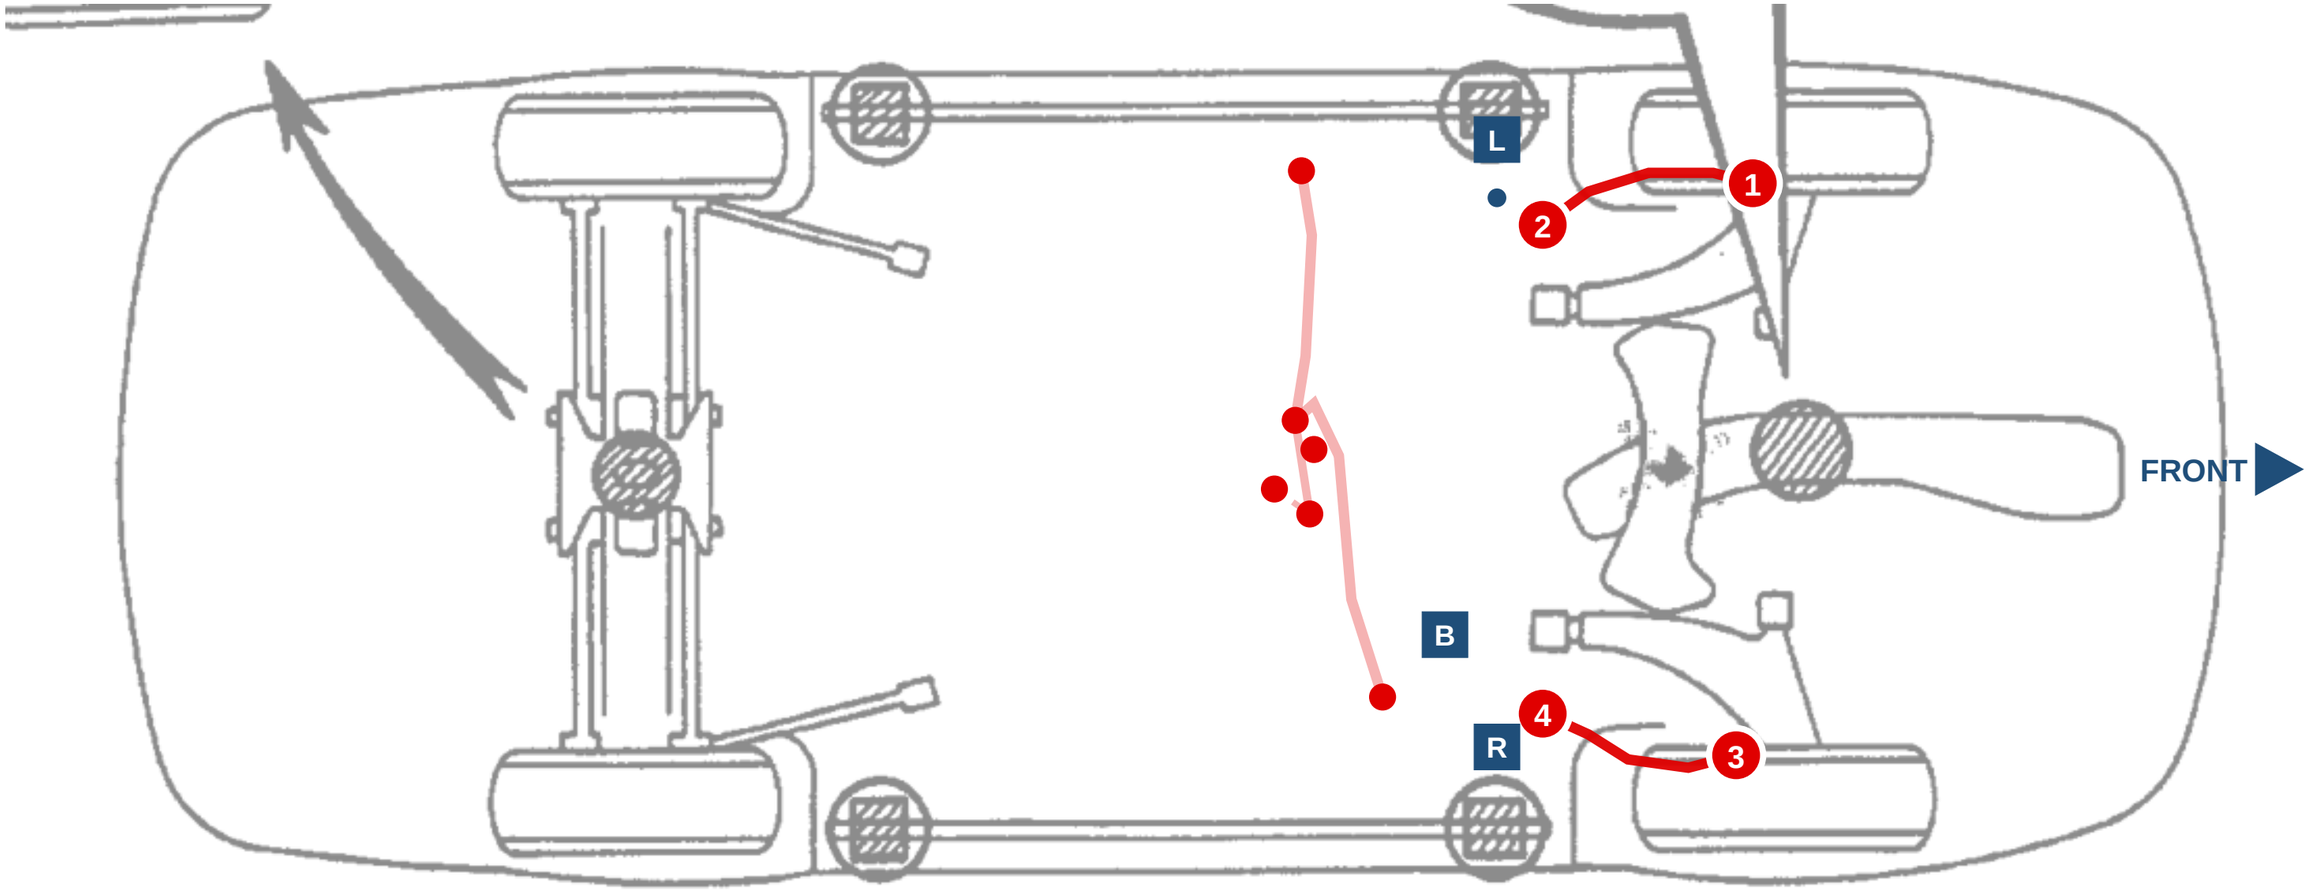


## PASSENGER (RH) SIDE

**REVISIONS**

| REV | DATE | BY | DESCRIPTION |
|---|---|---|---|
| I | 2026-10-27 | DG | Crank and cam each run in one shielded Raychem cable (2-core / 3-core). The CAN-Lambda bra... |
| J | 2026-10-28 | DG | ECU engine harness layout tree built from Route 16 (Dan's device spots and branches, DECISIO... |
| K | 2026-10-29 | DG | Ignition coil ground goes straight to the glove-box POWER box NEG bar through bulkhead cavity ... |
| L | 2026-10-29 | DG | Every connector part-way along a line or run breaks out at least 6 in (152 mm) off it; the last conn... |

**ST185-harness - every wiring harness of the car, one drawing set**


Layout - ST185-WheelSpeed-Front - ROUTE-9-WHEELSPEED-FRONT

| DRAWING NO. | REV | SHEET | SIZE | DRAWN | DATE |
|---|---|---|---|---|---|
| ST185-harness-LAY | L | 25 OF 35 | 432 x 279 mm | DG | 2026-10-29 |

ST185 Celica (living-relation) - generated by docs/harness/tools/build_drawings.py from docs/harness/MASTER-wirelist.csv; not to scale

**LAYOUT - ST185-WheelSpeed-Front - ROUTE 9 WHEELSPEED FRONT, as approved (3 of 4)**

Fig. 1 · Instrument panel, TIS 1993 EWD ·Relay Locations· p.18 (sheet 1). Driver side left. Rev 2 (Dan·s mark-up; blue arrows with black labels = where the part sits): the FL cable comes into the cabin at the driver kick panel by J/B No.1 (2) and runs up past J/B1 and across under the dash; the FR cable comes in on the passenger side by the Extra High Speed relay / R/B No.4 area (4) and runs across to the center. Both end at the front VRC (5). ...

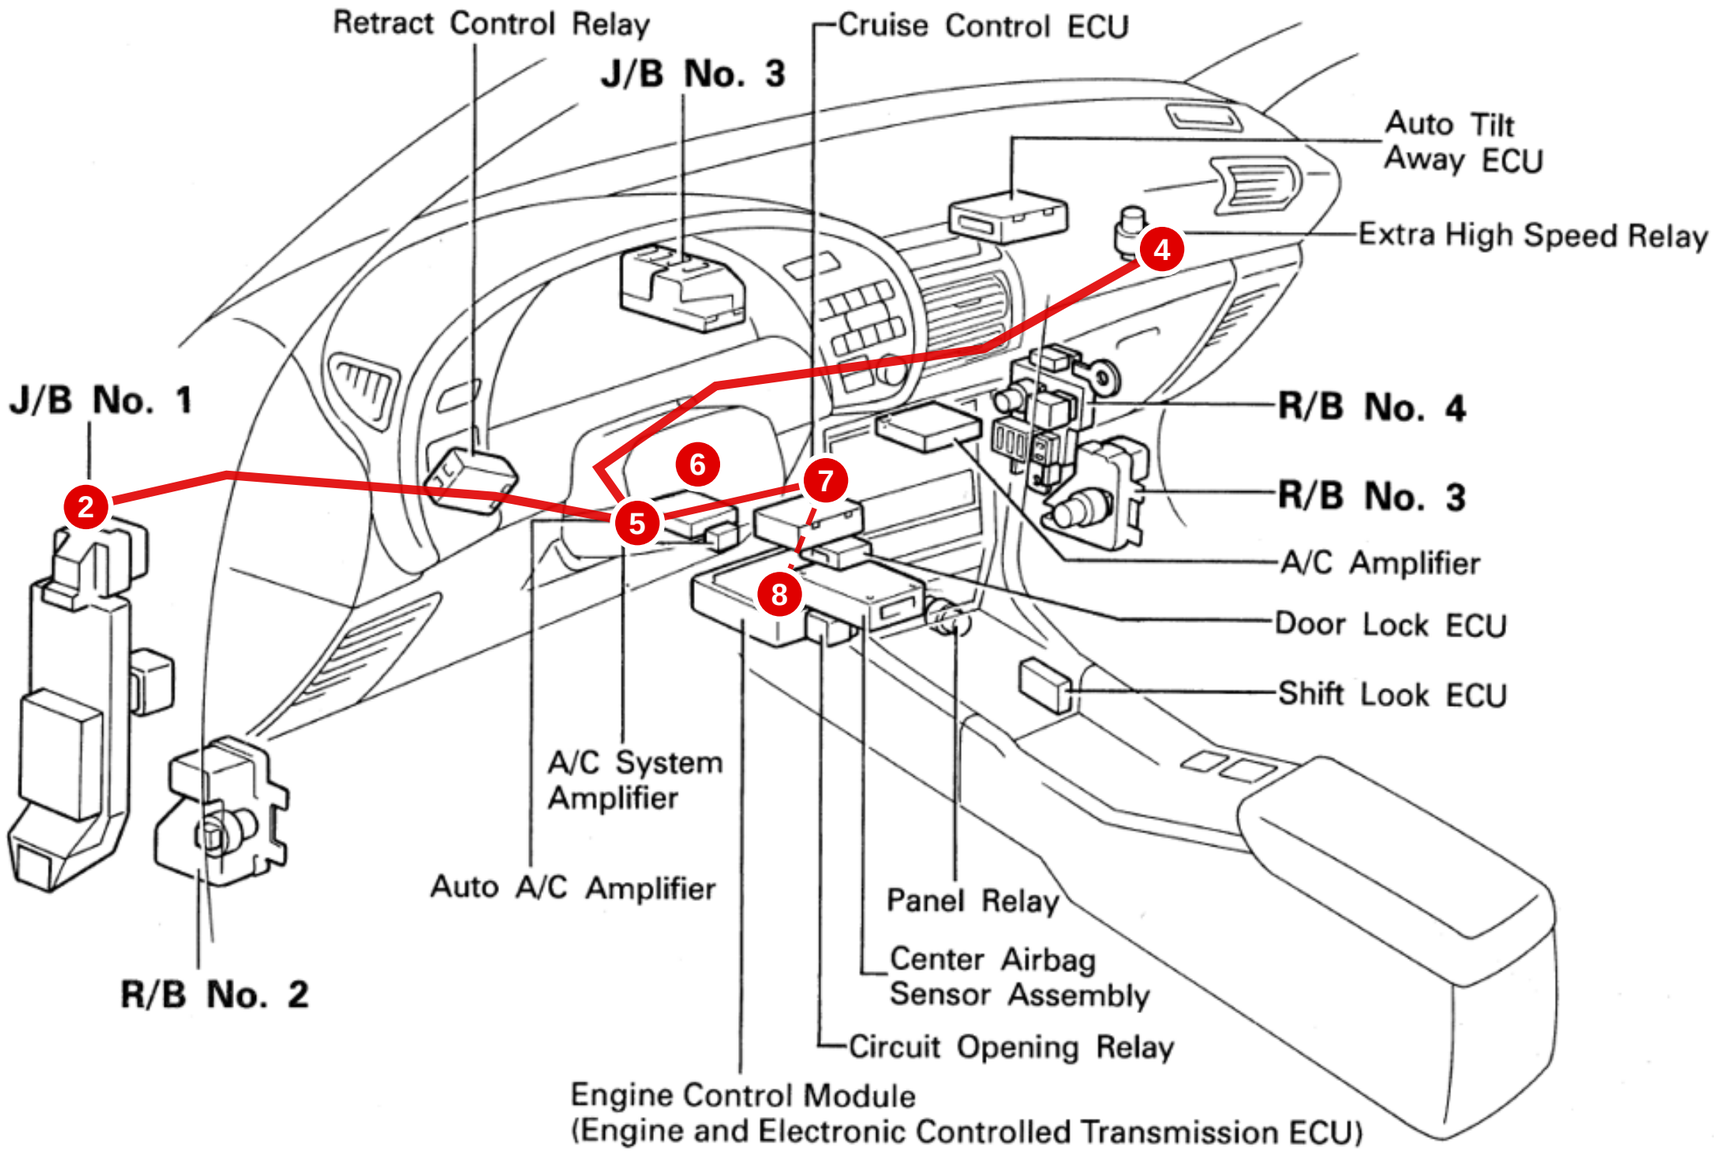


| REVISIONS | | | |
|---|---|---|---|
| REV | DATE | BY | DESCRIPTION |
| I | 2026-10-27 | DG | Crank and cam each run in one shielded Raychem cable (2-core / 3-core). The CAN-Lambda bra... |
| J | 2026-10-28 | DG | ECU engine harness layout tree built from Route 16 (Dan's device spots and branches, DECISIO... |
| K | 2026-10-29 | DG | Ignition coil ground goes straight to the glove-box POWER box NEG bar through bulkhead cavity ... |
| L | 2026-10-29 | DG | Every connector part-way along a line or run breaks out at least 6 in (152 mm) off it; the last conn... |

**ST185-harness - every wiring harness of the car, one drawing set**

Layout - ST185-WheelSpeed-Front - ROUTE-9-WHEELSPEED-FRONT


| DRAWING NO. | REV | SHEET | SIZE | DRAWN | DATE |
|---|---|---|---|---|---|
| ST185-harness-LAY | L | 26 OF 35 | 432 x 279 mm | DG | 2026-10-29 |

ST185 Celica (living-relation) - generated by docs/harness/tools/build_drawings.py from docs/harness/MASTER-wirelist.csv; not to scale

**LAYOUT - ST185-WheelSpeed-Front - ROUTE 9 WHEELSPEED FRONT, as approved (4 of 4)**

Top view for the figure above · same route, same colors. Projected from the figure above (approximate); this figure·s part is bright, the rest of the route is faded. Blue squares: B = bulkhead A/B (DRB102, RH firewall), R / L = RH / LH fender pass-throughs (Route 9 rev 2). Top view base: 1993 Celica repair manual RM305U1, Introduction, ·Vehicle Lift and Support Locations·, p. IN·24 (st185-celica-repair-manual\manuals\RM305U1 - Introduction - Ve...

## DRIVER (LH) SIDE

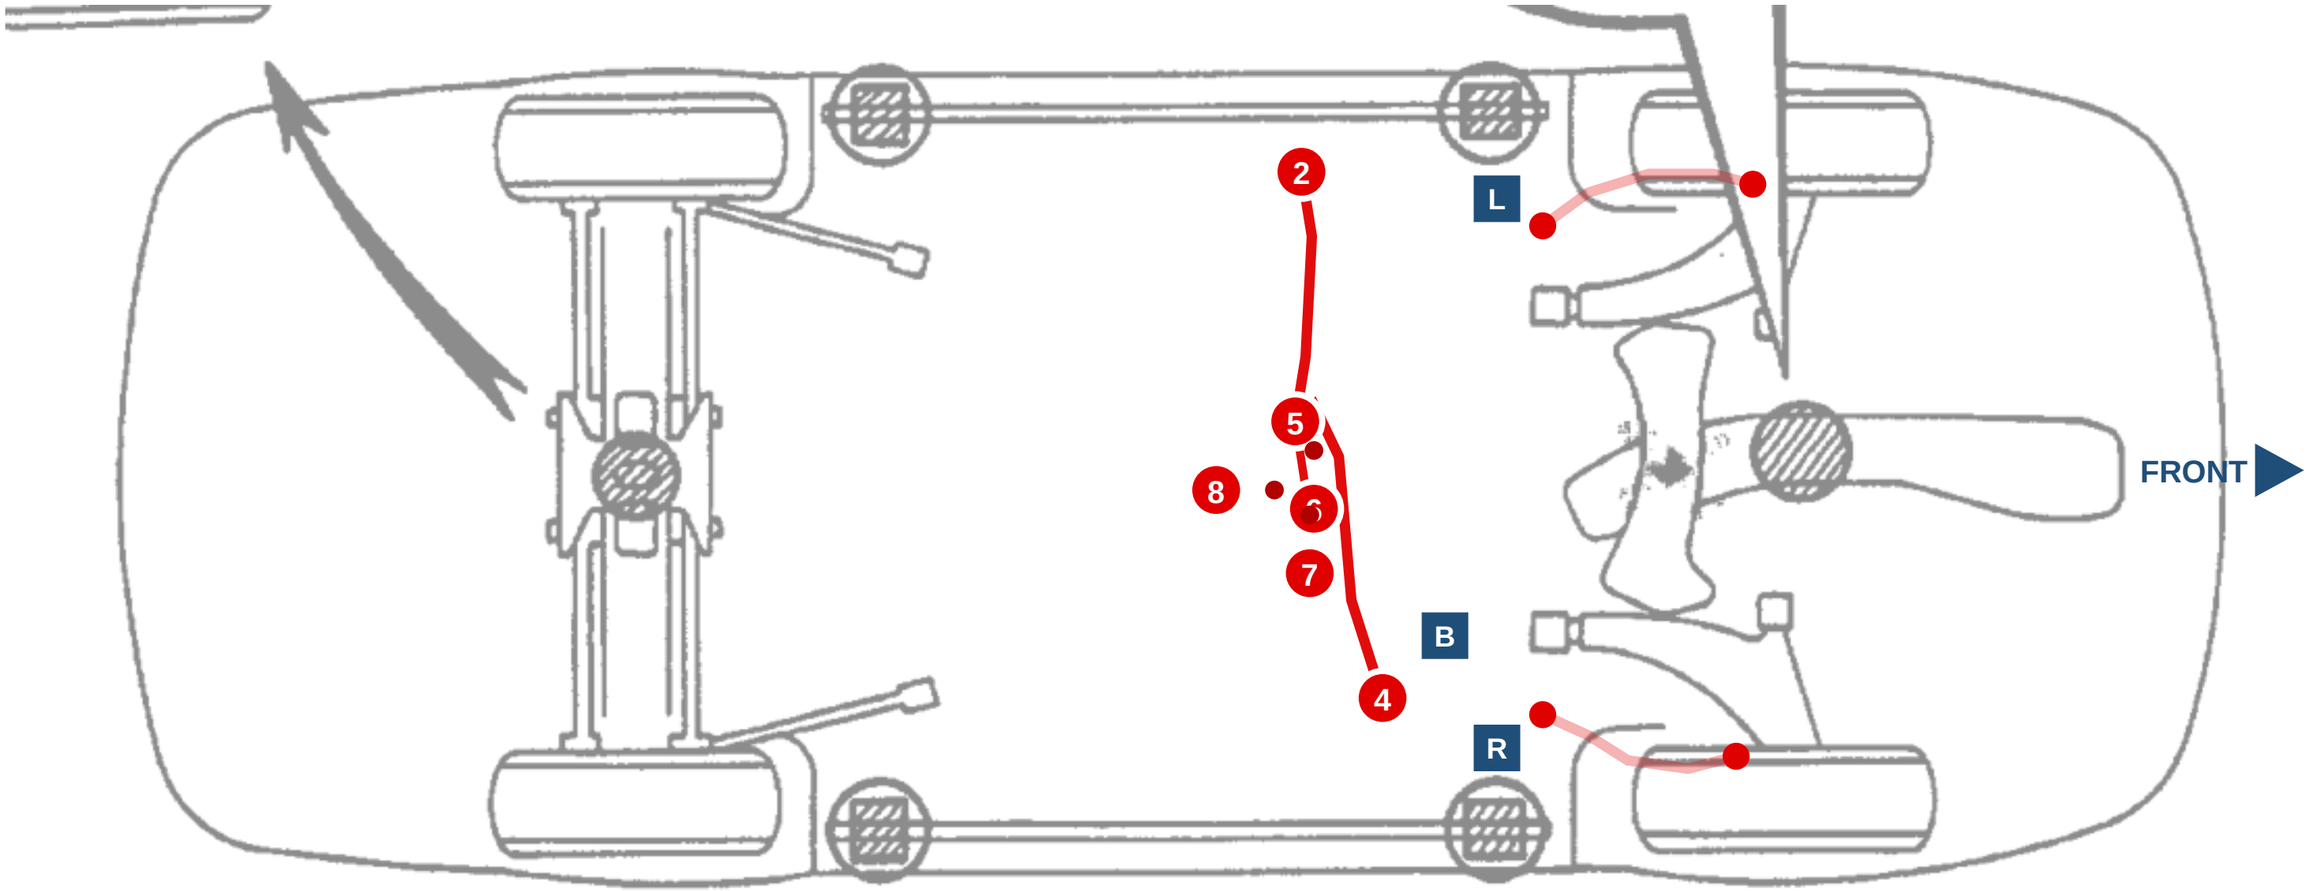


## PASSENGER (RH) SIDE

**REVISIONS**

| REV | DATE | BY | DESCRIPTION |
|---|---|---|---|
| I | 2026-10-27 | DG | Crank and cam each run in one shielded Raychem cable (2-core / 3-core). The CAN-Lambda bra... |
| J | 2026-10-28 | DG | ECU engine harness layout tree built from Route 16 (Dan's device spots and branches, DECISIO... |
| K | 2026-10-29 | DG | Ignition coil ground goes straight to the glove-box POWER box NEG bar through bulkhead cavity ... |
| L | 2026-10-29 | DG | Every connector part-way along a line or run breaks out at least 6 in (152 mm) off it; the last conn... |

**ST185-harness - every wiring harness of the car, one drawing set**


Layout - ST185-WheelSpeed-Front - ROUTE-9-WHEELSPEED-FRONT

| DRAWING NO. | REV | SHEET | SIZE | DRAWN | DATE |
|---|---|---|---|---|---|
| ST185-harness-LAY | L | 27 OF 35 | 432 x 279 mm | DG | 2026-10-29 |

ST185 Celica (living-relation) - generated by docs/harness/tools/build_drawings.py from docs/harness/MASTER-wirelist.csv; not to scale

**LAYOUT - ST185-WheelSpeed-Rear - ROUTE 10 WHEELSPEED REAR, as approved (1 of 4)**

Fig. 1 · Body, liftback, TIS 1993 EWD p.46 (tis1993-wiring-routing-2.pdf, sheet 11). Car front on the left; the near side is the driver (LH) side. Rev 2: the rear VRC is no longer back here. The RL sensor cable (1) and the RR sensor cable (2, dashed · far side, hidden in this view) come into the cabin and meet under the rear seat on the driver side (3), then both run forward along the LH sill with the factory Floor Wire (which carried the old ABS re...

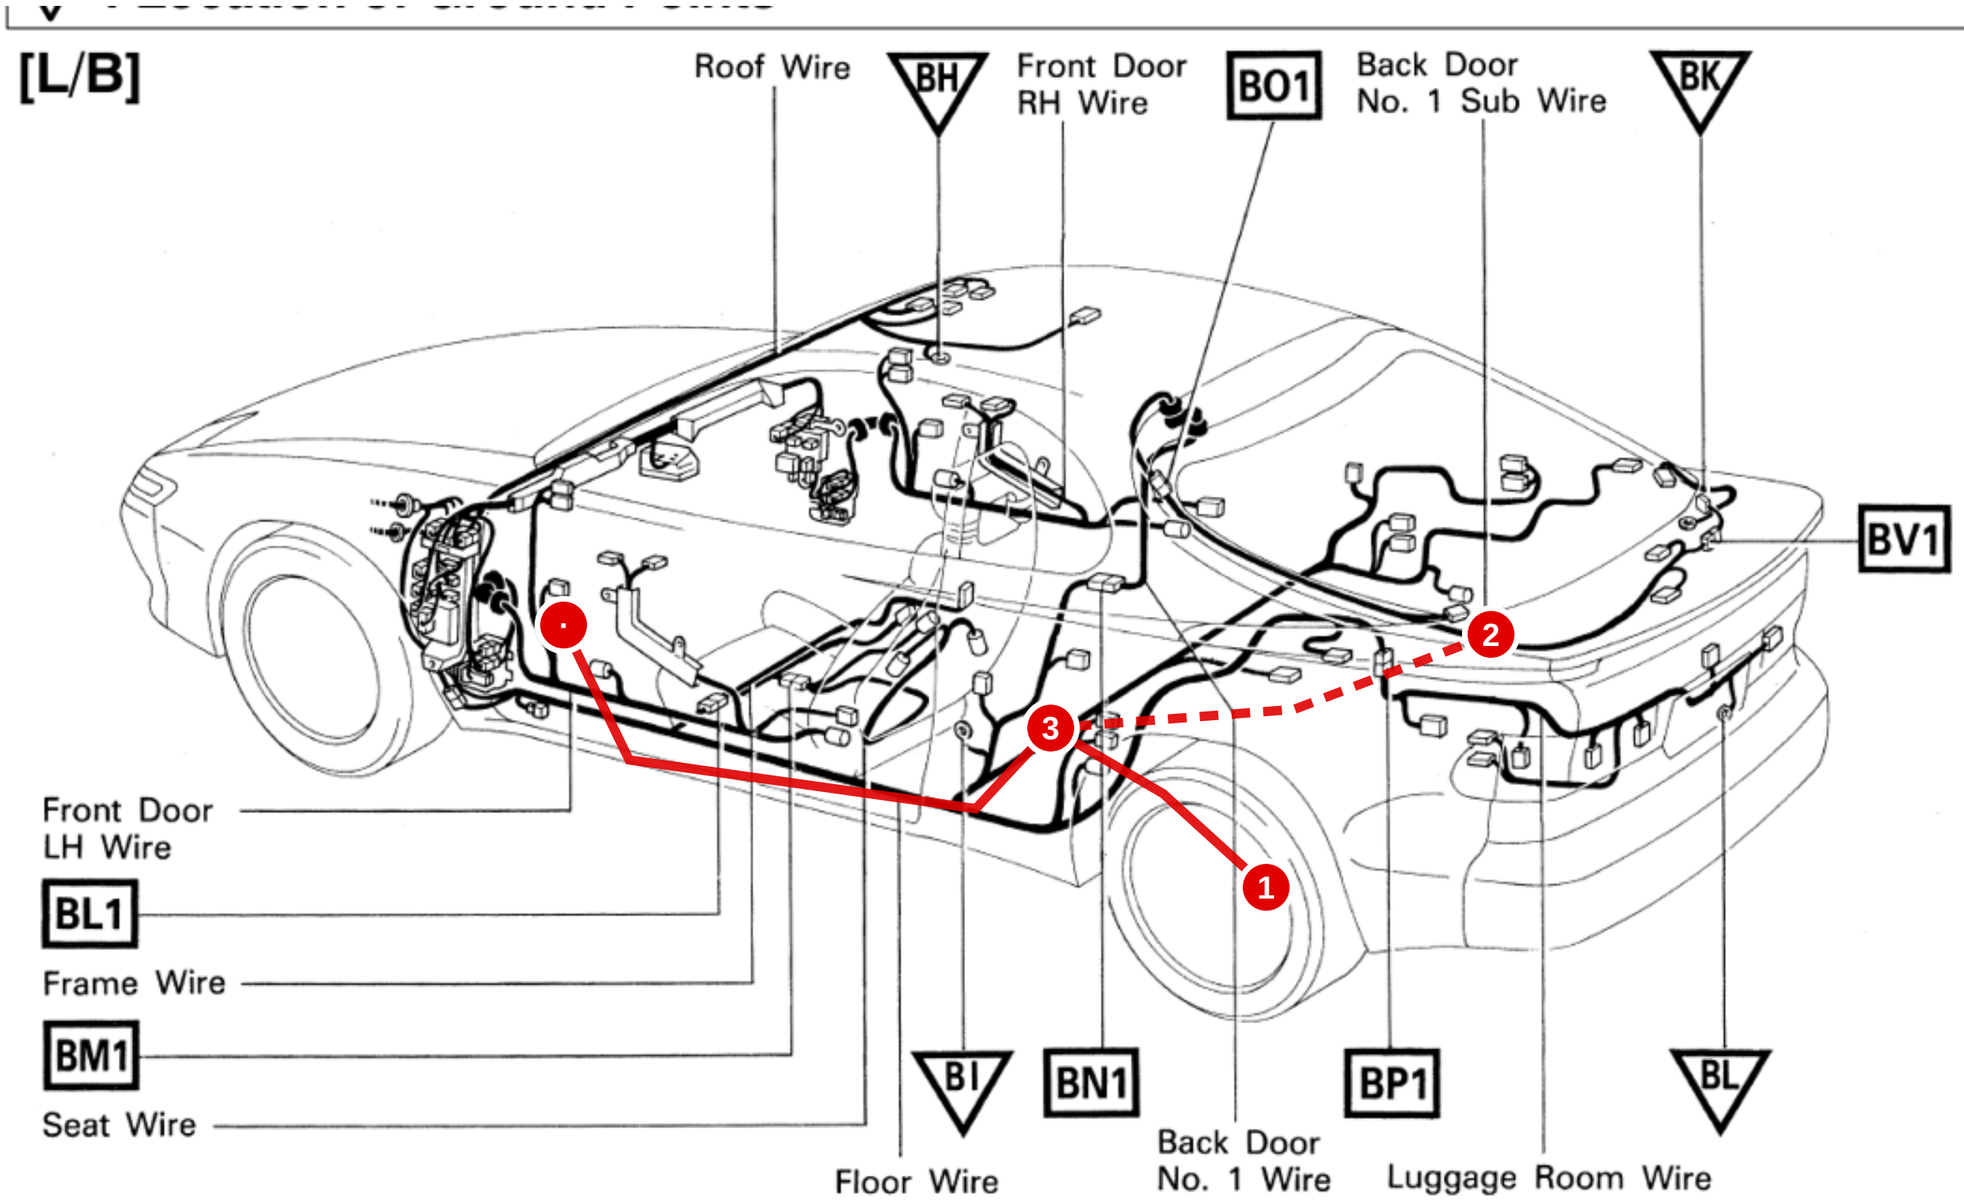


**REVISIONS**

| REV | DATE | BY | DESCRIPTION |
|---|---|---|---|
| I | 2026-10-27 | DG | Crank and cam each run in one shielded Raychem cable (2-core / 3-core). The CAN-Lambda bra... |
| J | 2026-10-28 | DG | ECU engine harness layout tree built from Route 16 (Dan's device spots and branches, DECISIO... |
| K | 2026-10-29 | DG | Ignition coil ground goes straight to the glove-box POWER box NEG bar through bulkhead cavity ... |
| L | 2026-10-29 | DG | Every connector part-way along a line or run breaks out at least 6 in (152 mm) off it; the last conn... |

**ST185-harness - every wiring harness of the car, one drawing set**

Layout - ST185-WheelSpeed-Rear - ROUTE-10-WHEELSPEED-REAR


| DRAWING NO. | REV | SHEET | SIZE | DRAWN | DATE |
|---|---|---|---|---|---|
| ST185-harness-LAY | L | 28 OF 35 | 432 x 279 mm | DG | 2026-10-29 |

ST185 Celica (living-relation) - generated by docs/harness/tools/build_drawings.py from docs/harness/MASTER-wirelist.csv; not to scale

**LAYOUT - ST185-WheelSpeed-Rear - ROUTE 10 WHEELSPEED REAR, as approved (2 of 4)**

Top view for the figure above · same route, same colors. Drawn to match the figure above (approximate); this figure·s part is bright, the rest of the route is faded. Blue squares: B = bulkhead A/B (DRB102, RH firewall), R / L = RH / LH fender pass-throughs (Route 9 rev 2). Top view base: 1993 Celica repair manual RM305U1, Introduction, ·Vehicle Lift and Support Locations·, p. IN·24 (st185-celica-repair-manual\manuals\RM305U1 - Introduction - V...

## DRIVER (LH) SIDE

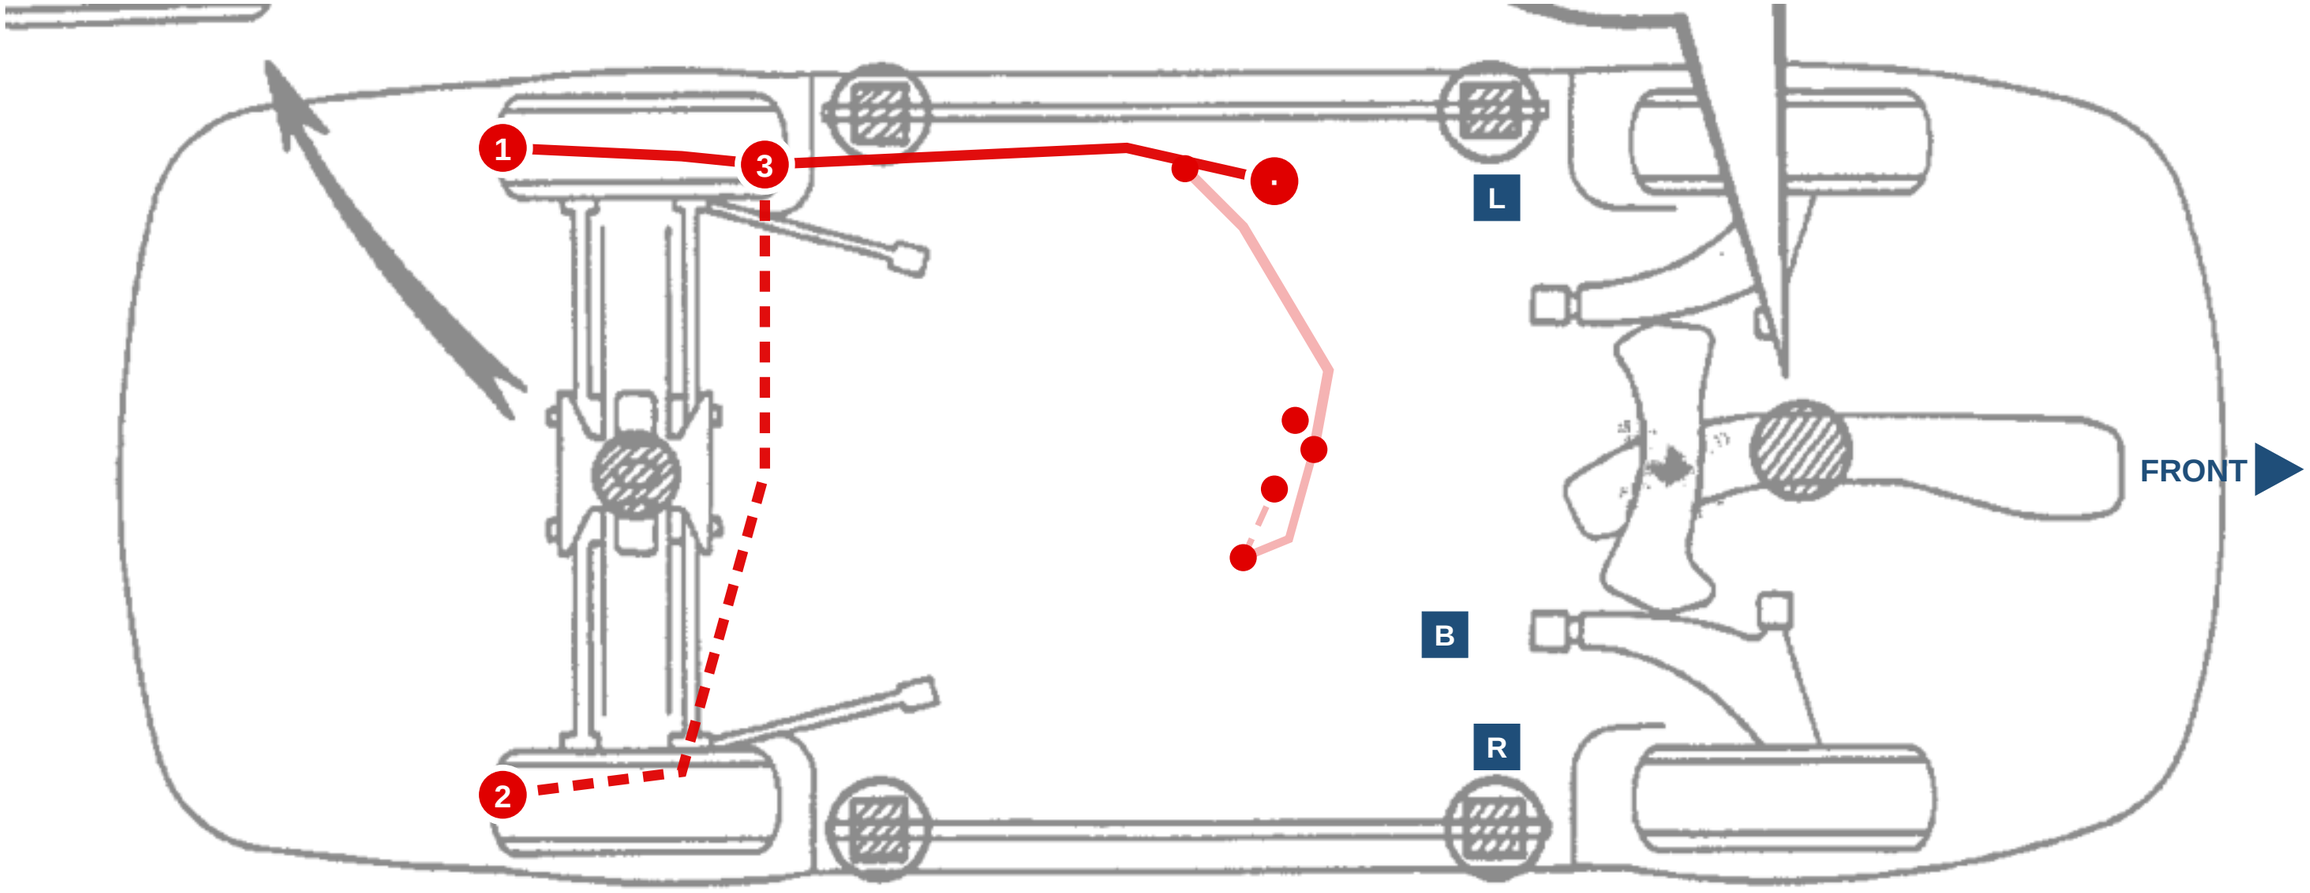


## PASSENGER (RH) SIDE

**REVISIONS**

| REV | DATE | BY | DESCRIPTION |
|---|---|---|---|
| I | 2026-10-27 | DG | Crank and cam each run in one shielded Raychem cable (2-core / 3-core). The CAN-Lambda bra... |
| J | 2026-10-28 | DG | ECU engine harness layout tree built from Route 16 (Dan's device spots and branches, DECISIO... |
| K | 2026-10-29 | DG | Ignition coil ground goes straight to the glove-box POWER box NEG bar through bulkhead cavity ... |
| L | 2026-10-29 | DG | Every connector part-way along a line or run breaks out at least 6 in (152 mm) off it; the last conn... |

**ST185-harness - every wiring harness of the car, one drawing set**


Layout - ST185-WheelSpeed-Rear - ROUTE-10-WHEELSPEED-REAR

| DRAWING NO. | REV | SHEET | SIZE | DRAWN | DATE |
|---|---|---|---|---|---|
| ST185-harness-LAY | L | 29 OF 35 | 432 x 279 mm | DG | 2026-10-29 |

ST185 Celica (living-relation) - generated by docs/harness/tools/build_drawings.py from docs/harness/MASTER-wirelist.csv; not to scale

**LAYOUT - ST185-WheelSpeed-Rear - ROUTE 10 WHEELSPEED REAR, as approved (3 of 4)**

Fig. 2 · Instrument panel, TIS 1993 EWD ·Relay Locations· p.18 (sheet 1). Driver side left. Rev 2 (Dan: ·vrc x2·): the RL/RR sensor cables come up from the LH sill at the driver kick panel (4) and run across under the dash to the rear VRC (5), mid-dash right above the ECU beside the front VRC (6, Route 9). The VRC output is now a short run to IX_WS_REAR (7) next to the ECU; the spur to ECU B (8) is B-cabin (Route 6, dashed). Deleted parts st...

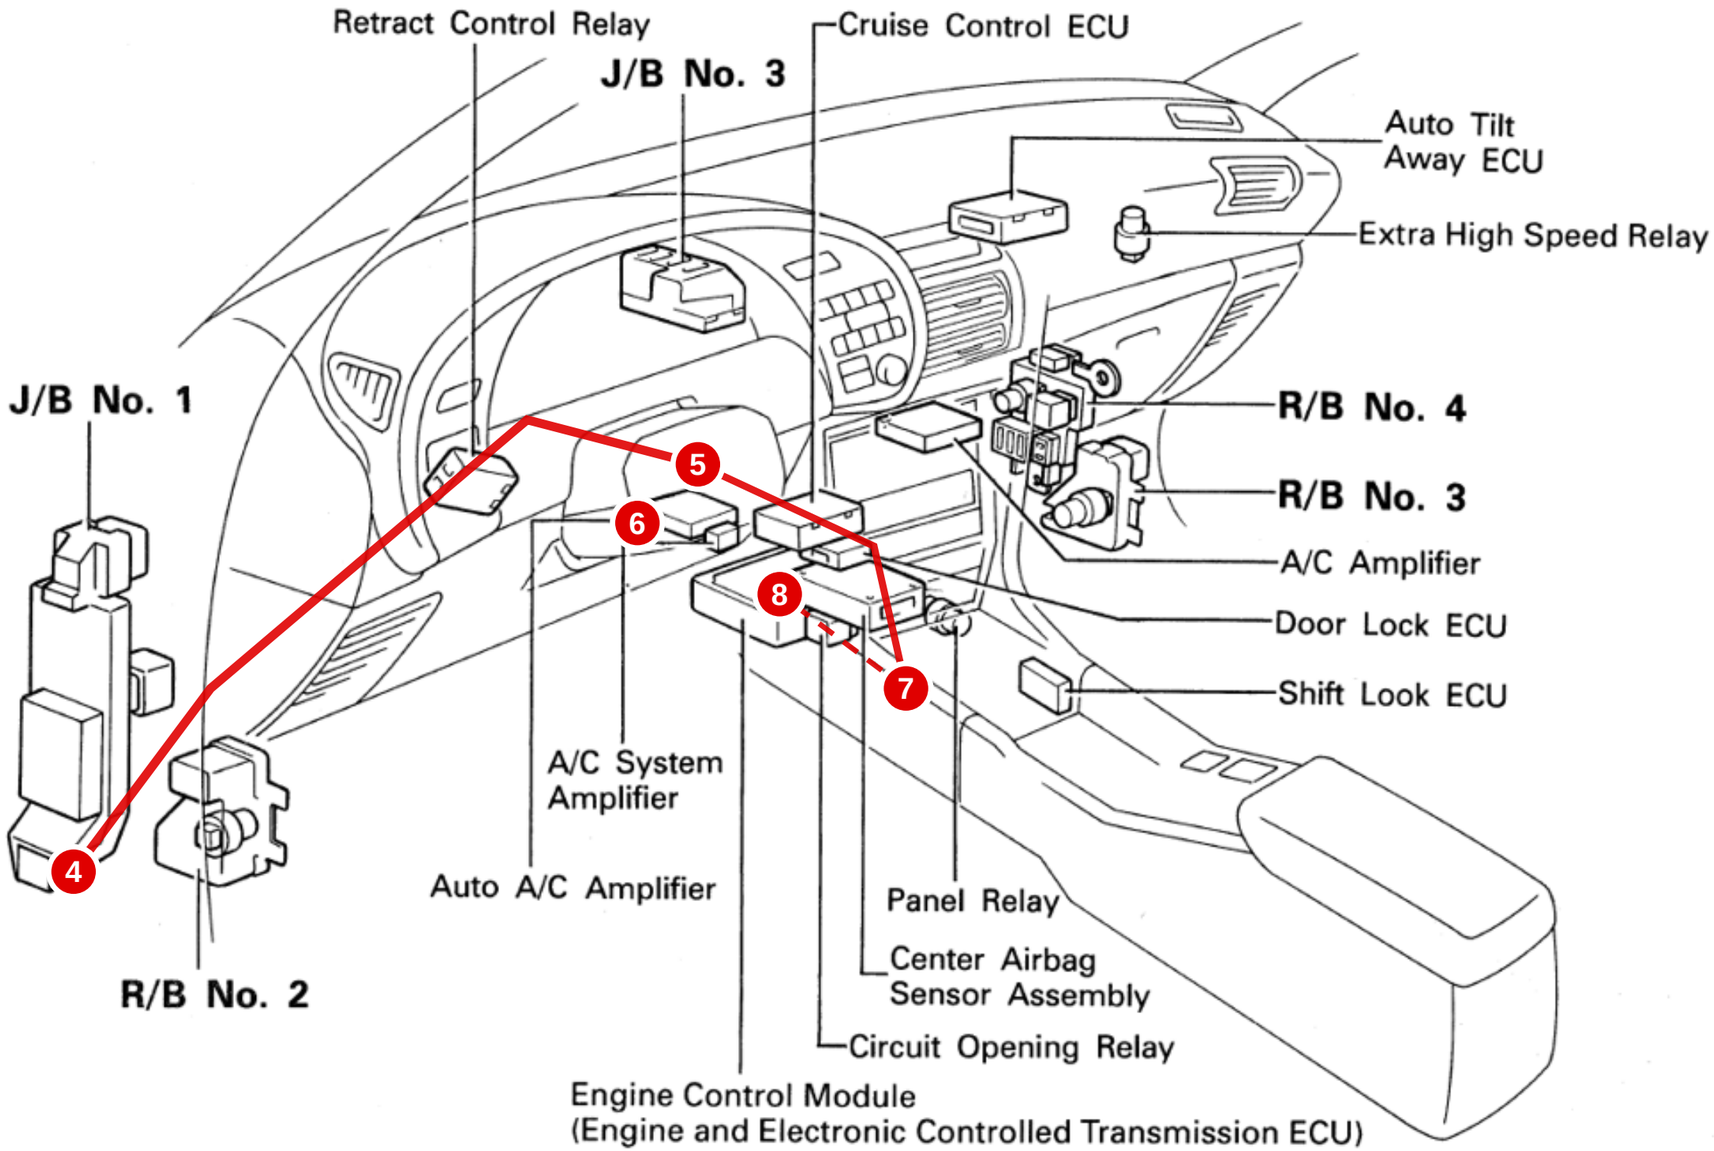


| REVISIONS | | | |
|---|---|---|---|
| REV | DATE | BY | DESCRIPTION |
| I | 2026-10-27 | DG | Crank and cam each run in one shielded Raychem cable (2-core / 3-core). The CAN-Lambda bra... |
| J | 2026-10-28 | DG | ECU engine harness layout tree built from Route 16 (Dan's device spots and branches, DECISIO... |
| K | 2026-10-29 | DG | Ignition coil ground goes straight to the glove-box POWER box NEG bar through bulkhead cavity ... |
| L | 2026-10-29 | DG | Every connector part-way along a line or run breaks out at least 6 in (152 mm) off it; the last conn... |

**ST185-harness - every wiring harness of the car, one drawing set**

Layout - ST185-WheelSpeed-Rear - ROUTE-10-WHEELSPEED-REAR


| DRAWING NO. | REV | SHEET | SIZE | DRAWN | DATE |
|---|---|---|---|---|---|
| ST185-harness-LAY | L | 30 OF 35 | 432 x 279 mm | DG | 2026-10-29 |

ST185 Celica (living-relation) - generated by docs/harness/tools/build_drawings.py from docs/harness/MASTER-wirelist.csv; not to scale

**LAYOUT - ST185-WheelSpeed-Rear - ROUTE 10 WHEELSPEED REAR, as approved (4 of 4)**

Top view for the figure above · same route, same colors. Projected from the figure above (approximate); this figure·s part is bright, the rest of the route is faded. Blue squares: B = bulkhead A/B (DRB102, RH firewall), R / L = RH / LH fender pass-throughs (Route 9 rev 2). Top view base: 1993 Celica repair manual RM305U1, Introduction, ·Vehicle Lift and Support Locations·, p. IN·24 (st185-celica-repair-manual\manuals\RM305U1 - Introduction - Ve...

## DRIVER (LH) SIDE

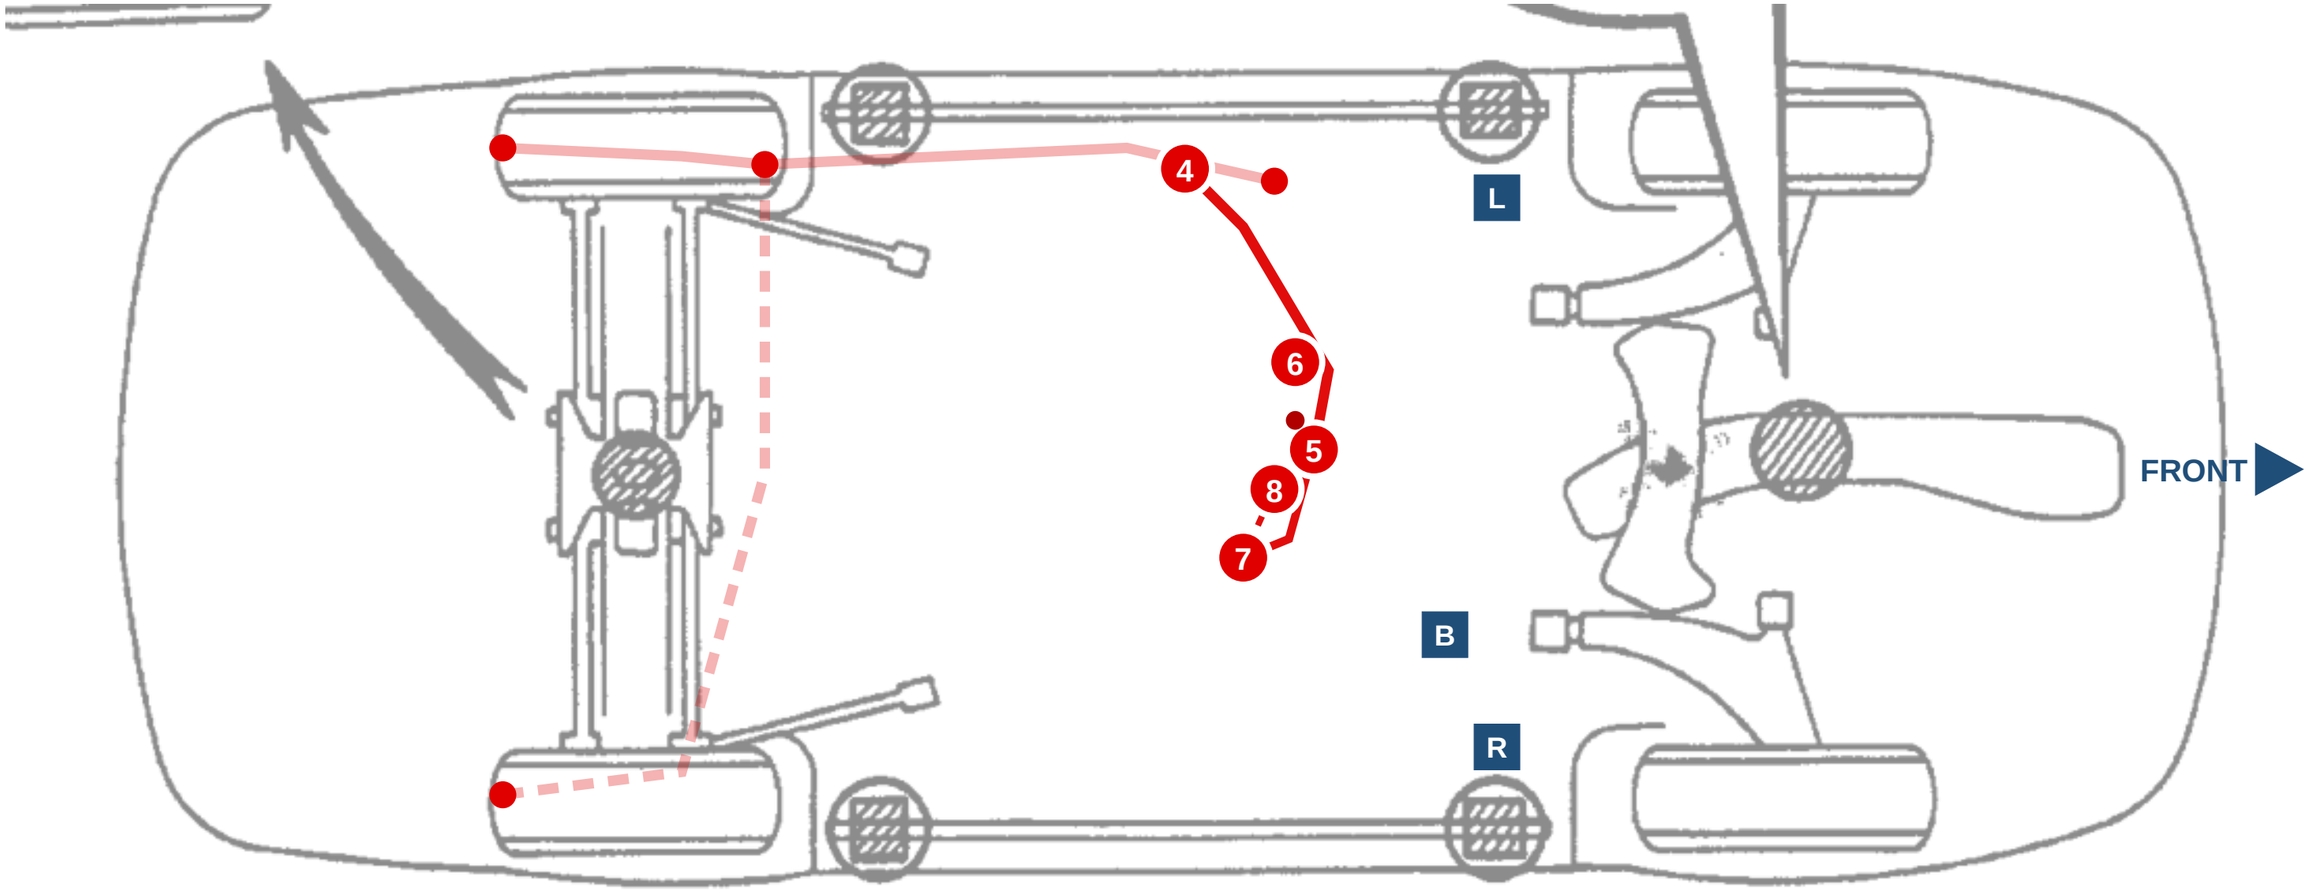


## PASSENGER (RH) SIDE

**REVISIONS**

| REV | DATE | BY | DESCRIPTION |
|---|---|---|---|
| I | 2026-10-27 | DG | Crank and cam each run in one shielded Raychem cable (2-core / 3-core). The CAN-Lambda bra... |
| J | 2026-10-28 | DG | ECU engine harness layout tree built from Route 16 (Dan's device spots and branches, DECISIO... |
| K | 2026-10-29 | DG | Ignition coil ground goes straight to the glove-box POWER box NEG bar through bulkhead cavity ... |
| L | 2026-10-29 | DG | Every connector part-way along a line or run breaks out at least 6 in (152 mm) off it; the last conn... |

**ST185-harness - every wiring harness of the car, one drawing set**


Layout - ST185-WheelSpeed-Rear - ROUTE-10-WHEELSPEED-REAR

| DRAWING NO. | REV | SHEET | SIZE | DRAWN | DATE |
|---|---|---|---|---|---|
| ST185-harness-LAY | L | 31 OF 35 | 432 x 279 mm | DG | 2026-10-29 |

ST185 Celica (living-relation) - generated by docs/harness/tools/build_drawings.py from docs/harness/MASTER-wirelist.csv; not to scale

**LAYOUT - ST185-RearFuel - ROUTE 11 REARFUEL, as approved (1 of 4)**

Fig. 1 · Instrument panel, TIS 1993 EWD ·Relay Locations· p.18 (tis1993-relay-locations.pdf, sheet 1). Driver side left, glove box right. Deleted parts still drawn on this page are not used. Dashed = the runs that leave the dash for the rear but belong to other harnesses: the fuel level lead B24 and the k_fp coil · wire A19 (both from the ECU; B-cabin Route 6 / A-cabin Route 5) and the k_fp coil + wire SW12 (CabinPower, Route 7), all leaving down th...

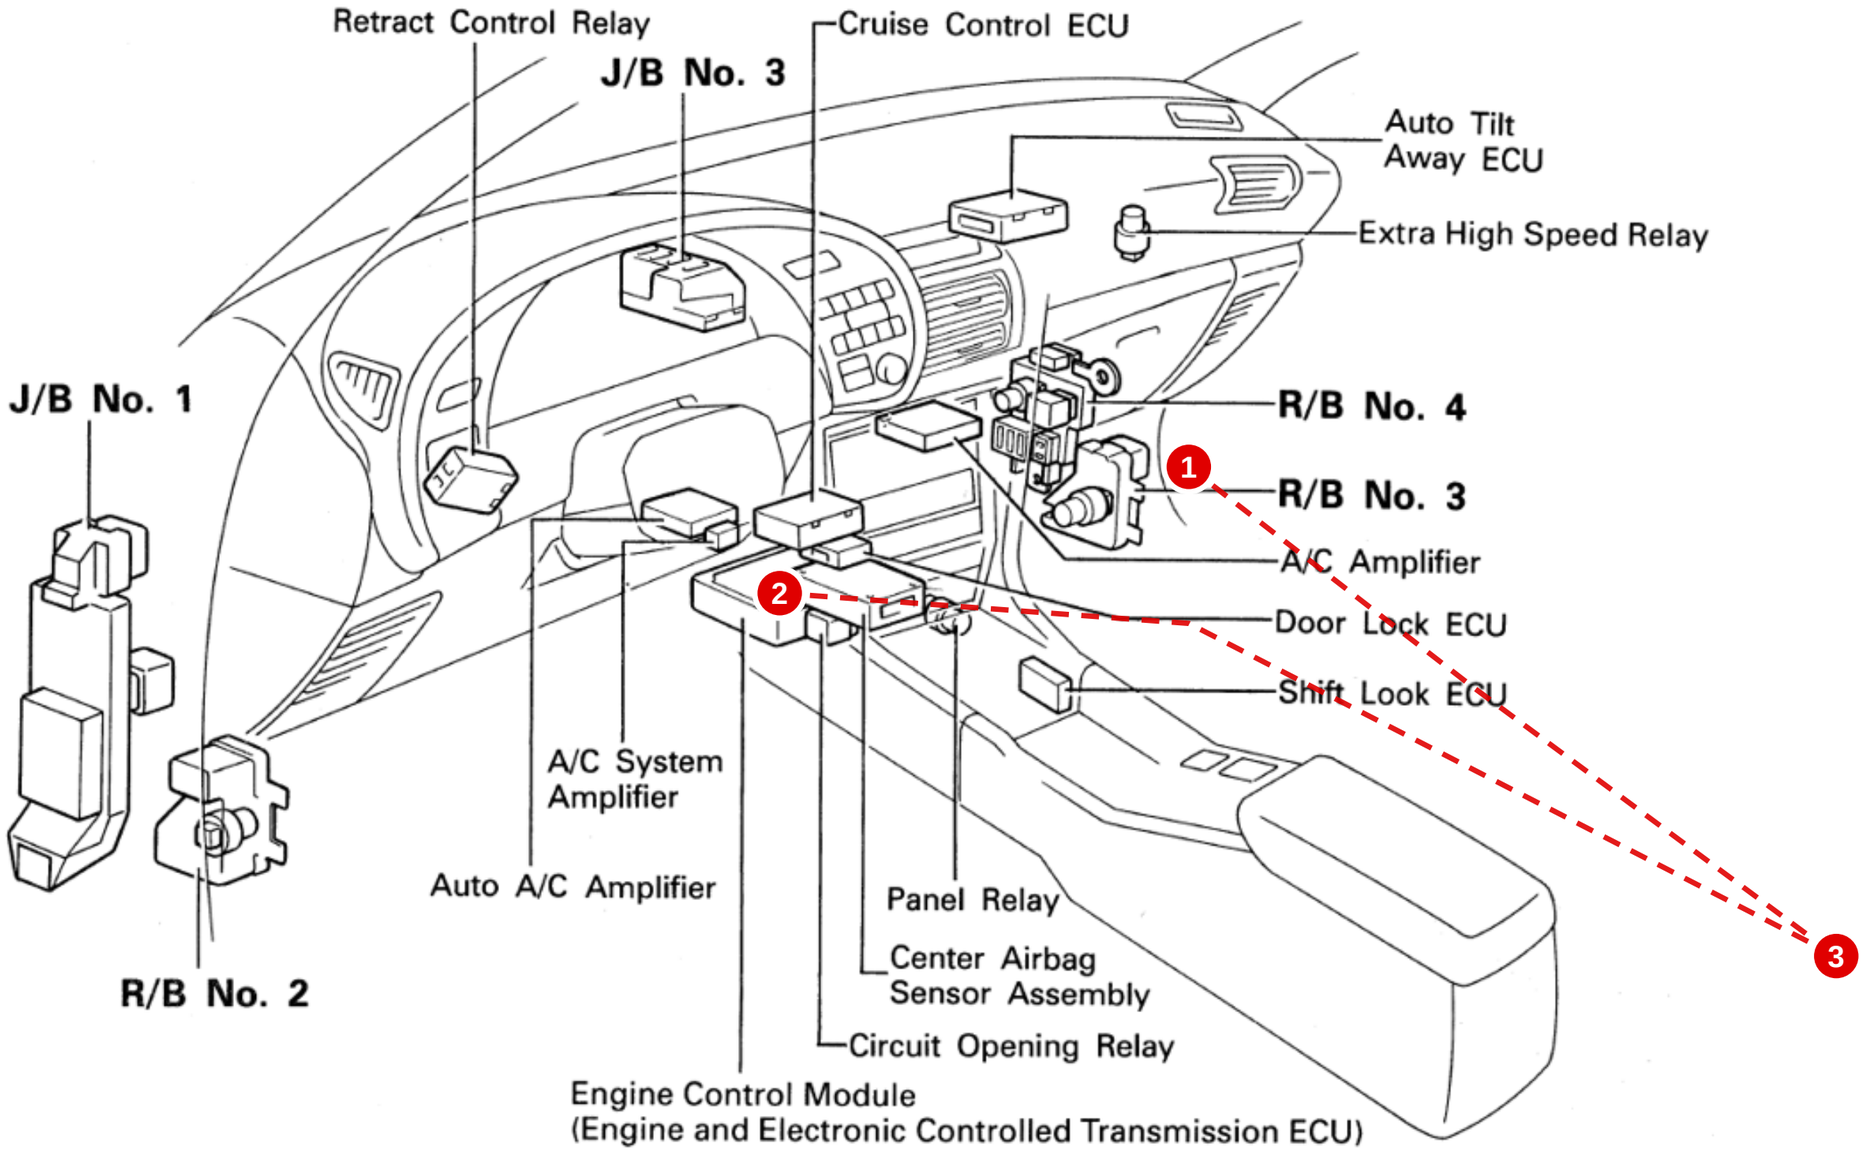


| REVISIONS | | | |
|---|---|---|---|
| REV | DATE | BY | DESCRIPTION |
| I | 2026-10-27 | DG | Crank and cam each run in one shielded Raychem cable (2-core / 3-core). The CAN-Lambda bra... |
| J | 2026-10-28 | DG | ECU engine harness layout tree built from Route 16 (Dan's device spots and branches, DECISIO... |
| K | 2026-10-29 | DG | Ignition coil ground goes straight to the glove-box POWER box NEG bar through bulkhead cavity ... |
| L | 2026-10-29 | DG | Every connector part-way along a line or run breaks out at least 6 in (152 mm) off it; the last conn... |

**ST185-harness - every wiring harness of the car, one drawing set**

Layout - ST185-RearFuel - ROUTE-11-REARFUEL


| DRAWING NO. | REV | SHEET | SIZE | DRAWN | DATE |
|---|---|---|---|---|---|
| ST185-harness-LAY | L | 32 OF 35 | 432 x 279 mm | DG | 2026-10-29 |

ST185 Celica (living-relation) - generated by docs/harness/tools/build_drawings.py from docs/harness/MASTER-wirelist.csv; not to scale

**LAYOUT - ST185-RearFuel - ROUTE 11 REARFUEL, as approved (2 of 4)**

Top view for the figure above · same route, same colors. Projected from the figure above (approximate); this figure·s part is bright, the rest of the route is faded. Blue squares: B = bulkhead A/B (DRB102, RH firewall), R / L = RH / LH fender pass-throughs (Route 9 rev 2). Top view base: 1993 Celica repair manual RM305U1, Introduction, ·Vehicle Lift and Support Locations·, p. IN·24 (st185-celica-repair-manual\manuals\RM305U1 - Introduction - Ve...

## DRIVER (LH) SIDE

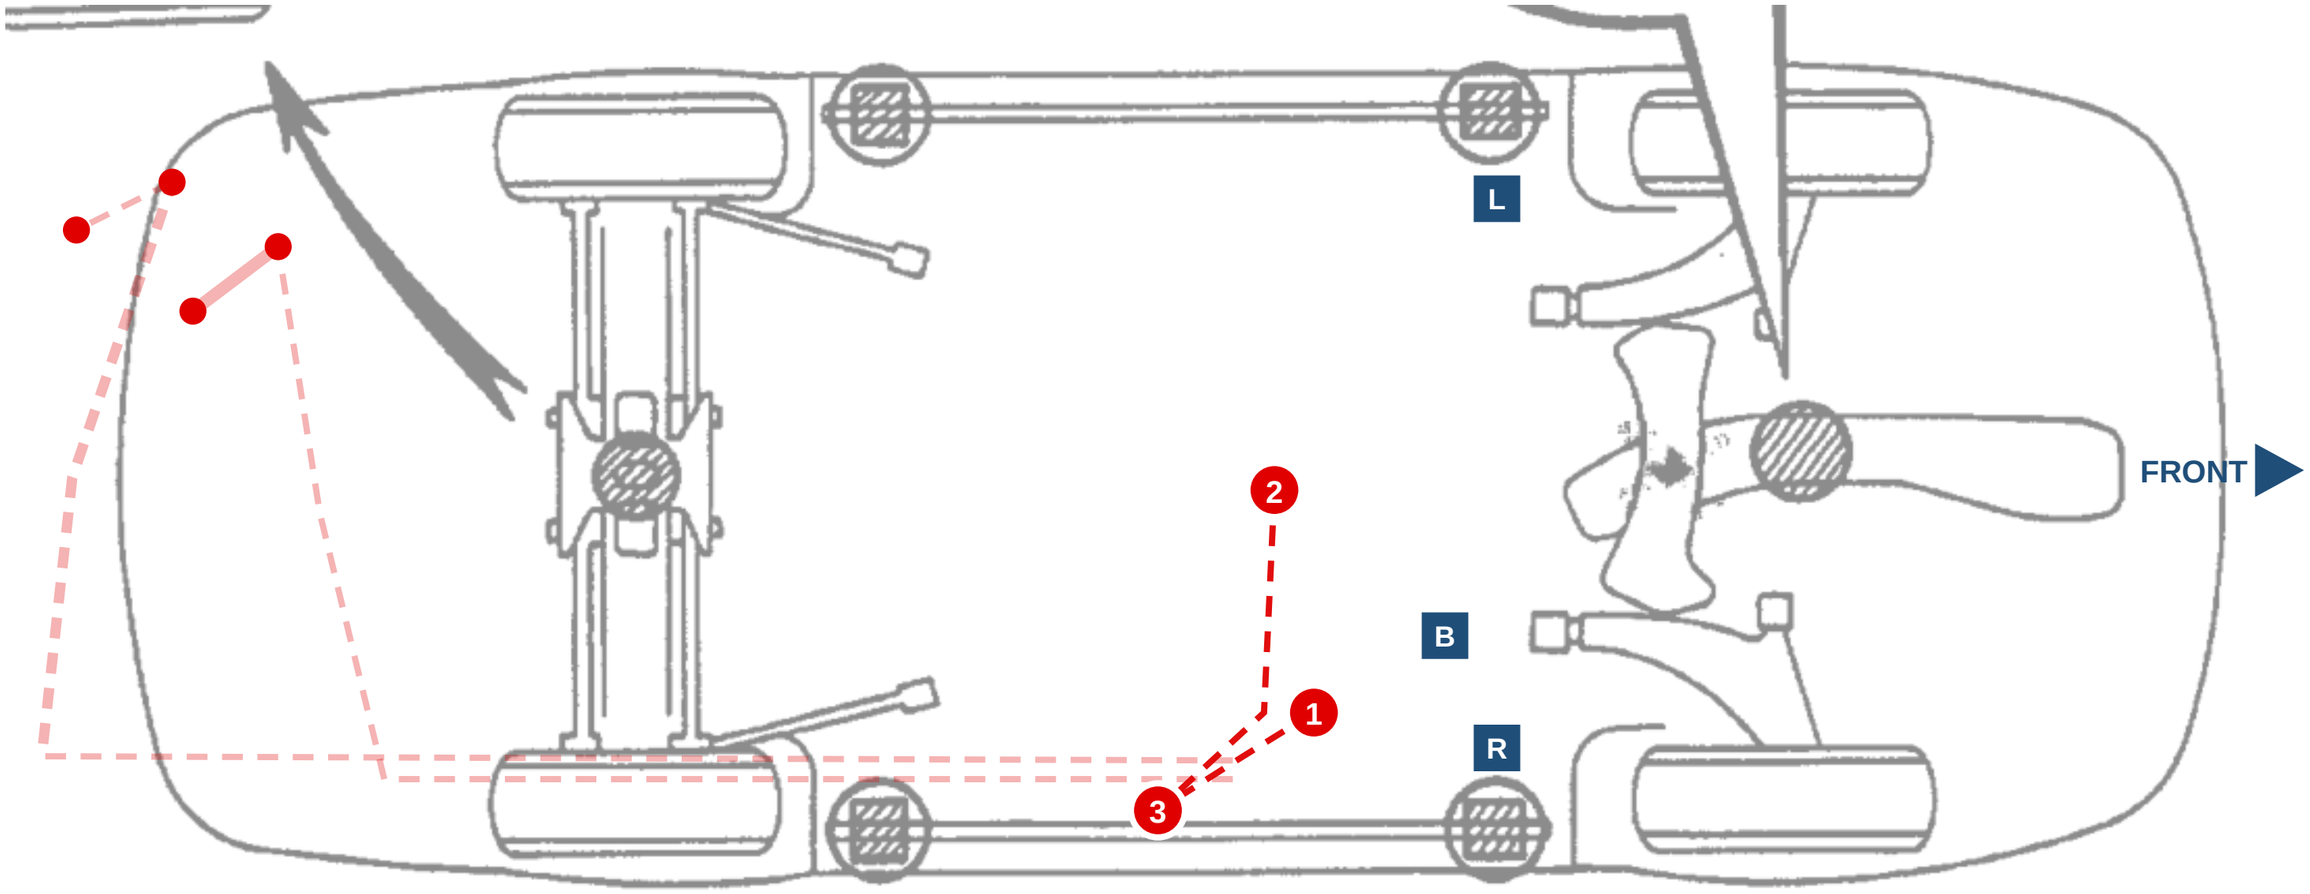


## PASSENGER (RH) SIDE

**REVISIONS**

| REV | DATE | BY | DESCRIPTION |
|---|---|---|---|
| I | 2026-10-27 | DG | Crank and cam each run in one shielded Raychem cable (2-core / 3-core). The CAN-Lambda bra... |
| J | 2026-10-28 | DG | ECU engine harness layout tree built from Route 16 (Dan's device spots and branches, DECISIO... |
| K | 2026-10-29 | DG | Ignition coil ground goes straight to the glove-box POWER box NEG bar through bulkhead cavity ... |
| L | 2026-10-29 | DG | Every connector part-way along a line or run breaks out at least 6 in (152 mm) off it; the last conn... |

**ST185-harness - every wiring harness of the car, one drawing set**


Layout - ST185-RearFuel - ROUTE-11-REARFUEL

| DRAWING NO. | REV | SHEET | SIZE | DRAWN | DATE |
|---|---|---|---|---|---|
| ST185-harness-LAY | L | 33 OF 35 | 432 x 279 mm | DG | 2026-10-29 |

ST185 Celica (living-relation) - generated by docs/harness/tools/build_drawings.py from docs/harness/MASTER-wirelist.csv; not to scale

**LAYOUT - ST185-RearFuel - ROUTE 11 REARFUEL, as approved (3 of 4)**

Fig. 2 · Body, liftback, TIS 1993 EWD p.46 (tis1993-wiring-routing-2.pdf, sheet 11). Car front on the left; the near side is the driver side, so the passenger-side runs are on the far side (drawn approximately). Red solid = RearFuel itself: the short lead from IX_FUEL_LVL (4) to the fuel level sender (5). Dashed = the fuel level lead (B-cabin) and the k_fp coil wires (Route 7, Route 5) coming down the passenger side, and the pump feed (HeavyD...

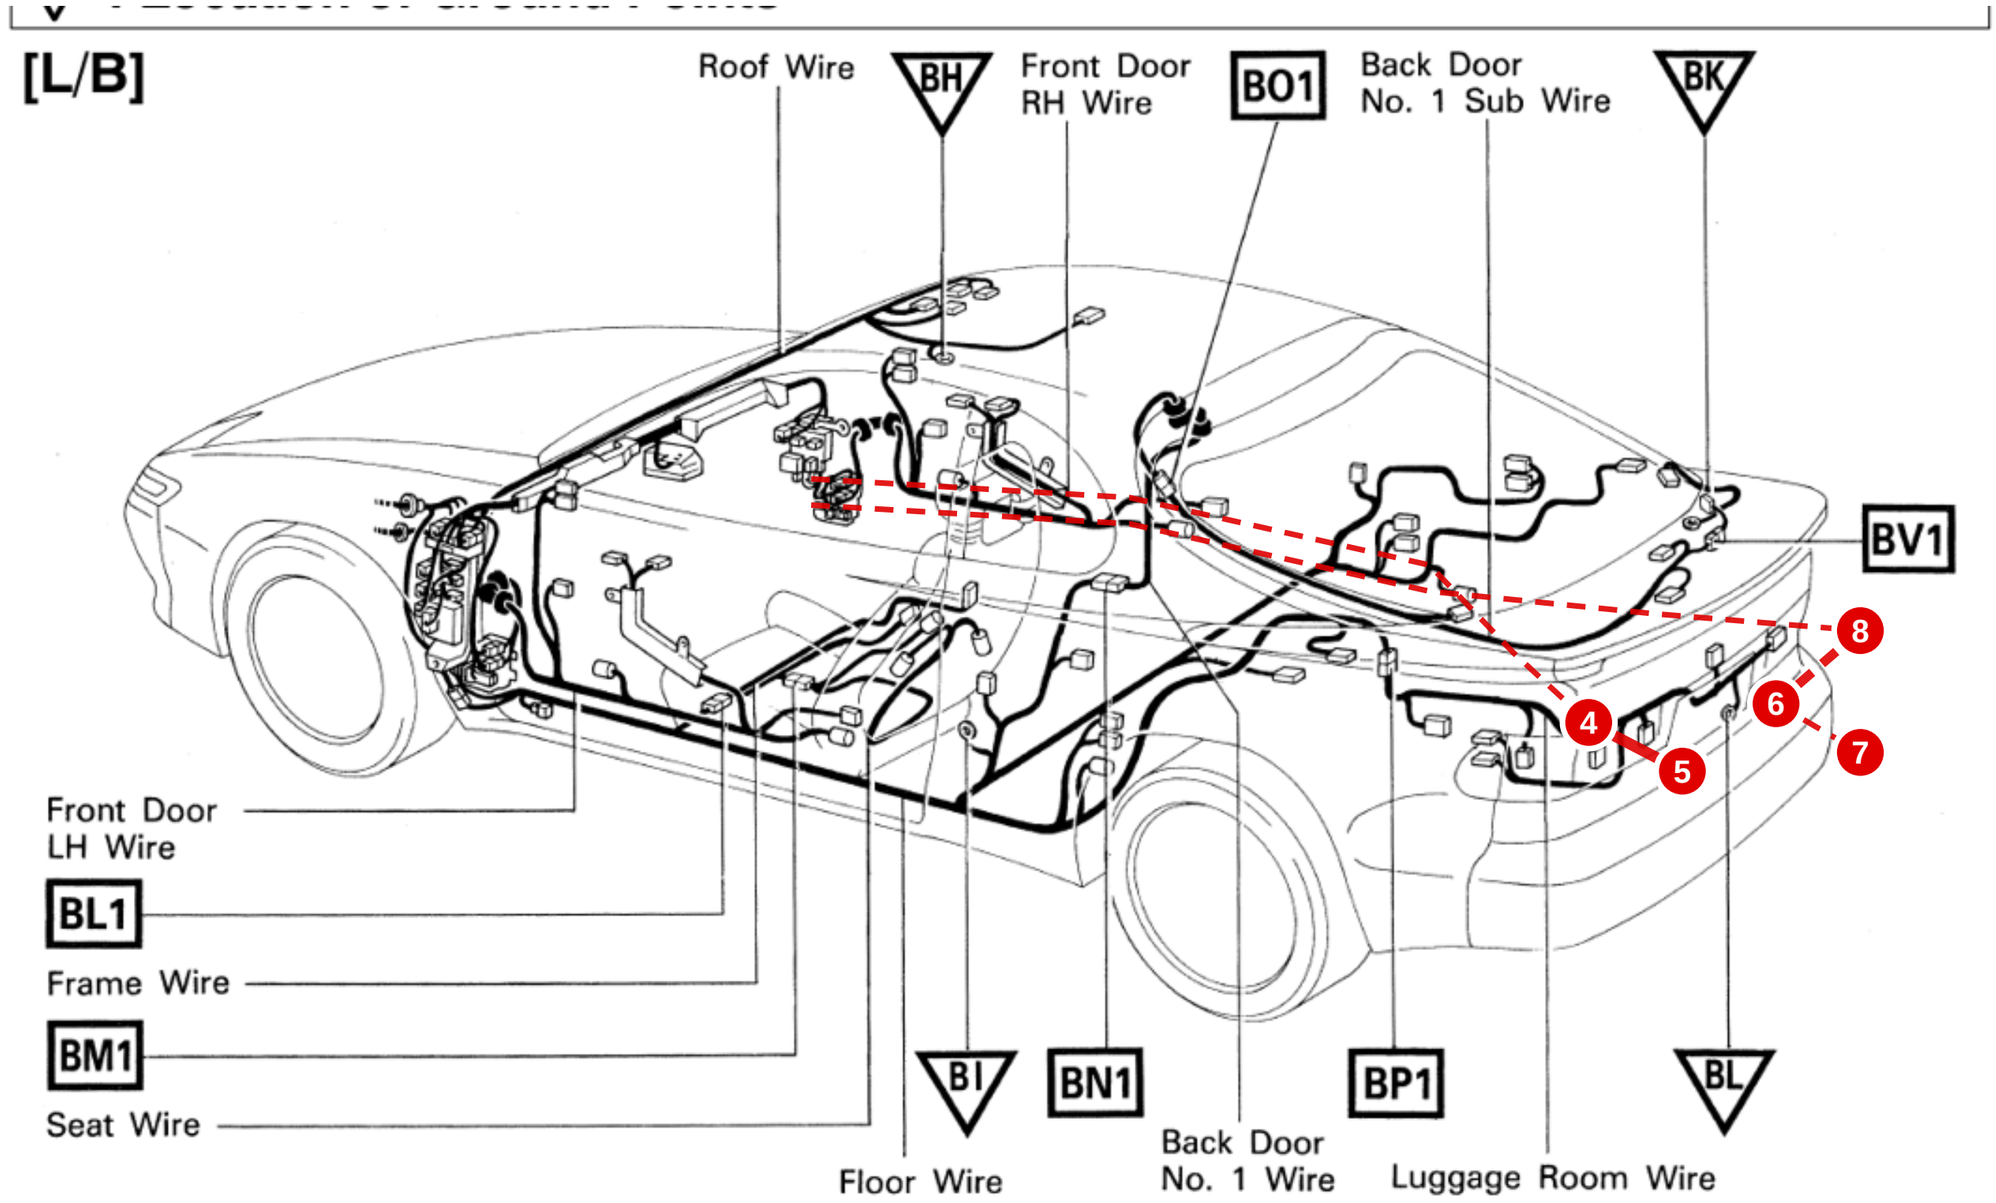


**REVISIONS**

| REV | DATE | BY | DESCRIPTION |
|---|---|---|---|
| I | 2026-10-27 | DG | Crank and cam each run in one shielded Raychem cable (2-core / 3-core). The CAN-Lambda bra... |
| J | 2026-10-28 | DG | ECU engine harness layout tree built from Route 16 (Dan's device spots and branches, DECISIO... |
| K | 2026-10-29 | DG | Ignition coil ground goes straight to the glove-box POWER box NEG bar through bulkhead cavity ... |
| L | 2026-10-29 | DG | Every connector part-way along a line or run breaks out at least 6 in (152 mm) off it; the last conn... |

**ST185-harness - every wiring harness of the car, one drawing set**

Layout - ST185-RearFuel - ROUTE-11-REARFUEL


| DRAWING NO. | REV | SHEET | SIZE | DRAWN | DATE |
|---|---|---|---|---|---|
| ST185-harness-LAY | L | 34 OF 35 | 432 x 279 mm | DG | 2026-10-29 |

ST185 Celica (living-relation) - generated by docs/harness/tools/build_drawings.py from docs/harness/MASTER-wirelist.csv; not to scale

**LAYOUT - ST185-RearFuel - ROUTE 11 REARFUEL, as approved (4 of 4)**

Top view for the figure above · same route, same colors. Drawn to match the figure above (approximate); this figure·s part is bright, the rest of the route is faded. Blue squares: B = bulkhead A/B (DRB102, RH firewall), R / L = RH / LH fender pass-throughs (Route 9 rev 2). Top view base: 1993 Celica repair manual RM305U1, Introduction, ·Vehicle Lift and Support Locations·, p. IN·24 (st185-celica-repair-manual\manuals\RM305U1 - Introduction - V...

## DRIVER (LH) SIDE

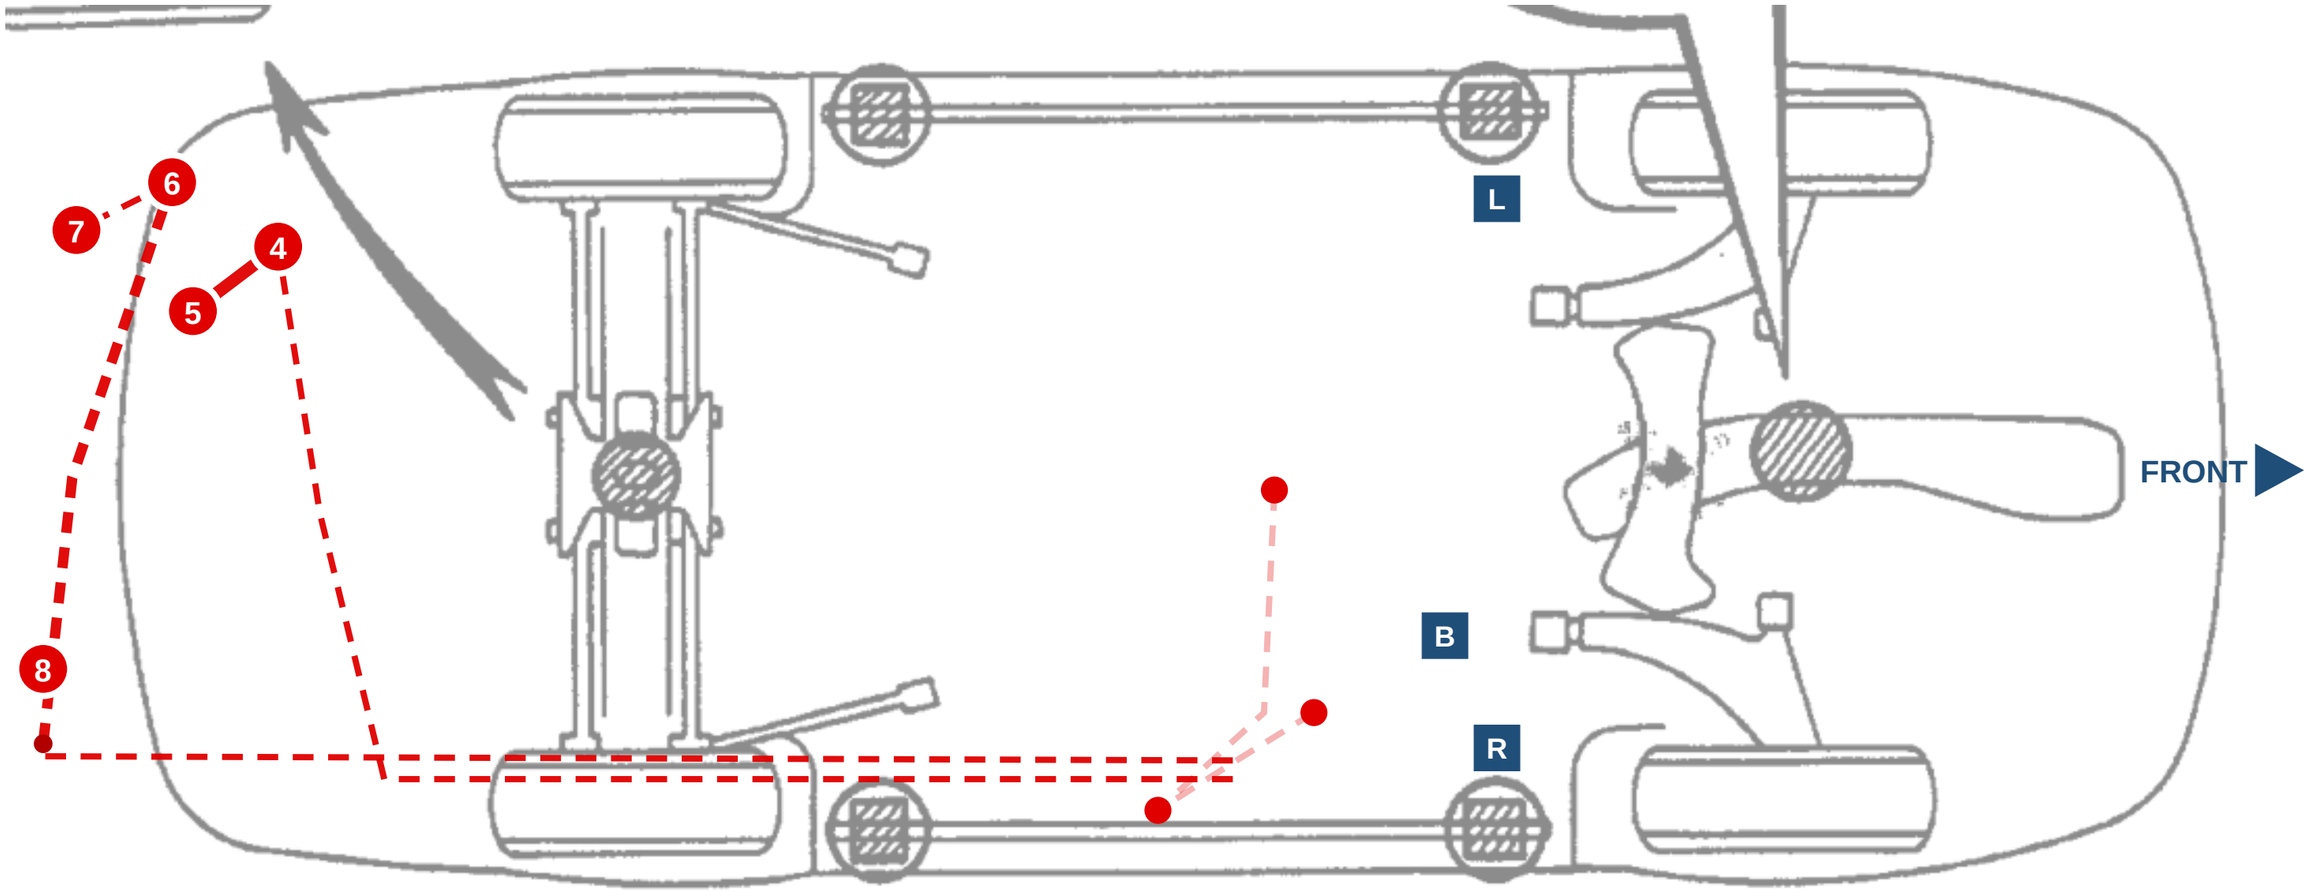


## PASSENGER (RH) SIDE

**REVISIONS**

| REV | DATE | BY | DESCRIPTION |
|---|---|---|---|
| I | 2026-10-27 | DG | Crank and cam each run in one shielded Raychem cable (2-core / 3-core). The CAN-Lambda bra... |
| J | 2026-10-28 | DG | ECU engine harness layout tree built from Route 16 (Dan's device spots and branches, DECISIO... |
| K | 2026-10-29 | DG | Ignition coil ground goes straight to the glove-box POWER box NEG bar through bulkhead cavity ... |
| L | 2026-10-29 | DG | Every connector part-way along a line or run breaks out at least 6 in (152 mm) off it; the last conn... |

**ST185-harness - every wiring harness of the car, one drawing set**

Layout - ST185-RearFuel - ROUTE-11-REARFUEL

| DRAWING NO. | REV | SHEET | SIZE | DRAWN | DATE |
|---|---|---|---|---|---|
| ST185-harness-LAY | L | 35 OF 35 | 432 x 279 mm | DG | 2026-10-29 |