
LAYOUT - ST185-AB-cabin - ROUTE 5 A CABIN, as approved (1 of 2)

Fig. 1 · Instrument panel, TIS 1993 EWD ·Relay Locations· p.18 (tis1993-relay-locations.pdf, sheet 1). Driver side on the left, passenger/glove box on the right. Red = A-cabin trunk (thick, ECU · bulkhead A) and its cabin branches. ECU at the factory ECM spot (accepted by Dan 2026·10·05). Rev 2: the front VRC and IX_WS_FRONT sit in the middle of the dash right above the ECU; thin dashed = the FL / FR sensor cables (WheelSpeed-Front, drawn

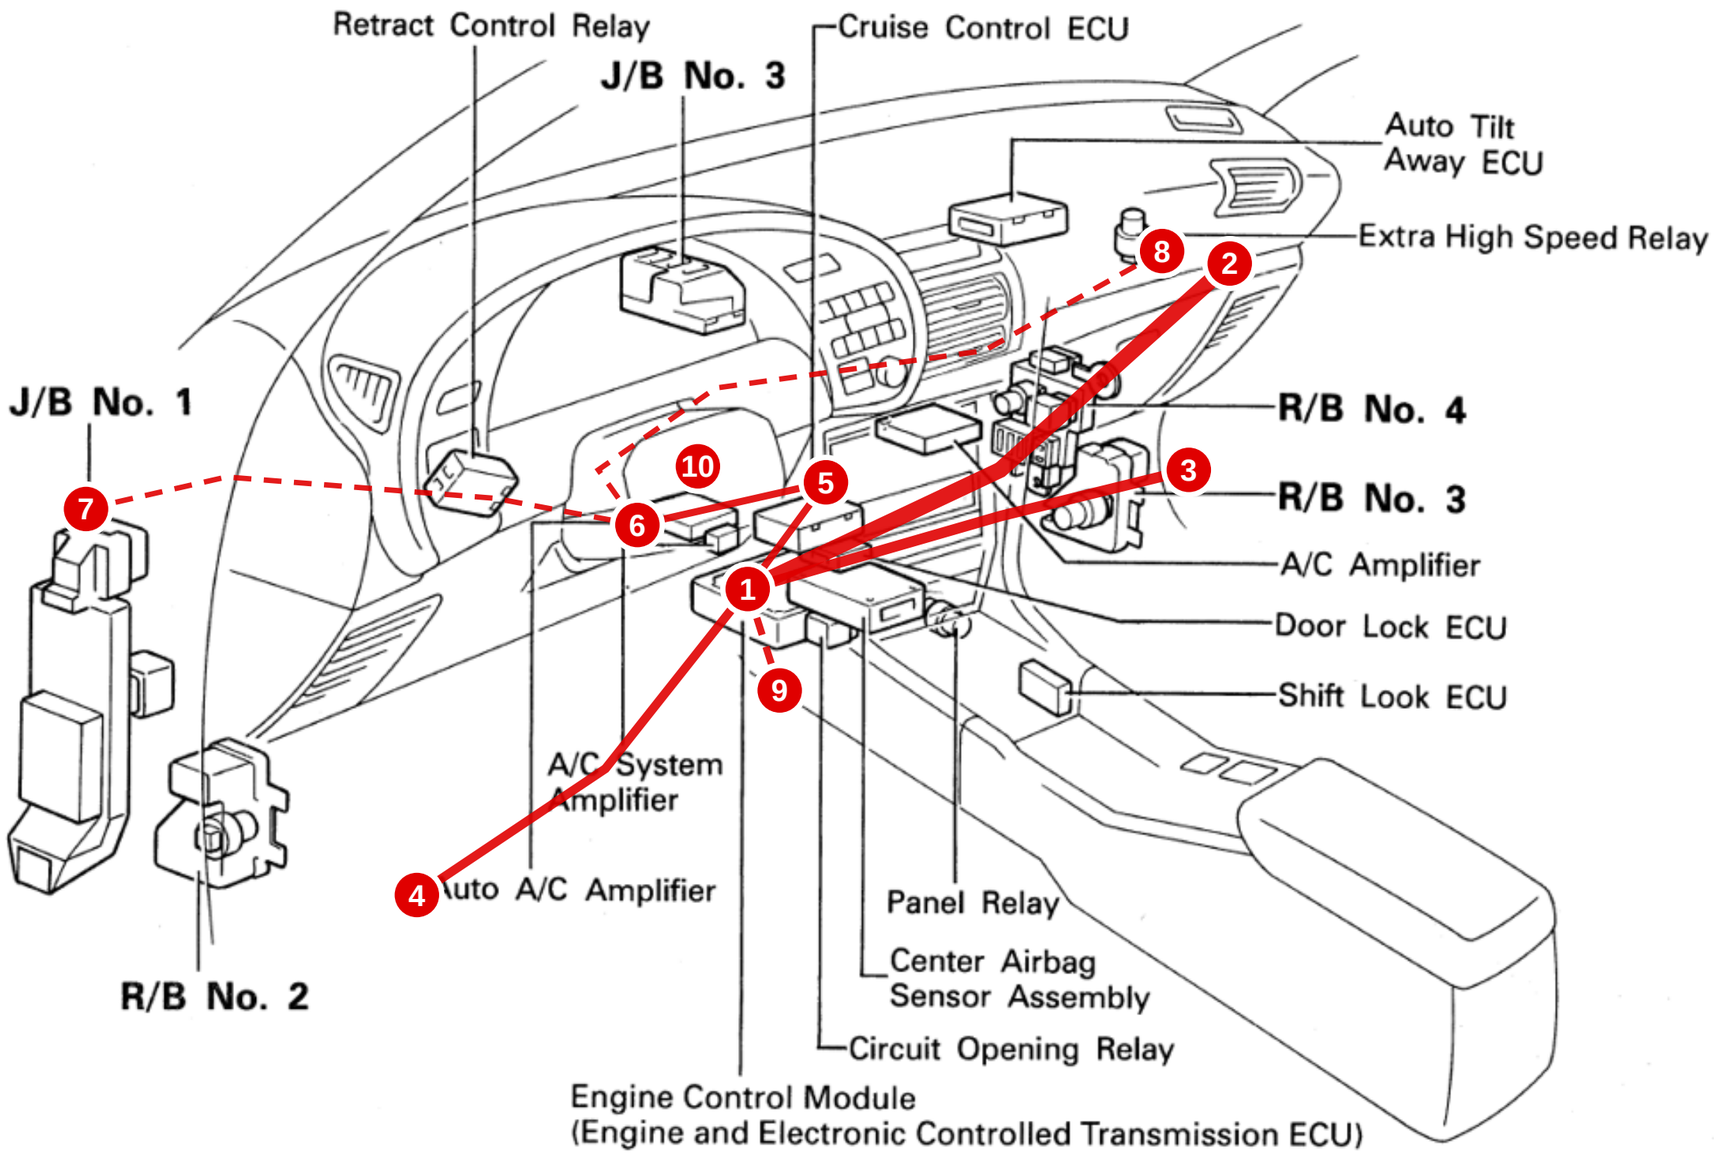

REVISIONS

REV	DATE	BY	DESCRIPTION
C	2026-10-26	DG	A15 lock-sensor input takes a modified tacho: Ign 8 through 4.7 k· to pin 9 (N61 workaround).
D	2026-10-26	DG	Car-check answers: if the ignition-switch black-orange wire is at the engine plug, remove it; A/C s...
E	2026-10-26	DG	C11 is hardware starter interlock only; Aux 8 spare. Oil LED stays on CSB3 L4.
F	2026-10-26	DG	Each grouped section is its own page. A schematic page holds six wires, each in its own line colo...

ST185-harness - every wiring harness of the car, one drawing set

Layout - ST185-AB-cabin - ROUTE-5-A-CABIN


DRAWING NO.	REV	SHEET	SIZE	DRAWN	DATE
ST185-harness-LAY	F	1 OF 65	432 x 279 mm	DG	2026-10-26

ST185 Celica (living-relation) - generated by docs/harness/tools/build_drawings.py from docs/harness/MASTER-wirelist.csv; not to scale

LAYOUT - ST185-AB-cabin - ROUTE 5 A CABIN, as approved (2 of 2)

Top view for the figure above · same route, same colors. Projected from the figure above (approximate); this figure·s part is bright, the rest of the route is faded. Blue squares: B = bulkhead A/B (DRB102, RH firewall), R / L = RH / LH fender pass-throughs (Route 9 rev 2). Top view base: 1993 Celica repair manual RM305U1, Introduction, ·Vehicle Lift and Support Locations·, p. IN·24 (st185-celica-repair-manual\manuals\RM305U1 - Introduction - Ve...

DRIVER (LH) SIDE

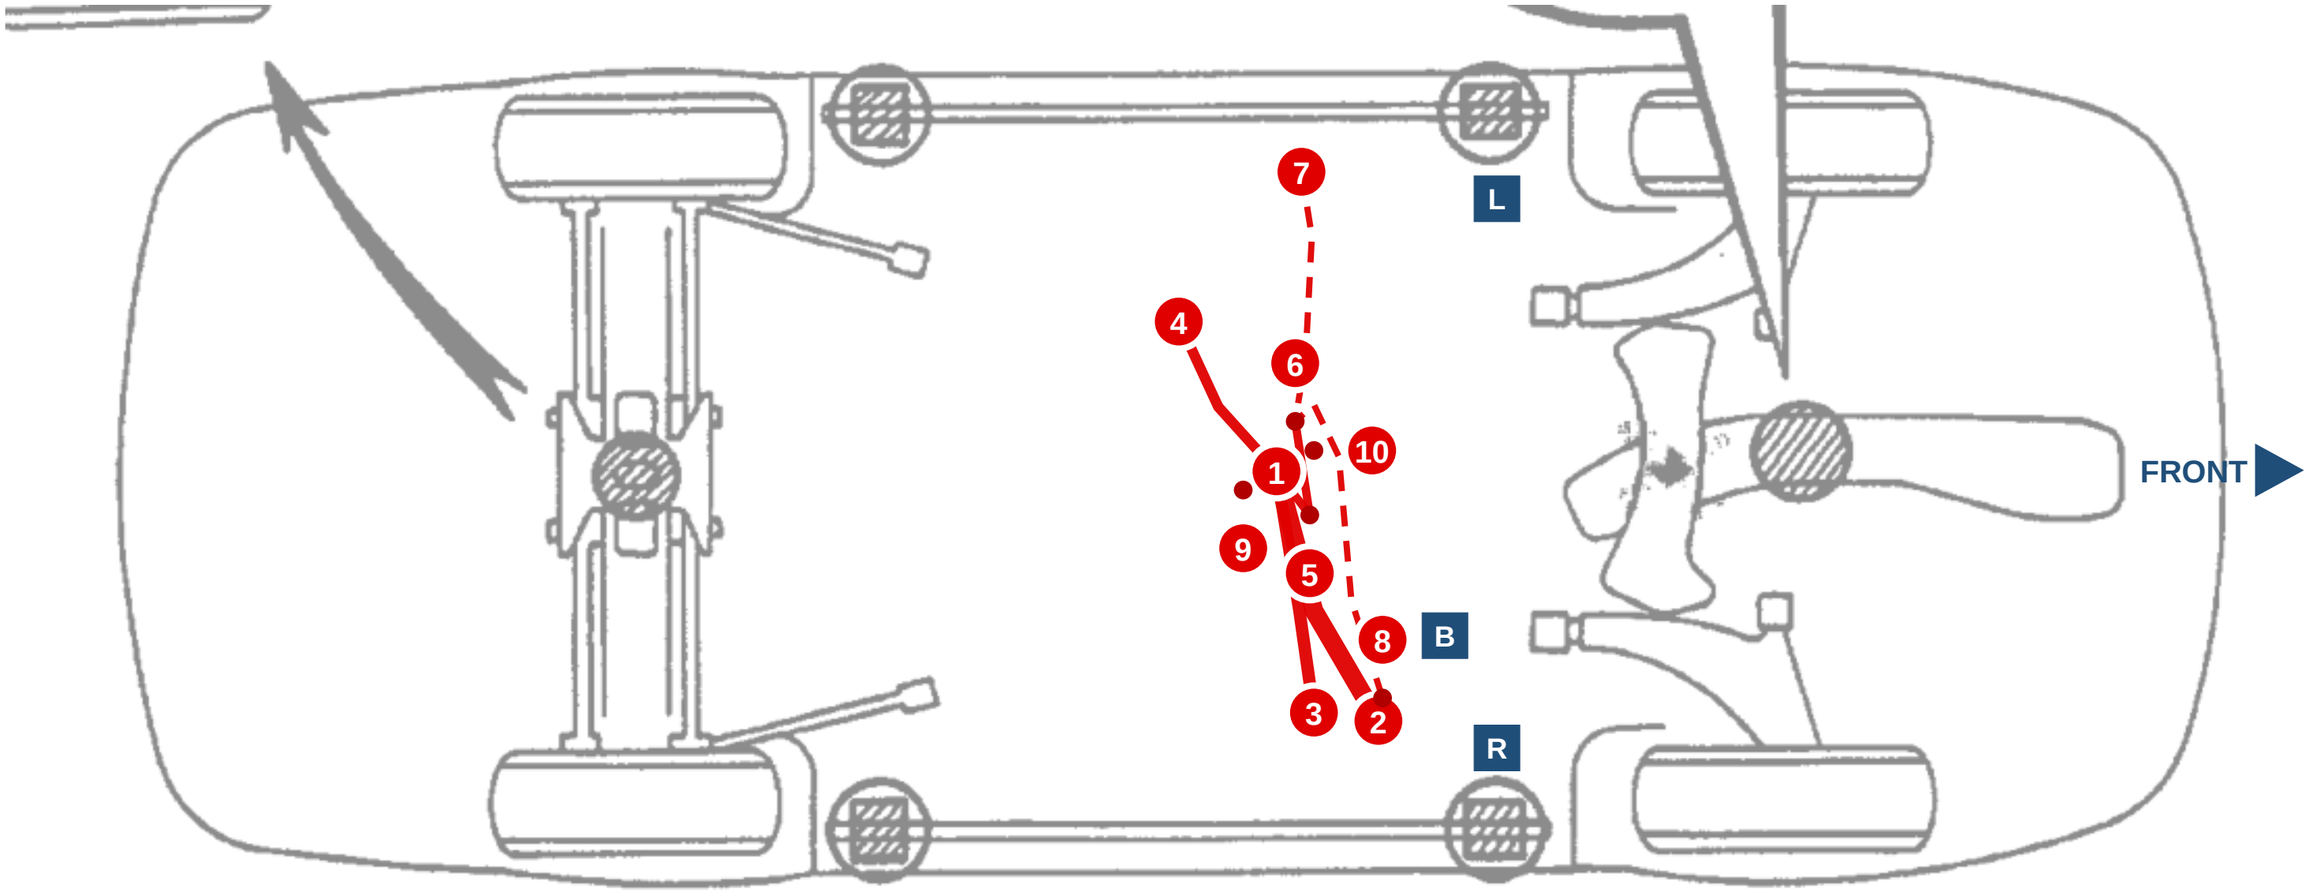

PASSENGER (RH) SIDE

REVISIONS			
REV	DATE	BY	DESCRIPTION
C	2026-10-26	DG	A15 lock-sensor input takes a modified tacho: Ign 8 through 4.7 k· to pin 9 (N61 workaround).
D	2026-10-26	DG	Car-check answers: if the ignition-switch black-orange wire is at the engine plug, remove it; A/C s...
E	2026-10-26	DG	C11 is hardware starter interlock only; Aux 8 spare. Oil LED stays on CSB3 L4.
F	2026-10-26	DG	Each grouped section is its own page. A schematic page holds six wires, each in its own line colo...

ST185-harness - every wiring harness of the car, one drawing set


Layout - ST185-AB-cabin - ROUTE-5-A-CABIN

DRAWING NO.	REV	SHEET	SIZE	DRAWN	DATE
ST185-harness-LAY	F	2 OF 65	432 x 279 mm	DG	2026-10-26

ST185 Celica (living-relation) - generated by docs/harness/tools/build_drawings.py from docs/harness/MASTER-wirelist.csv; not to scale

LAYOUT - ST185-AB-cabin - ROUTE 6 B CABIN, as approved (1 of 2)

Fig. 1 · Instrument panel, TIS 1993 EWD ·Relay Locations· p.18 (tis1993-relay-locations.pdf, sheet 1). Driver side left, glove box right. Red = B-cabin trunk (thick, ECU B · bulkhead B) and its cabin branches. Rev 2 (Dan·s mark-up 2026·10·10): the anti-theft unit is in the center dash just left of the ECU (B27 run there); the fuel level (B24) and the fuel pump feed run from the glove-box area down the passenger side to the trunk / RearFuel hand-off (das

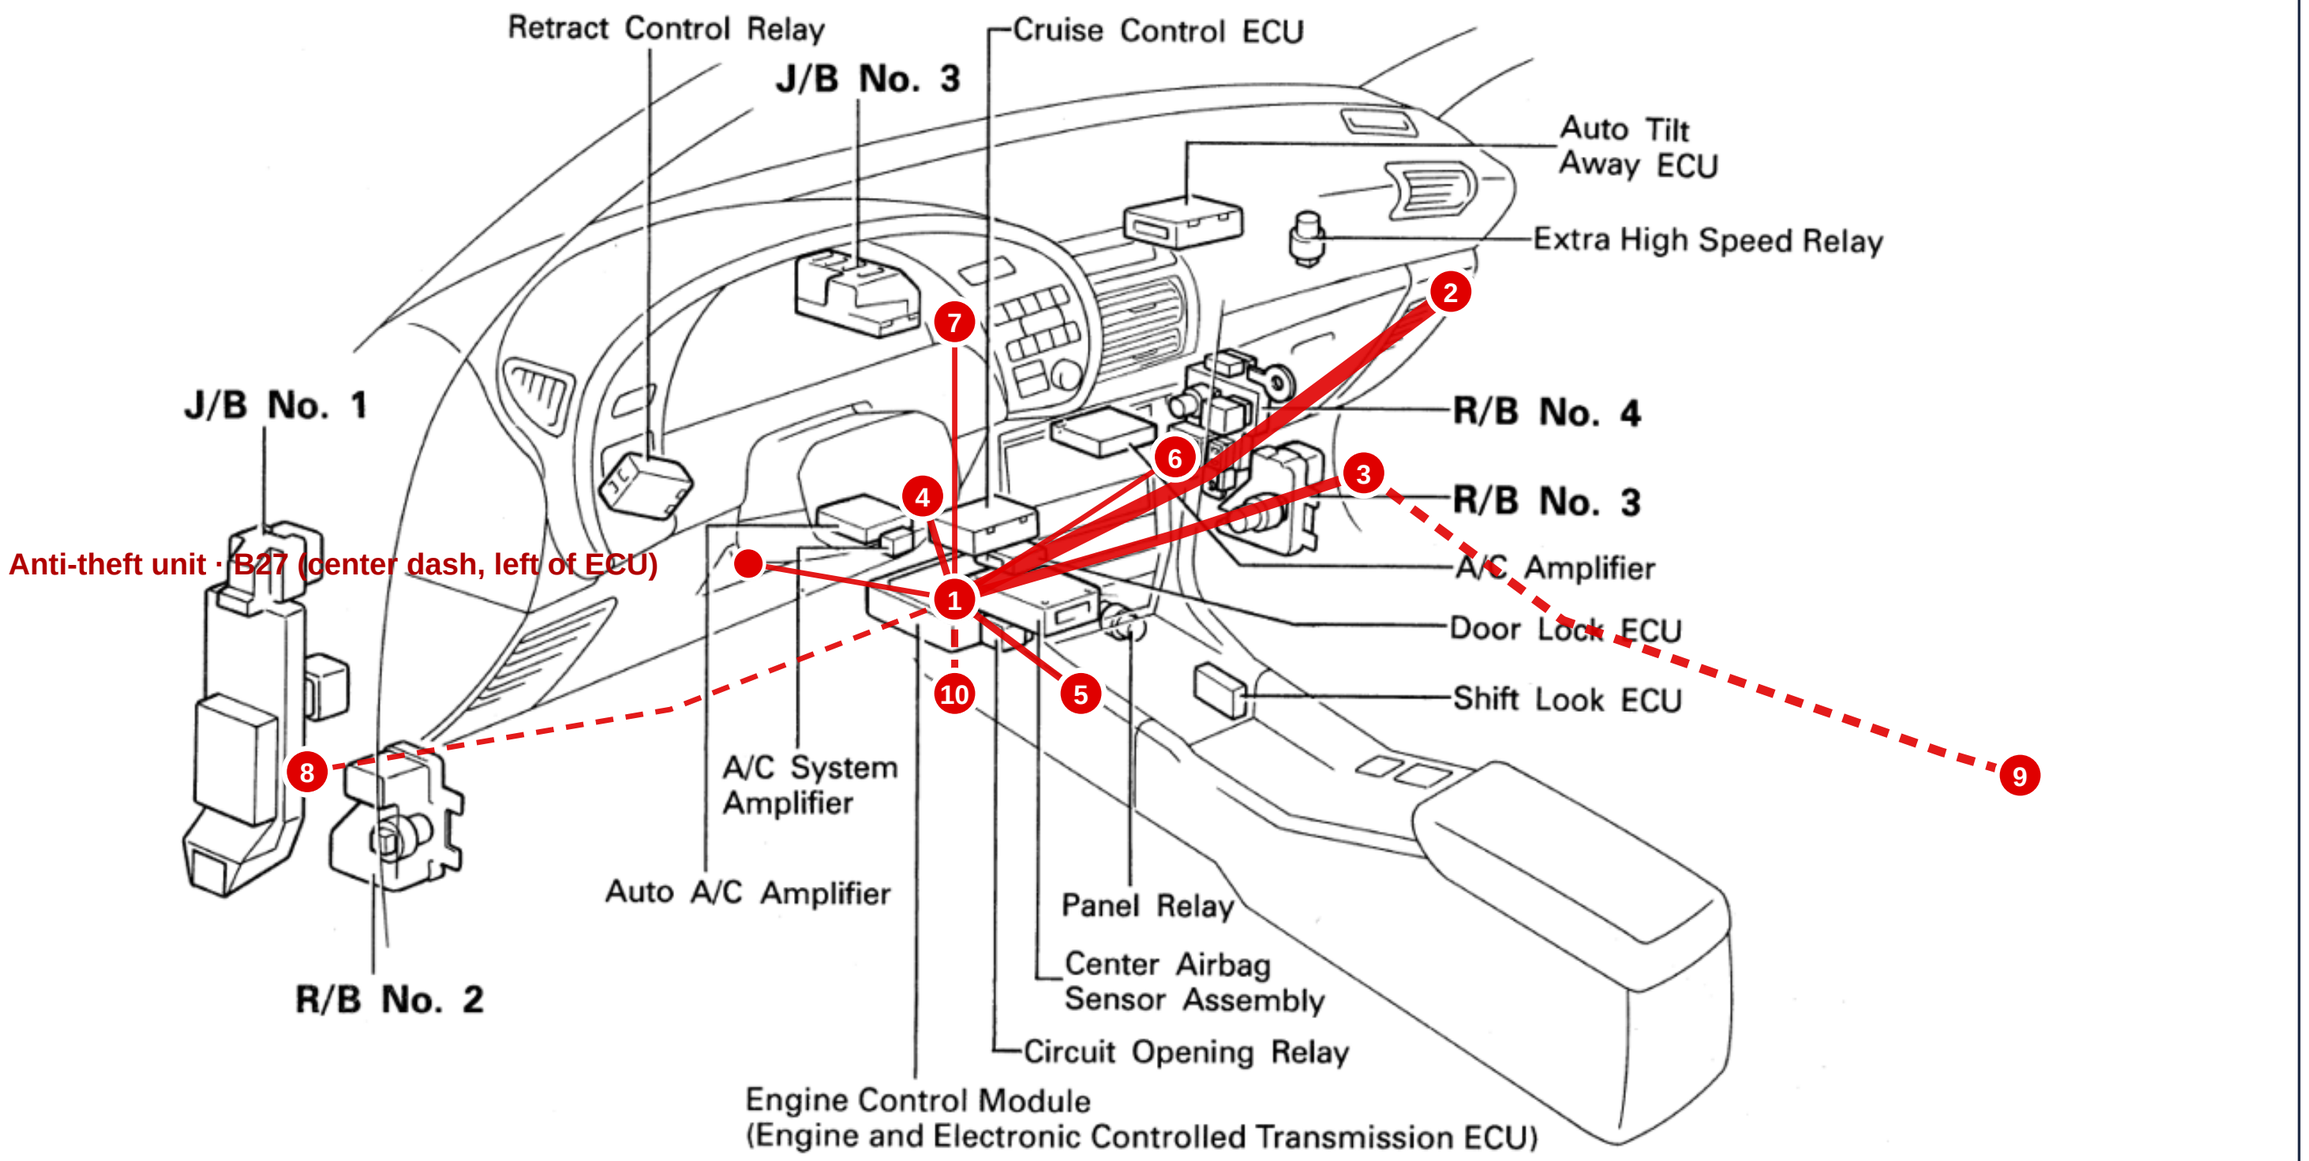

REVISIONS			
REV	DATE	BY	DESCRIPTION
C	2026-10-26	DG	A15 lock-sensor input takes a modified tacho: Ign 8 through 4.7 k· to pin 9 (N61 workaround).
D	2026-10-26	DG	Car-check answers: if the ignition-switch black-orange wire is at the engine plug, remove it; A/C s...
E	2026-10-26	DG	C11 is hardware starter interlock only; Aux 8 spare. Oil LED stays on CSB3 L4.
F	2026-10-26	DG	Each grouped section is its own page. A schematic page holds six wires, each in its own line colo...

ST185-harness - every wiring harness of the car, one drawing set

Layout - ST185-AB-cabin - ROUTE-6-B-CABIN


DRAWING NO.	REV	SHEET	SIZE	DRAWN	DATE
ST185-harness-LAY	F	3 OF 65	432 x 279 mm	DG	2026-10-26

ST185 Celica (living-relation) - generated by docs/harness/tools/build_drawings.py from docs/harness/MASTER-wirelist.csv; not to scale

LAYOUT - ST185-AB-cabin - ROUTE 6 B CABIN, as approved (2 of 2)

Top view for the figure above · same route, same colors. Projected from the figure above (approximate); this figure·s part is bright, the rest of the route is faded. Blue squares: B = bulkhead A/B (DRB102, RH firewall), R / L = RH / LH fender pass-throughs (Route 9 rev 2). Top view base: 1993 Celica repair manual RM305U1, Introduction, ·Vehicle Lift and Support Locations·, p. IN·24 (st185-celica-repair-manual\manuals\RM305U1 - Introduction - Ve...

DRIVER (LH) SIDE

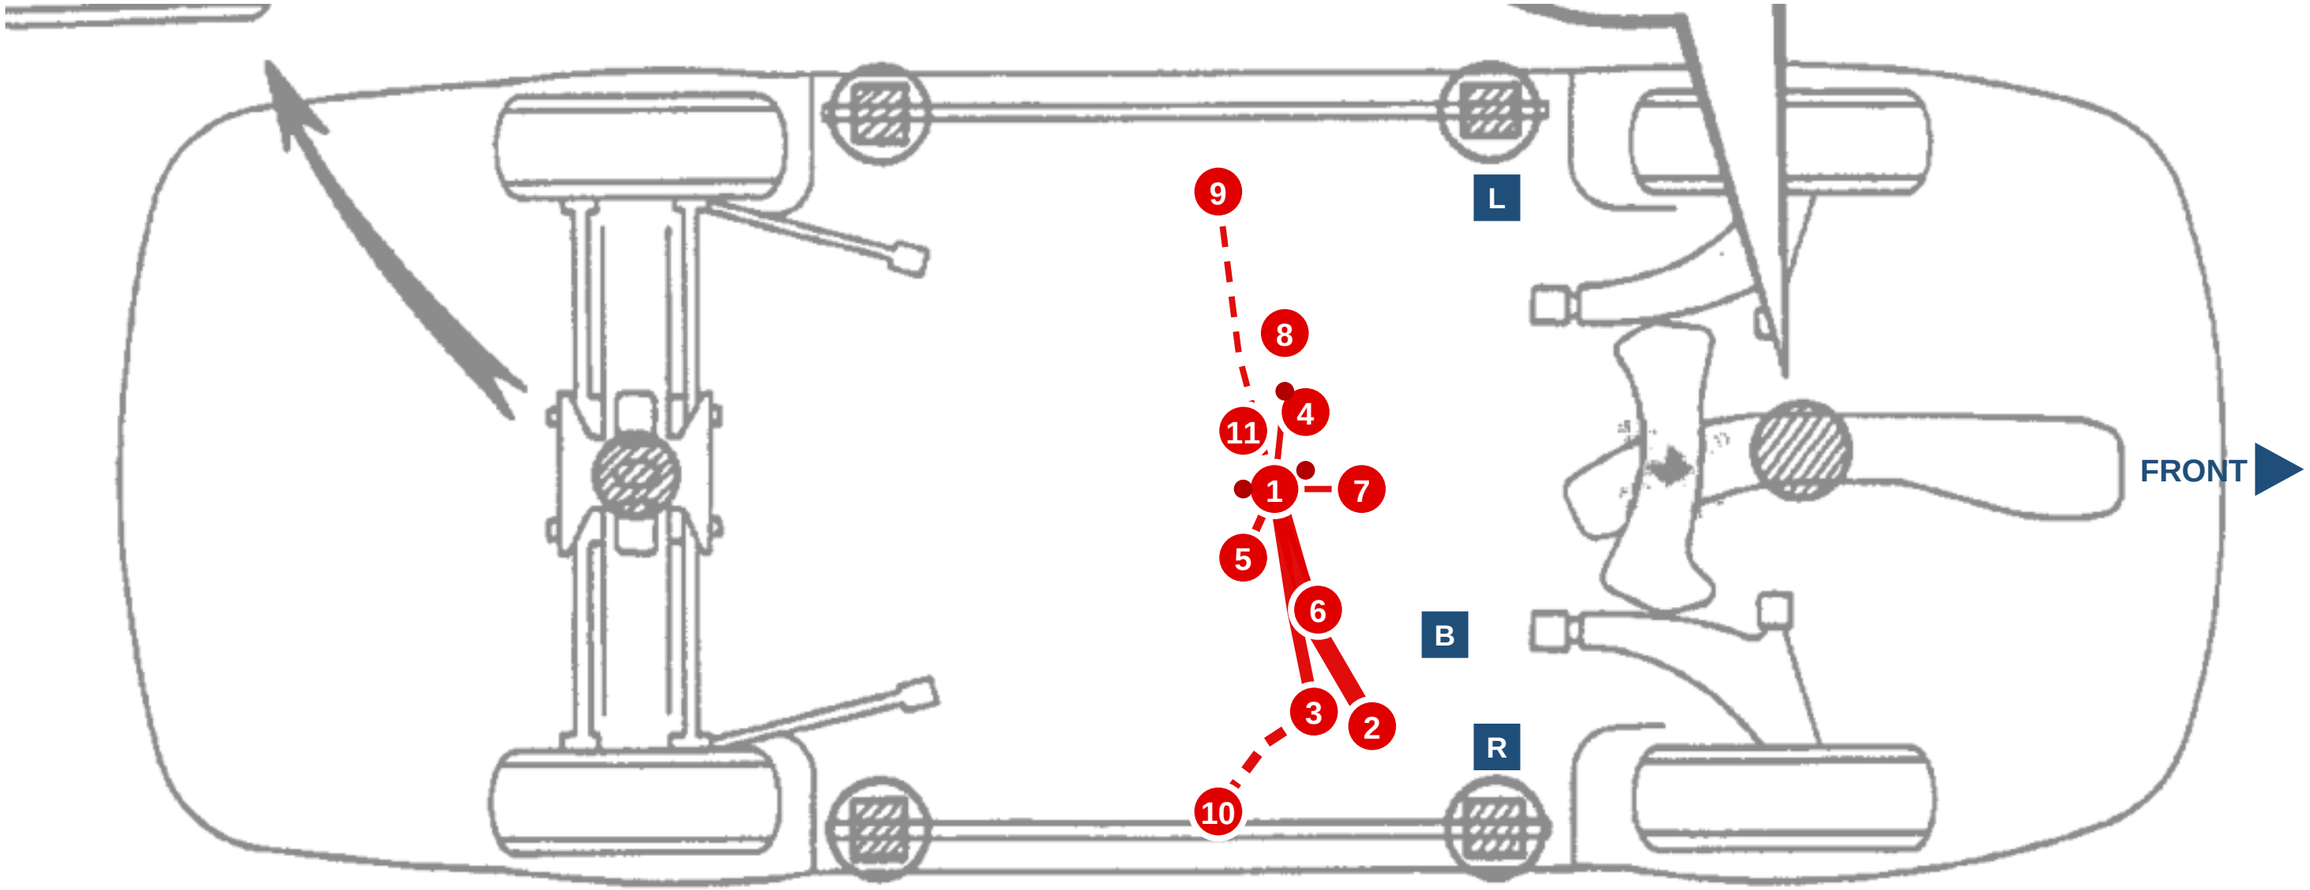

PASSENGER (RH) SIDE

REVISIONS

REV	DATE	BY	DESCRIPTION
C	2026-10-26	DG	A15 lock-sensor input takes a modified tacho: Ign 8 through 4.7 k· to pin 9 (N61 workaround).
D	2026-10-26	DG	Car-check answers: if the ignition-switch black-orange wire is at the engine plug, remove it; A/C s...
E	2026-10-26	DG	C11 is hardware starter interlock only; Aux 8 spare. Oil LED stays on CSB3 L4.
F	2026-10-26	DG	Each grouped section is its own page. A schematic page holds six wires, each in its own line colo...

ST185-harness - every wiring harness of the car, one drawing set


Layout - ST185-AB-cabin - ROUTE-6-B-CABIN

DRAWING NO.	REV	SHEET	SIZE	DRAWN	DATE
ST185-harness-LAY	F	4 OF 65	432 x 279 mm	DG	2026-10-26

ST185 Celica (living-relation) - generated by docs/harness/tools/build_drawings.py from docs/harness/MASTER-wirelist.csv; not to scale

LAYOUT - ST185-AB-engine - ROUTE 3 A ENGINE, as approved (1 of 10)

Fig. 1 · Engine compartment, 3S-GTE, TIS 1993 EWD ·Position of Parts in Engine Compartment· p.29 (tis1993-wiring-routing.pdf, sheet 2), · rev 2: every device spot is from Dan·s black labels on rev 1 (2026·10·04), read off his mark-up image (approximate). Firewall at top, driver side on the right. Red = A-engine trunk (thick) with branches; (S) = shielded, each its own cable. Blue squares = B-engine devices Dan also placed · recorded for the B-engi

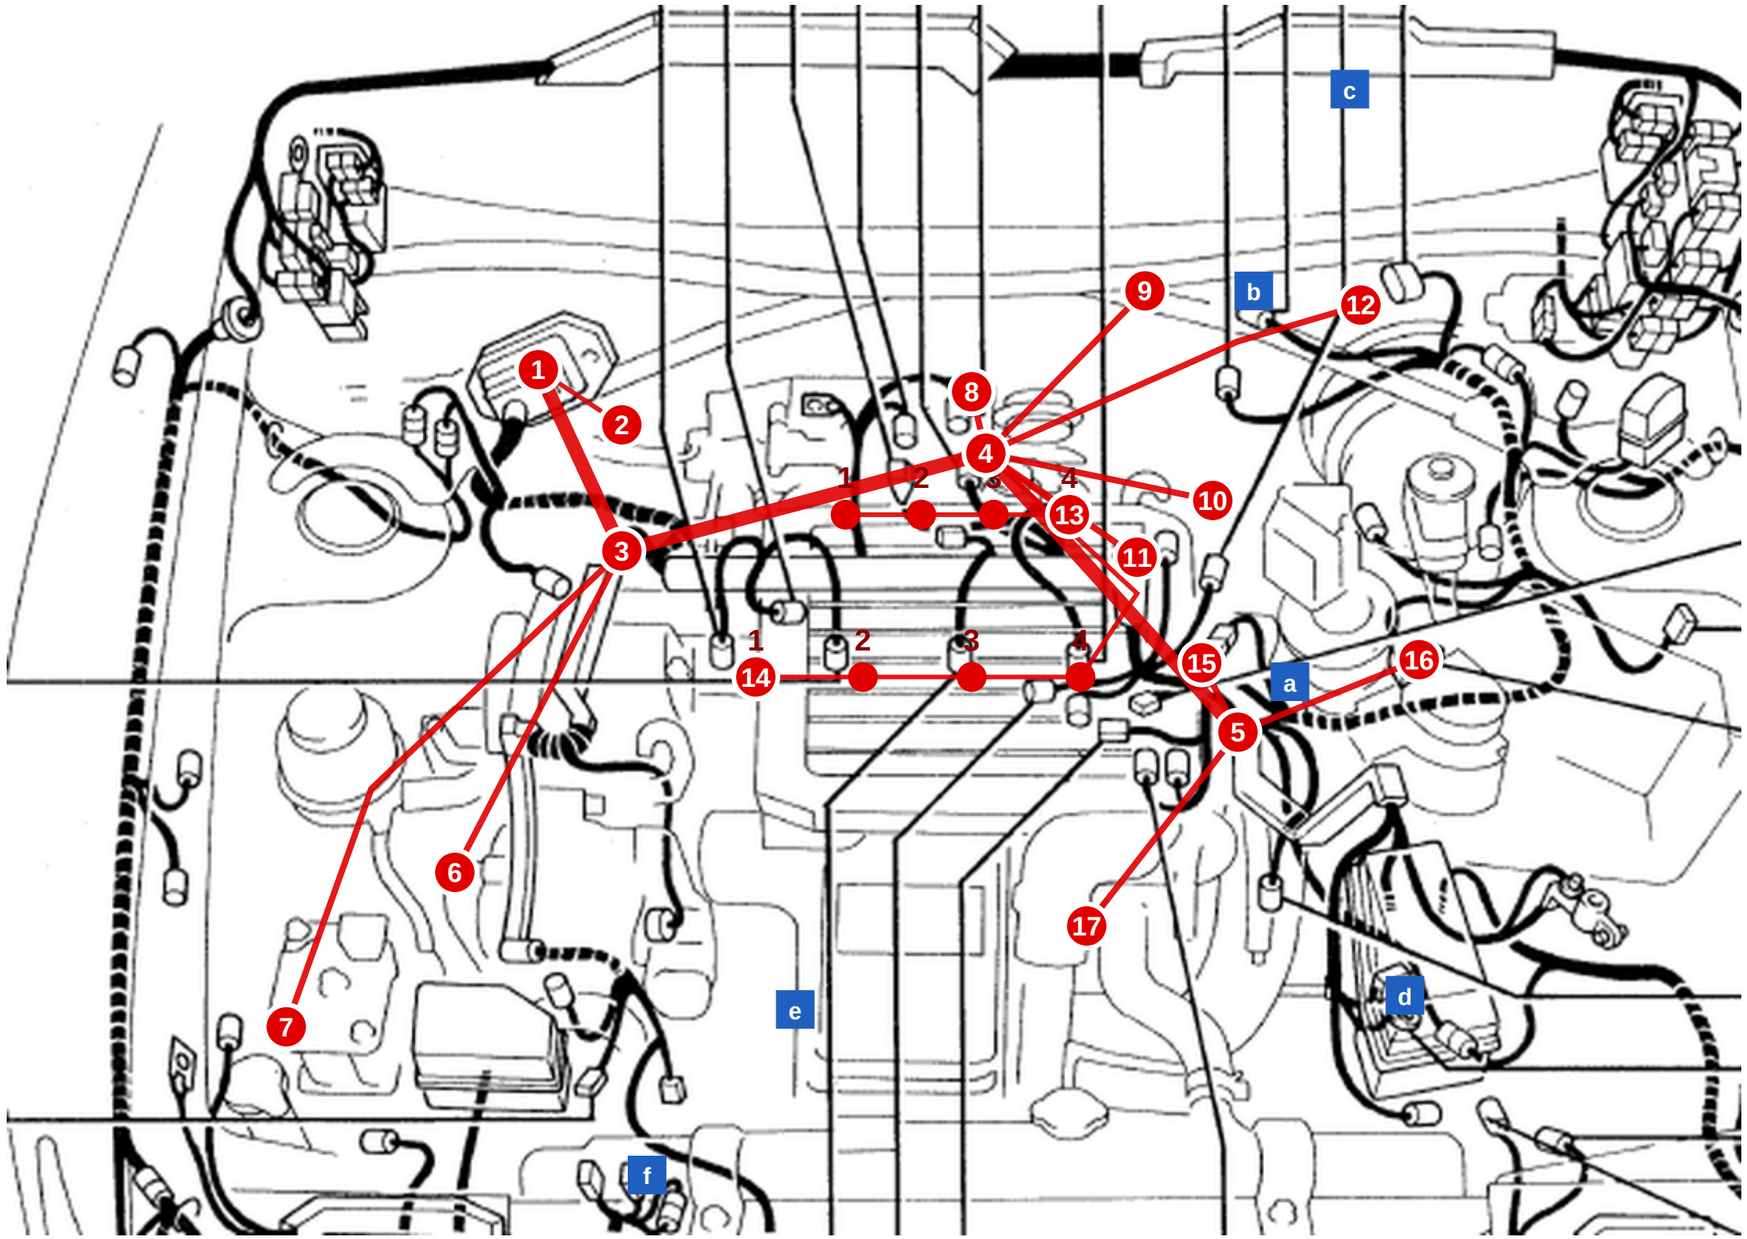

REVISIONS			
REV	DATE	BY	DESCRIPTION
C	2026-10-26	DG	A15 lock-sensor input takes a modified tacho: Ign 8 through 4.7 k· to pin 9 (N61 workaround).
D	2026-10-26	DG	Car-check answers: if the ignition-switch black-orange wire is at the engine plug, remove it; A/C s...
E	2026-10-26	DG	C11 is hardware starter interlock only; Aux 8 spare. Oil LED stays on CSB3 L4.
F	2026-10-26	DG	Each grouped section is its own page. A schematic page holds six wires, each in its own line colo...

ST185-harness - every wiring harness of the car, one drawing set

Layout - ST185-AB-engine - ROUTE-3-A-ENGINE


DRAWING NO.	REV	SHEET	SIZE	DRAWN	DATE
ST185-harness-LAY	F	5 OF 65	432 x 279 mm	DG	2026-10-26

ST185 Celica (living-relation) - generated by docs/harness/tools/build_drawings.py from docs/harness/MASTER-wirelist.csv; not to scale

LAYOUT - ST185-AB-engine - ROUTE 3 A ENGINE, as approved (2 of 10)

Top view · same route and colors, projected from the drawing above (approximate). Bright = this view·s part, faded = the rest. Blue squares: B = bulkhead A/B (DRB102), R / L = RH / LH fender pass-throughs. Top view base: 1993 Celica repair manual RM305U1, Introduction, ·Vehicle Lift and Support Locations·, p. IN·24 (st185-celica-repair-manual\manuals\RM305U1 - Introduction - Vehicle Lift and Support Locations.pdf), car outline only, lightene...

DRIVER (LH) SIDE

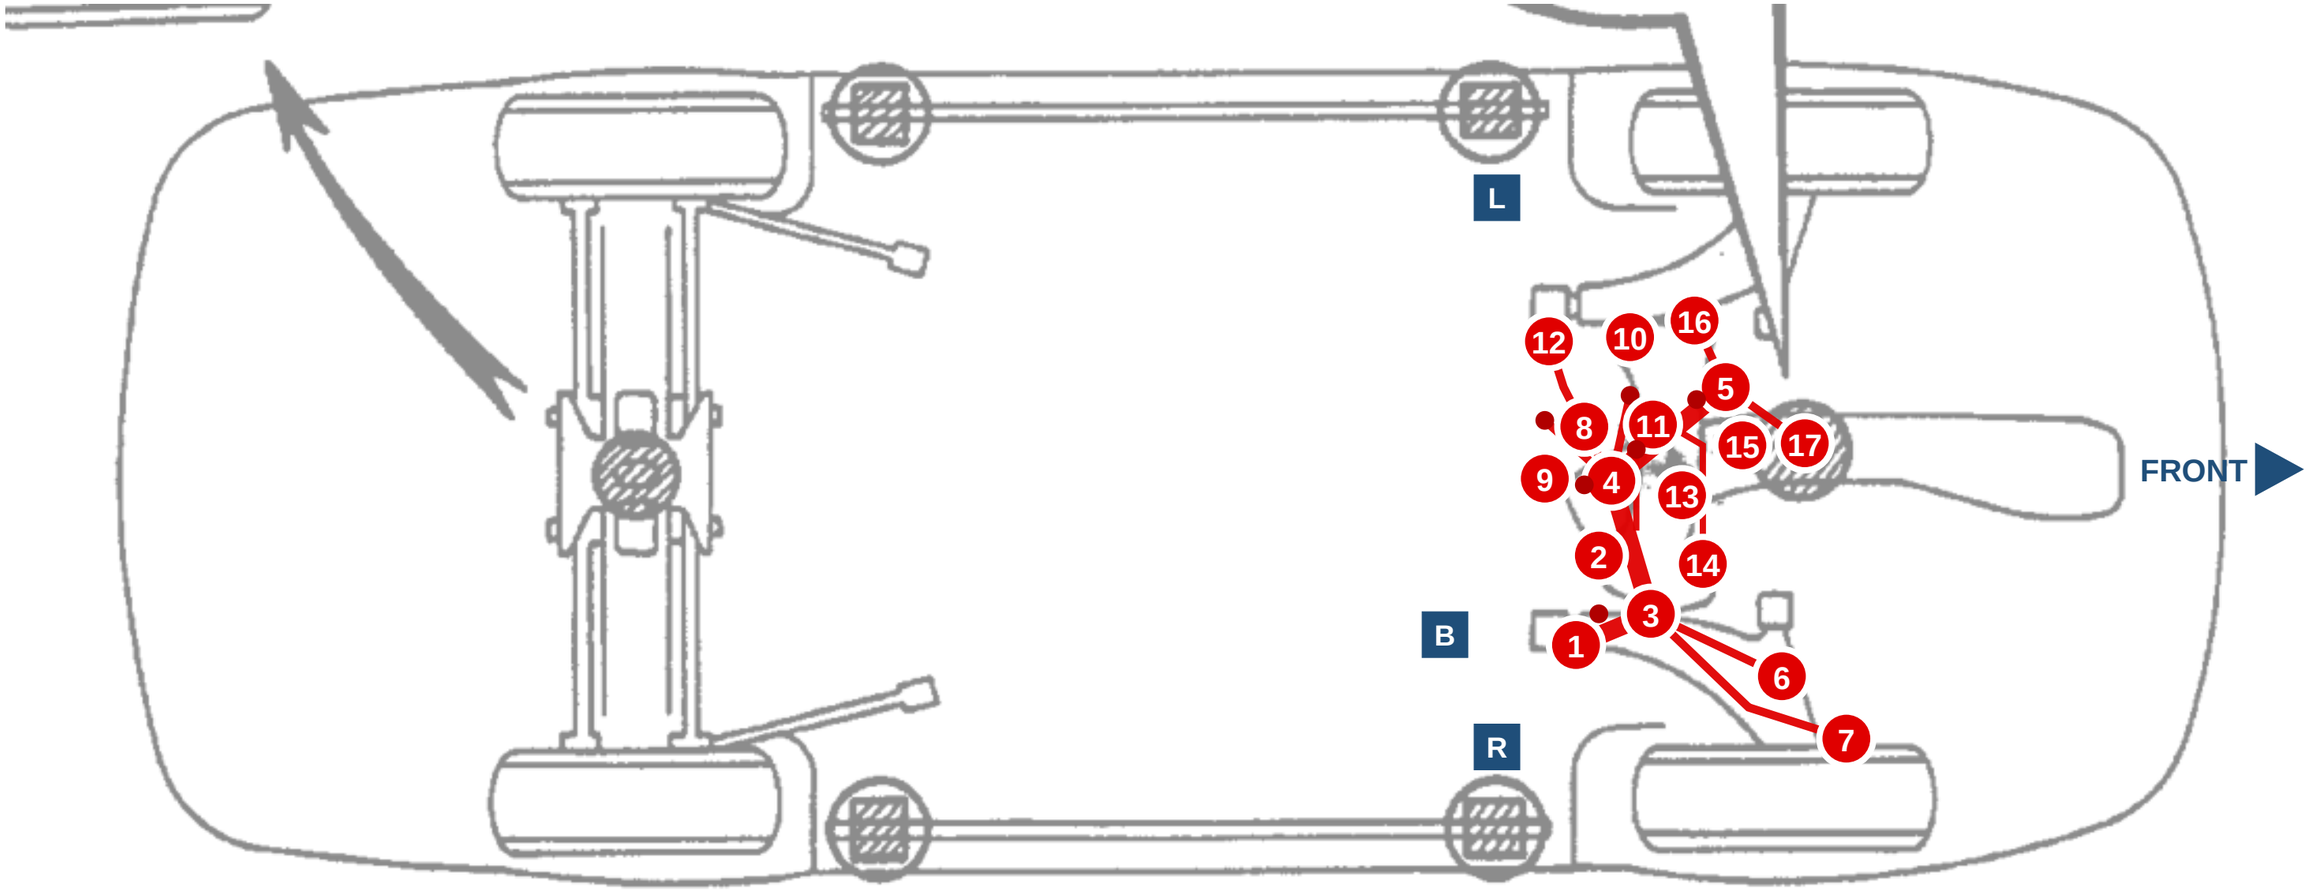

PASSENGER (RH) SIDE

REVISIONS			
REV	**DATE**	**BY**	**DESCRIPTION**
C	2026-10-26	DG	A15 lock-sensor input takes a modified tacho: Ign 8 through 4.7 k· to pin 9 (N61 workaround).
D	2026-10-26	DG	Car-check answers: if the ignition-switch black-orange wire is at the engine plug, remove it; A/C s...
E	2026-10-26	DG	C11 is hardware starter interlock only; Aux 8 spare. Oil LED stays on CSB3 L4.
F	2026-10-26	DG	Each grouped section is its own page. A schematic page holds six wires, each in its own line colo...


ST185-harness - every wiring harness of the car, one drawing set

Layout - ST185-AB-engine - ROUTE-3-A-ENGINE

DRAWING NO.	REV	SHEET	SIZE	DRAWN	DATE
ST185-harness-LAY	F	6 OF 65	432 x 279 mm	DG	2026-10-26

LAYOUT - ST185-AB-engine - ROUTE 3 A ENGINE, as approved (3 of 10)

Detail A · Bulkhead A, IX_B_RAIL and the FP1 branch (crank, MR-S pump speed). Zoomed from the same TIS 1993 EWD p.29 drawing (sheet 2); firewall at top, driver side on the right. Numbers match the main key.

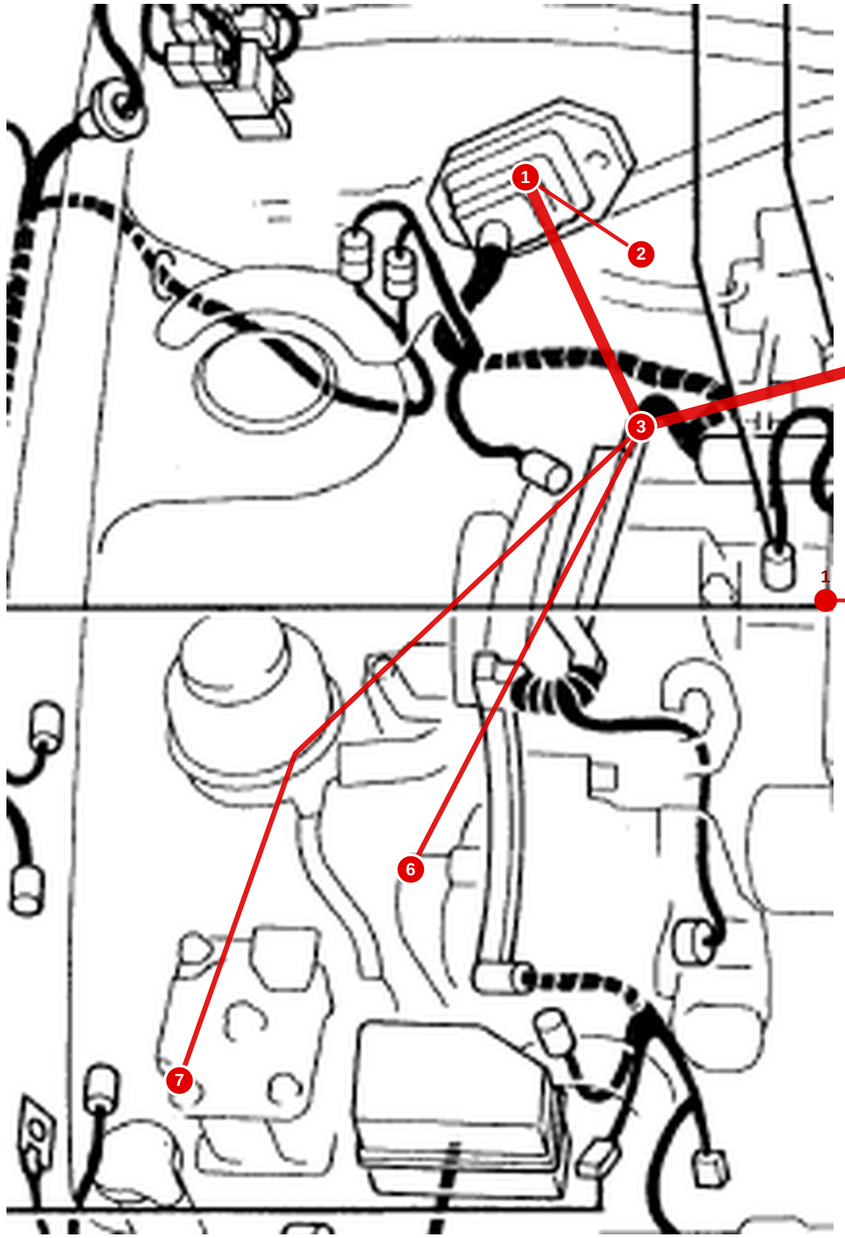

REVISIONS

REV	DATE	BY	DESCRIPTION
C	2026-10-26	DG	A15 lock-sensor input takes a modified tacho: Ign 8 through 4.7 k· to pin 9 (N61 workaround).
D	2026-10-26	DG	Car-check answers: if the ignition-switch black-orange wire is at the engine plug, remove it; A/C s...
E	2026-10-26	DG	C11 is hardware starter interlock only; Aux 8 spare. Oil LED stays on CSB3 L4.
F	2026-10-26	DG	Each grouped section is its own page. A schematic page holds six wires, each in its own line colo...

ST185-harness - every wiring harness of the car, one drawing set


Layout - ST185-AB-engine - ROUTE-3-A-ENGINE

DRAWING NO.	REV	SHEET	SIZE	DRAWN	DATE
ST185-harness-LAY	F	7 OF 65	432 x 279 mm	DG	2026-10-26

LAYOUT - ST185-AB-engine - ROUTE 3 A ENGINE, as approved (4 of 10)

Top view for Detail A. Top view · same route and colors, projected from the drawing above (approximate). Bright = this view·s part, faded = the rest. Blue squares: B = bulkhead A/B (DRB102), R / L = RH / LH fender pass-throughs. Top view base: 1993 Celica repair manual RM305U1, Introduction, ·Vehicle Lift and Support Locations·, p. IN·24 (st185-celica-repair-manual\manuals\RM305U1 - Introduction - Vehicle Lift and Support Locations.pdf), car...

DRIVER (LH) SIDE

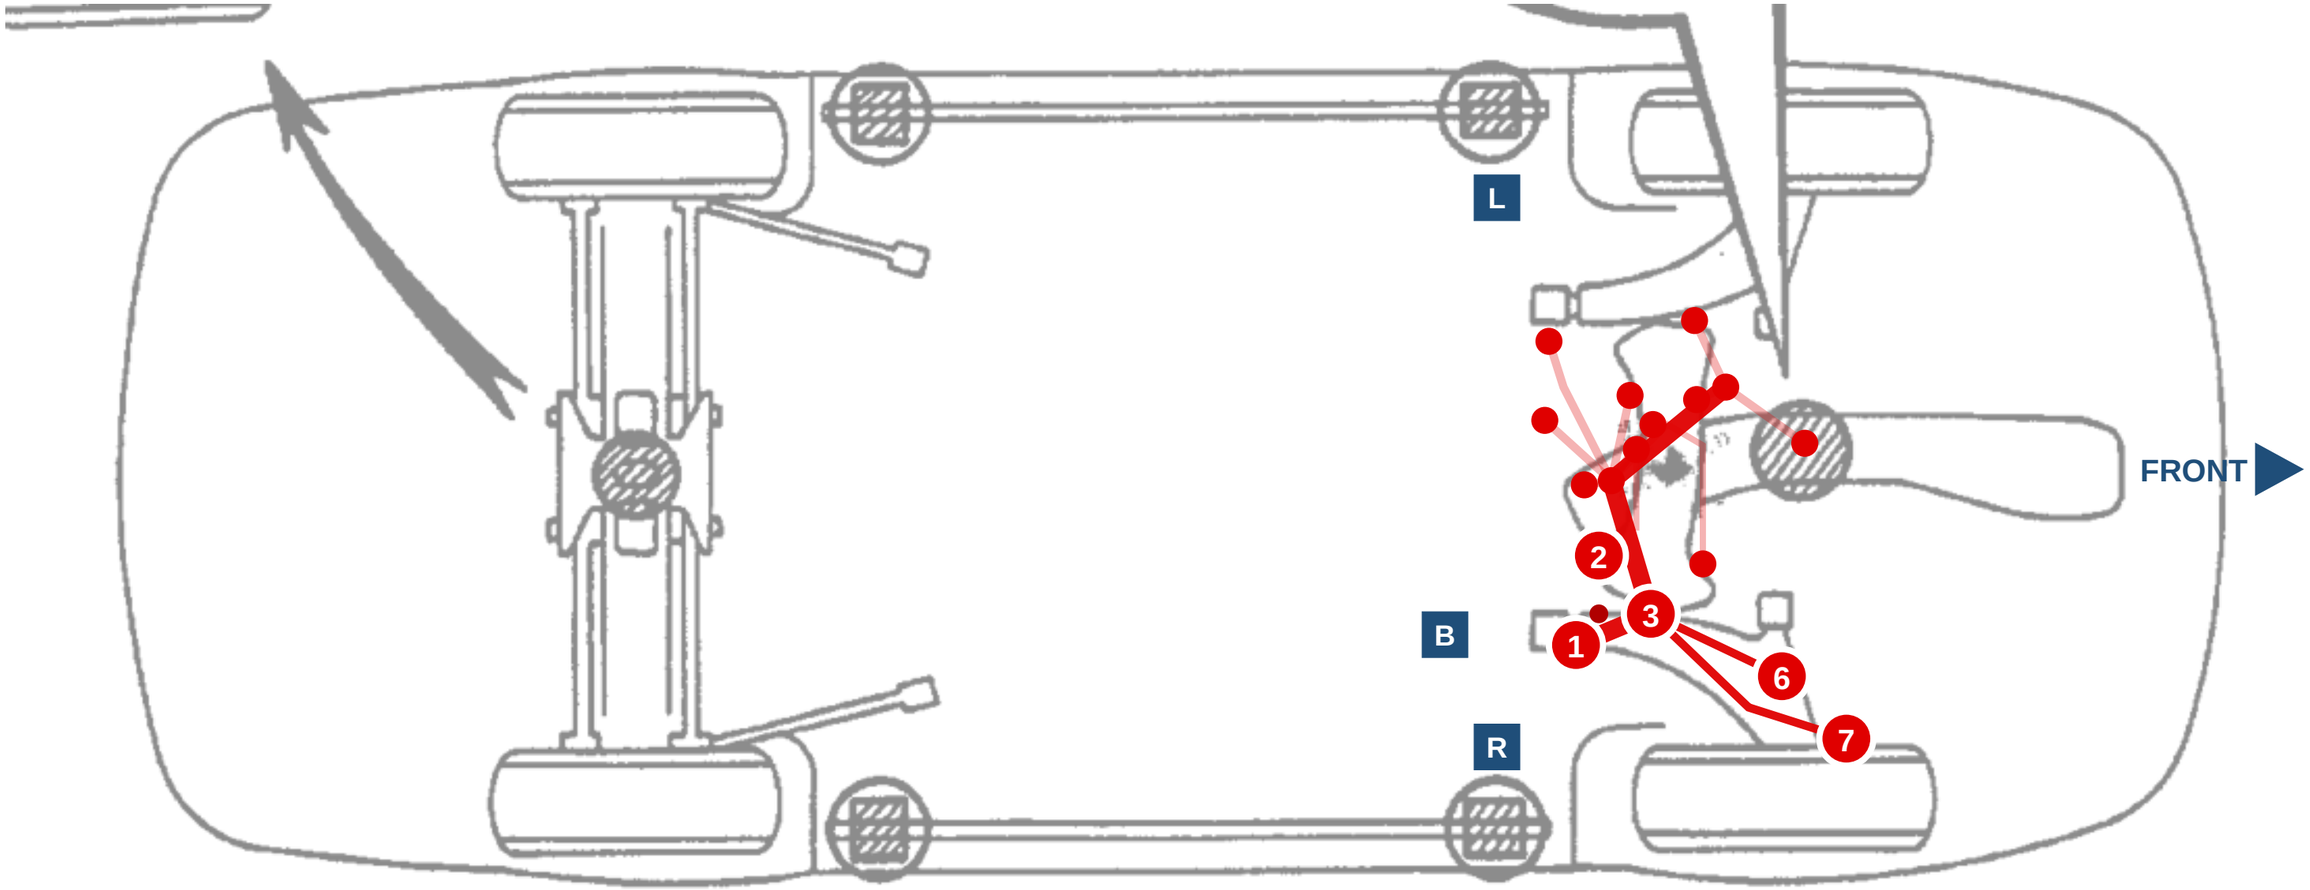

PASSENGER (RH) SIDE

REVISIONS

REV	DATE	BY	DESCRIPTION
C	2026-10-26	DG	A15 lock-sensor input takes a modified tacho: Ign 8 through 4.7 k· to pin 9 (N61 workaround).
D	2026-10-26	DG	Car-check answers: if the ignition-switch black-orange wire is at the engine plug, remove it; A/C s...
E	2026-10-26	DG	C11 is hardware starter interlock only; Aux 8 spare. Oil LED stays on CSB3 L4.
F	2026-10-26	DG	Each grouped section is its own page. A schematic page holds six wires, each in its own line colo...


ST185-harness - every wiring harness of the car, one drawing set

Layout - ST185-AB-engine - ROUTE-3-A-ENGINE

DRAWING NO.	REV	SHEET	SIZE	DRAWN	DATE
ST185-harness-LAY	F	8 OF 65	432 x 279 mm	DG	2026-10-26

LAYOUT - ST185-AB-engine - ROUTE 3 A ENGINE, as approved (5 of 10)

Detail B · Injector row and coil row off FP2. Zoomed from the same TIS 1993 EWD p.29 drawing (sheet 2); firewall at top, driver side on the right. Numbers match the main key.

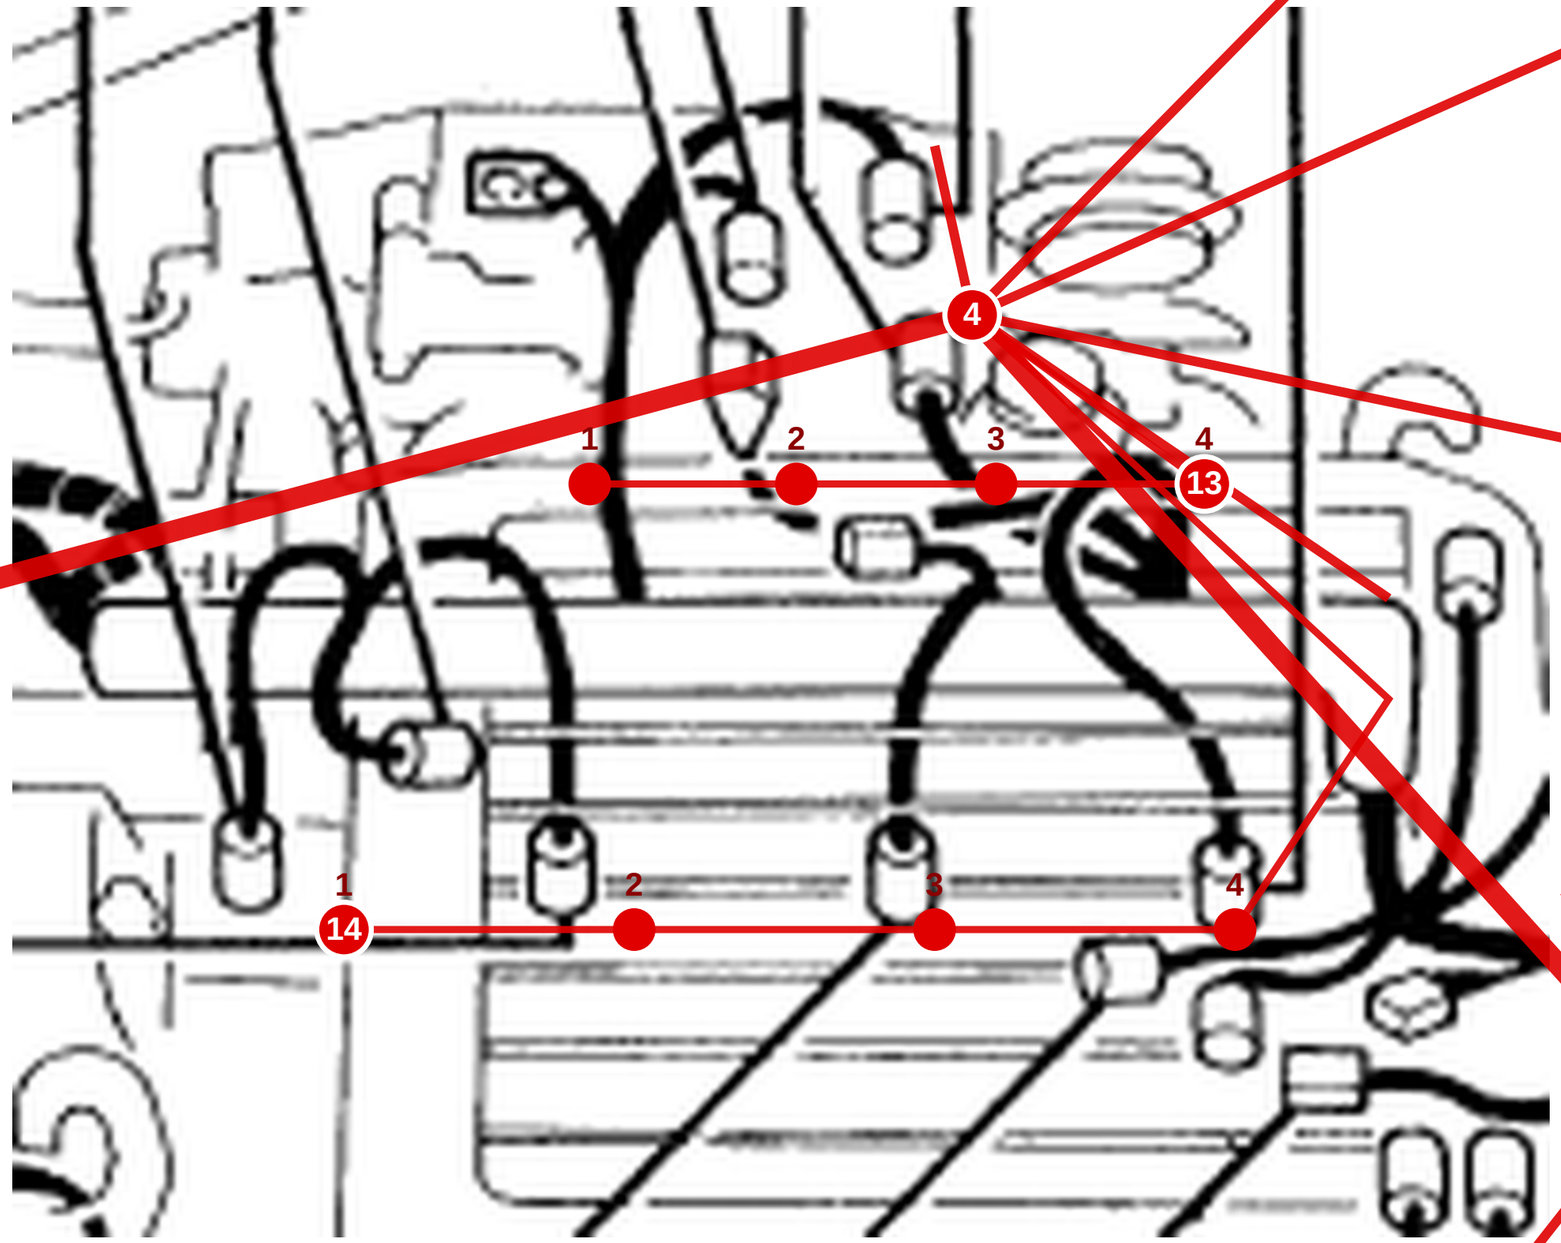

REVISIONS			
REV	DATE	BY	DESCRIPTION
C	2026-10-26	DG	A15 lock-sensor input takes a modified tacho: Ign 8 through 4.7 k· to pin 9 (N61 workaround).
D	2026-10-26	DG	Car-check answers: if the ignition-switch black-orange wire is at the engine plug, remove it; A/C s...
E	2026-10-26	DG	C11 is hardware starter interlock only; Aux 8 spare. Oil LED stays on CSB3 L4.
F	2026-10-26	DG	Each grouped section is its own page. A schematic page holds six wires, each in its own line colo...

ST185-harness - every wiring harness of the car, one drawing set

Layout - ST185-AB-engine - ROUTE-3-A-ENGINE


DRAWING NO.	REV	SHEET	SIZE	DRAWN	DATE
ST185-harness-LAY	F	9 OF 65	432 x 279 mm	DG	2026-10-26

ST185 Celica (wiring-relation) - generated by docs/harness/tools/build_drawings.py from docs/harness/MASTER-wirelist.csv; not to scale

LAYOUT - ST185-AB-engine - ROUTE 3 A ENGINE, as approved (6 of 10)

Top view for Detail B. Top view · same route and colors, projected from the drawing above (approximate). Bright = this view·s part, faded = the rest. Blue squares: B = bulkhead A/B (DRB102), R / L = RH / LH fender pass-throughs. Top view base: 1993 Celica repair manual RM305U1, Introduction, ·Vehicle Lift and Support Locations·, p. IN·24 (st185-celica-repair-manual\manuals\RM305U1 - Introduction - Vehicle Lift and Support Locations.pdf), car...

DRIVER (LH) SIDE

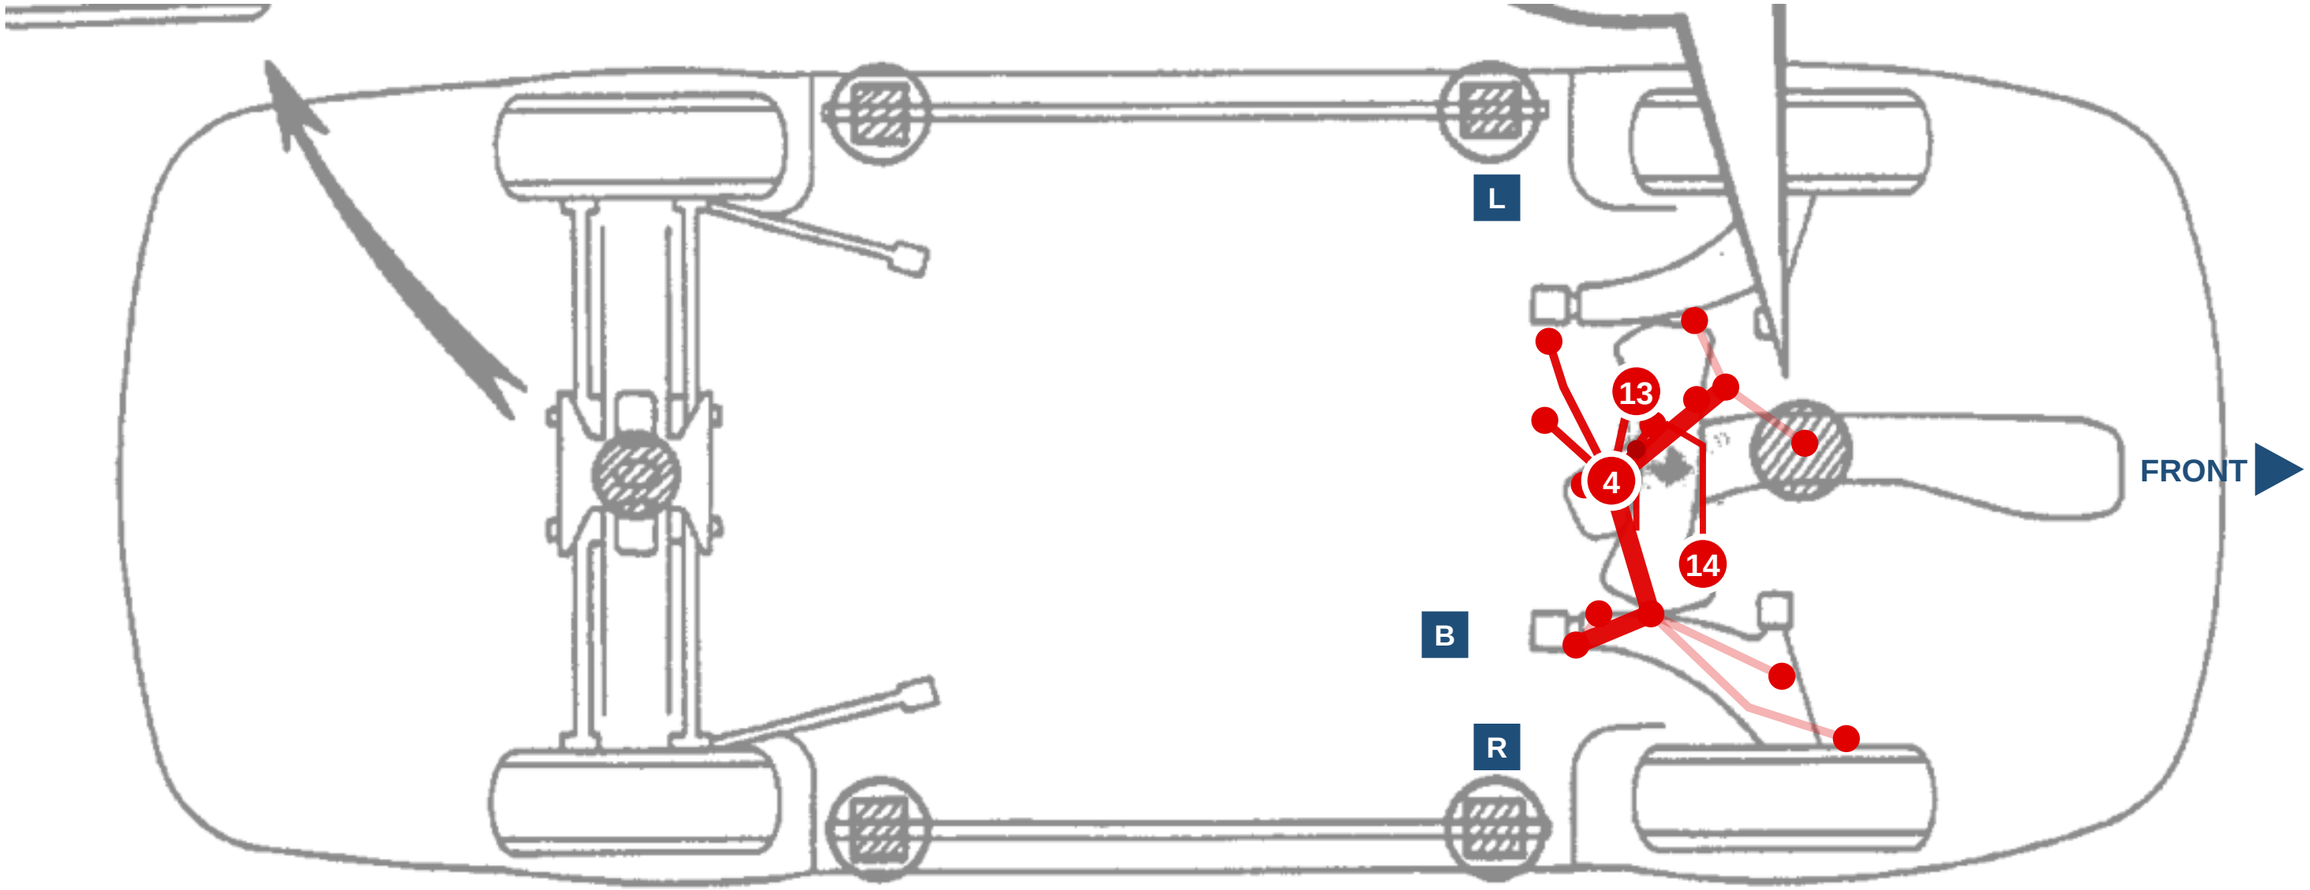

PASSENGER (RH) SIDE

REVISIONS

REV	DATE	BY	DESCRIPTION
C	2026-10-26	DG	A15 lock-sensor input takes a modified tacho: Ign 8 through 4.7 k· to pin 9 (N61 workaround).
D	2026-10-26	DG	Car-check answers: if the ignition-switch black-orange wire is at the engine plug, remove it; A/C s...
E	2026-10-26	DG	C11 is hardware starter interlock only; Aux 8 spare. Oil LED stays on CSB3 L4.
F	2026-10-26	DG	Each grouped section is its own page. A schematic page holds six wires, each in its own line colo...

ST185-harness - every wiring harness of the car, one drawing set


Layout - ST185-AB-engine - ROUTE-3-A-ENGINE

DRAWING NO.	REV	SHEET	SIZE	DRAWN	DATE
ST185-harness-LAY	F	10 OF 65	432 x 279 mm	DG	2026-10-26

ST185 Celica (living-relation) - generated by docs/harness/tools/build_drawings.py from docs/harness/MASTER-wirelist.csv; not to scale

LAYOUT - ST185-AB-engine - ROUTE 3 A ENGINE, as approved (7 of 10)

Detail C · FP2 sensor group (IAT, MAP, ETB, cam, flex). Zoomed from the same TIS 1993 EWD p.29 drawing (sheet 2); firewall at top, driver side on the right. Numbers match the main key.

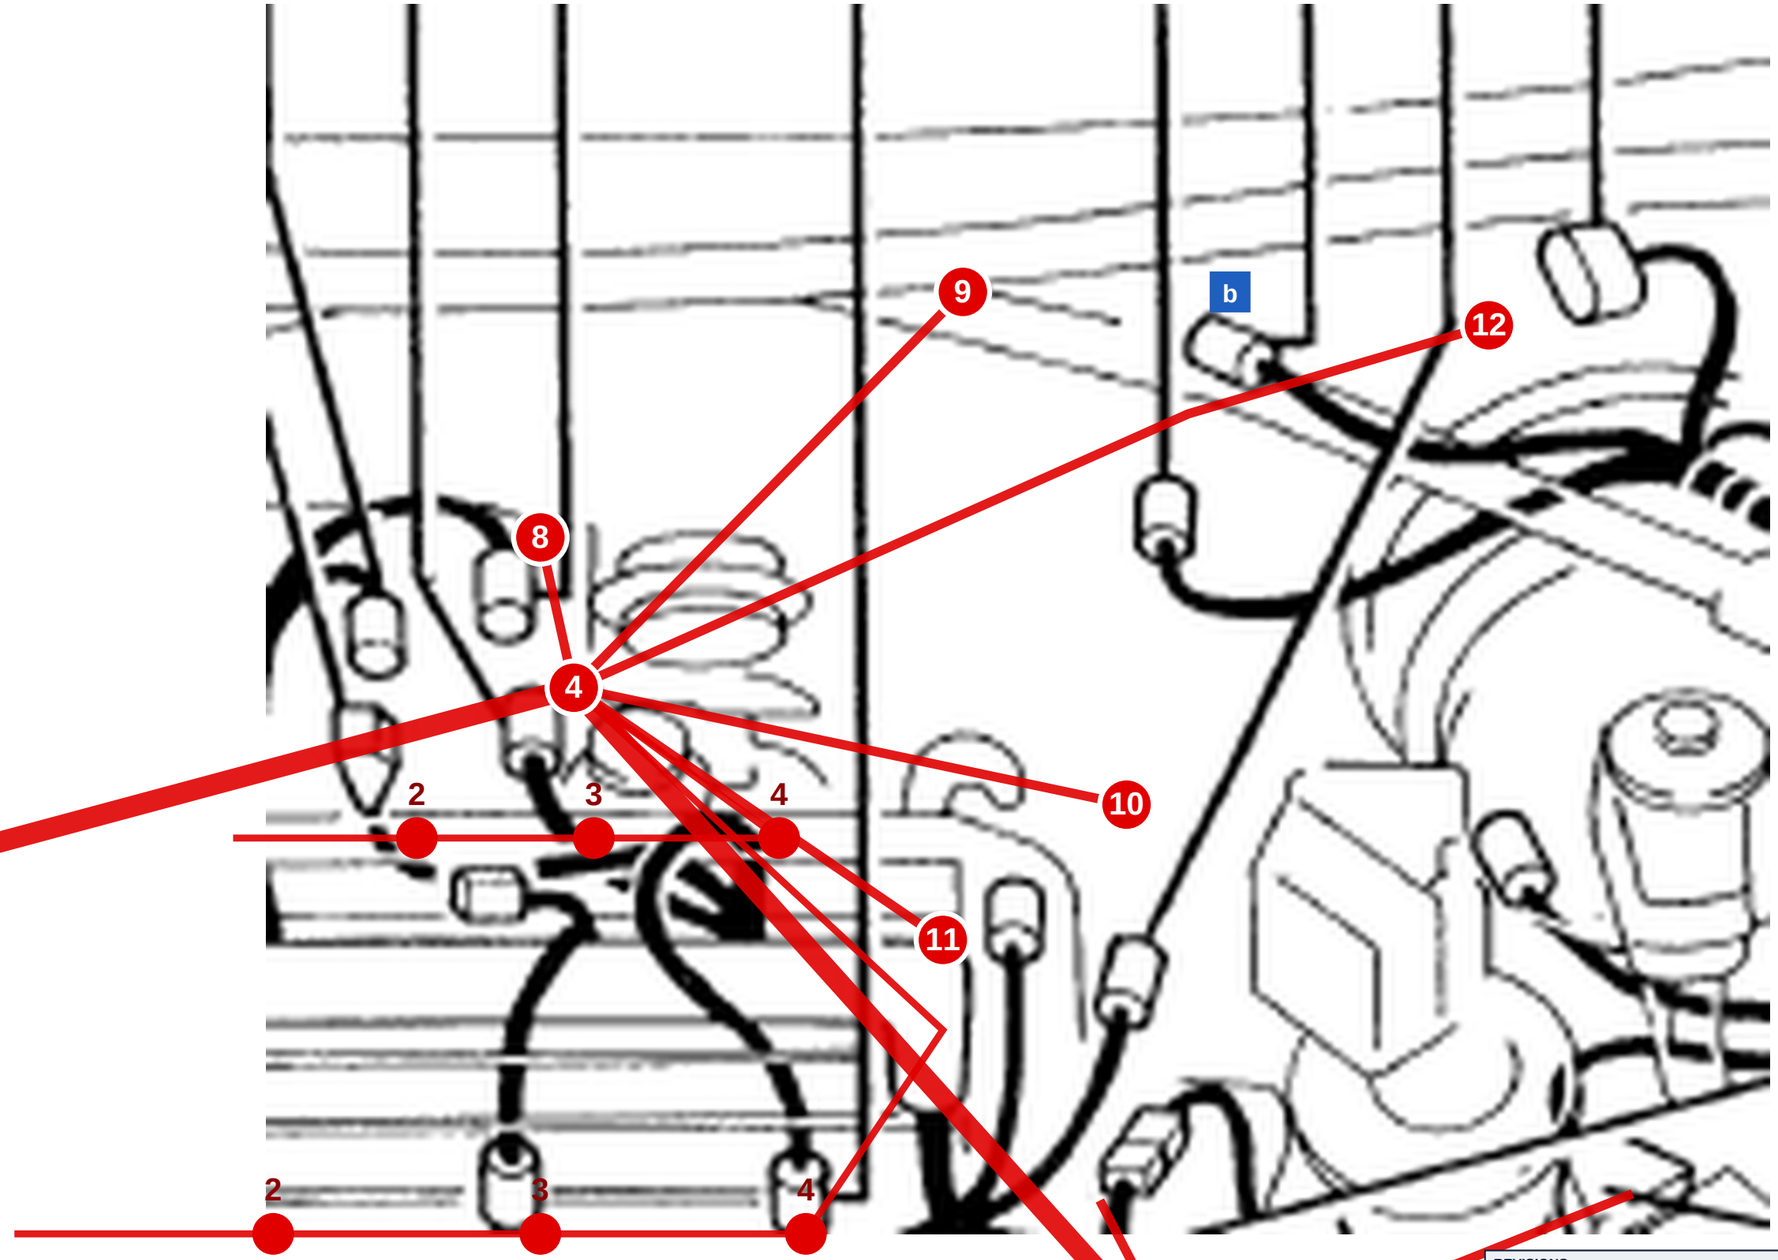

REVISIONS

REV	DATE	BY	DESCRIPTION
C	2026-10-26	DG	A15 lock-sensor input takes a modified tacho: Ign 8 through 4.7 k· to pin 9 (N61 workaround).
D	2026-10-26	DG	Car-check answers: if the ignition-switch black-orange wire is at the engine plug, remove it; A/C s...
E	2026-10-26	DG	C11 is hardware starter interlock only; Aux 8 spare. Oil LED stays on CSB3 L4.
F	2026-10-26	DG	Each grouped section is its own page. A schematic page holds six wires, each in its own line colo...

ST185-harness - every wiring harness of the car, one drawing set

Layout - ST185-AB-engine - ROUTE-3-A-ENGINE


DRAWING NO.	REV	SHEET	SIZE	DRAWN	DATE
ST185-harness-LAY	F	11 OF 65	432 x 279 mm	DG	2026-10-26

ST185 Celica (living-relation) - generated by docs/harness/tools/build_drawings.py from docs/harness/MASTER-wirelist.csv; not to scale

LAYOUT - ST185-AB-engine - ROUTE 3 A ENGINE, as approved (8 of 10)

Top view for Detail C. Top view · same route and colors, projected from the drawing above (approximate). Bright = this view·s part, faded = the rest. Blue squares: B = bulkhead A/B (DRB102), R / L = RH / LH fender pass-throughs. Top view base: 1993 Celica repair manual RM305U1, Introduction, ·Vehicle Lift and Support Locations·, p. IN·24 (st185-celica-repair-manual\manuals\RM305U1 - Introduction - Vehicle Lift and Support Locations.pdf), car...

DRIVER (LH) SIDE

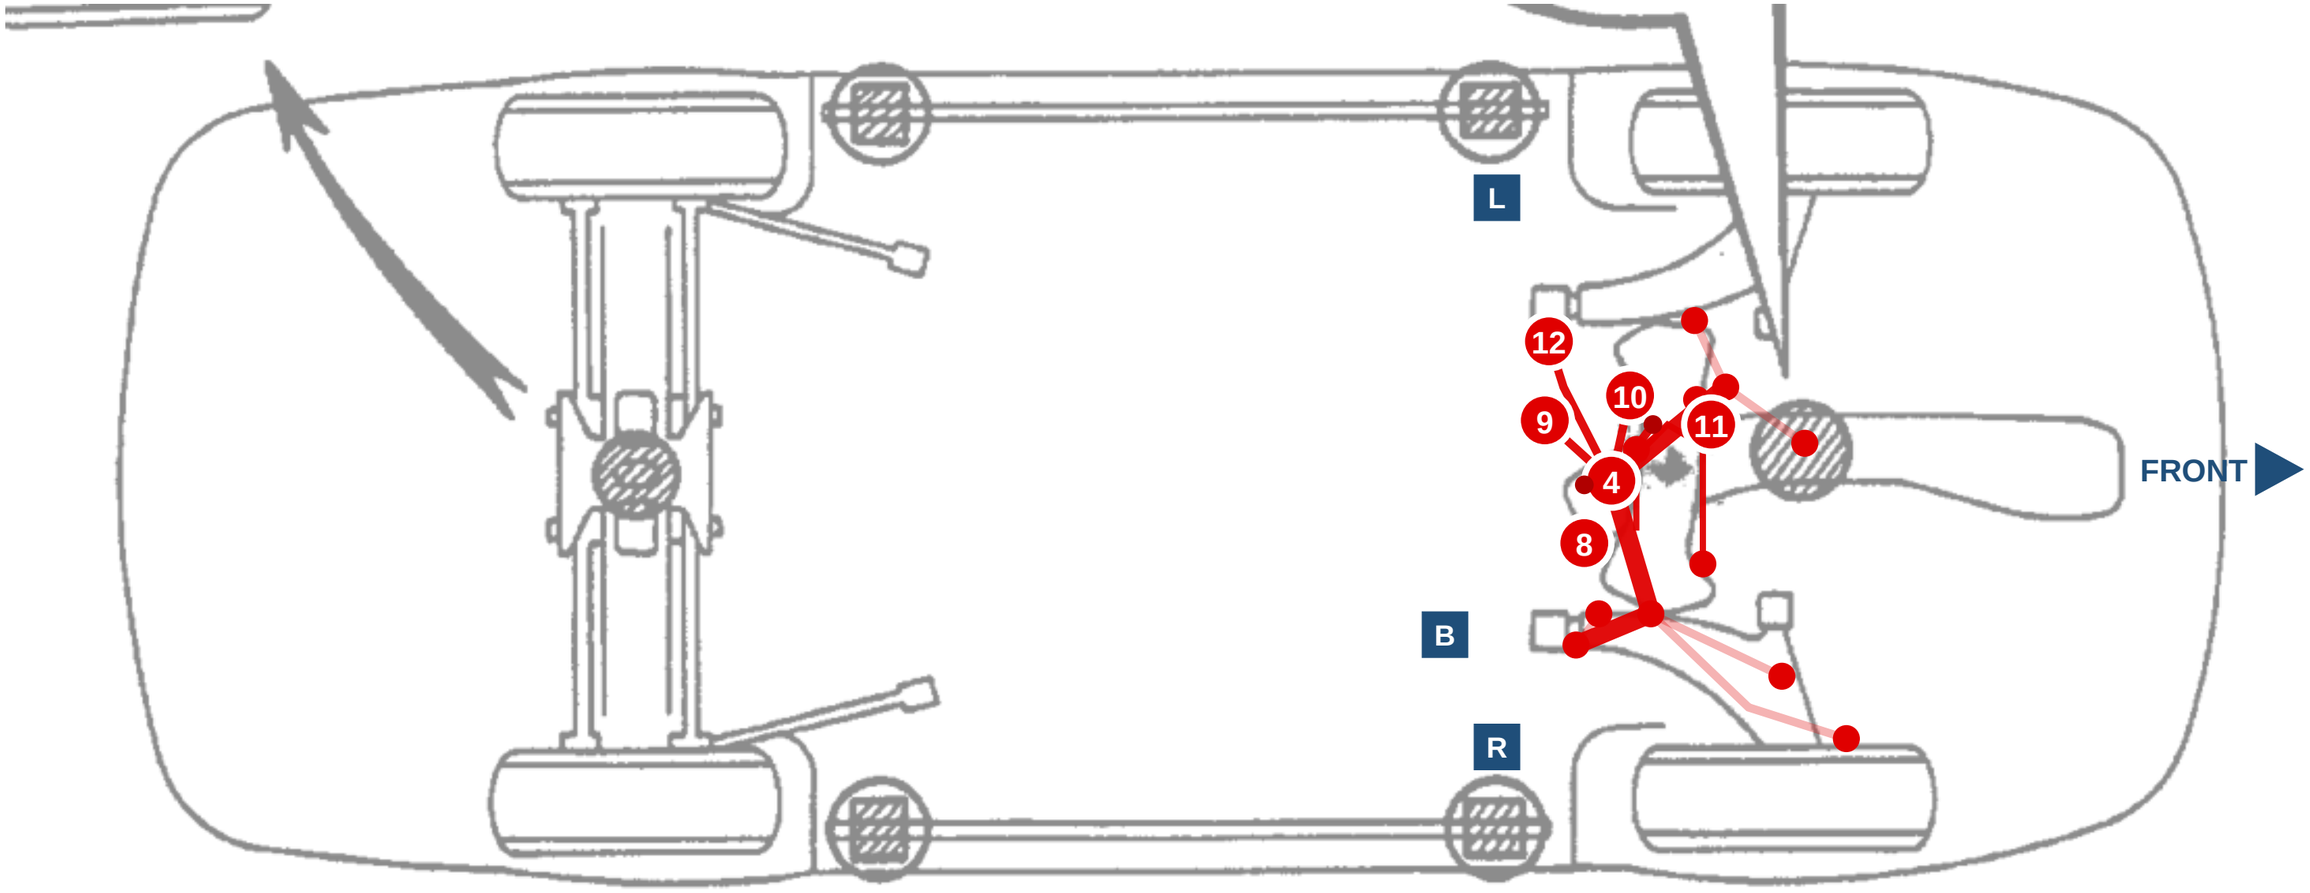

PASSENGER (RH) SIDE

REVISIONS

REV	DATE	BY	DESCRIPTION
C	2026-10-26	DG	A15 lock-sensor input takes a modified tacho: Ign 8 through 4.7 k· to pin 9 (N61 workaround).
D	2026-10-26	DG	Car-check answers: if the ignition-switch black-orange wire is at the engine plug, remove it; A/C s...
E	2026-10-26	DG	C11 is hardware starter interlock only; Aux 8 spare. Oil LED stays on CSB3 L4.
F	2026-10-26	DG	Each grouped section is its own page. A schematic page holds six wires, each in its own line colo...


ST185-harness - every wiring harness of the car, one drawing set

Layout - ST185-AB-engine - ROUTE-3-A-ENGINE

DRAWING NO.	REV	SHEET	SIZE	DRAWN	DATE
ST185-harness-LAY	F	12 OF 65	432 x 279 mm	DG	2026-10-26

LAYOUT - ST185-AB-engine - ROUTE 3 A ENGINE, as approved (9 of 10)

Detail D · FP3 group (ECT, boost solenoid, turbo speed). Zoomed from the same TIS 1993 EWD p.29 drawing (sheet 2); firewall at the drivers side on the right. Numbers match the main key.

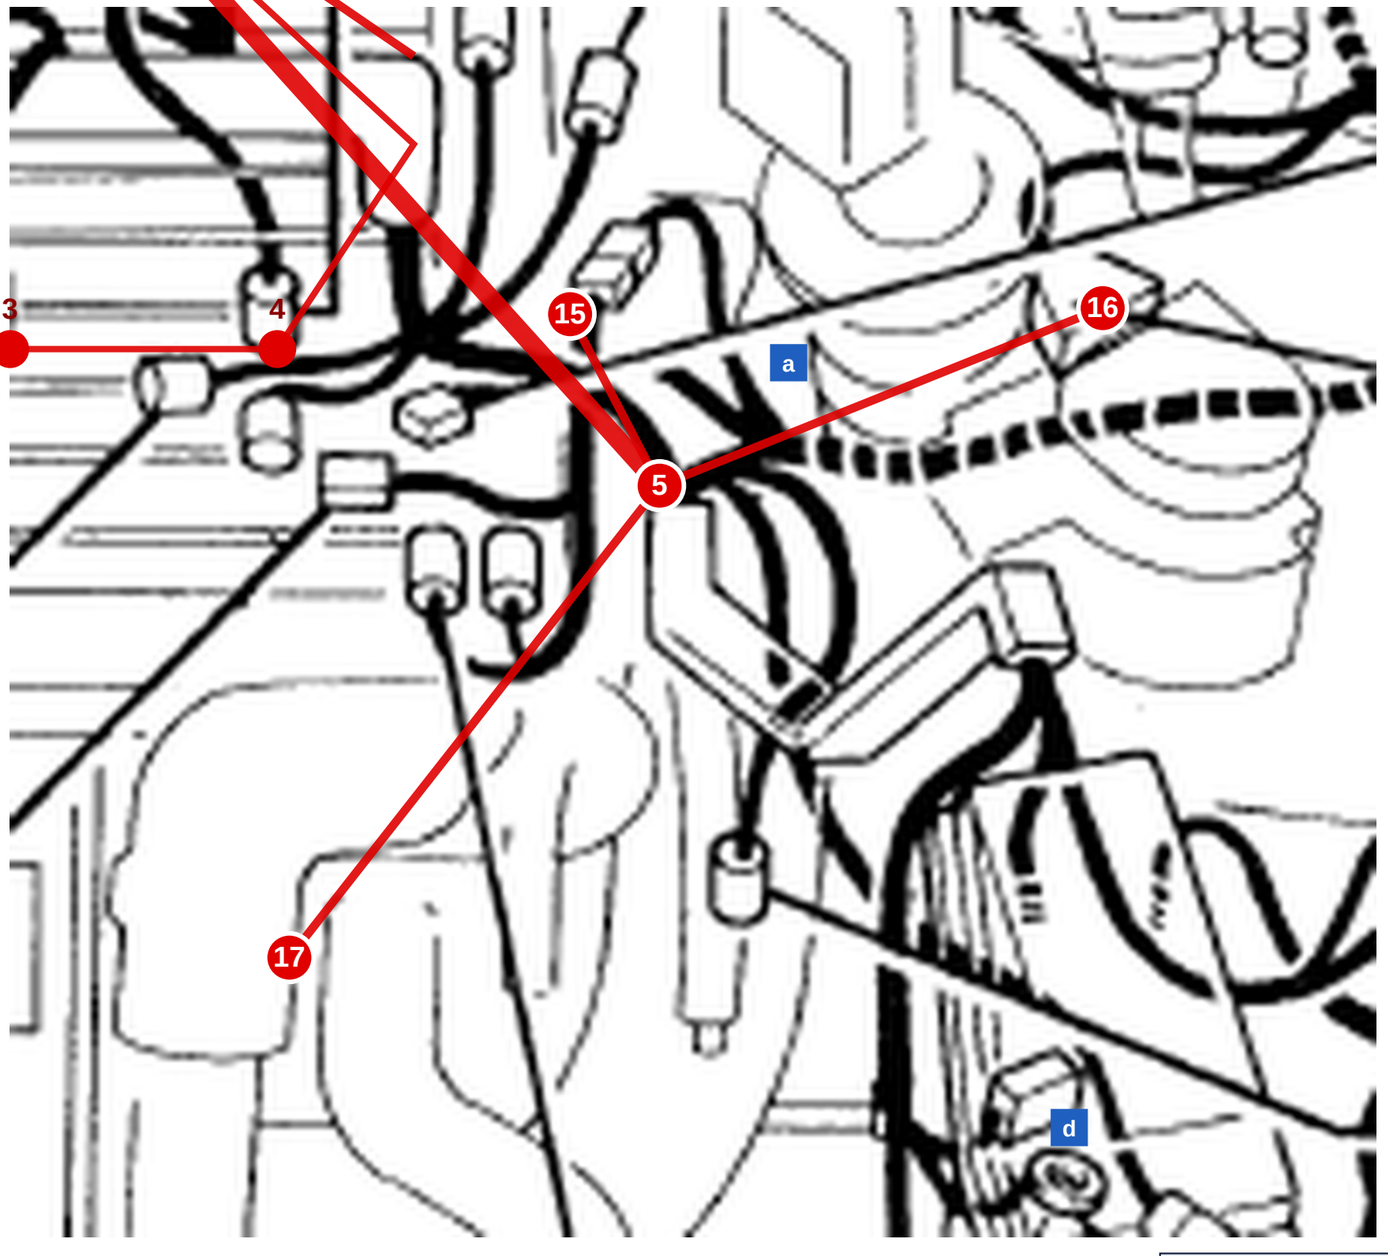

REVISIONS			
REV	DATE	BY	DESCRIPTION
C	2026-10-26	DG	A15 lock-sensor input takes a modified tacho: Ign 8 through 4.7 k· to pin 9 (N61 workaround).
D	2026-10-26	DG	Car-check answers: if the ignition-switch black-orange wire is at the engine plug, remove it; A/C s...
E	2026-10-26	DG	C11 is hardware starter interlock only; Aux 8 spare. Oil LED stays on CSB3 L4.
F	2026-10-26	DG	Each grouped section is its own page. A schematic page holds six wires, each in its own line colo...

ST185-harness - every wiring harness of the car, one drawing set


Layout - ST185-AB-engine - ROUTE-3-A-ENGINE

DRAWING NO.	REV	SHEET	SIZE	DRAWN	DATE
ST185-harness-LAY	F	13 OF 65	432 x 279 mm	DG	2026-10-26

LAYOUT - ST185-AB-engine - ROUTE 3 A ENGINE, as approved (10 of 10)

Top view for Detail D. Top view · same route and colors, projected from the drawing above (approximate). Bright = this view·s part, faded = the rest. Blue squares: B = bulkhead A/B (DRB102), R / L = RH / LH fender pass-throughs. Top view base: 1993 Celica repair manual RM305U1, Introduction, ·Vehicle Lift and Support Locations·, p. IN·24 (st185-celica-repair-manual\manuals\RM305U1 - Introduction - Vehicle Lift and Support Locations.pdf), car...

DRIVER (LH) SIDE

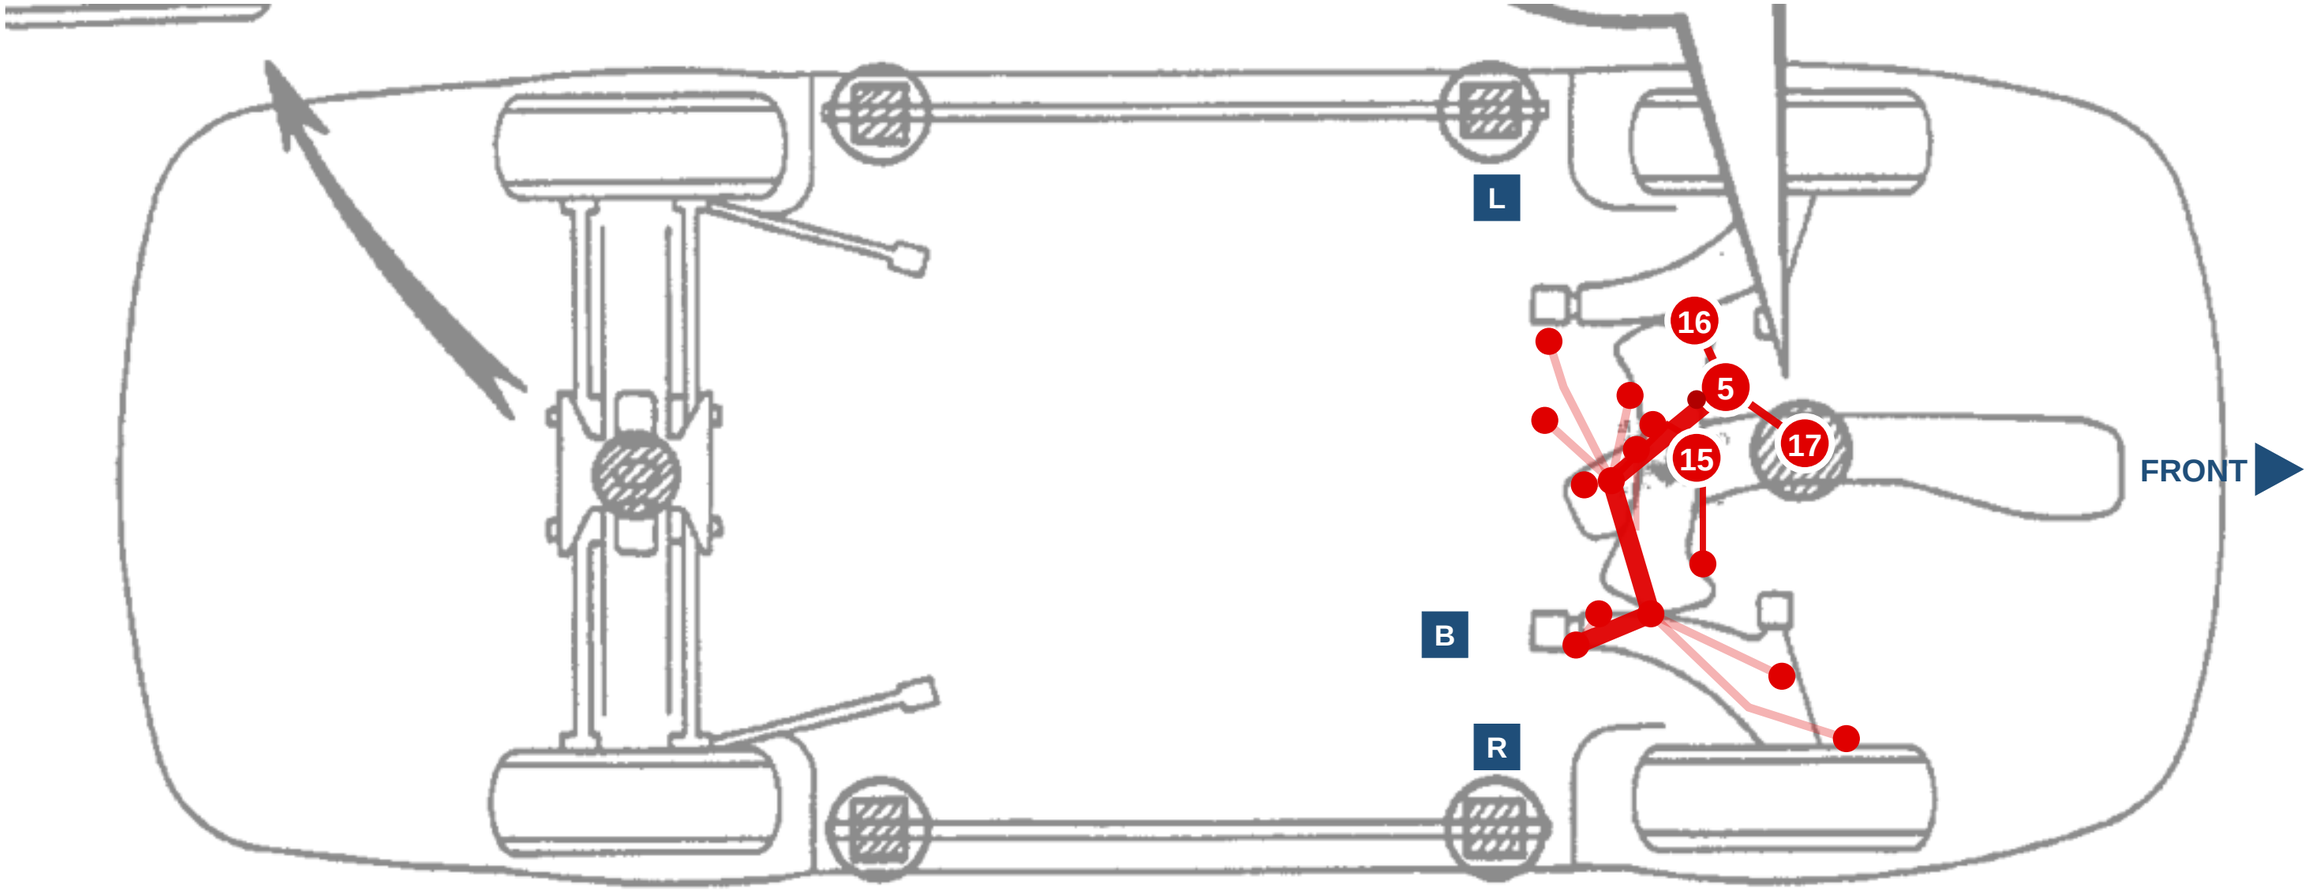

PASSENGER (RH) SIDE

REVISIONS

REV	DATE	BY	DESCRIPTION
C	2026-10-26	DG	A15 lock-sensor input takes a modified tacho: Ign 8 through 4.7 k· to pin 9 (N61 workaround).
D	2026-10-26	DG	Car-check answers: if the ignition-switch black-orange wire is at the engine plug, remove it; A/C s...
E	2026-10-26	DG	C11 is hardware starter interlock only; Aux 8 spare. Oil LED stays on CSB3 L4.
F	2026-10-26	DG	Each grouped section is its own page. A schematic page holds six wires, each in its own line colo...

ST185-harness - every wiring harness of the car, one drawing set


Layout - ST185-AB-engine - ROUTE-3-A-ENGINE

DRAWING NO.	REV	SHEET	SIZE	DRAWN	DATE
ST185-harness-LAY	F	14 OF 65	432 x 279 mm	DG	2026-10-26

ST185 Celica (living-relation) - generated by docs/harness/tools/build_drawings.py from docs/harness/MASTER-wirelist.csv; not to scale

LAYOUT - ST185-AB-engine - ROUTE 4 B ENGINE, as approved (1 of 10)

Fig. 1 · Engine compartment, 3S-GTE, TIS 1993 EWD ·Position of Parts in Engine Compartment· p.29 (tis1993-wiring-routing.pdf, sheet 2). Firewall at top, driver side on the right. Device spots are Dan·s labels from his Route 3 mark-up (oil temp, oil press, fuel press, coolant press · moved to the rear of the block on the driver side per Dan 2026·10·05 · charge-pipe IAT, wideband O2). Knock 1 uses the factory K1 leader on p.29; the gearbox VSS spot

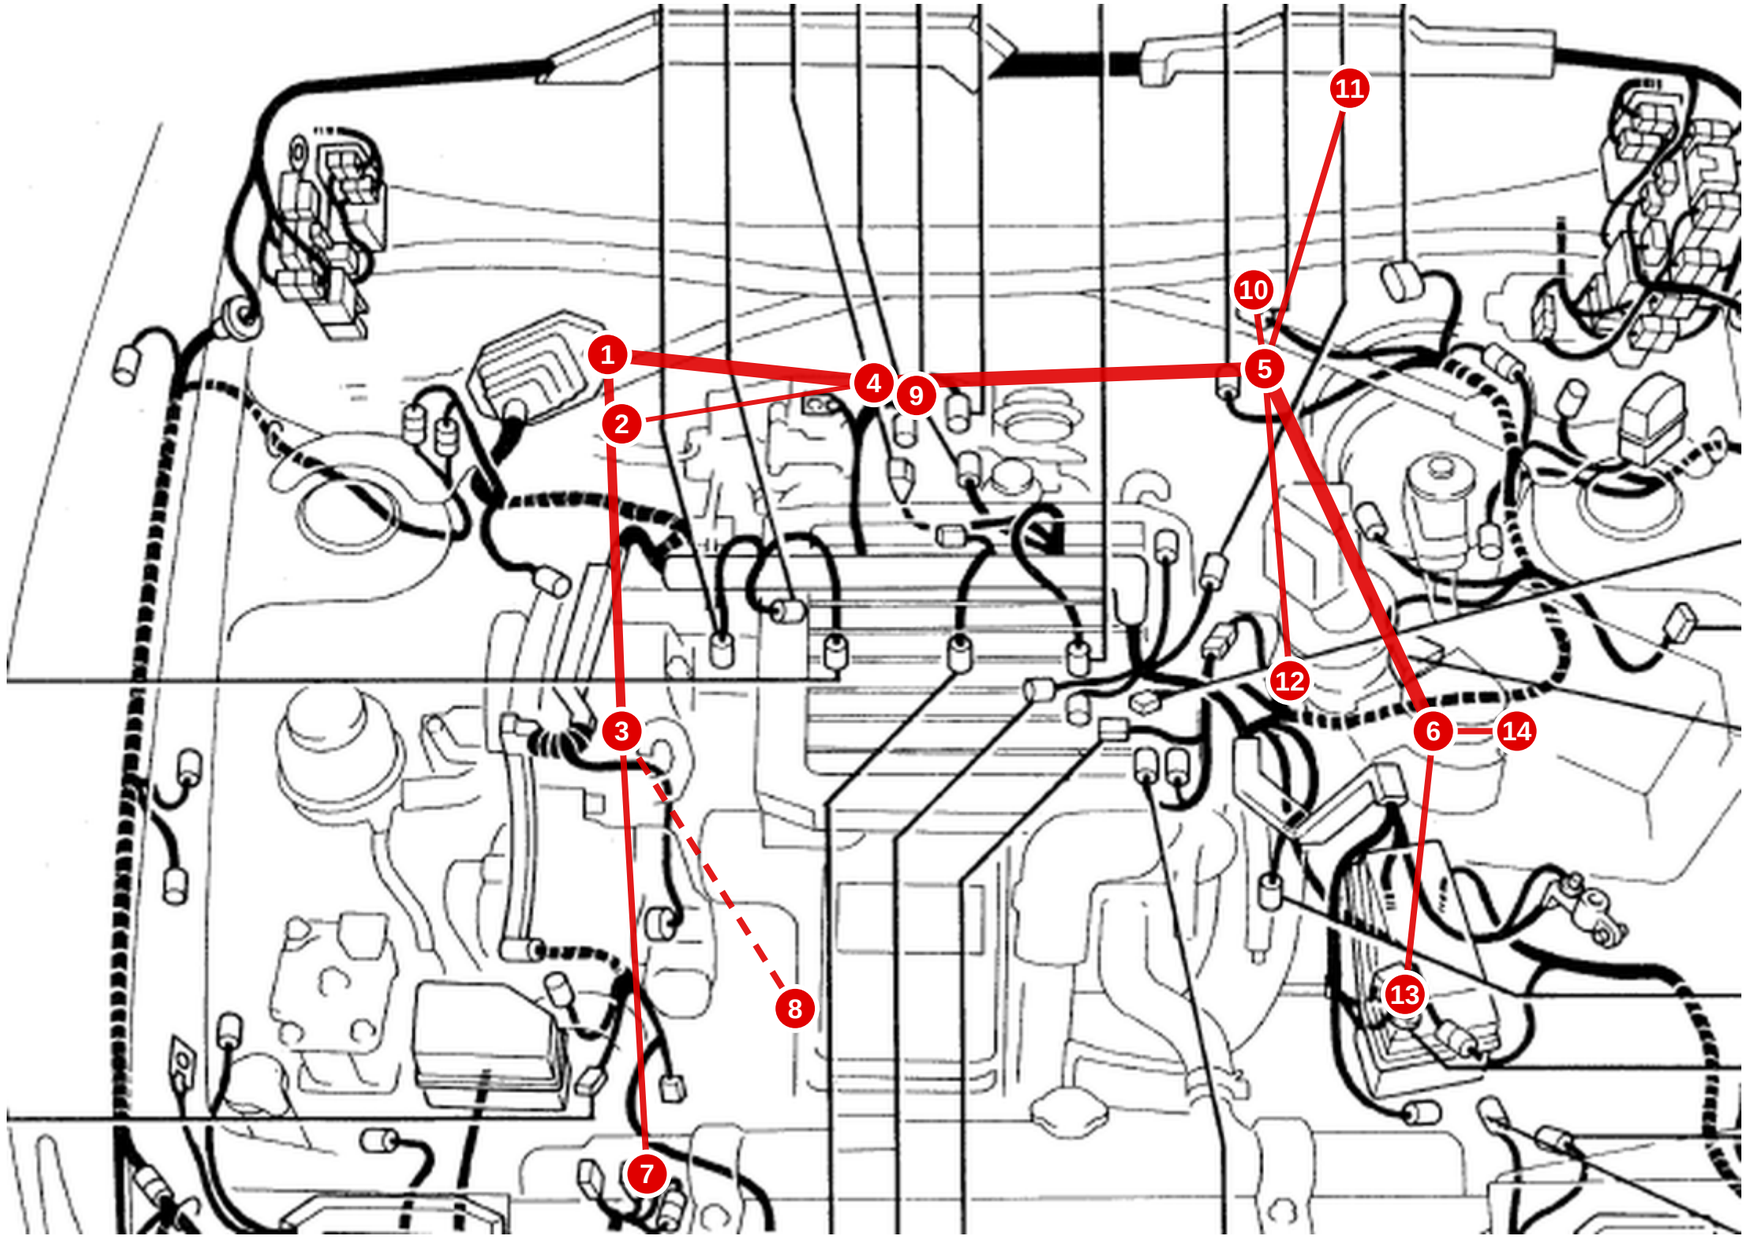

REVISIONS

REV	DATE	BY	DESCRIPTION
C	2026-10-26	DG	A15 lock-sensor input takes a modified tacho: Ign 8 through 4.7 k· to pin 9 (N61 workaround).
D	2026-10-26	DG	Car-check answers: if the ignition-switch black-orange wire is at the engine plug, remove it; A/C s...
E	2026-10-26	DG	C11 is hardware starter interlock only; Aux 8 spare. Oil LED stays on CSB3 L4.
F	2026-10-26	DG	Each grouped section is its own page. A schematic page holds six wires, each in its own line colo...

ST185-harness - every wiring harness of the car, one drawing set

Layout - ST185-AB-engine - ROUTE-4-B-ENGINE


DRAWING NO.	REV	SHEET	SIZE	DRAWN	DATE
ST185-harness-LAY	F	15 OF 65	432 x 279 mm	DG	2026-10-26

ST185 Celica (living-relation) - generated by docs/harness/tools/build_drawings.py from docs/harness/MASTER-wirelist.csv; not to scale

LAYOUT - ST185-AB-engine - ROUTE 4 B ENGINE, as approved (2 of 10)

Top view · same route and colors, projected from the drawing above (approximate). Bright = this view·s part, faded = the rest. Blue squares: B = bulkhead A/B (DRB102), R / L = RH / LH fender pass-throughs. Top view base: 1993 Celica repair manual RM305U1, Introduction, ·Vehicle Lift and Support Locations·, p. IN·24 (st185-celica-repair-manual\manuals\RM305U1 - Introduction - Vehicle Lift and Support Locations.pdf), car outline only, lightene...

DRIVER (LH) SIDE

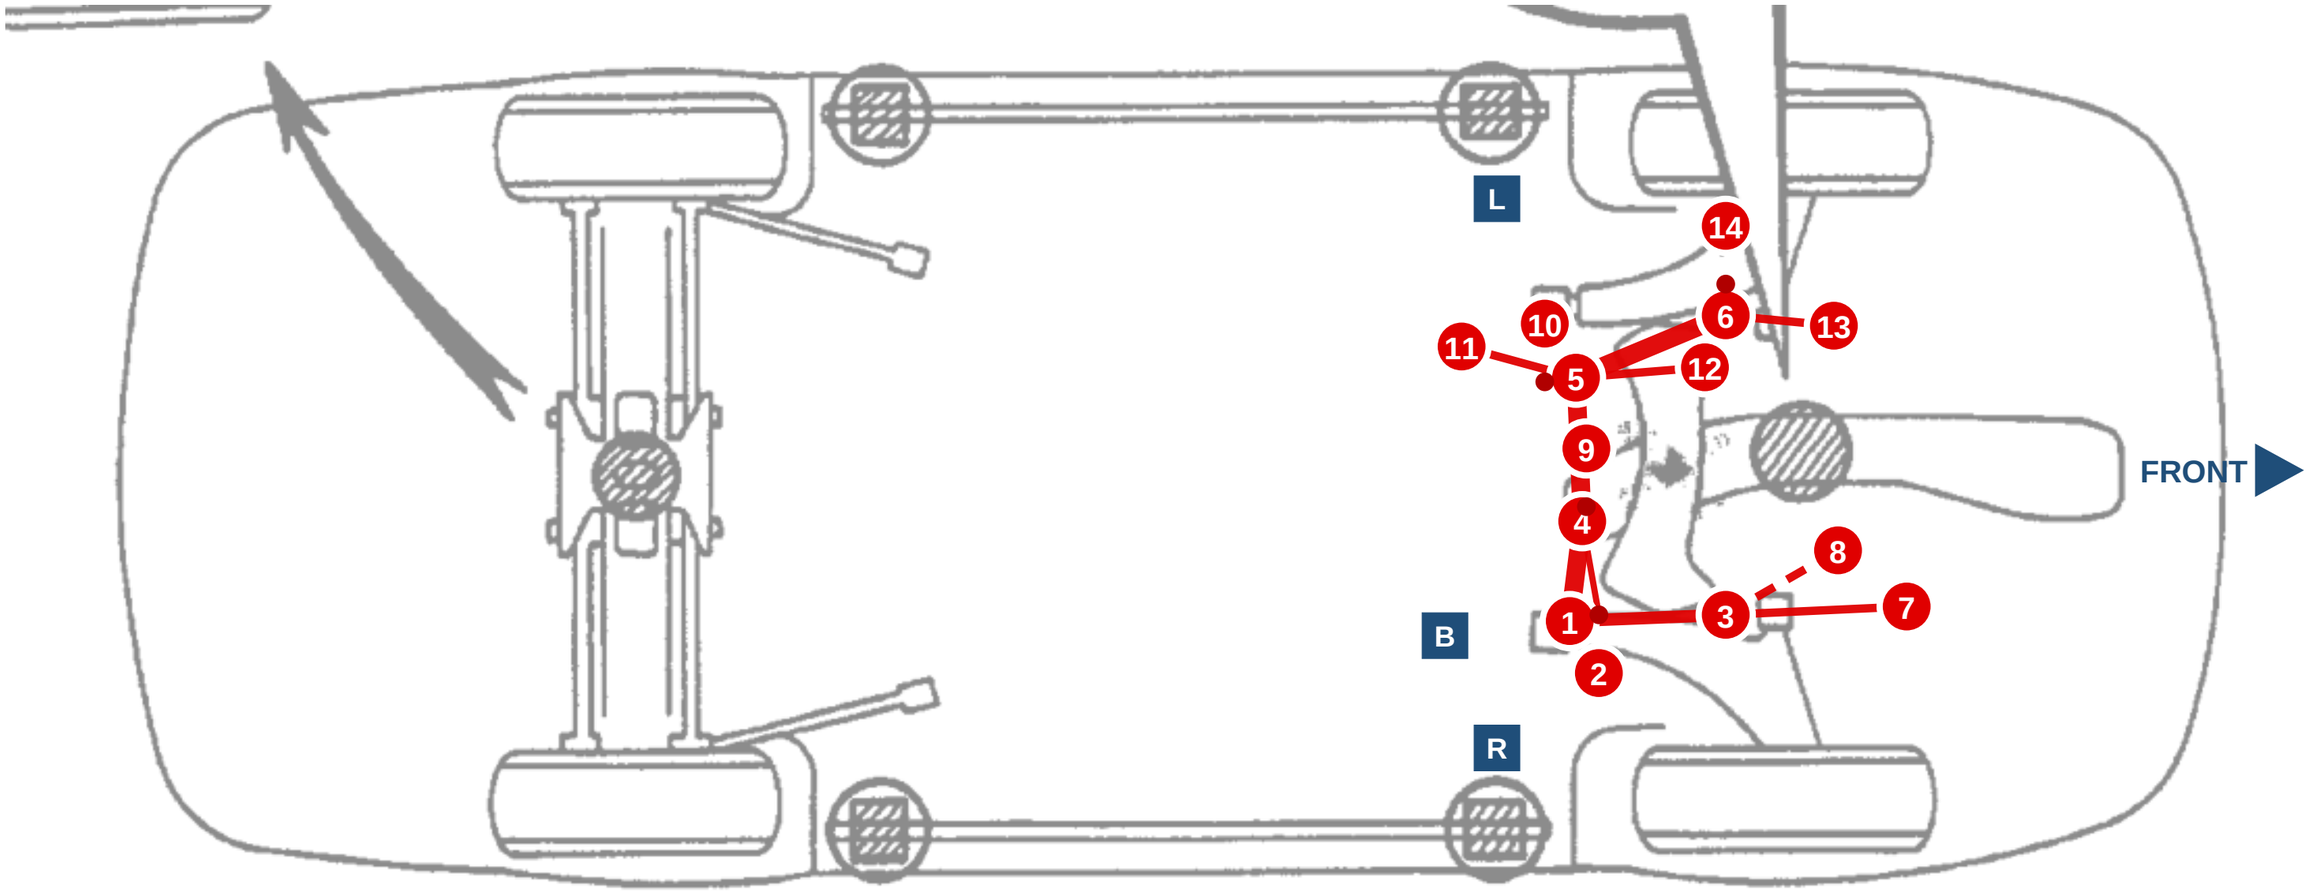

PASSENGER (RH) SIDE

REVISIONS

REV	DATE	BY	DESCRIPTION
C	2026-10-26	DG	A15 lock-sensor input takes a modified tacho: Ign 8 through 4.7 k· to pin 9 (N61 workaround).
D	2026-10-26	DG	Car-check answers: if the ignition-switch black-orange wire is at the engine plug, remove it; A/C s...
E	2026-10-26	DG	C11 is hardware starter interlock only; Aux 8 spare. Oil LED stays on CSB3 L4.
F	2026-10-26	DG	Each grouped section is its own page. A schematic page holds six wires, each in its own line colo...

ST185-harness - every wiring harness of the car, one drawing set


Layout - ST185-AB-engine - ROUTE-4-B-ENGINE

DRAWING NO.	REV	SHEET	SIZE	DRAWN	DATE
ST185-harness-LAY	F	16 OF 65	432 x 279 mm	DG	2026-10-26

ST185 Celica (living-relation) - generated by docs/harness/tools/build_drawings.py from docs/harness/MASTER-wirelist.csv; not to scale

LAYOUT - ST185-AB-engine - ROUTE 4 B ENGINE, as approved (3 of 10)

Detail A · Bulkhead B, IX_B_RAIL and FP1 (knock). Zoomed from the same TIS 1993 EWD p.29 drawing (sheet 2); firewall at top, driver side on the right. Numbers match the main key.

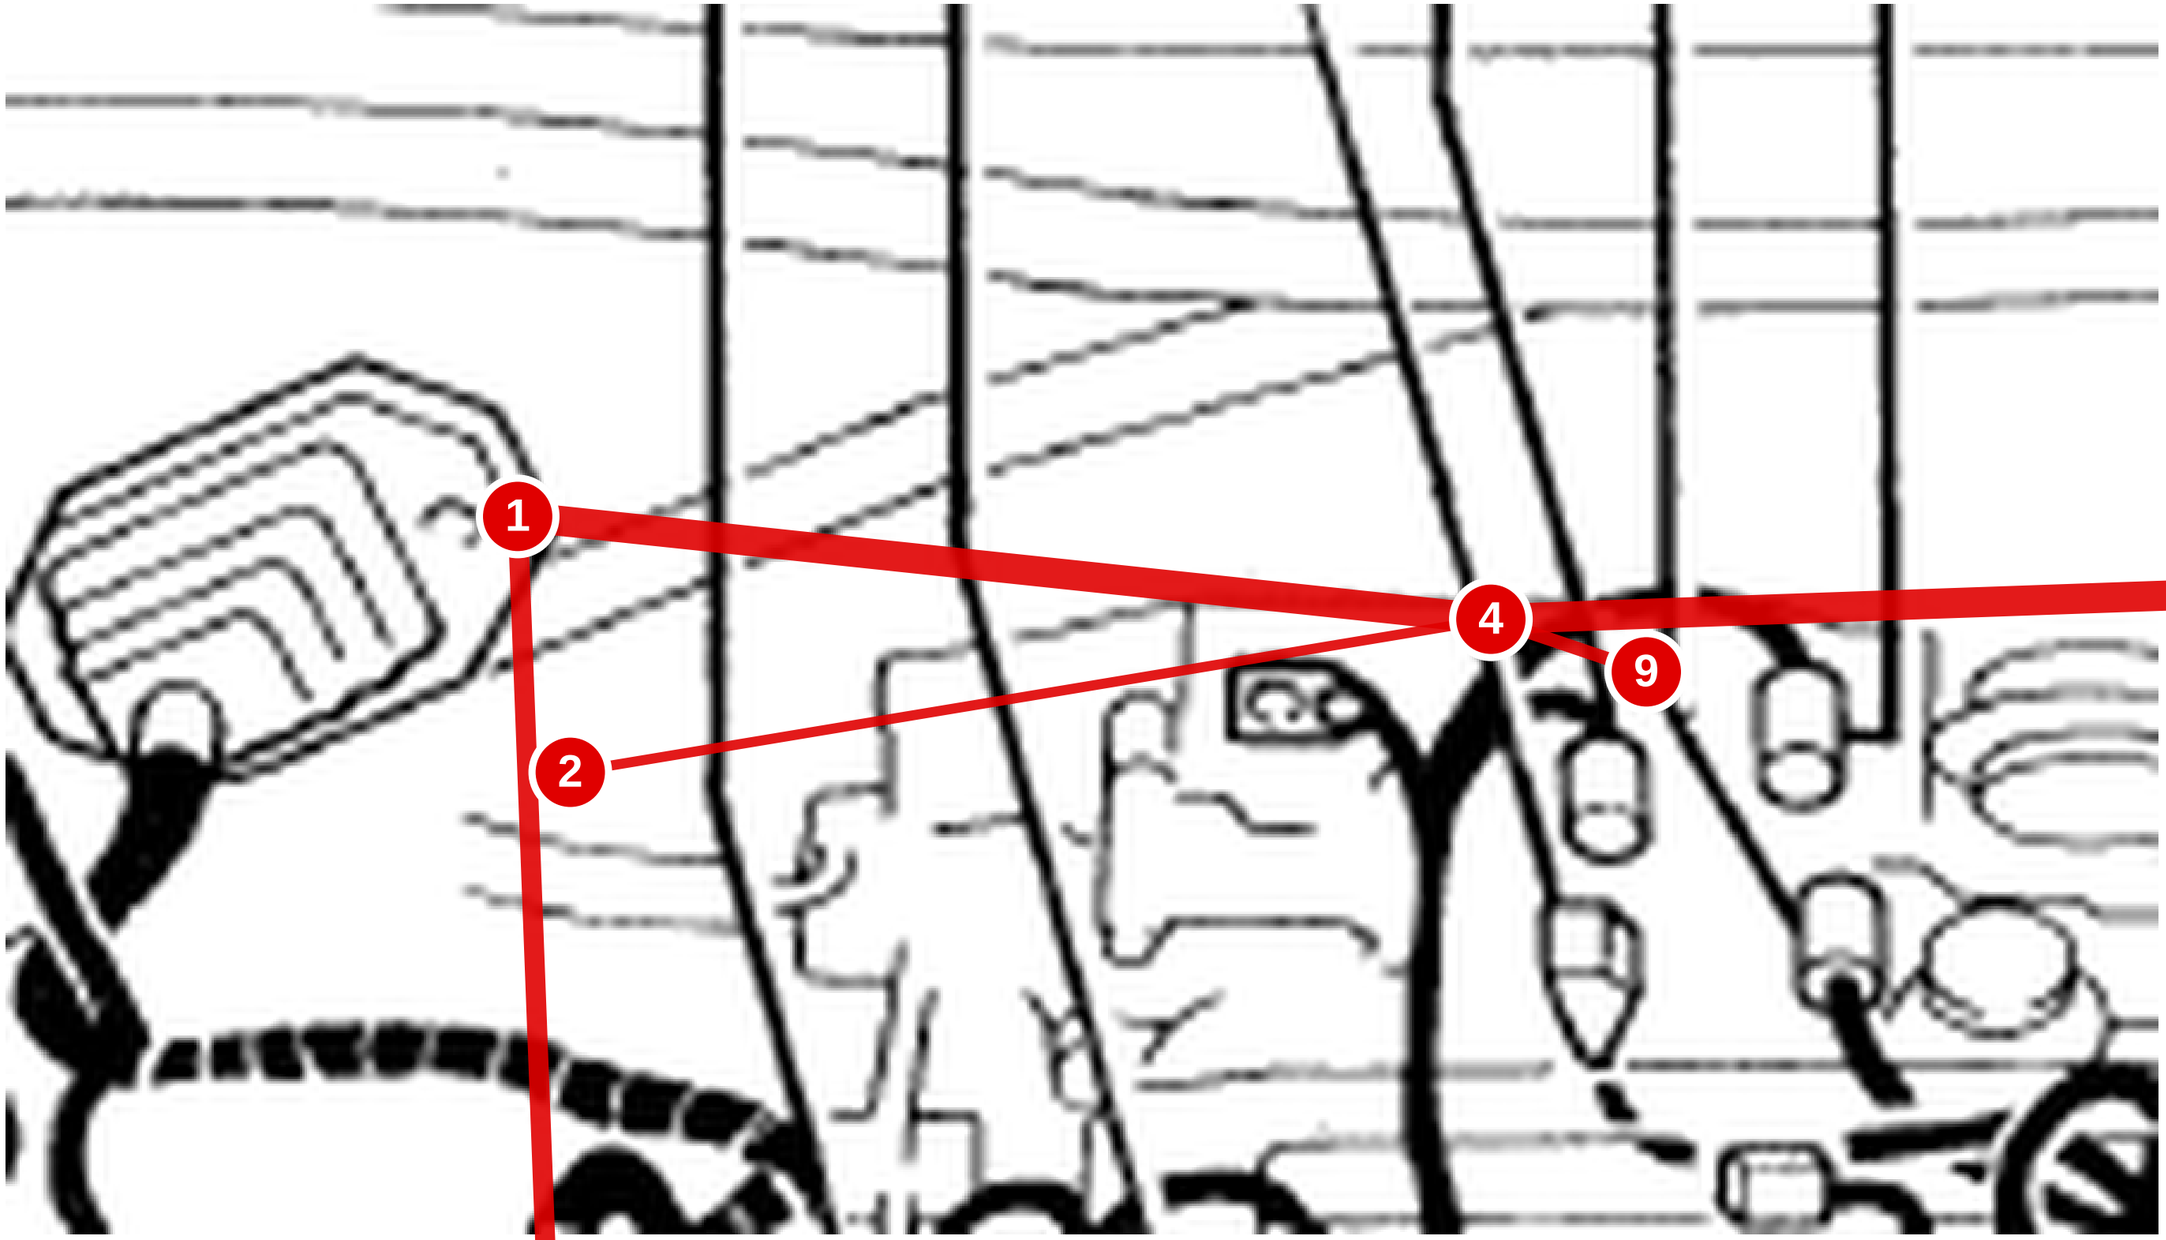

REVISIONS

REV	DATE	BY	DESCRIPTION
C	2026-10-26	DG	A15 lock-sensor input takes a modified tacho: Ign 8 through 4.7 k· to pin 9 (N61 workaround).
D	2026-10-26	DG	Car-check answers: if the ignition-switch black-orange wire is at the engine plug, remove it; A/C s...
E	2026-10-26	DG	C11 is hardware starter interlock only; Aux 8 spare. Oil LED stays on CSB3 L4.
F	2026-10-26	DG	Each grouped section is its own page. A schematic page holds six wires, each in its own line colo...

ST185-harness - every wiring harness of the car, one drawing set

Layout - ST185-AB-engine - ROUTE-4-B-ENGINE


DRAWING NO.	REV	SHEET	SIZE	DRAWN	DATE
ST185-harness-LAY	F	17 OF 65	432 x 279 mm	DG	2026-10-26

ST185 Celica (living-relation) - generated by docs/harness/tools/build_drawings.py from docs/harness/MASTER-wirelist.csv; not to scale

LAYOUT - ST185-AB-engine - ROUTE 4 B ENGINE, as approved (4 of 10)

Top view for Detail A. Top view · same route and colors, projected from the drawing above (approximate). Bright = this view·s part, faded = the rest. Blue squares: B = bulkhead A/B (DRB102), R / L = RH / LH fender pass-throughs. Top view base: 1993 Celica repair manual RM305U1, Introduction, ·Vehicle Lift and Support Locations·, p. IN·24 (st185-celica-repair-manual\manuals\RM305U1 - Introduction - Vehicle Lift and Support Locations.pdf), car...

DRIVER (LH) SIDE

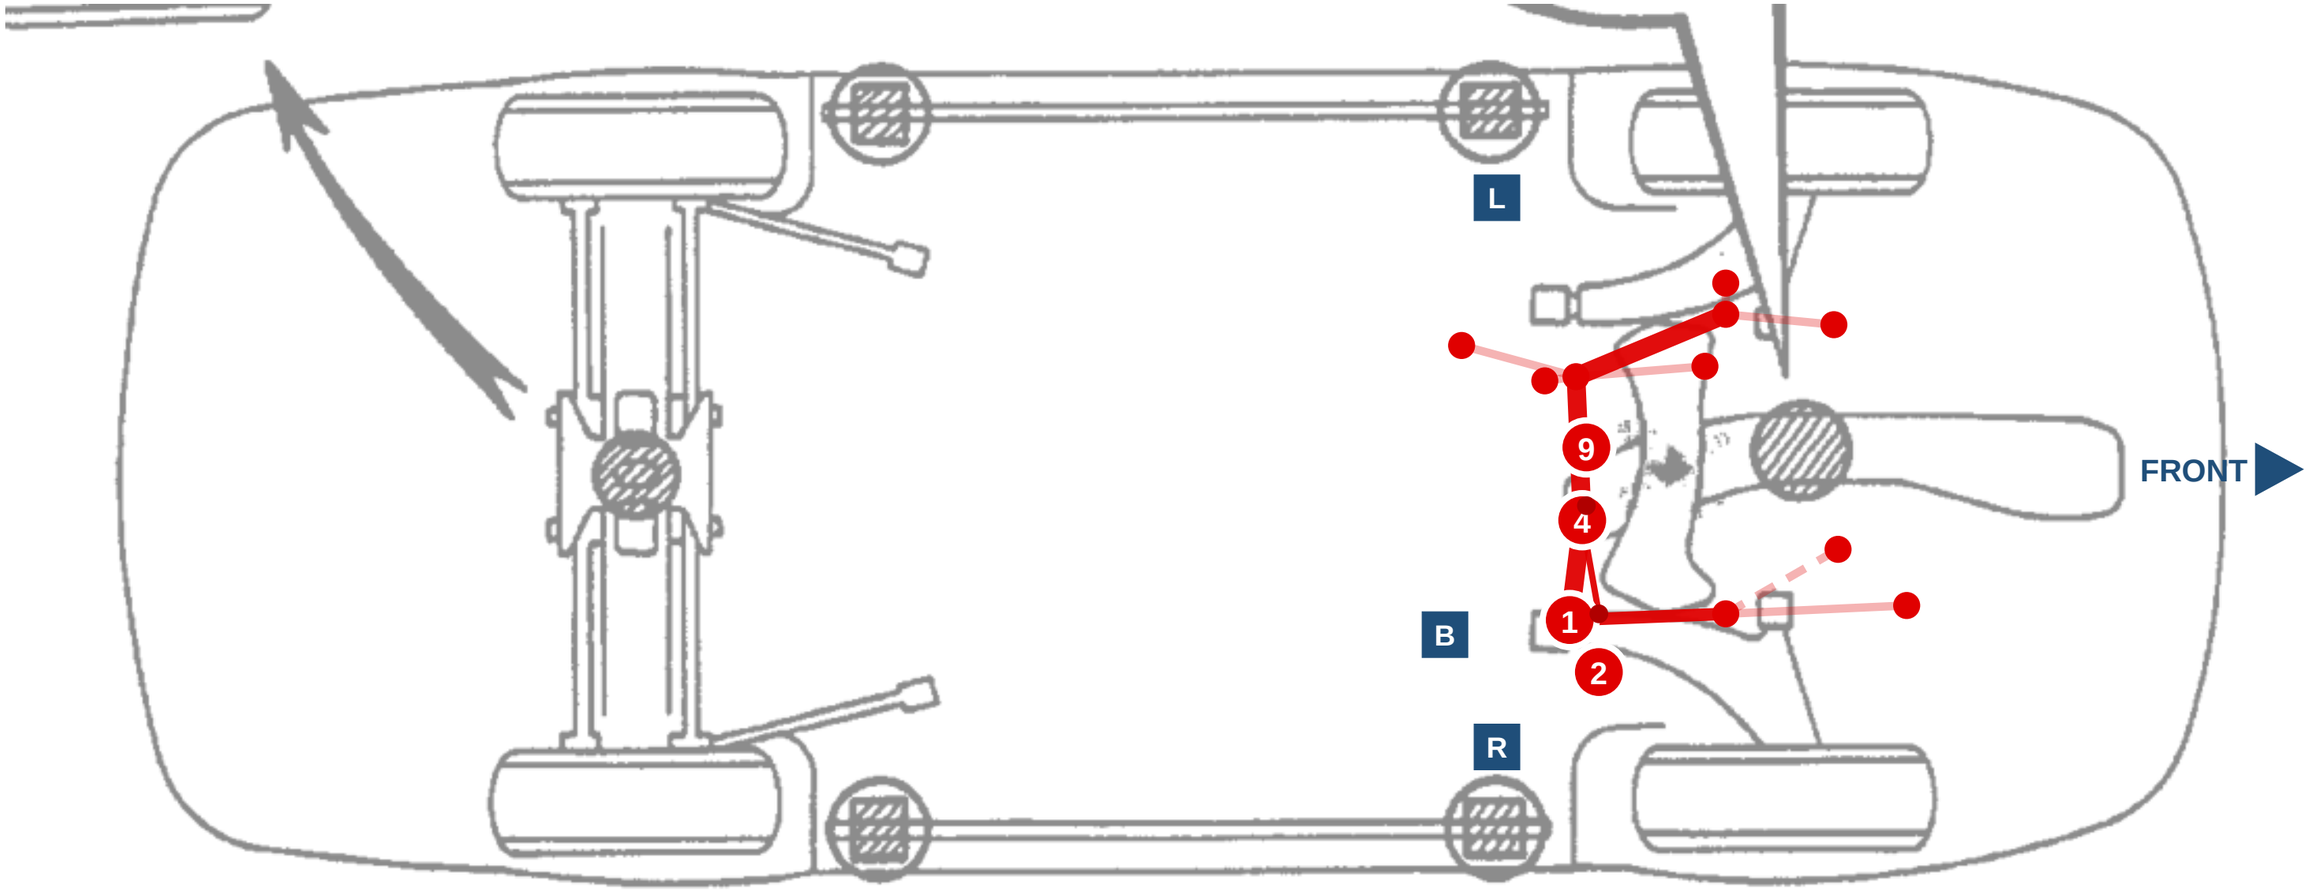

PASSENGER (RH) SIDE

REVISIONS

REV	DATE	BY	DESCRIPTION
C	2026-10-26	DG	A15 lock-sensor input takes a modified tacho: Ign 8 through 4.7 k· to pin 9 (N61 workaround).
D	2026-10-26	DG	Car-check answers: if the ignition-switch black-orange wire is at the engine plug, remove it; A/C s...
E	2026-10-26	DG	C11 is hardware starter interlock only; Aux 8 spare. Oil LED stays on CSB3 L4.
F	2026-10-26	DG	Each grouped section is its own page. A schematic page holds six wires, each in its own line colo...


ST185-harness - every wiring harness of the car, one drawing set

Layout - ST185-AB-engine - ROUTE-4-B-ENGINE

DRAWING NO.	REV	SHEET	SIZE	DRAWN	DATE
ST185-harness-LAY	F	18 OF 65	432 x 279 mm	DG	2026-10-26

LAYOUT - ST185-AB-engine - ROUTE 4 B ENGINE, as approved (5 of 10)

Detail B · FP0 passenger leg (oil temp, CAN-Lambda). Zoomed from the same TIS 1993 EWD p.29 drawing (sheet 2); firewall at top, driver side on the right. Numbers match the main key.

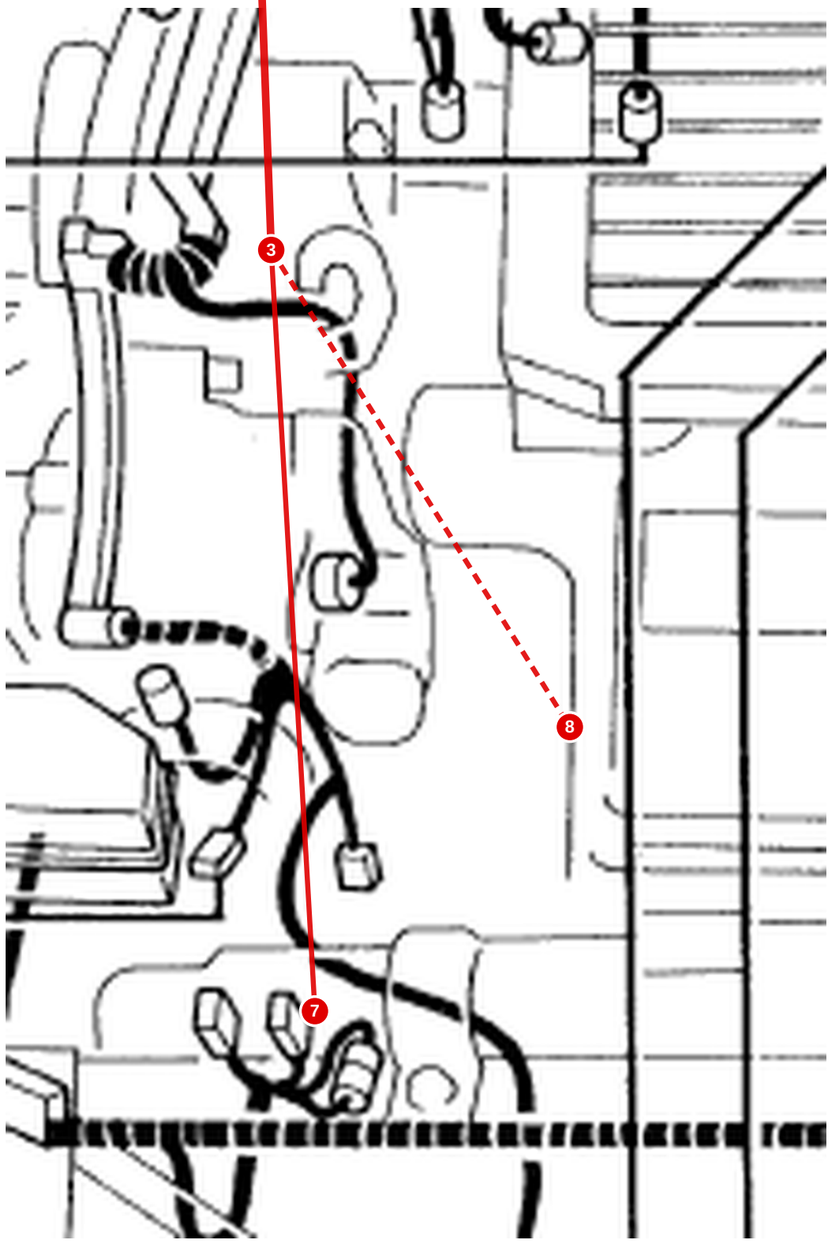

REVISIONS

REV	DATE	BY	DESCRIPTION
C	2026-10-26	DG	A15 lock-sensor input takes a modified tacho: Ign 8 through 4.7 k· to pin 9 (N61 workaround).
D	2026-10-26	DG	Car-check answers: if the ignition-switch black-orange wire is at the engine plug, remove it; A/C s...
E	2026-10-26	DG	C11 is hardware starter interlock only; Aux 8 spare. Oil LED stays on CSB3 L4.
F	2026-10-26	DG	Each grouped section is its own page. A schematic page holds six wires, each in its own line colo...

ST185-harness - every wiring harness of the car, one drawing set

Layout - ST185-AB-engine - ROUTE-4-B-ENGINE


DRAWING NO.	REV	SHEET	SIZE	DRAWN	DATE
ST185-harness-LAY	F	19 OF 65	432 x 279 mm	DG	2026-10-26

ST185 Celica (living-relation) - generated by docs/harness/tools/build_drawings.py from docs/harness/MASTER-wirelist.csv; not to scale

LAYOUT - ST185-AB-engine - ROUTE 4 B ENGINE, as approved (6 of 10)

Top view for Detail B. Top view · same route and colors, projected from the drawing above (approximate). Bright = this view·s part, faded = the rest. Blue squares: B = bulkhead A/B (DRB102), R / L = RH / LH fender pass-throughs. Top view base: 1993 Celica repair manual RM305U1, Introduction, ·Vehicle Lift and Support Locations·, p. IN·24 (st185-celica-repair-manual\manuals\RM305U1 - Introduction - Vehicle Lift and Support Locations.pdf), car...

DRIVER (LH) SIDE

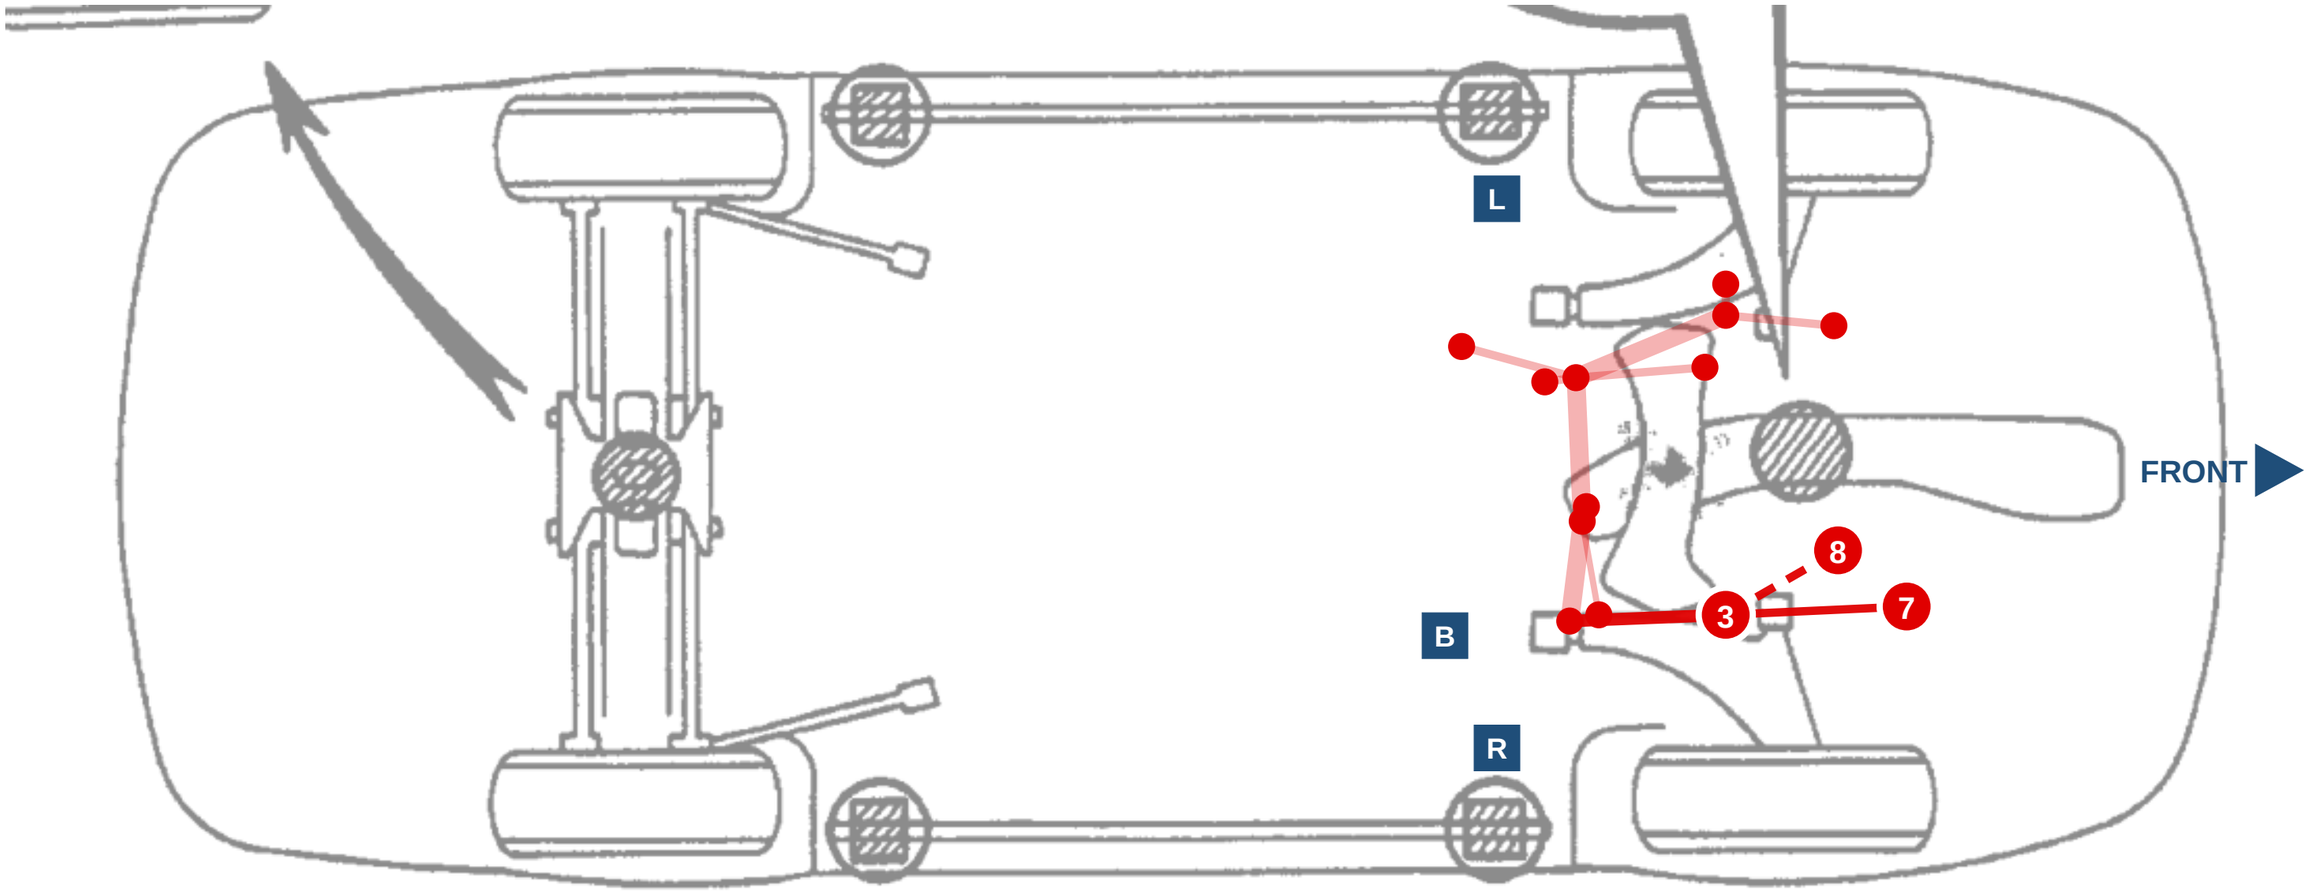

PASSENGER (RH) SIDE

REVISIONS

REV	DATE	BY	DESCRIPTION
C	2026-10-26	DG	A15 lock-sensor input takes a modified tacho: Ign 8 through 4.7 k· to pin 9 (N61 workaround).
D	2026-10-26	DG	Car-check answers: if the ignition-switch black-orange wire is at the engine plug, remove it; A/C s...
E	2026-10-26	DG	C11 is hardware starter interlock only; Aux 8 spare. Oil LED stays on CSB3 L4.
F	2026-10-26	DG	Each grouped section is its own page. A schematic page holds six wires, each in its own line colo...


ST185-harness - every wiring harness of the car, one drawing set

Layout - ST185-AB-engine - ROUTE-4-B-ENGINE

DRAWING NO.	REV	SHEET	SIZE	DRAWN	DATE
ST185-harness-LAY	F	20 OF 65	432 x 279 mm	DG	2026-10-26

LAYOUT - ST185-AB-engine - ROUTE 4 B ENGINE, as approved (7 of 10)

Detail C · FP2 group (fuel, coolant and oil pressure). Zoomed from the same TIS 1993 EWD p.29 drawing (sheet 2); firewall at top, driver side on the right. Numbers match the main key.

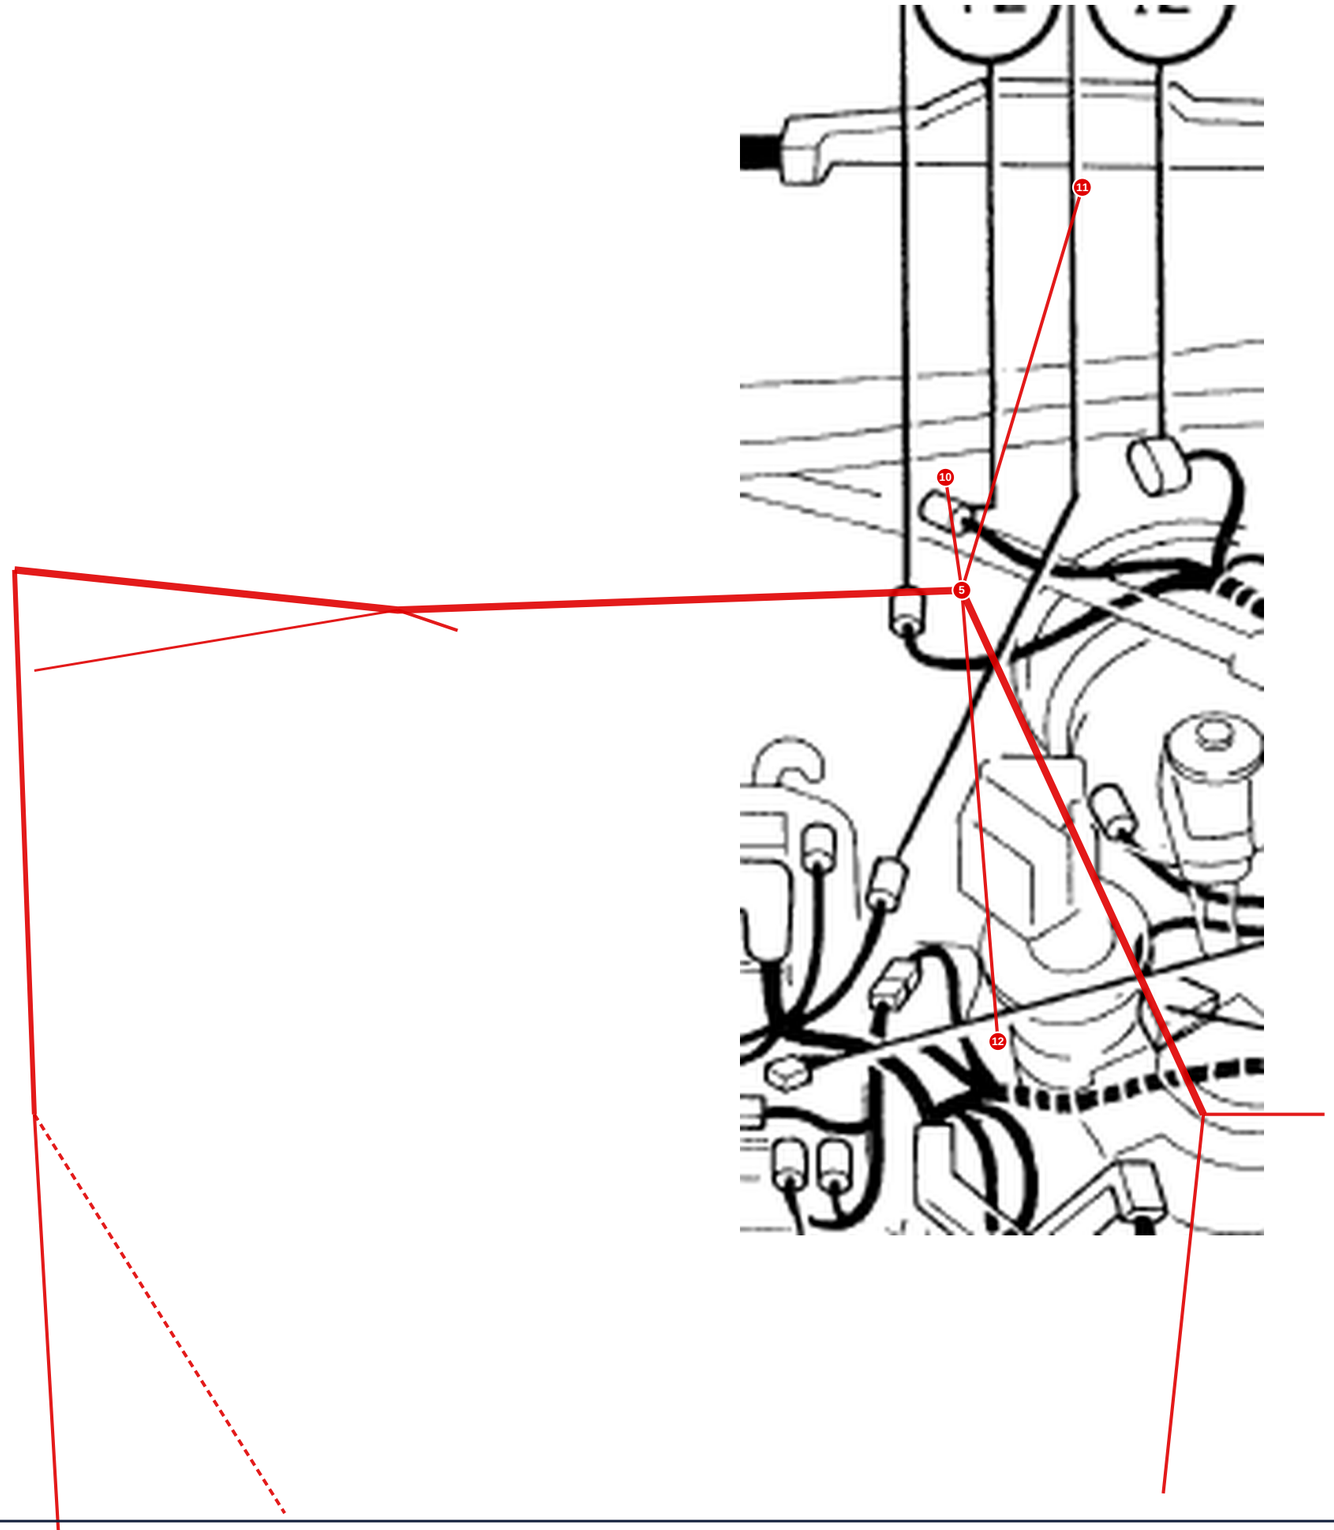

REVISIONS

REV	DATE	BY	DESCRIPTION
C	2026-10-26	DG	A15 lock-sensor input takes a modified tacho: Ign 8 through 4.7 k· to pin 9 (N61 workaround).
D	2026-10-26	DG	Car-check answers: if the ignition-switch black-orange wire is at the engine plug, remove it; A/C s...
E	2026-10-26	DG	C11 is hardware starter interlock only; Aux 8 spare. Oil LED stays on CSB3 L4.
F	2026-10-26	DG	Each grouped section is its own page. A schematic page holds six wires, each in its own line colo...

ST185-harness - every wiring harness of the car, one drawing set

Layout - ST185-AB-engine - ROUTE-4-B-ENGINE


DRAWING NO.	REV	SHEET	SIZE	DRAWN	DATE
ST185-harness-LAY	F	21 OF 65	432 x 279 mm	DG	2026-10-26

ST185 Celica (living-relation) - generated by docs/harness/tools/build_drawings.py from docs/harness/MASTER-wirelist.csv; not to scale

LAYOUT - ST185-AB-engine - ROUTE 4 B ENGINE, as approved (8 of 10)

Top view for Detail C. Top view · same route and colors, projected from the drawing above (approximate). Bright = this view·s part, faded = the rest. Blue squares: B = bulkhead A/B (DRB102), R / L = RH / LH fender pass-throughs. Top view base: 1993 Celica repair manual RM305U1, Introduction, ·Vehicle Lift and Support Locations·, p. IN·24 (st185-celica-repair-manual\manuals\RM305U1 - Introduction - Vehicle Lift and Support Locations.pdf), car...

DRIVER (LH) SIDE

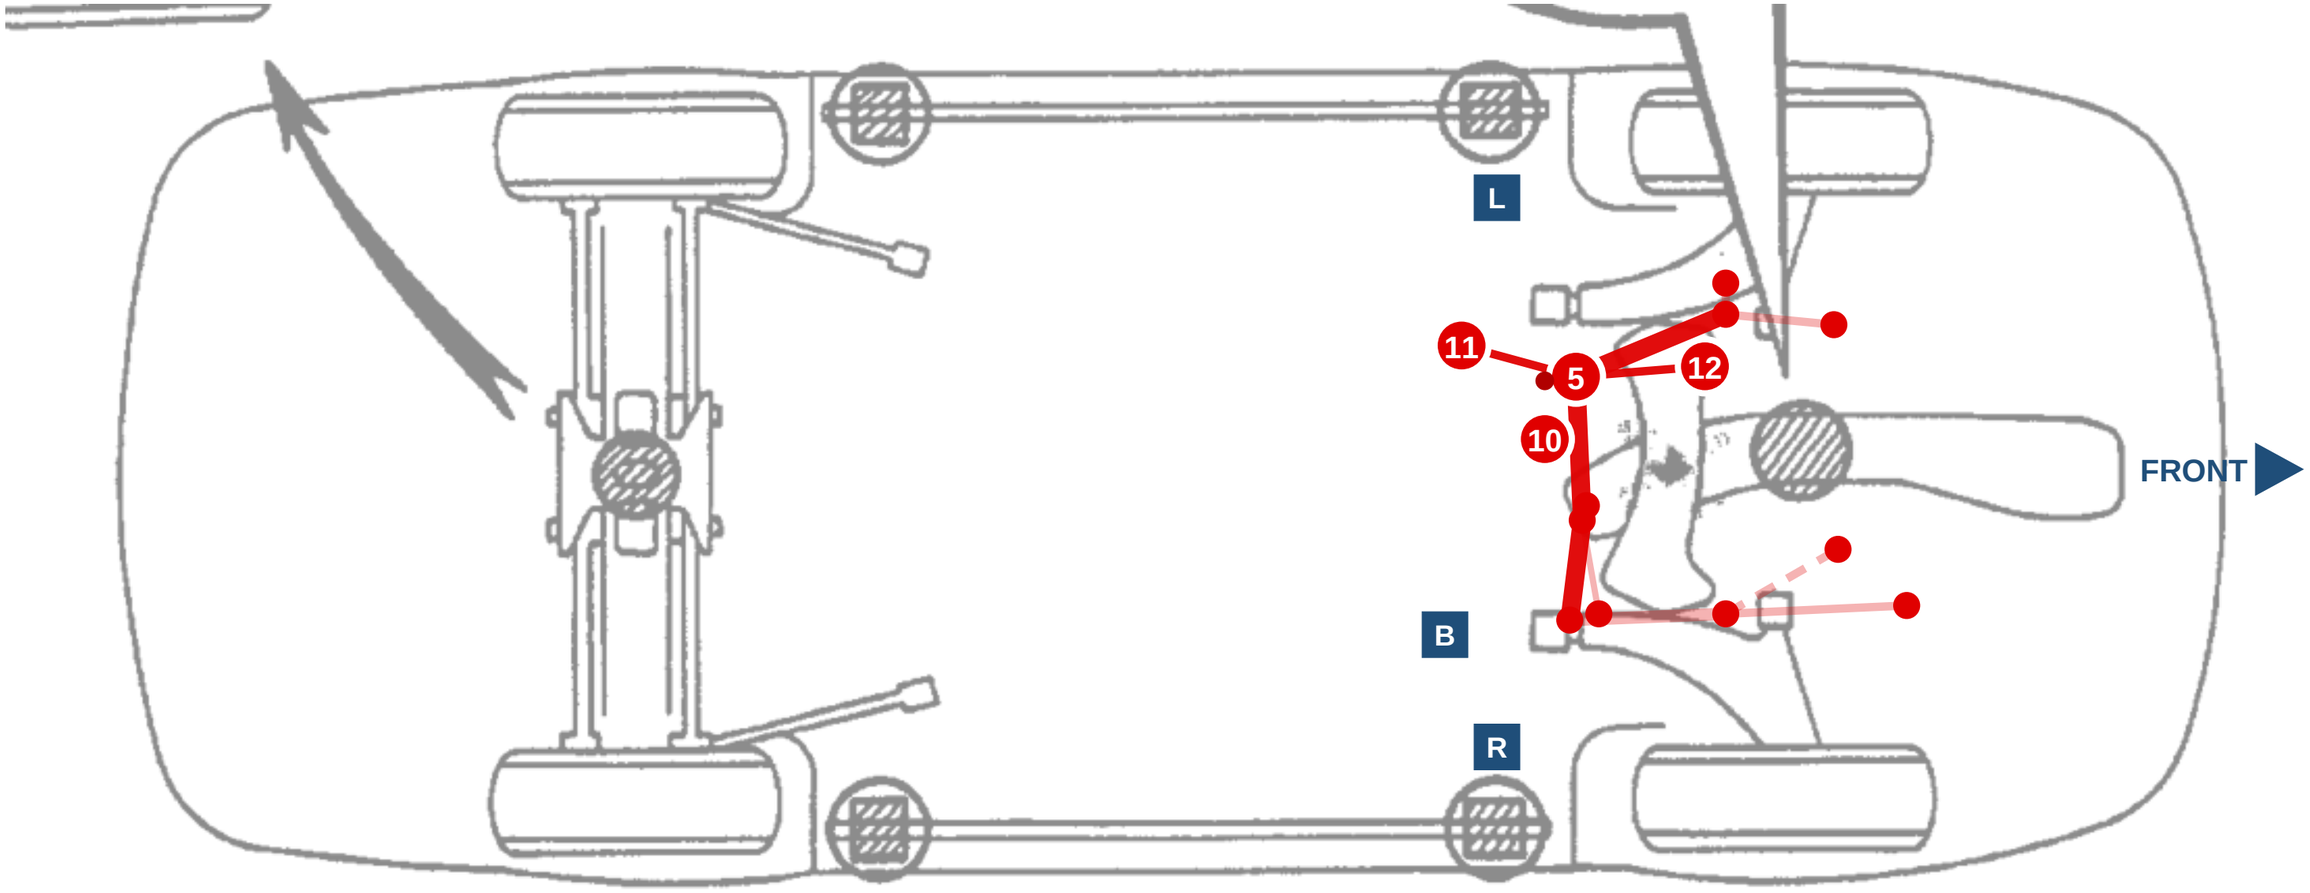

PASSENGER (RH) SIDE

REVISIONS

REV	DATE	BY	DESCRIPTION
C	2026-10-26	DG	A15 lock-sensor input takes a modified tacho: Ign 8 through 4.7 k· to pin 9 (N61 workaround).
D	2026-10-26	DG	Car-check answers: if the ignition-switch black-orange wire is at the engine plug, remove it; A/C s...
E	2026-10-26	DG	C11 is hardware starter interlock only; Aux 8 spare. Oil LED stays on CSB3 L4.
F	2026-10-26	DG	Each grouped section is its own page. A schematic page holds six wires, each in its own line colo...

ST185-harness - every wiring harness of the car, one drawing set


Layout - ST185-AB-engine - ROUTE-4-B-ENGINE

DRAWING NO.	REV	SHEET	SIZE	DRAWN	DATE
ST185-harness-LAY	F	22 OF 65	432 x 279 mm	DG	2026-10-26

ST185 Celica (living-relation) - generated by docs/harness/tools/build_drawings.py from docs/harness/MASTER-wirelist.csv; not to scale

LAYOUT - ST185-AB-engine - ROUTE 4 B ENGINE, as approved (9 of 10)

Detail D · FP3 group (IAT charge pipe, gearbox VSS). Zoomed from the same TIS 1993 EWD p.29 drawing (sheet 2); firewall at top, driver side on the right. Numbers match the master key.

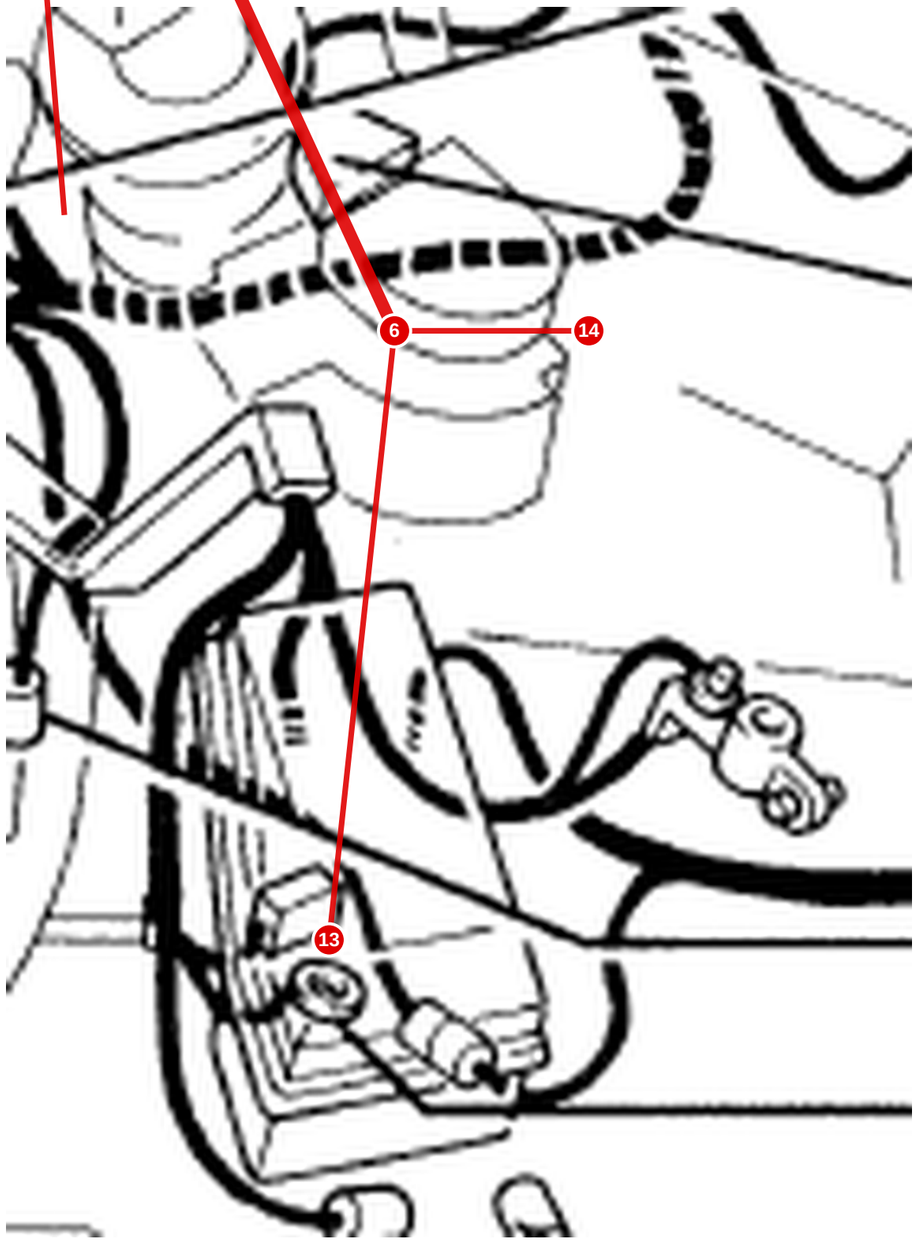

REVISIONS

REV	DATE	BY	DESCRIPTION
C	2026-10-26	DG	A15 lock-sensor input takes a modified tacho: Ign 8 through 4.7 k· to pin 9 (N61 workaround).
D	2026-10-26	DG	Car-check answers: if the ignition-switch black-orange wire is at the engine plug, remove it; A/C s...
E	2026-10-26	DG	C11 is hardware starter interlock only; Aux 8 spare. Oil LED stays on CSB3 L4.
F	2026-10-26	DG	Each grouped section is its own page. A schematic page holds six wires, each in its own line colo...

ST185-harness - every wiring harness of the car, one drawing set

Layout - ST185-AB-engine - ROUTE-4-B-ENGINE


DRAWING NO.	REV	SHEET	SIZE	DRAWN	DATE
ST185-harness-LAY	F	23 OF 65	432 x 279 mm	DG	2026-10-26

ST185 Celica (living-relation) - generated by docs/harness/tools/build_drawings.py from docs/harness/MASTER-wirelist.csv; not to scale

LAYOUT - ST185-AB-engine - ROUTE 4 B ENGINE, as approved (10 of 10)

Top view for Detail D. Top view · same route and colors, projected from the drawing above (approximate). Bright = this view·s part, faded = the rest. Blue squares: B = bulkhead A/B (DRB102), R / L = RH / LH fender pass-throughs. Top view base: 1993 Celica repair manual RM305U1, Introduction, ·Vehicle Lift and Support Locations·, p. IN·24 (st185-celica-repair-manual\manuals\RM305U1 - Introduction - Vehicle Lift and Support Locations.pdf), car...

DRIVER (LH) SIDE

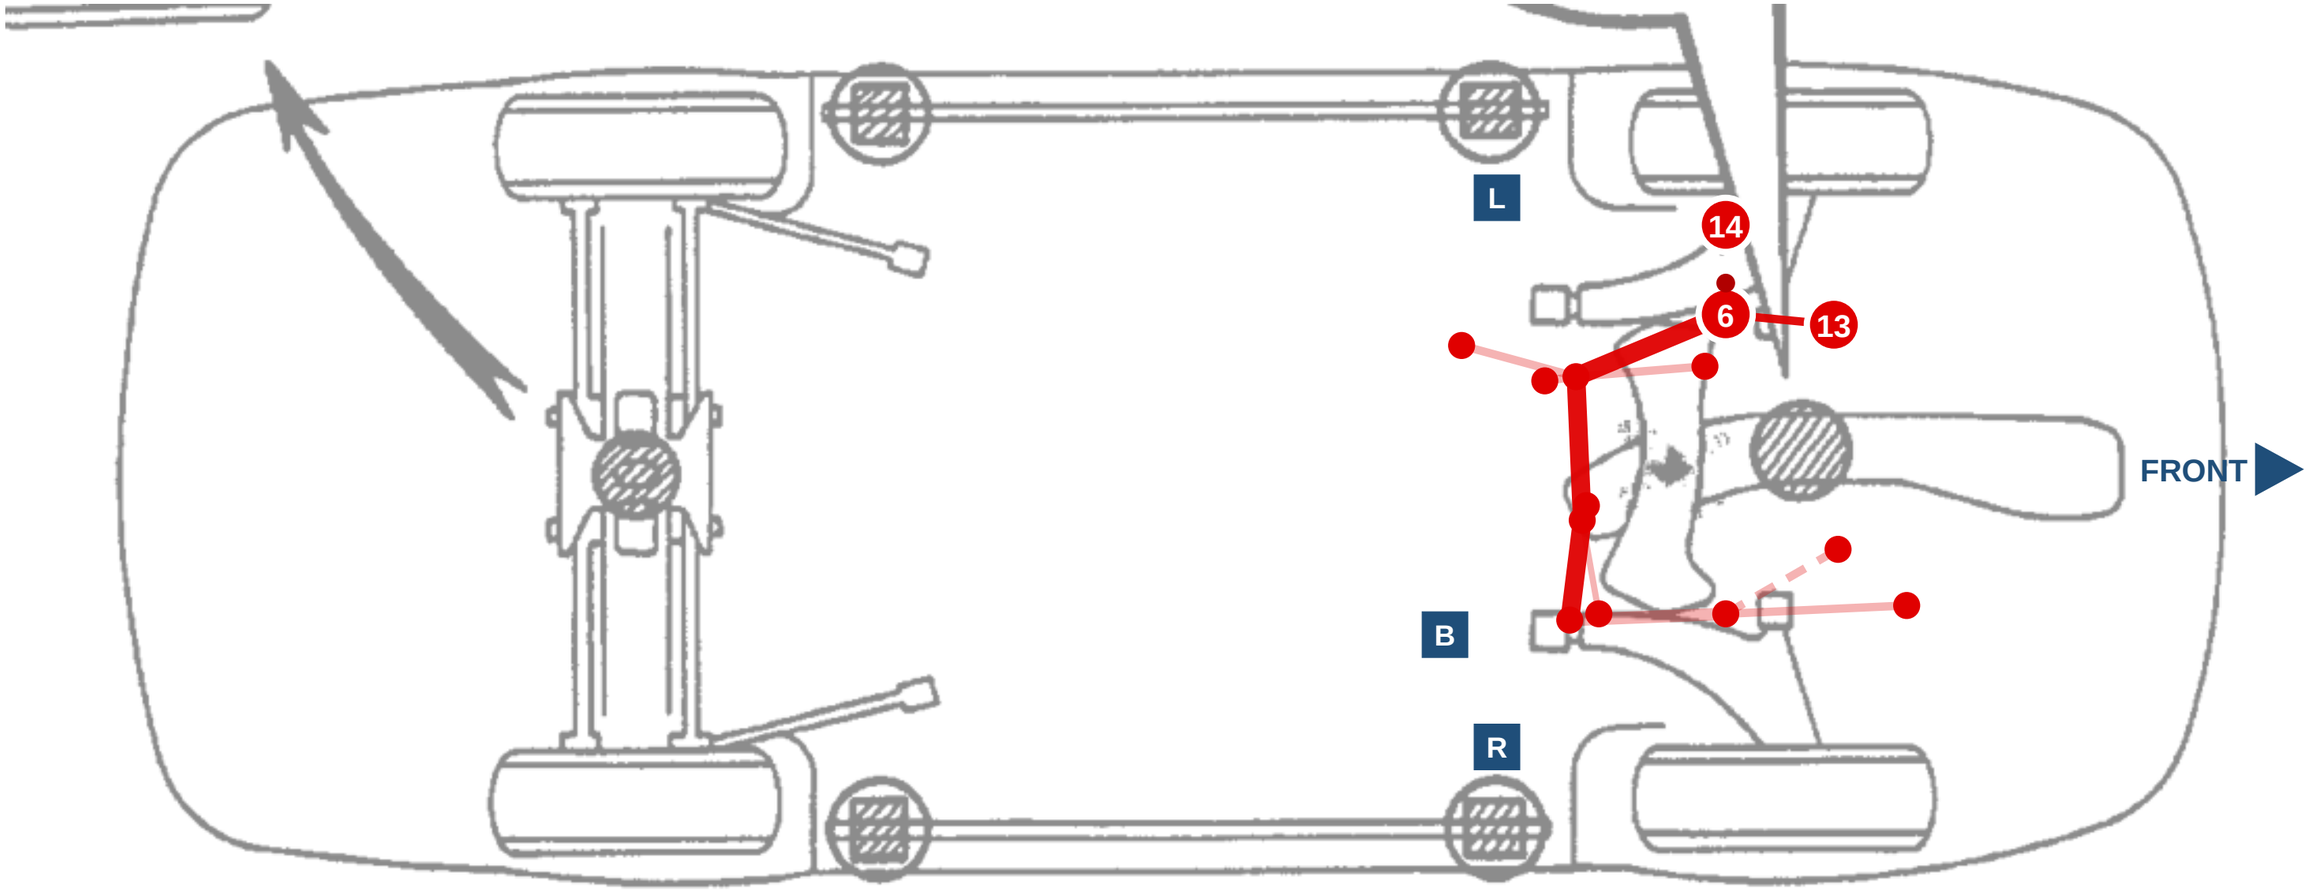

PASSENGER (RH) SIDE

REVISIONS

REV	DATE	BY	DESCRIPTION
C	2026-10-26	DG	A15 lock-sensor input takes a modified tacho: Ign 8 through 4.7 k· to pin 9 (N61 workaround).
D	2026-10-26	DG	Car-check answers: if the ignition-switch black-orange wire is at the engine plug, remove it; A/C s...
E	2026-10-26	DG	C11 is hardware starter interlock only; Aux 8 spare. Oil LED stays on CSB3 L4.
F	2026-10-26	DG	Each grouped section is its own page. A schematic page holds six wires, each in its own line colo...

ST185-harness - every wiring harness of the car, one drawing set

Layout - ST185-AB-engine - ROUTE-4-B-ENGINE

DRAWING NO.	REV	SHEET	SIZE	DRAWN	DATE
ST185-harness-LAY	F	24 OF 65	432 x 279 mm	DG	2026-10-26

ST185 Celica (living-relation) - generated by docs/harness/tools/build_drawings.py from docs/harness/MASTER-wirelist.csv; not to scale

LAYOUT - ST185-AB-engine - ROUTE 16 ENGINE MAIN, as approved (1 of 1)


1993 EWD (EWD160U) book p.36, Electrical Wiring Routing, 3S-GTE engine compartment; coordinates in PDF points of Connector__Ground_and_Splice.pdf page 1 (st185-celica-repair-manual).

ELECTRICAL WIRING ROUTING


▭ : Location of Connector Joining Wire Harness and Wire Harness

▽ : Location of Ground Points

[3S-GTE]

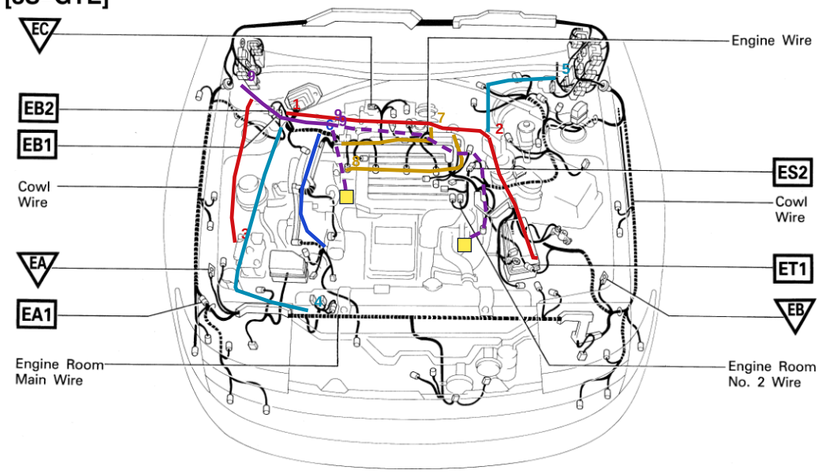

○ : Location of Splice Points

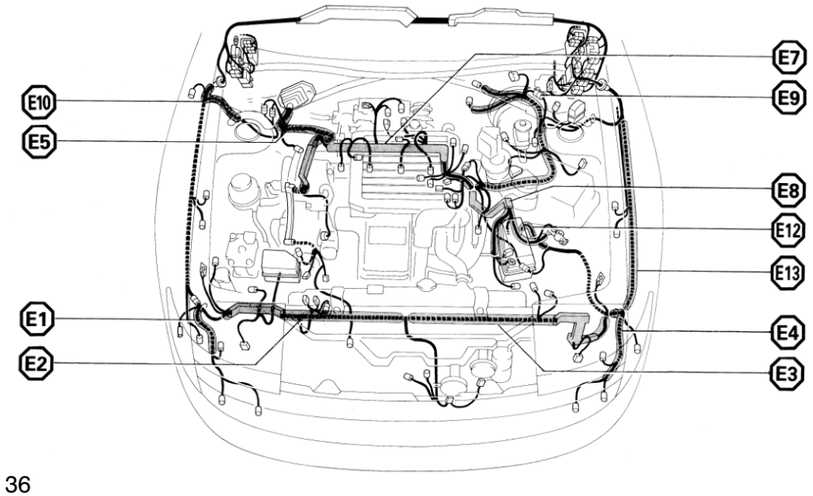

36

APPROVED LINES

- 1 Main trunk
- 2 Driver-side drop
- 3 Passenger fender drop
- 4 Passenger front run
- 5 Driver firewall spur
- 6 Belt-end drop
- 7 Head loom, rear
- 8 Head loom, front
- 9 Alt and starter
- 9 Alt and starter, low behind the engine
- 9 Alt and starter, low behind the engine

DEVICES

alternator
starter

REVISIONS

REV	DATE	BY	DESCRIPTION
C	2026-10-26	DG	A15 lock-sensor input takes a modified tacho: Ign 8 through 4.7 k· to pin 9 (N61 workaround).
D	2026-10-26	DG	Car-check answers: if the ignition-switch black-orange wire is at the engine plug, remove it; A/C s...
E	2026-10-26	DG	C11 is hardware starter interlock only; Aux 8 spare. Oil LED stays on CSB3 L4.
F	2026-10-26	DG	Each grouped section is its own page. A schematic page holds six wires, each in its own line colo...

ST185-harness - every wiring harness of the car, one drawing set


Layout - ST185-AB-engine - ROUTE-16-ENGINE-MAIN

DRAWING NO.	REV	SHEET	SIZE	DRAWN	DATE
ST185-harness-LAY	F	25 OF 65	432 x 279 mm	DG	2026-10-26

ST185 Celica (living-relation) - generated by docs/harness/tools/build_drawings.py from docs/harness/MASTER-wirelist.csv; not to scale

LAYOUT - ST185-CabinPower - ROUTE 7 CABINPOWER, as approved (1 of 4)

Fig. 1 · Instrument panel, TIS 1993 EWD ·Relay Locations· p.18 (tis1993-relay-locations.pdf, sheet 1). Driver side left, glove box right. Red solid = CabinPower runs from the glove-box POWER box and LOGIC box; thin dashed = the two B28 / B30 ignition taps (B-cabin leads, shown for reference). R/B No.2, No.3 and No.4 drawn on this page are removed (fog lights deleted, Dan 2026·10·10) · their spots are only where the new feeds splice onto the C

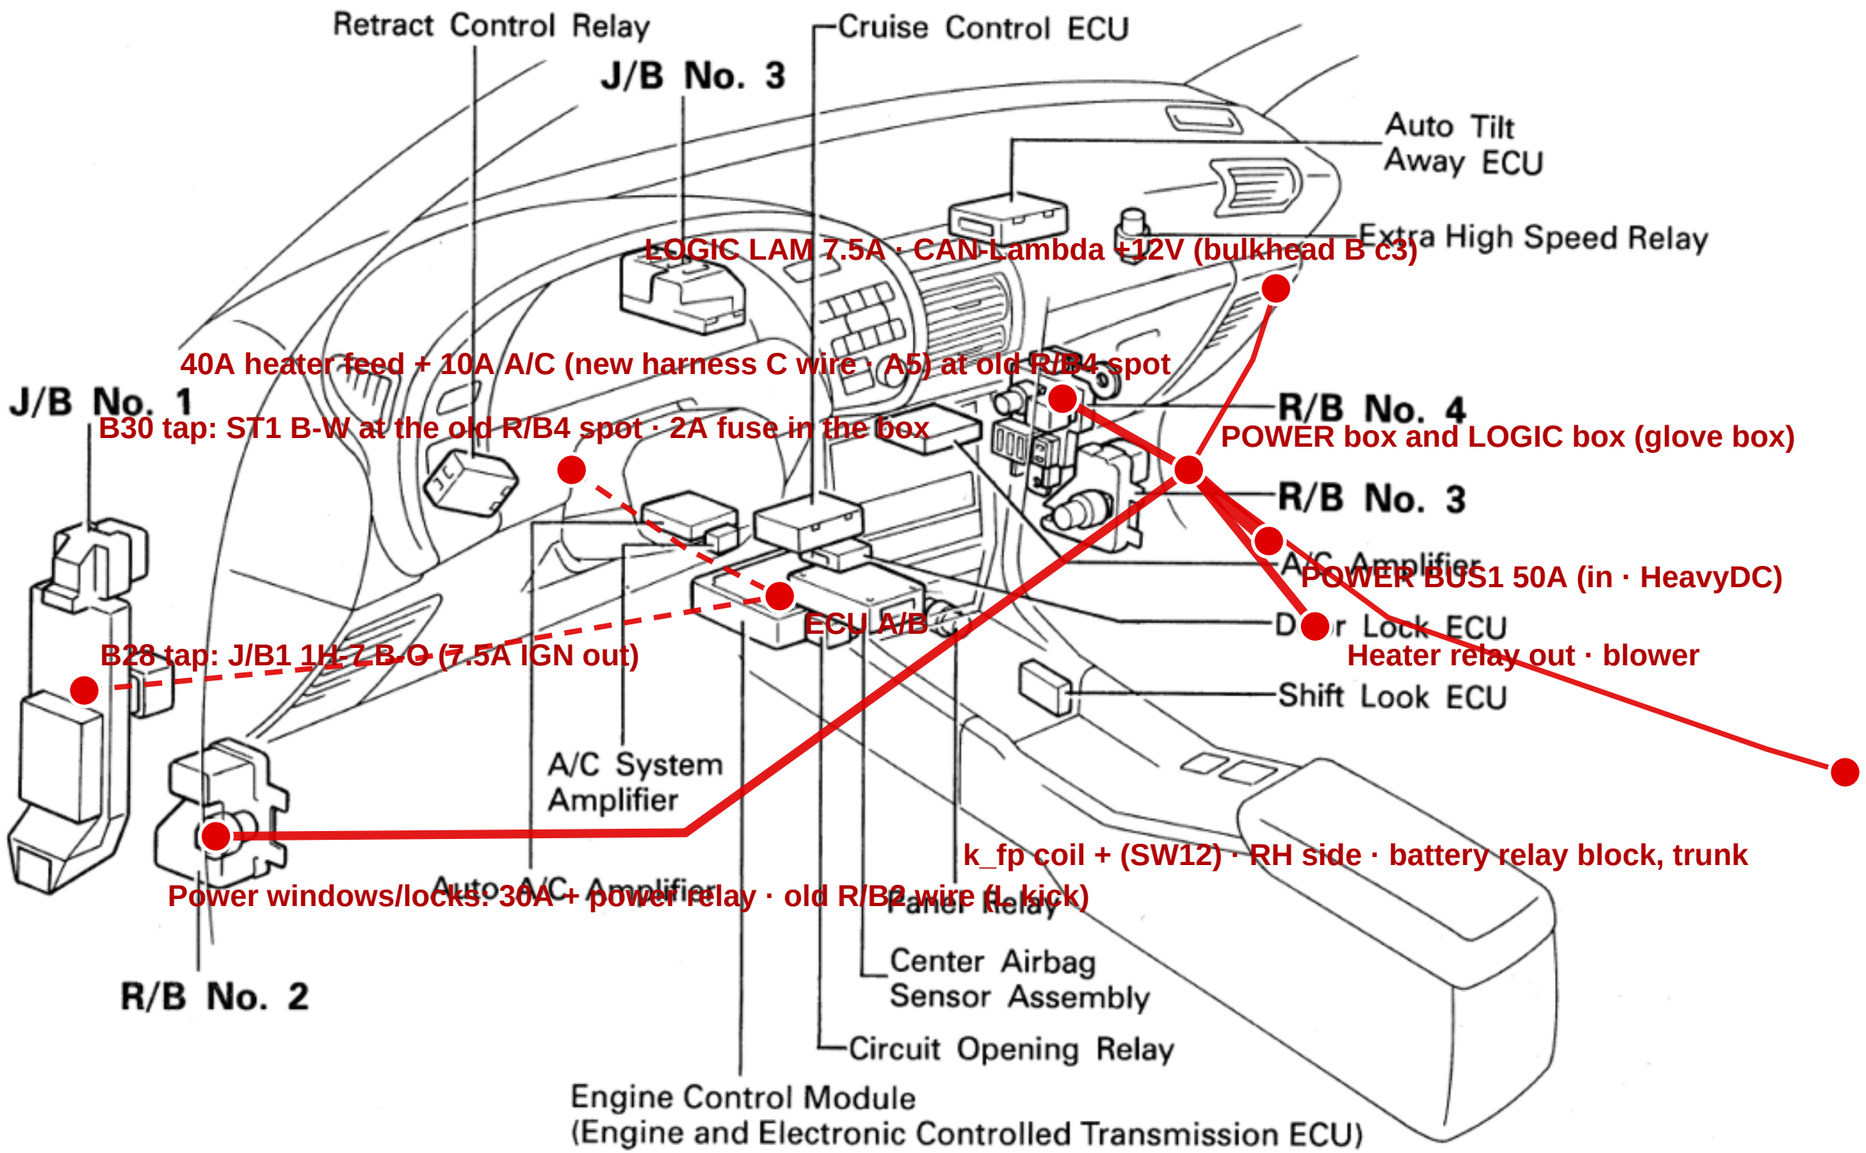

REVISIONS

REV	DATE	BY	DESCRIPTION
C	2026-10-26	DG	A15 lock-sensor input takes a modified tacho: Ign 8 through 4.7 k· to pin 9 (N61 workaround).
D	2026-10-26	DG	Car-check answers: if the ignition-switch black-orange wire is at the engine plug, remove it; A/C s...
E	2026-10-26	DG	C11 is hardware starter interlock only; Aux 8 spare. Oil LED stays on CSB3 L4.
F	2026-10-26	DG	Each grouped section is its own page. A schematic page holds six wires, each in its own line colo...

ST185-harness - every wiring harness of the car, one drawing set

Layout - ST185-CabinPower - ROUTE-7-CABINPOWER


DRAWING NO.	REV	SHEET	SIZE	DRAWN	DATE
ST185-harness-LAY	F	26 OF 65	432 x 279 mm	DG	2026-10-26

ST185 Celica (living-relation) - generated by docs/harness/tools/build_drawings.py from docs/harness/MASTER-wirelist.csv; not to scale

LAYOUT - ST185-CabinPower - ROUTE 7 CABINPOWER, as approved (2 of 4)

Top view for the figure above · same route, same colors. Projected from the figure above (approximate); this figure·s part is bright, the rest of the route is faded. Blue squares: B = bulkhead A/B (DRB102, RH firewall), R / L = RH / LH fender pass-throughs (Route 9 rev 2). Top view base: 1993 Celica repair manual RM305U1, Introduction, ·Vehicle Lift and Support Locations·, p. IN·24 (st185-celica-repair-manual\manuals\RM305U1 - Introduction - Ve...

DRIVER (LH) SIDE

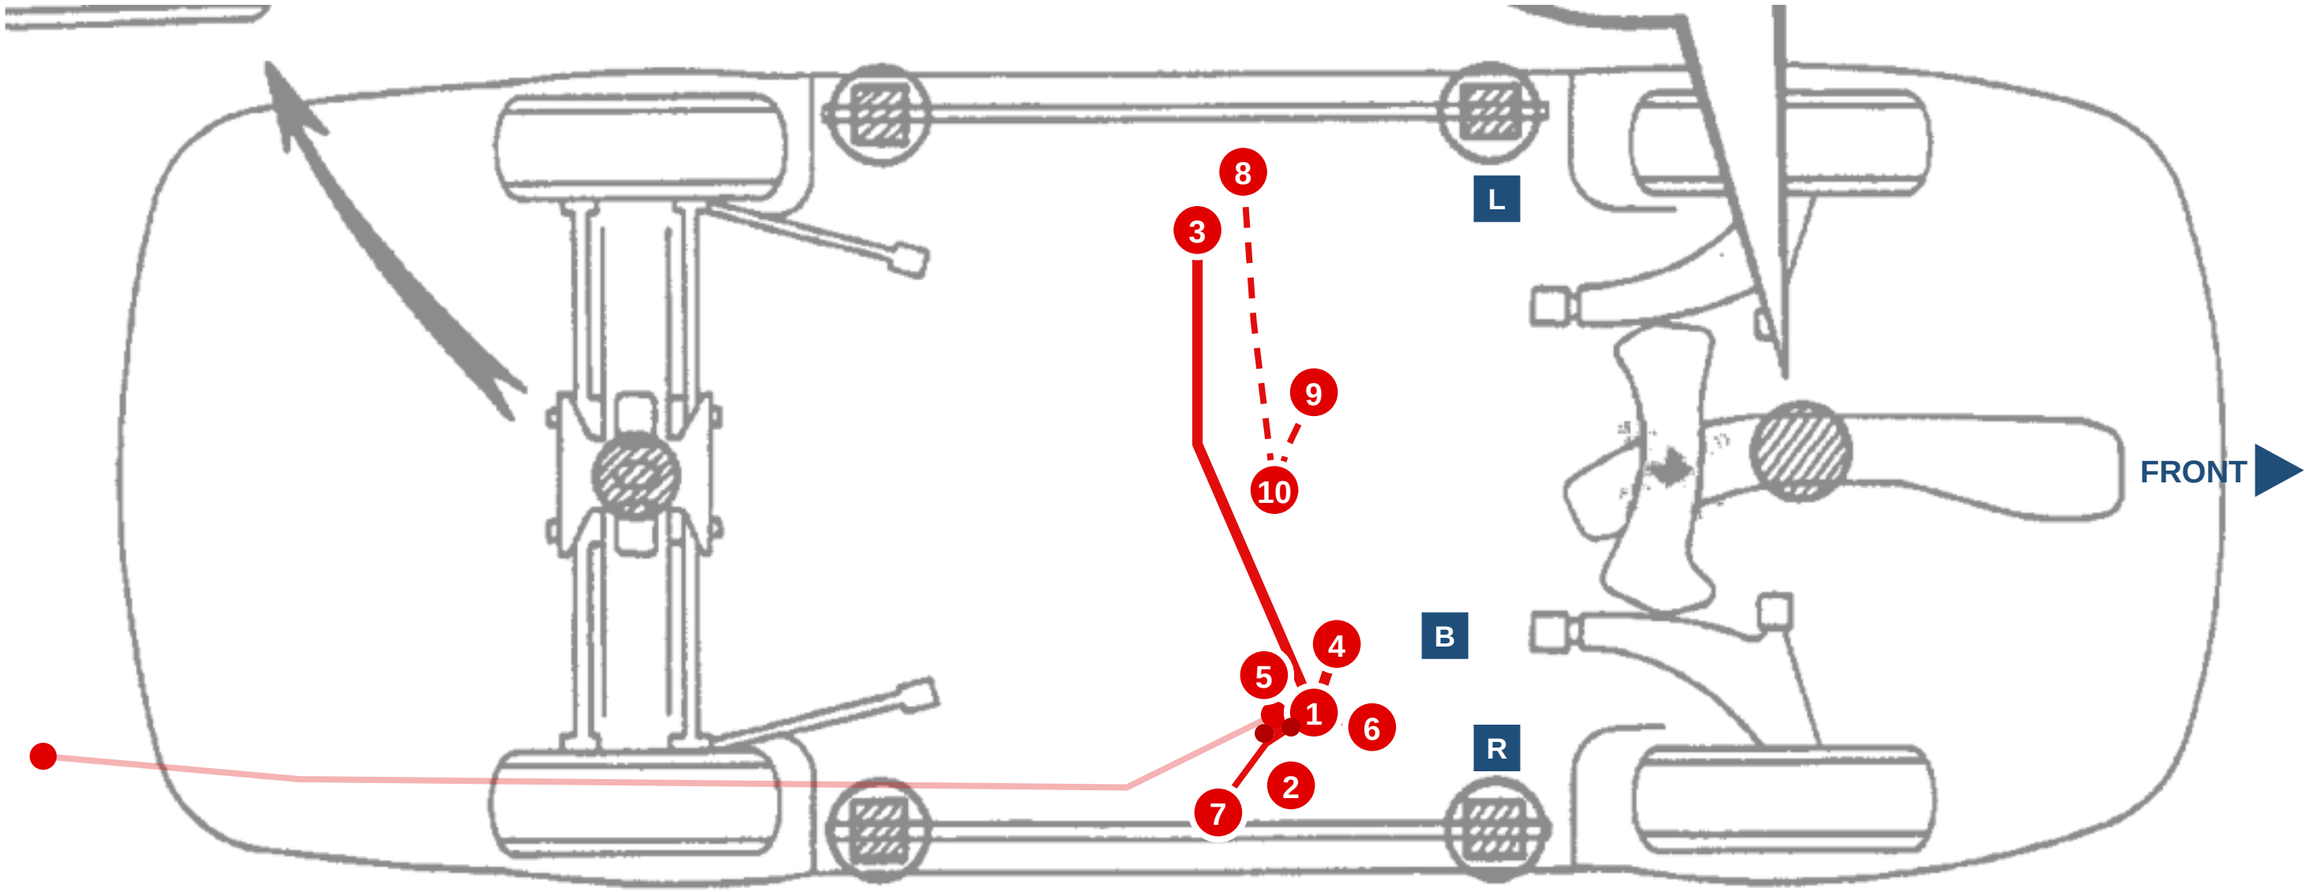

PASSENGER (RH) SIDE

REVISIONS

REV	DATE	BY	DESCRIPTION
C	2026-10-26	DG	A15 lock-sensor input takes a modified tacho: Ign 8 through 4.7 k· to pin 9 (N61 workaround).
D	2026-10-26	DG	Car-check answers: if the ignition-switch black-orange wire is at the engine plug, remove it; A/C s...
E	2026-10-26	DG	C11 is hardware starter interlock only; Aux 8 spare. Oil LED stays on CSB3 L4.
F	2026-10-26	DG	Each grouped section is its own page. A schematic page holds six wires, each in its own line colo...

ST185-harness - every wiring harness of the car, one drawing set


Layout - ST185-CabinPower - ROUTE-7-CABINPOWER

DRAWING NO.	REV	SHEET	SIZE	DRAWN	DATE
ST185-harness-LAY	F	27 OF 65	432 x 279 mm	DG	2026-10-26

ST185 Celica (living-relation) - generated by docs/harness/tools/build_drawings.py from docs/harness/MASTER-wirelist.csv; not to scale

LAYOUT - ST185-CabinPower - ROUTE 7 CABINPOWER, as approved (3 of 4)

Fig. 2 · Body, liftback, TIS 1993 EWD ·Electrical Wiring Routing· p.46 (tis1993-wiring-routing-2.pdf, sheet 11). Car front at left; the run is on the far (passenger, RH) side, alongside the HeavyDC battery cables (Route 1), so it is drawn approximately. K1 redraw: it now ends at the battery relay block (the pump feed starts there, Route 11) and carries only the k_fp coil + wire (SW12). The coil · wire A19 (A-cabin) and the fuel level B24 lead (B-cabin) ri...

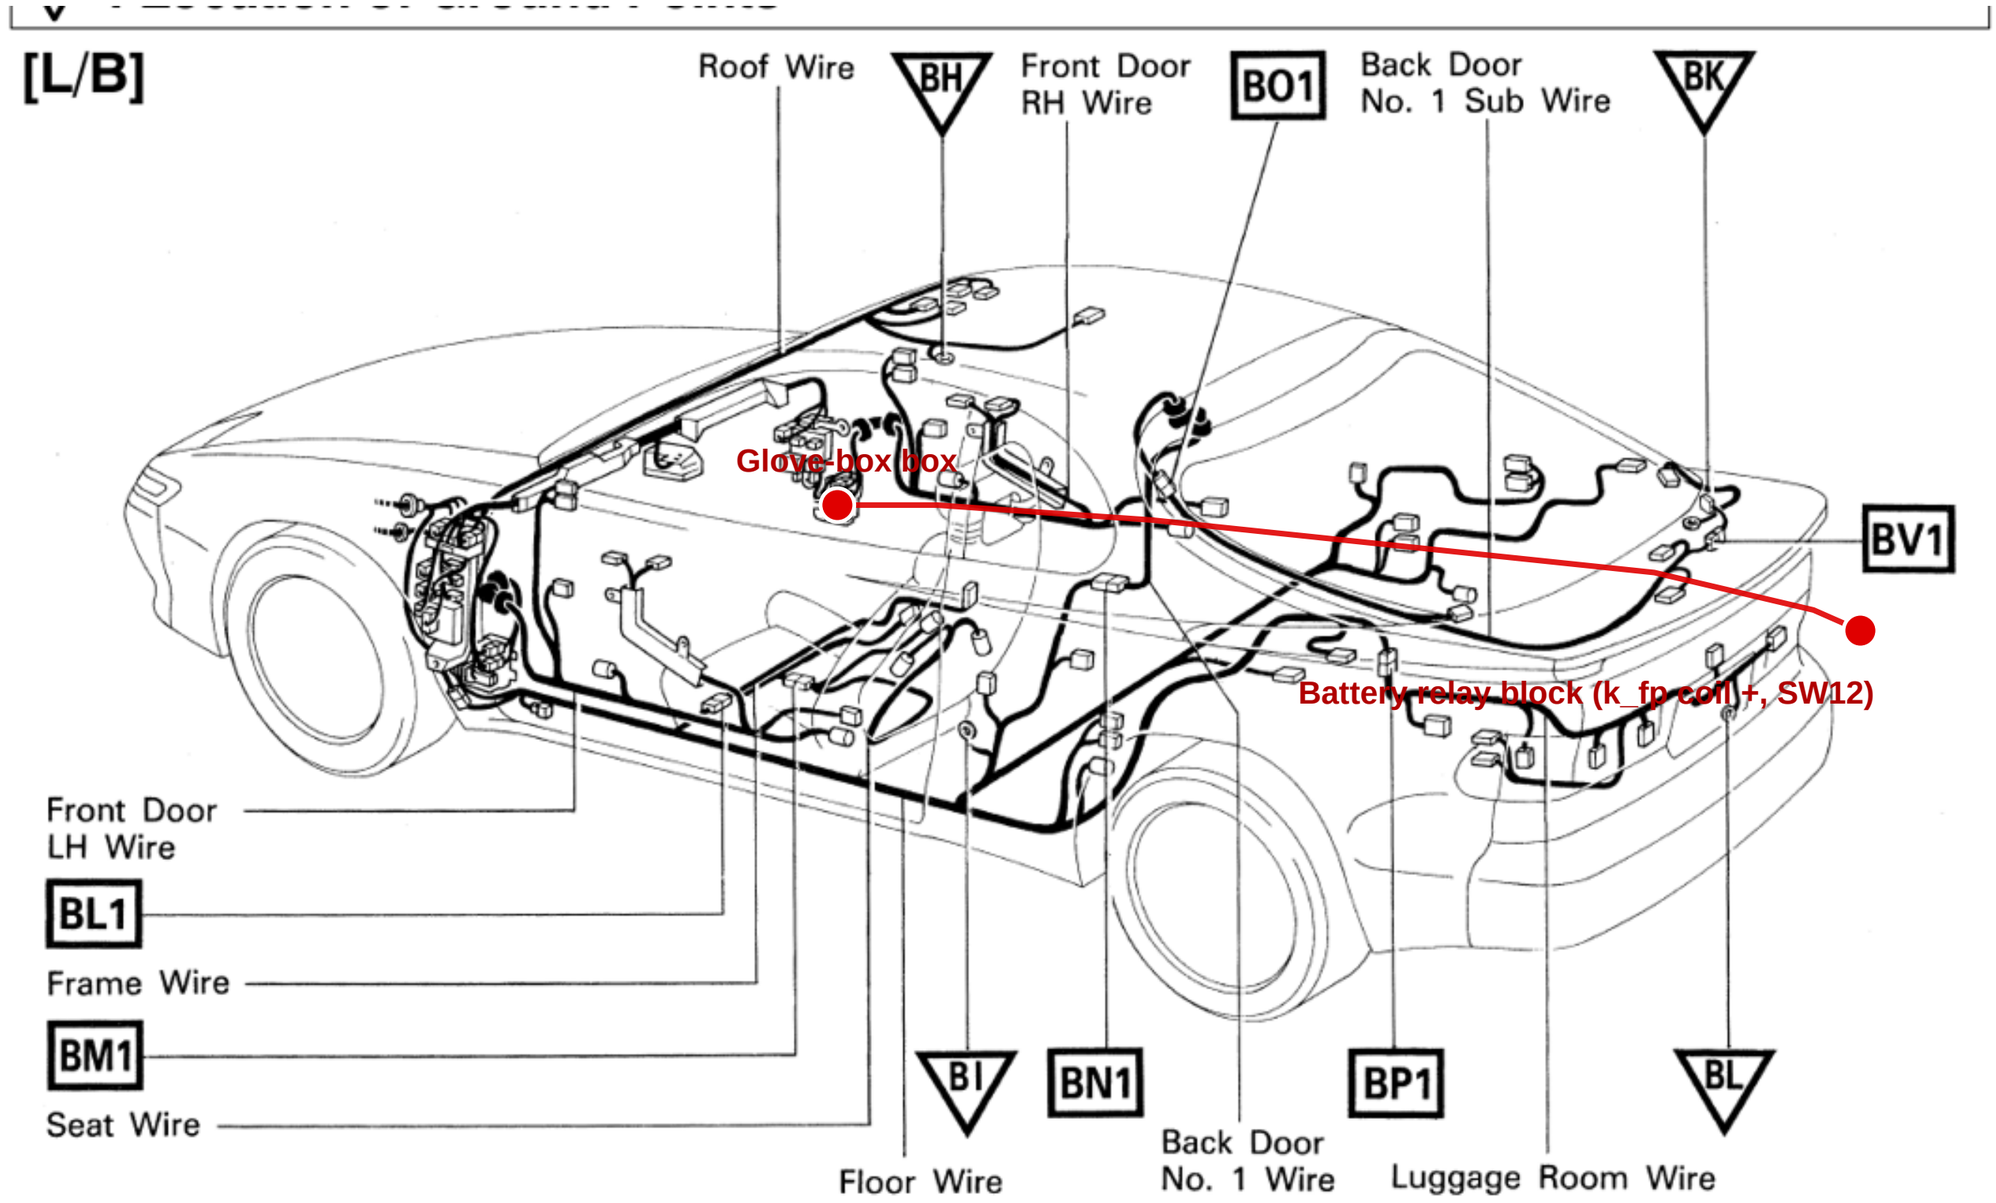

REVISIONS

REV	DATE	BY	DESCRIPTION
C	2026-10-26	DG	A15 lock-sensor input takes a modified tacho: Ign 8 through 4.7 k· to pin 9 (N61 workaround).
D	2026-10-26	DG	Car-check answers: if the ignition-switch black-orange wire is at the engine plug, remove it; A/C s...
E	2026-10-26	DG	C11 is hardware starter interlock only; Aux 8 spare. Oil LED stays on CSB3 L4.
F	2026-10-26	DG	Each grouped section is its own page. A schematic page holds six wires, each in its own line colo...

ST185-harness - every wiring harness of the car, one drawing set

Layout - ST185-CabinPower - ROUTE-7-CABINPOWER


DRAWING NO.	REV	SHEET	SIZE	DRAWN	DATE
ST185-harness-LAY	F	28 OF 65	432 x 279 mm	DG	2026-10-26

ST185 Celica (living-relation) - generated by docs/harness/tools/build_drawings.py from docs/harness/MASTER-wirelist.csv; not to scale

LAYOUT - ST185-CabinPower - ROUTE 7 CABINPOWER, as approved (4 of 4)

Top view for the figure above · same route, same colors. Drawn to match the figure above (approximate); this figure·s part is bright, the rest of the route is faded. Blue squares: B = bulkhead A/B (DRB102, RH firewall), R / L = RH / LH fender pass-throughs (Route 9 rev 2). Top view base: 1993 Celica repair manual RM305U1, Introduction, ·Vehicle Lift and Support Locations·, p. IN·24 (st185-celica-repair-manual\manuals\RM305U1 - Introduction - V...

DRIVER (LH) SIDE

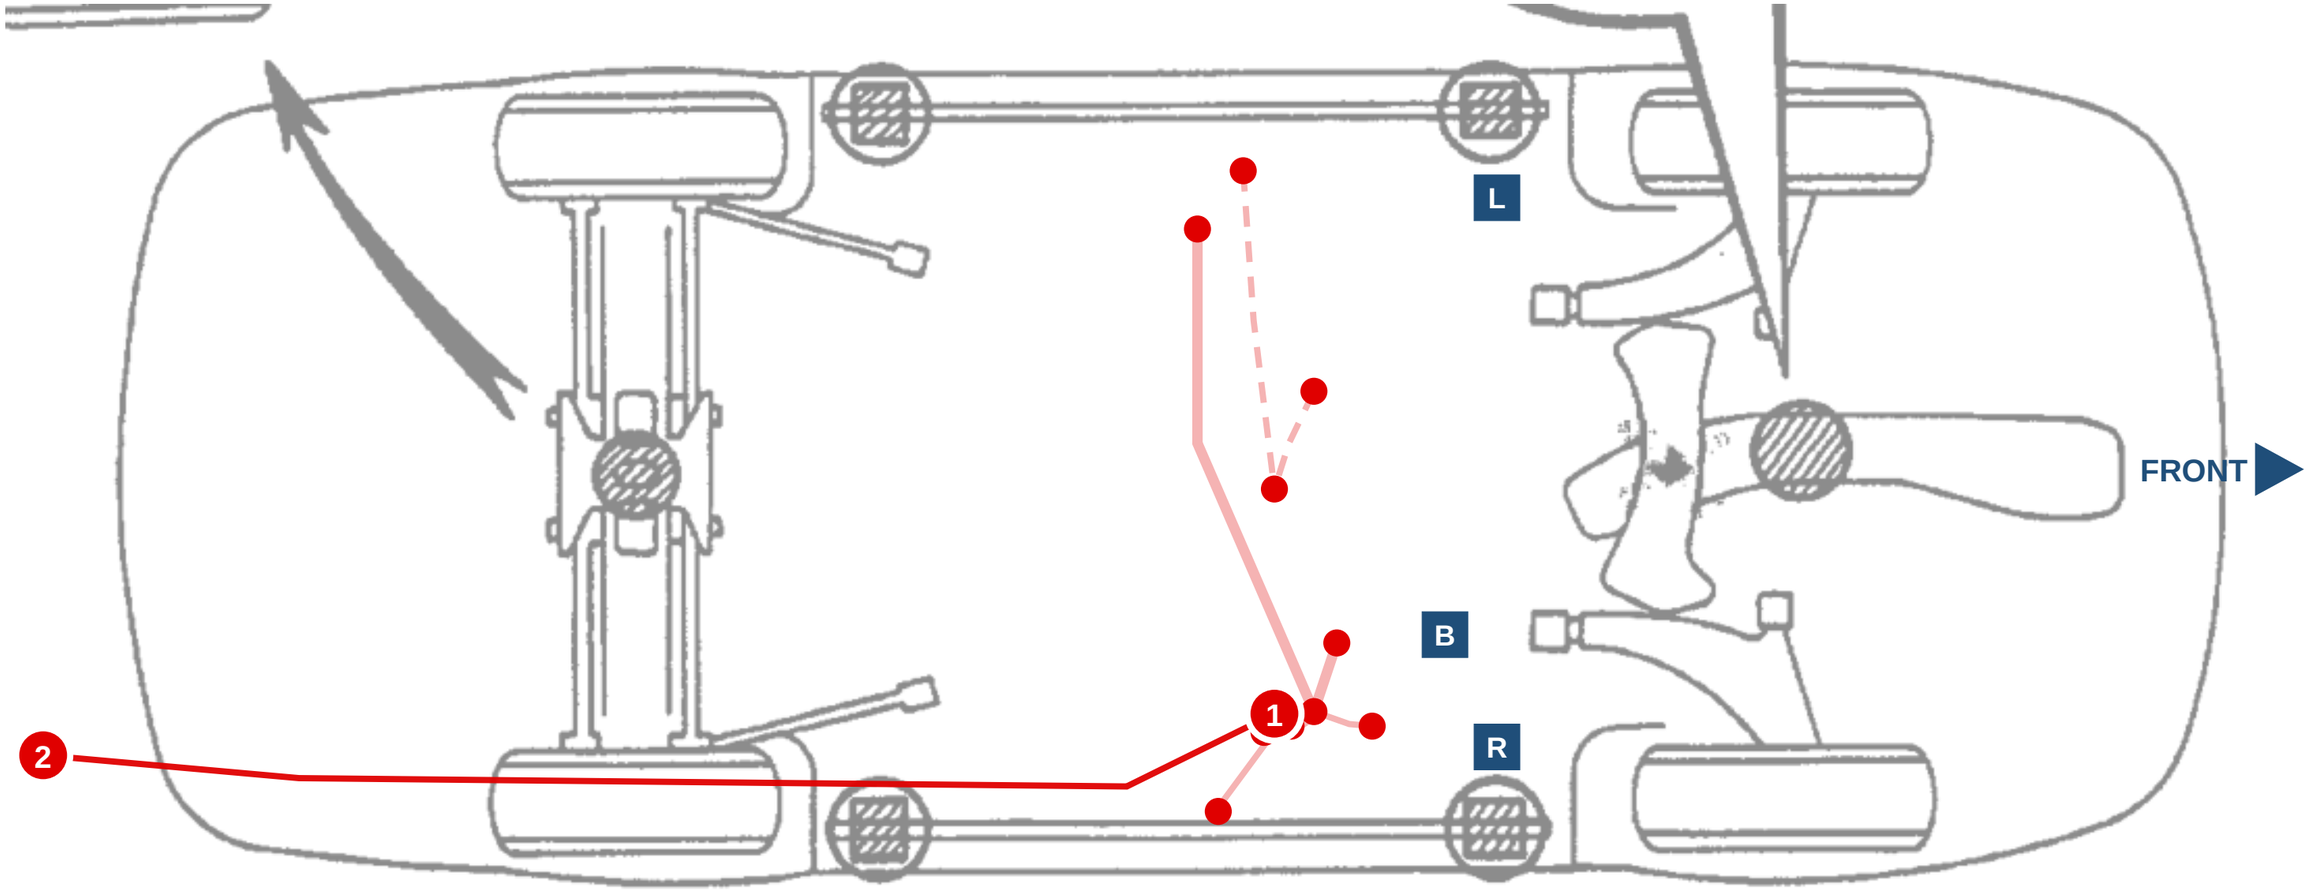

PASSENGER (RH) SIDE

REVISIONS

REV	DATE	BY	DESCRIPTION
C	2026-10-26	DG	A15 lock-sensor input takes a modified tacho: Ign 8 through 4.7 k· to pin 9 (N61 workaround).
D	2026-10-26	DG	Car-check answers: if the ignition-switch black-orange wire is at the engine plug, remove it; A/C s...
E	2026-10-26	DG	C11 is hardware starter interlock only; Aux 8 spare. Oil LED stays on CSB3 L4.
F	2026-10-26	DG	Each grouped section is its own page. A schematic page holds six wires, each in its own line colo...

ST185-harness - every wiring harness of the car, one drawing set


Layout - ST185-CabinPower - ROUTE-7-CABINPOWER

DRAWING NO.	REV	SHEET	SIZE	DRAWN	DATE
ST185-harness-LAY	F	29 OF 65	432 x 279 mm	DG	2026-10-26

ST185 Celica (living-relation) - generated by docs/harness/tools/build_drawings.py from docs/harness/MASTER-wirelist.csv; not to scale

LAYOUT - ST185-EngineRoom-C - ROUTE 2 HARNESS C, as approved (1 of 4)

Fig. C · Rev 4 (Dan·s mark-up): the cabin part now takes the higher path · from the left kick splices up and across under the dash, over the ECU / A/C amp area, to the right side and the glove box; the old low path is dropped. Instrument panel, TIS 1993 EWD ·Relay Locations· p.18 (sheet 1). Cabin side of harness C: the glove-box box · right kick (old R/B4 / R/B3 spots · both relay blocks removed, R12) · under the dash to the left kick (J/B No.1, IE1) ·

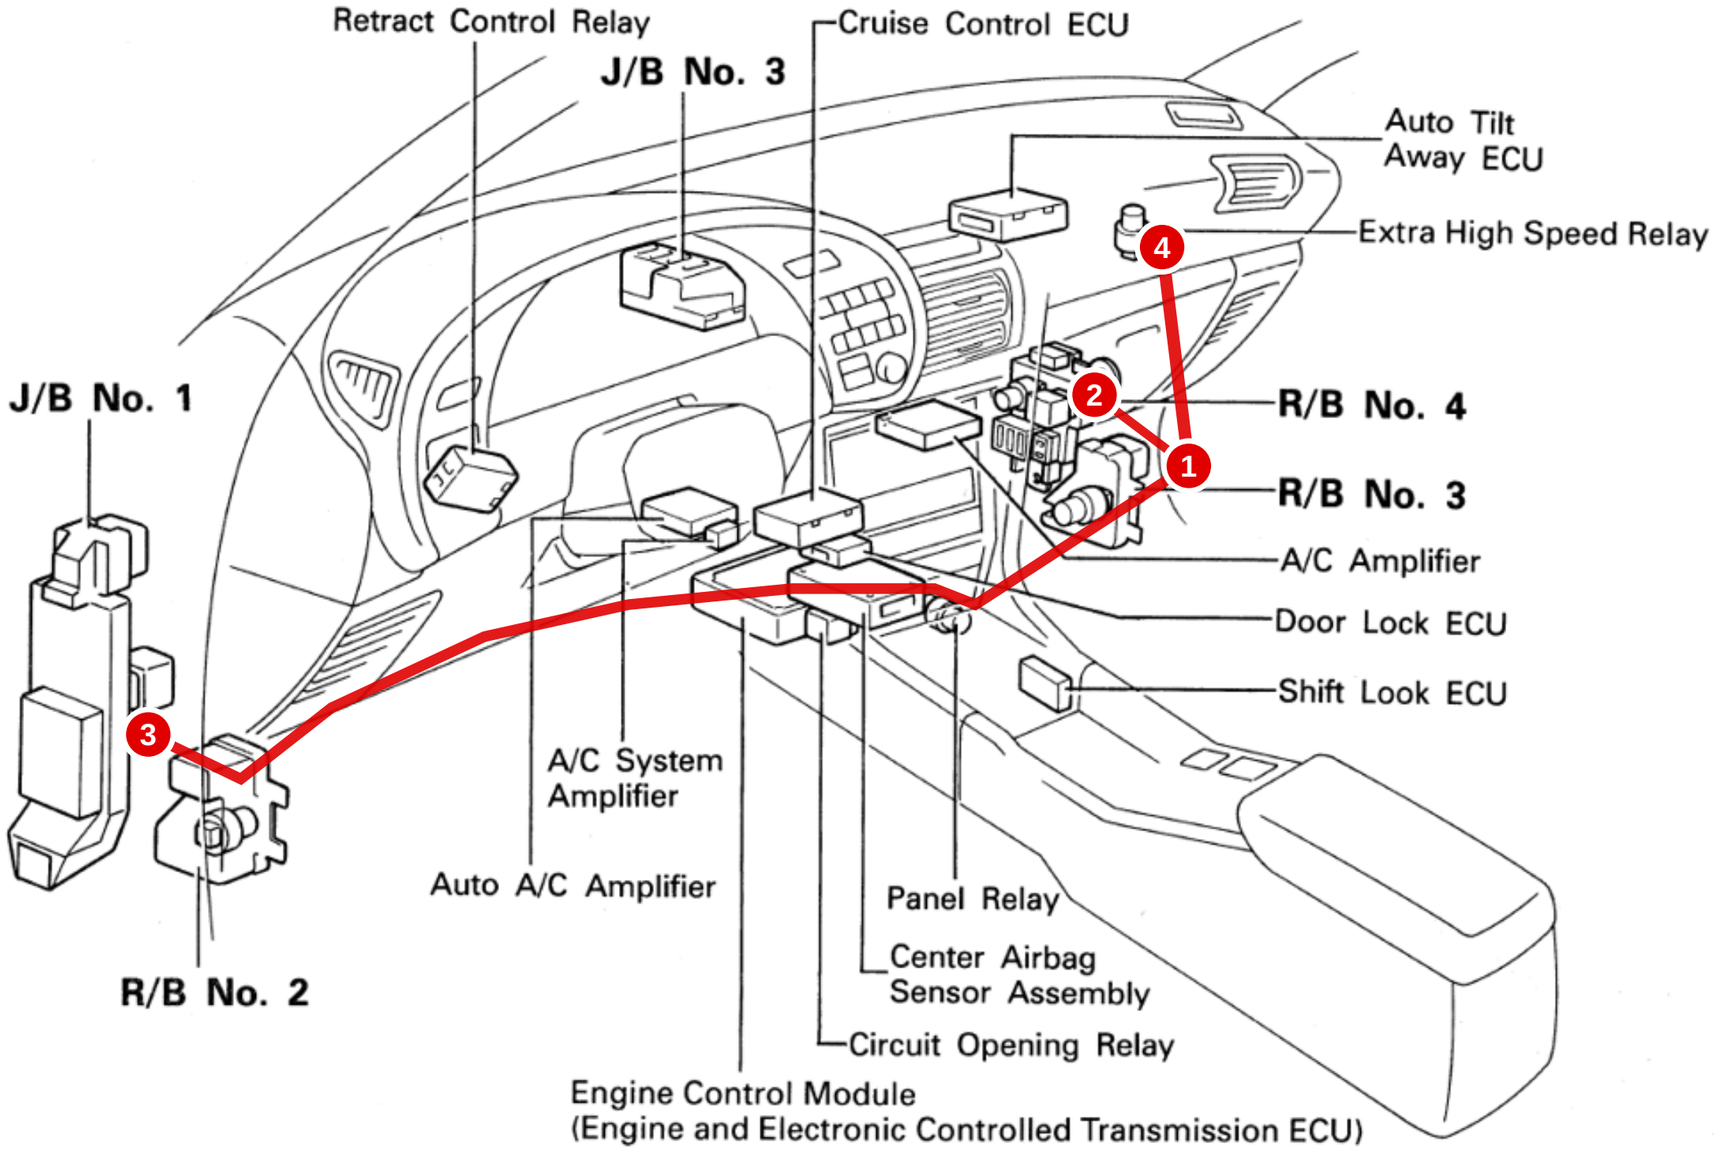

REVISIONS

REV	DATE	BY	DESCRIPTION
C	2026-10-26	DG	A15 lock-sensor input takes a modified tacho: Ign 8 through 4.7 k· to pin 9 (N61 workaround).
D	2026-10-26	DG	Car-check answers: if the ignition-switch black-orange wire is at the engine plug, remove it; A/C s...
E	2026-10-26	DG	C11 is hardware starter interlock only; Aux 8 spare. Oil LED stays on CSB3 L4.
F	2026-10-26	DG	Each grouped section is its own page. A schematic page holds six wires, each in its own line colo...

ST185-harness - every wiring harness of the car, one drawing set

Layout - ST185-EngineRoom-C - ROUTE-2-HARNESS-C


DRAWING NO.	REV	SHEET	SIZE	DRAWN	DATE
ST185-harness-LAY	F	30 OF 65	432 x 279 mm	DG	2026-10-26

ST185 Celica (living-relation) - generated by docs/harness/tools/build_drawings.py from docs/harness/MASTER-wirelist.csv; not to scale

LAYOUT - ST185-EngineRoom-C - ROUTE 2 HARNESS C, as approved (2 of 4)

Top view for the figure above · same route, same colors. Projected from the figure above (approximate); this figure·s part is bright, the rest of the route is faded. Blue squares: B = bulkhead A/B (DRB102, RH firewall), R / L = RH / LH fender pass-throughs (Route 9 rev 2). Top view base: 1993 Celica repair manual RM305U1, Introduction, ·Vehicle Lift and Support Locations·, p. IN·24 (st185-celica-repair-manual\manuals\RM305U1 - Introduction - Ve...

DRIVER (LH) SIDE

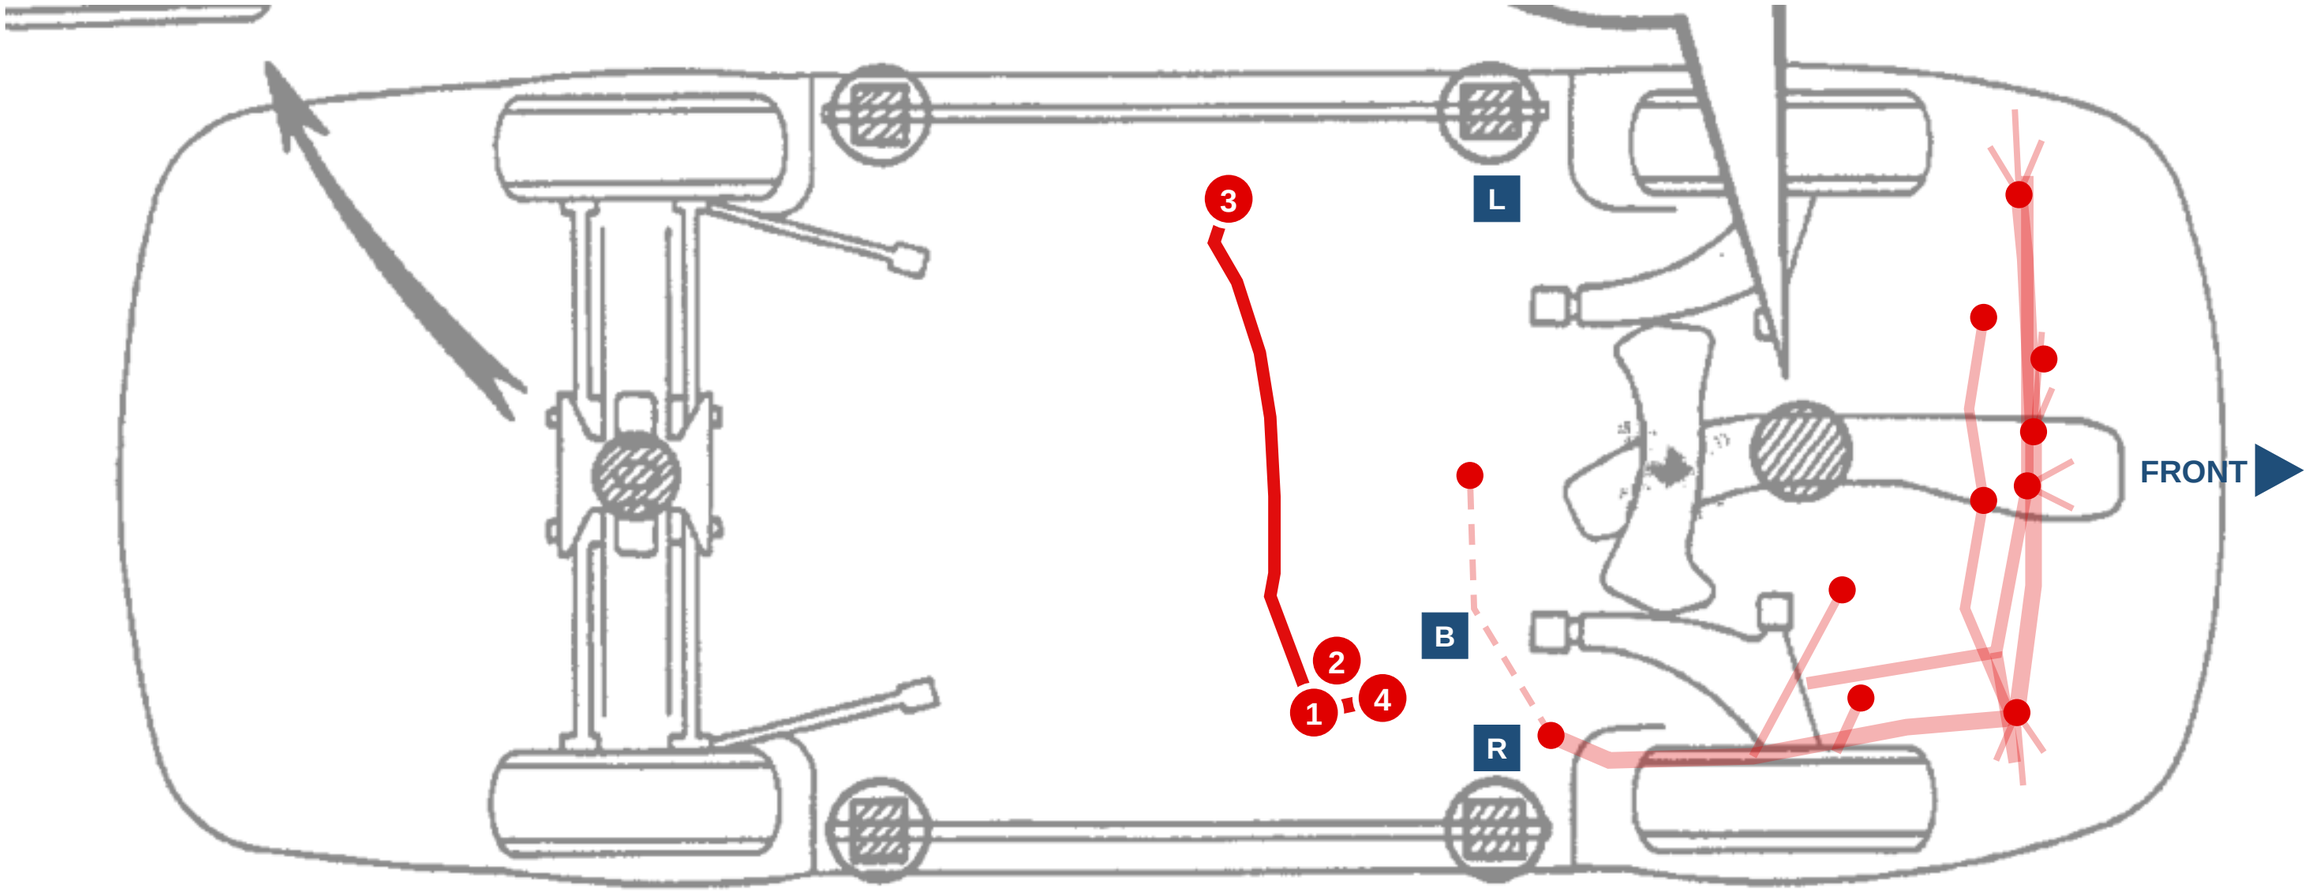

PASSENGER (RH) SIDE

REVISIONS

REV	DATE	BY	DESCRIPTION
C	2026-10-26	DG	A15 lock-sensor input takes a modified tacho: Ign 8 through 4.7 k· to pin 9 (N61 workaround).
D	2026-10-26	DG	Car-check answers: if the ignition-switch black-orange wire is at the engine plug, remove it; A/C s...
E	2026-10-26	DG	C11 is hardware starter interlock only; Aux 8 spare. Oil LED stays on CSB3 L4.
F	2026-10-26	DG	Each grouped section is its own page. A schematic page holds six wires, each in its own line colo...

ST185-harness - every wiring harness of the car, one drawing set


Layout - ST185-EngineRoom-C - ROUTE-2-HARNESS-C

DRAWING NO.	REV	SHEET	SIZE	DRAWN	DATE
ST185-harness-LAY	F	31 OF 65	432 x 279 mm	DG	2026-10-26

ST185 Celica (living-relation) - generated by docs/harness/tools/build_drawings.py from docs/harness/MASTER-wirelist.csv; not to scale

LAYOUT - ST185-EngineRoom-C - ROUTE 2 HARNESS C, as approved (3 of 4)

Fig. B · Rev 8 (Dan·s mark-up): the fan branch now leaves the main run near the RH front corner (15) and runs to the condenser fan (9) then on to the radiator fan (10); the branch from the upper fender run is removed. Horns are custom-wired: no OEM horn leads or connectors; a short horn branch (8) splits to a DT 2-way at each horn (17). Rev 7 (Dan·s mark-up): no IX_HEAD hub. The main run passes each front corner and short branches d...

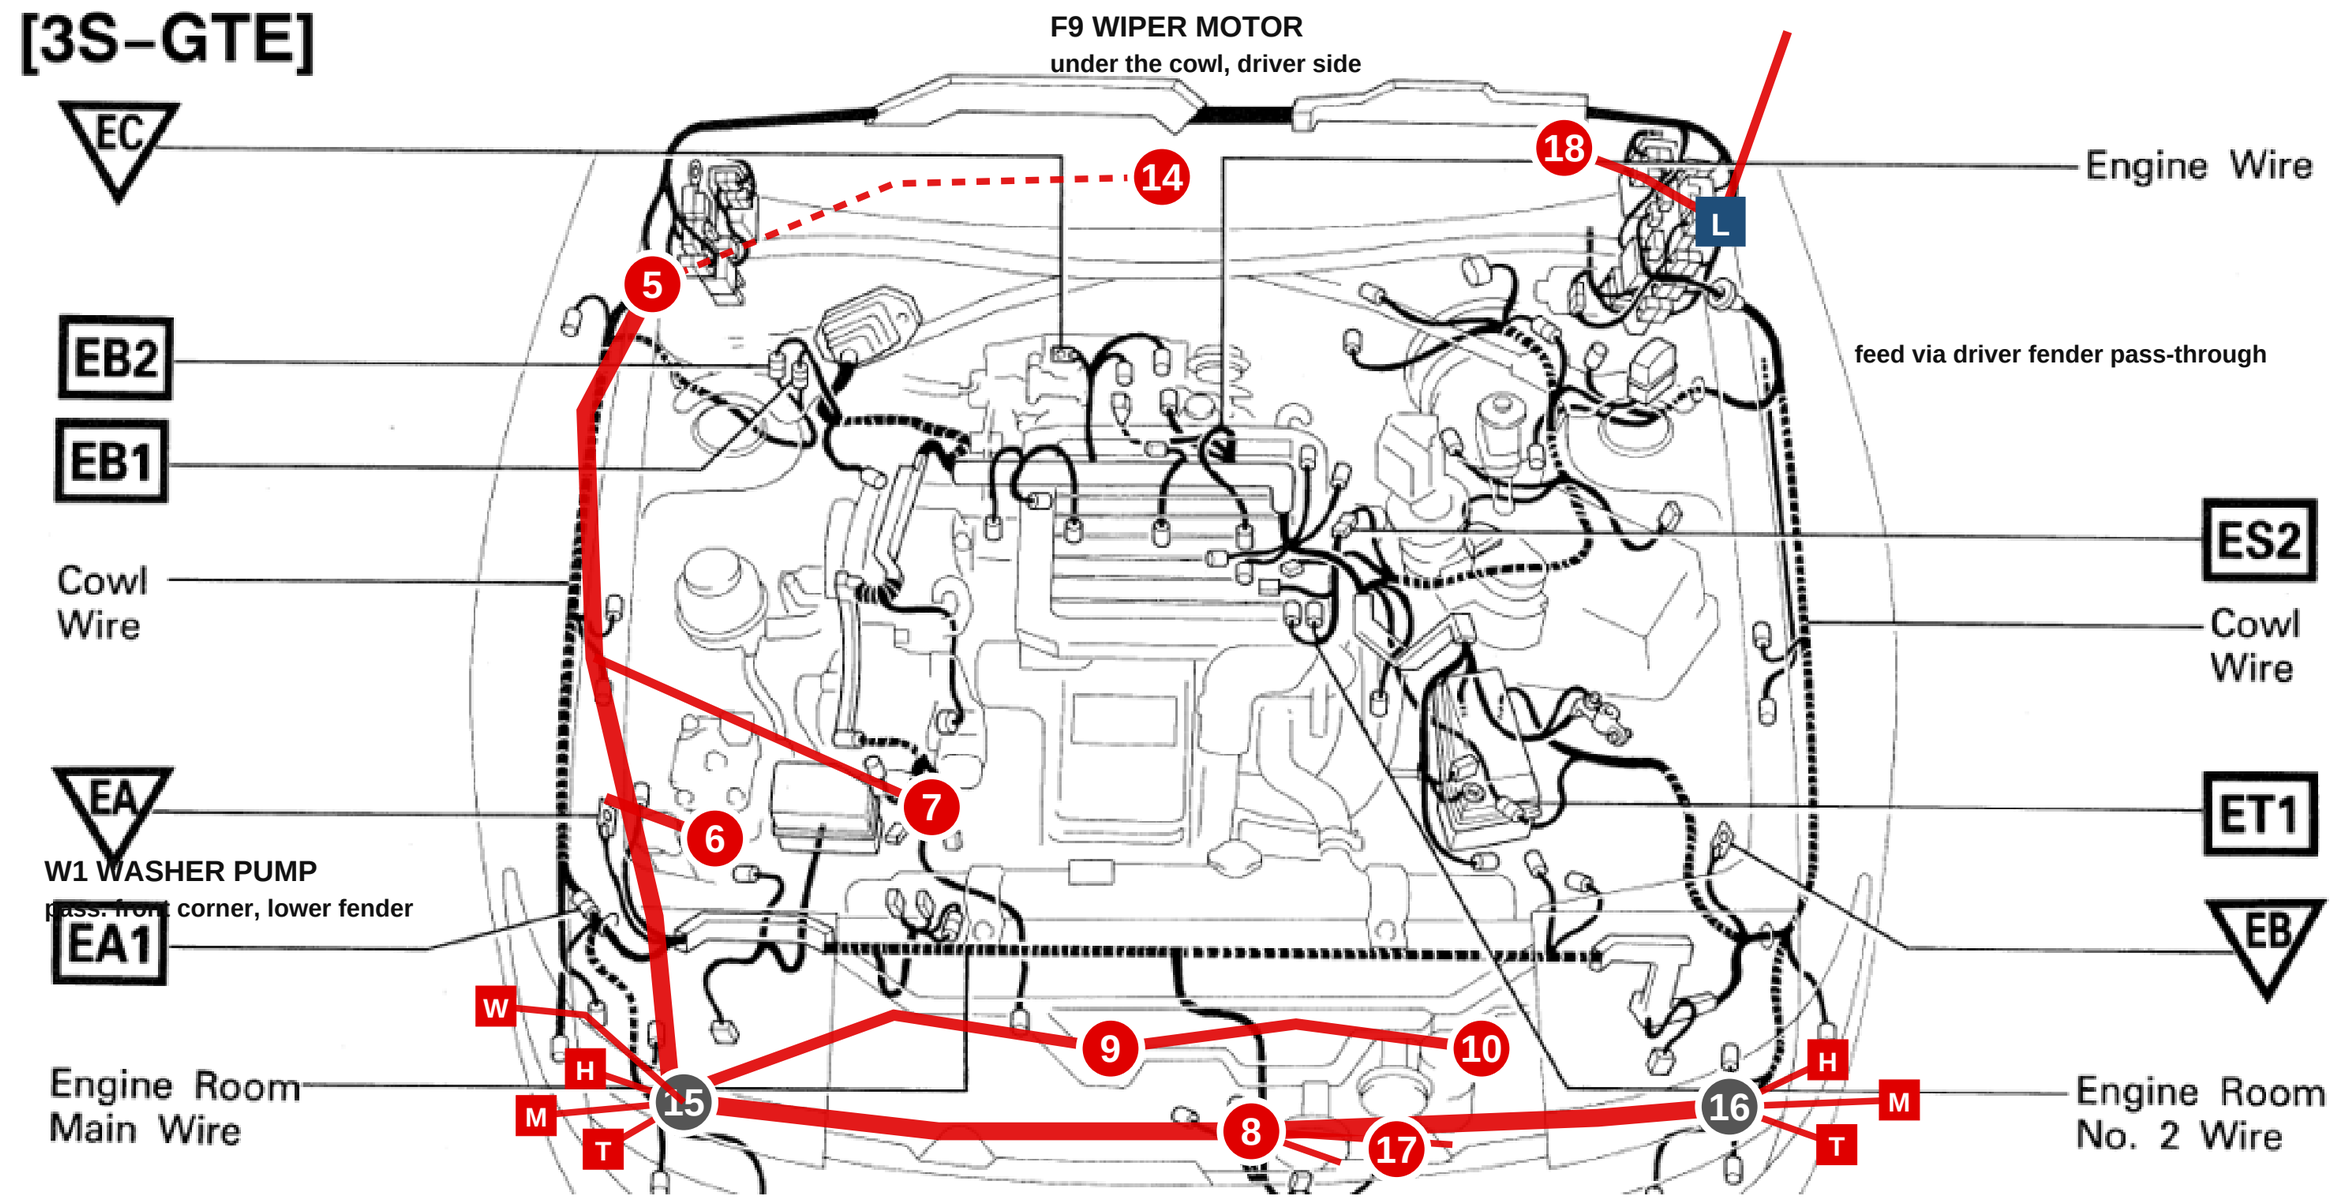

REVISIONS

REV	DATE	BY	DESCRIPTION
C	2026-10-26	DG	A15 lock-sensor input takes a modified tacho: Ign 8 through 4.7 k· to pin 9 (N61 workaround).
D	2026-10-26	DG	Car-check answers: if the ignition-switch black-orange wire is at the engine plug, remove it; A/C s...
E	2026-10-26	DG	C11 is hardware starter interlock only; Aux 8 spare. Oil LED stays on CSB3 L4.
F	2026-10-26	DG	Each grouped section is its own page. A schematic page holds six wires, each in its own line colo...

ST185-harness - every wiring harness of the car, one drawing set

Layout - ST185-EngineRoom-C - ROUTE-2-HARNESS-C


DRAWING NO.	REV	SHEET	SIZE	DRAWN	DATE
ST185-harness-LAY	F	32 OF 65	432 x 279 mm	DG	2026-10-26

ST185 Celica (living-relation) - generated by docs/harness/tools/build_drawings.py from docs/harness/MASTER-wirelist.csv; not to scale

LAYOUT - ST185-EngineRoom-C - ROUTE 2 HARNESS C, as approved (4 of 4)

Top view for the figure above · same route, same colors. Projected from the figure above (approximate); this figure·s part is bright, the rest of the route is faded. Blue squares: B = bulkhead A/B (DRB102, RH firewall), R / L = RH / LH fender pass-throughs (Route 9 rev 2). Top view base: 1993 Celica repair manual RM305U1, Introduction, ·Vehicle Lift and Support Locations·, p. IN·24 (st185-celica-repair-manual\manuals\RM305U1 - Introduction - Ve...

DRIVER (LH) SIDE

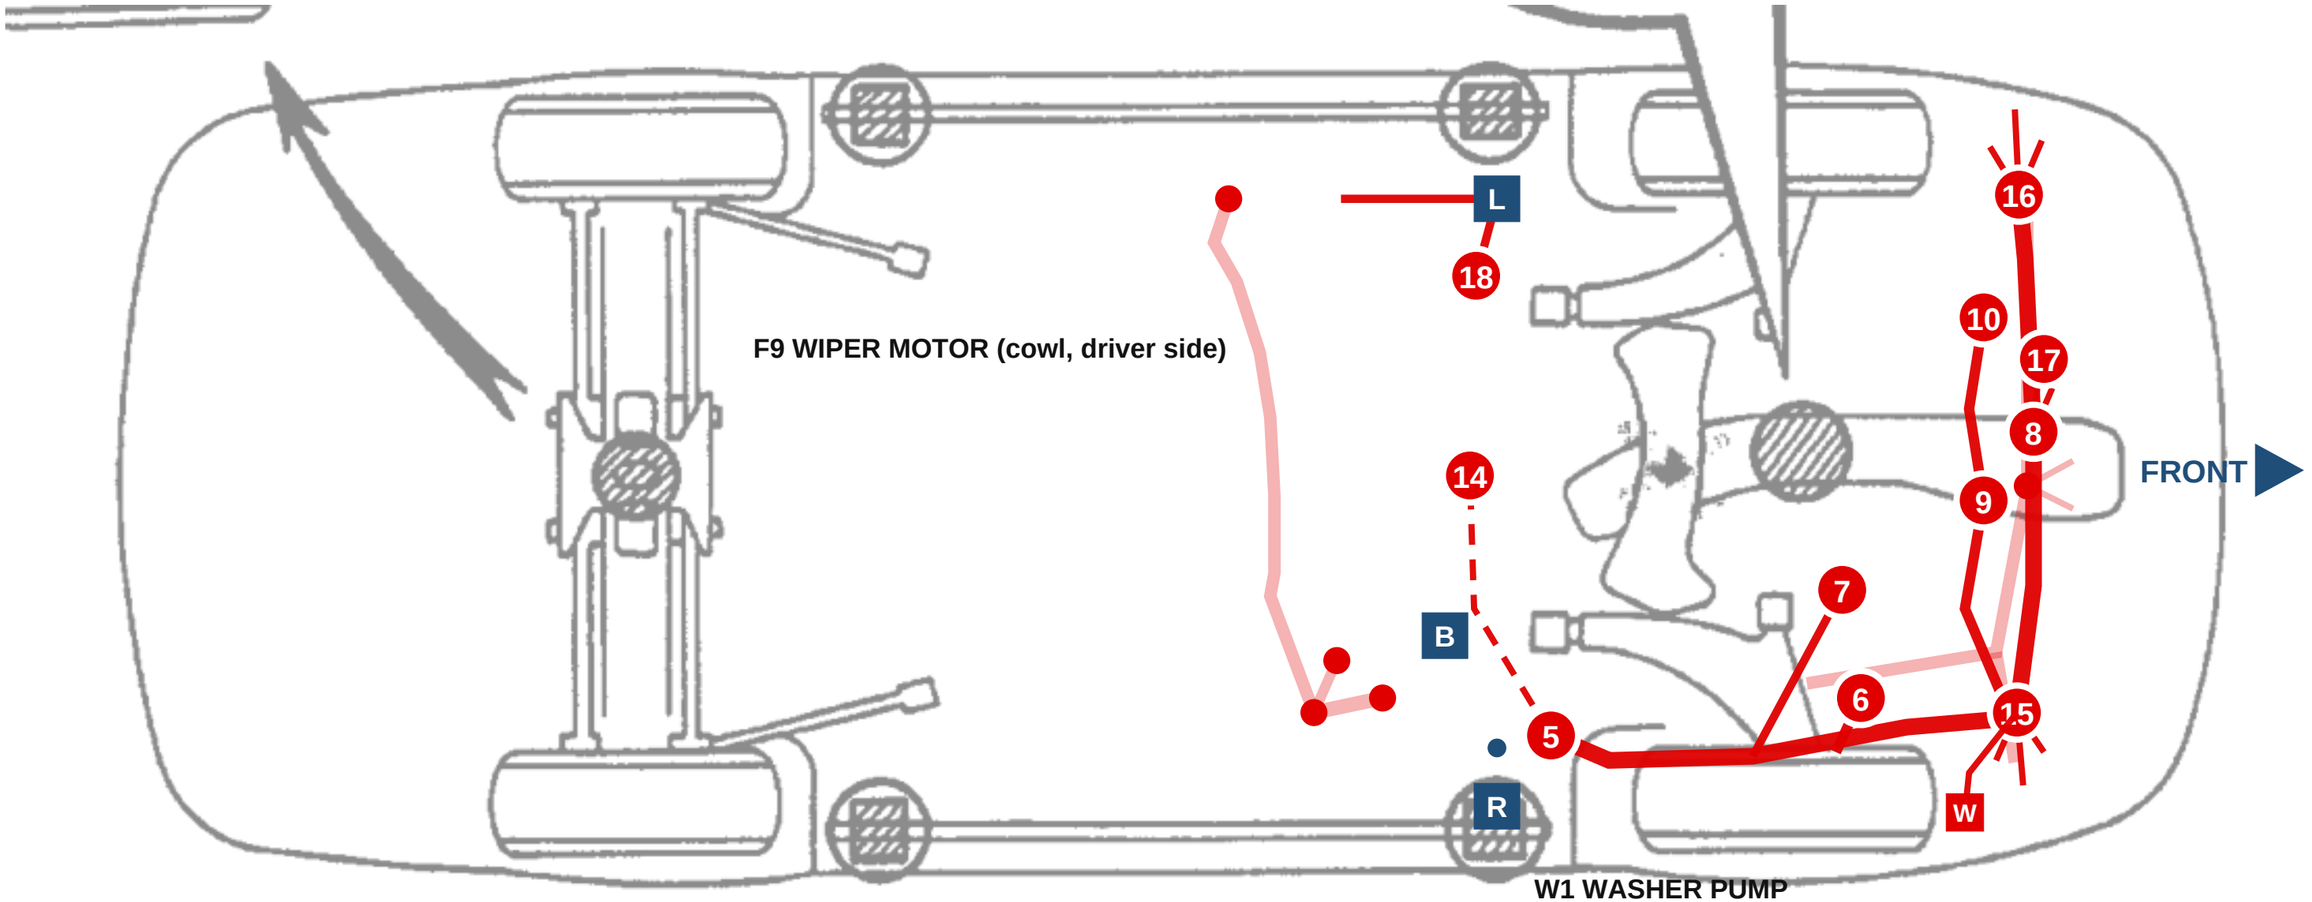

PASSENGER (RH) SIDE

REVISIONS			
REV	**DATE**	**BY**	**DESCRIPTION**
C	2026-10-26	DG	A15 lock-sensor input takes a modified tacho: Ign 8 through 4.7 k· to pin 9 (N61 workaround).
D	2026-10-26	DG	Car-check answers: if the ignition-switch black-orange wire is at the engine plug, remove it; A/C s...
E	2026-10-26	DG	C11 is hardware starter interlock only; Aux 8 spare. Oil LED stays on CSB3 L4.
F	2026-10-26	DG	Each grouped section is its own page. A schematic page holds six wires, each in its own line colo...

ST185-harness - every wiring harness of the car, one drawing set

Layout - ST185-EngineRoom-C - ROUTE-2-HARNESS-C

DRAWING NO.	REV	SHEET	SIZE	DRAWN	DATE
ST185-harness-LAY	F	33 OF 65	432 x 279 mm	DG	2026-10-26

ST185 Celica (living-relation) - generated by docs/harness/tools/build_drawings.py from docs/harness/MASTER-wirelist.csv; not to scale


LAYOUT - ST185-EngineRoom-C - ROUTE 17 FRONT, as approved (1 of 1)

1993 EWD book p.36 (3S-GTE engine compartment); PDF points of Connector__Ground_and_Splice.pdf page 1 (st185-celica-repair-manual).


ELECTRICAL WIRING ROUTING

▭ : Location of Connector Joining Wire Harness and Wire Harness

▽ : Location of Ground Points

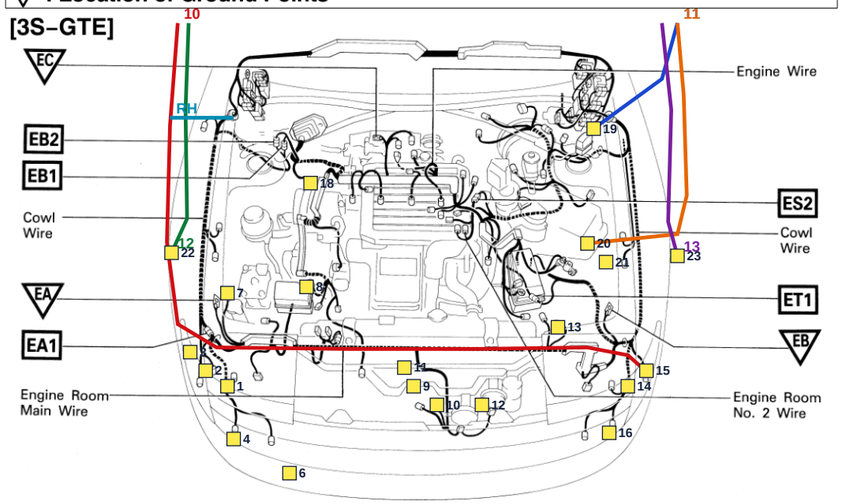

○ : Location of Splice Points

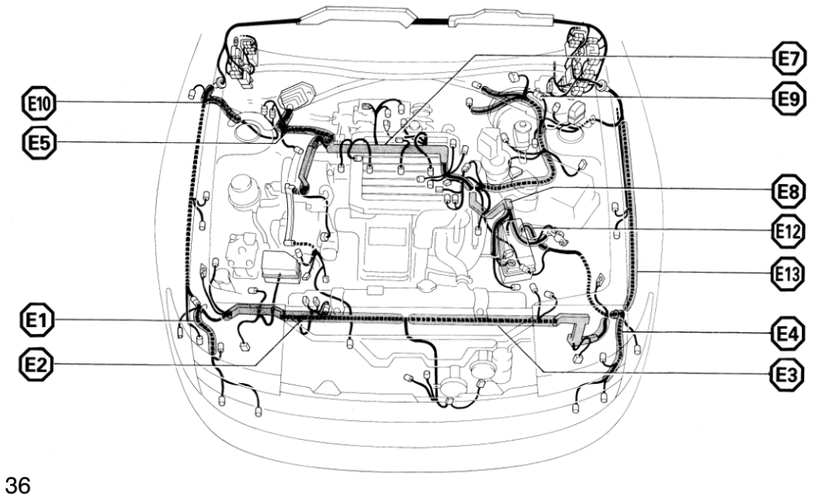

APPROVED LINES

- 10 Front run
- 11 Driver fender run (wiper)
- 11 Driver fender run (siren branch)
- 12 Wheel-speed RH
- 13 Wheel-speed LH
- RH fender grommet

DEVICES

1 RH headlight
2 RH pop-up motor
3 Washer pump
4 RH turn + clearance
6 Oil temp sensor (front oil cooler)
7 MR-S EPS pump (old ABS actuator spot)
8 A/C compressor clutch
9 Condenser fan
10 Ambient air temp sensor
11 Alarm hood pin
12 Horns (2)
13 Radiator fan
14 LH headlight
15 LH pop-up motor
16 LH turn + clearance
18 A/C dual pressure switch (via RH fender grommet)
19 Wiper motor (driver fender run)
20 Alarm siren (old battery spot)
21 Jump studs (OPTIONAL, owning harness open)
22 RH front wheel speed sensor (own harness to VRC / ECU)
23 LH front wheel speed sensor (own harness to VRC / ECU)

REVISIONS

REV	DATE	BY	DESCRIPTION
C	2026-10-26	DG	A15 lock-sensor input takes a modified tacho: Ign 8 through 4.7 k· to pin 9 (N61 workaround).
D	2026-10-26	DG	Car-check answers: if the ignition-switch black-orange wire is at the engine plug, remove it; A/C s...
E	2026-10-26	DG	C11 is hardware starter interlock only; Aux 8 spare. Oil LED stays on CSB3 L4.
F	2026-10-26	DG	Each grouped section is its own page. A schematic page holds six wires, each in its own line colo...

ST185-harness - every wiring harness of the car, one drawing set


Layout - ST185-EngineRoom-C - ROUTE-17-FRONT

DRAWING NO.	REV	SHEET	SIZE	DRAWN	DATE
ST185-harness-LAY	F	34 OF 65	432 x 279 mm	DG	2026-10-26

ST185 Celica (living-relation) - generated by docs/harness/tools/build_drawings.py from docs/harness/MASTER-wirelist.csv; not to scale

LAYOUT - ST185-HeavyDC - ROUTE 1 HEAVYDC, as approved (1 of 7)

Fig. 1 · Rev 4 (Dan): battery box moved to the passenger-side rear corner of the trunk (far side in this view, approximate); H1/H2 rerouted from there. Body, liftback, TIS 1993 EWD ·Electrical Wiring Routing· p.46 (st185-celica-repair-manual: electrical/circuits/tis1993-wiring-routing-2.pdf, sheet 11). Car front is at left; the near side is the driver (LH) side. The red line runs on the far (passenger, RH) side, so it is drawn approximately on this perspec...

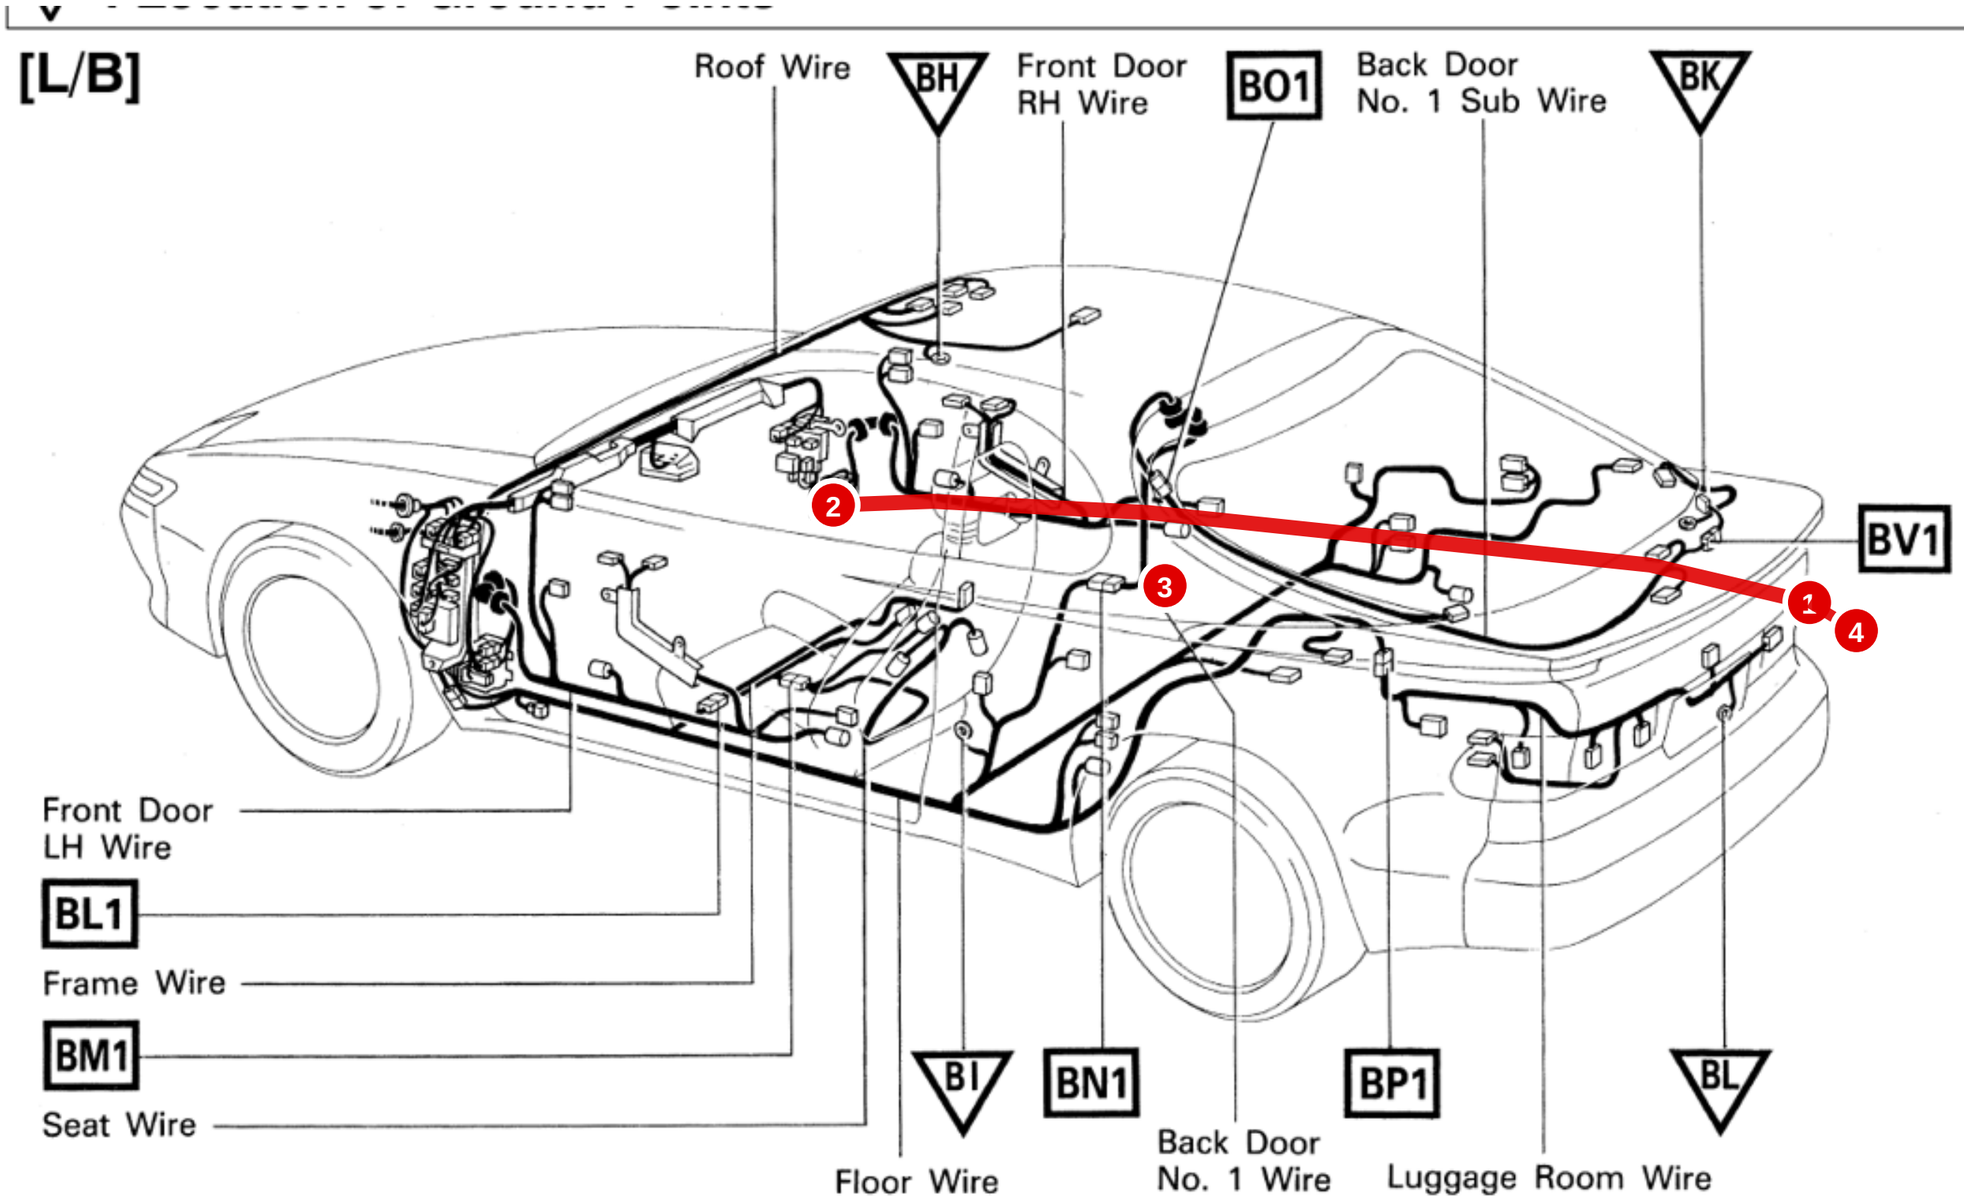

REVISIONS

REV	DATE	BY	DESCRIPTION
C	2026-10-26	DG	A15 lock-sensor input takes a modified tacho: Ign 8 through 4.7 k· to pin 9 (N61 workaround).
D	2026-10-26	DG	Car-check answers: if the ignition-switch black-orange wire is at the engine plug, remove it; A/C s...
E	2026-10-26	DG	C11 is hardware starter interlock only; Aux 8 spare. Oil LED stays on CSB3 L4.
F	2026-10-26	DG	Each grouped section is its own page. A schematic page holds six wires, each in its own line colo...

ST185-harness - every wiring harness of the car, one drawing set

Layout - ST185-HeavyDC - ROUTE-1-HEAVYDC


DRAWING NO.	REV	SHEET	SIZE	DRAWN	DATE
ST185-harness-LAY	F	35 OF 65	432 x 279 mm	DG	2026-10-26

ST185 Celica (living-relation) - generated by docs/harness/tools/build_drawings.py from docs/harness/MASTER-wirelist.csv; not to scale

LAYOUT - ST185-HeavyDC - ROUTE 1 HEAVYDC, as approved (2 of 7)

Top view for the figure above · same route, same colors. Drawn to match the figure above (approximate); this figure·s part is bright, the rest of the route is faded. Blue squares: B = bulkhead A/B (DRB102, RH firewall), R / L = RH / LH fender pass-throughs (Route 9 rev 2). Top view base: 1993 Celica repair manual RM305U1, Introduction, ·Vehicle Lift and Support Locations·, p. IN·24 (st185-celica-repair-manual\manuals\RM305U1 - Introduction - V...

DRIVER (LH) SIDE

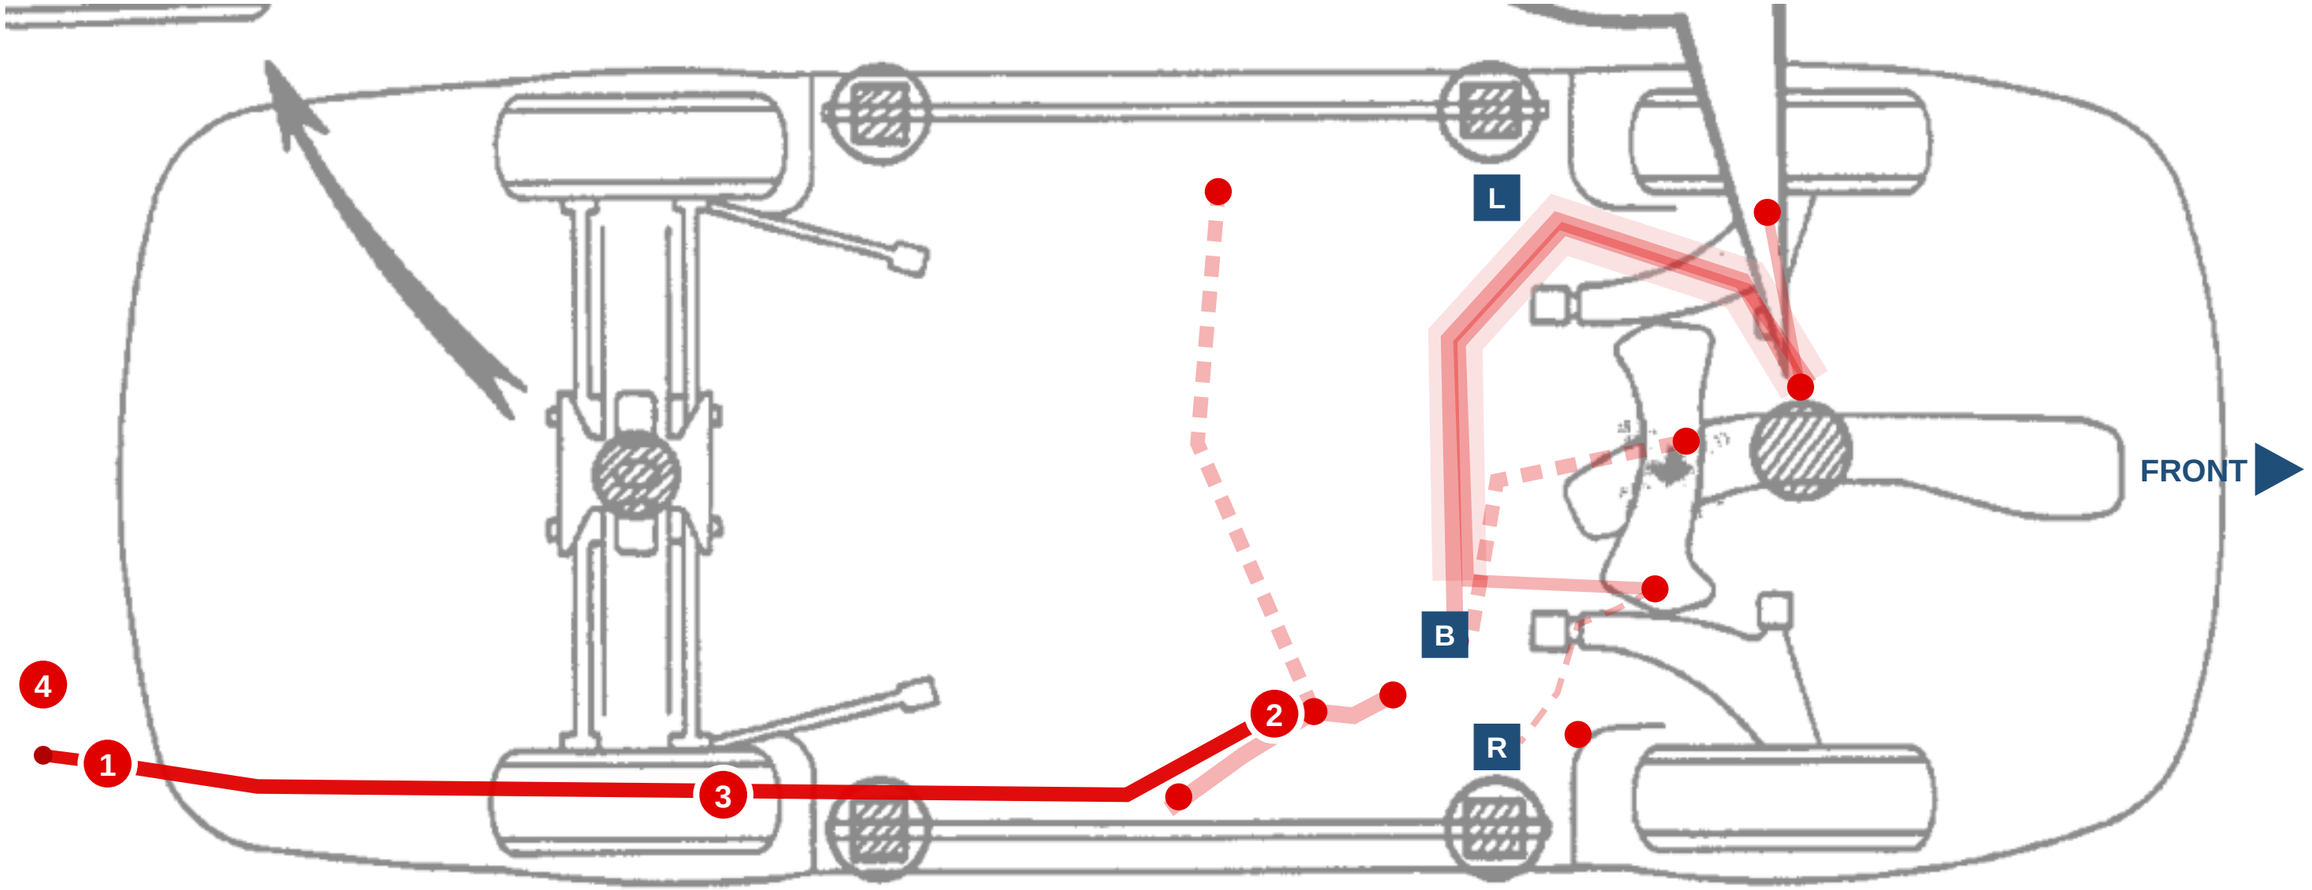

PASSENGER (RH) SIDE

REVISIONS

REV	DATE	BY	DESCRIPTION
C	2026-10-26	DG	A15 lock-sensor input takes a modified tacho: Ign 8 through 4.7 k· to pin 9 (N61 workaround).
D	2026-10-26	DG	Car-check answers: if the ignition-switch black-orange wire is at the engine plug, remove it; A/C s...
E	2026-10-26	DG	C11 is hardware starter interlock only; Aux 8 spare. Oil LED stays on CSB3 L4.
F	2026-10-26	DG	Each grouped section is its own page. A schematic page holds six wires, each in its own line colo...

ST185-harness - every wiring harness of the car, one drawing set


Layout - ST185-HeavyDC - ROUTE-1-HEAVYDC

DRAWING NO.	REV	SHEET	SIZE	DRAWN	DATE
ST185-harness-LAY	F	36 OF 65	432 x 279 mm	DG	2026-10-26

ST185 Celica (living-relation) - generated by docs/harness/tools/build_drawings.py from docs/harness/MASTER-wirelist.csv; not to scale

LAYOUT - ST185-HeavyDC - ROUTE 1 HEAVYDC, as approved (3 of 7)

Fig. 2 · Instrument panel, TIS 1993 EWD ·Relay Locations· p.18 (tis1993-relay-locations.pdf, sheet 1). R/B No.4 / No.3 mark the right kick panel; J/B No.1 / R/B No.2 the left kick. Solid = +, dashed = ground. The exact POWER box mount spot in the glove box is still to be measured. Deleted parts still drawn on this factory page: Circuit Opening Relay, Center Airbag Sensor, Cruise Control ECU · not used.

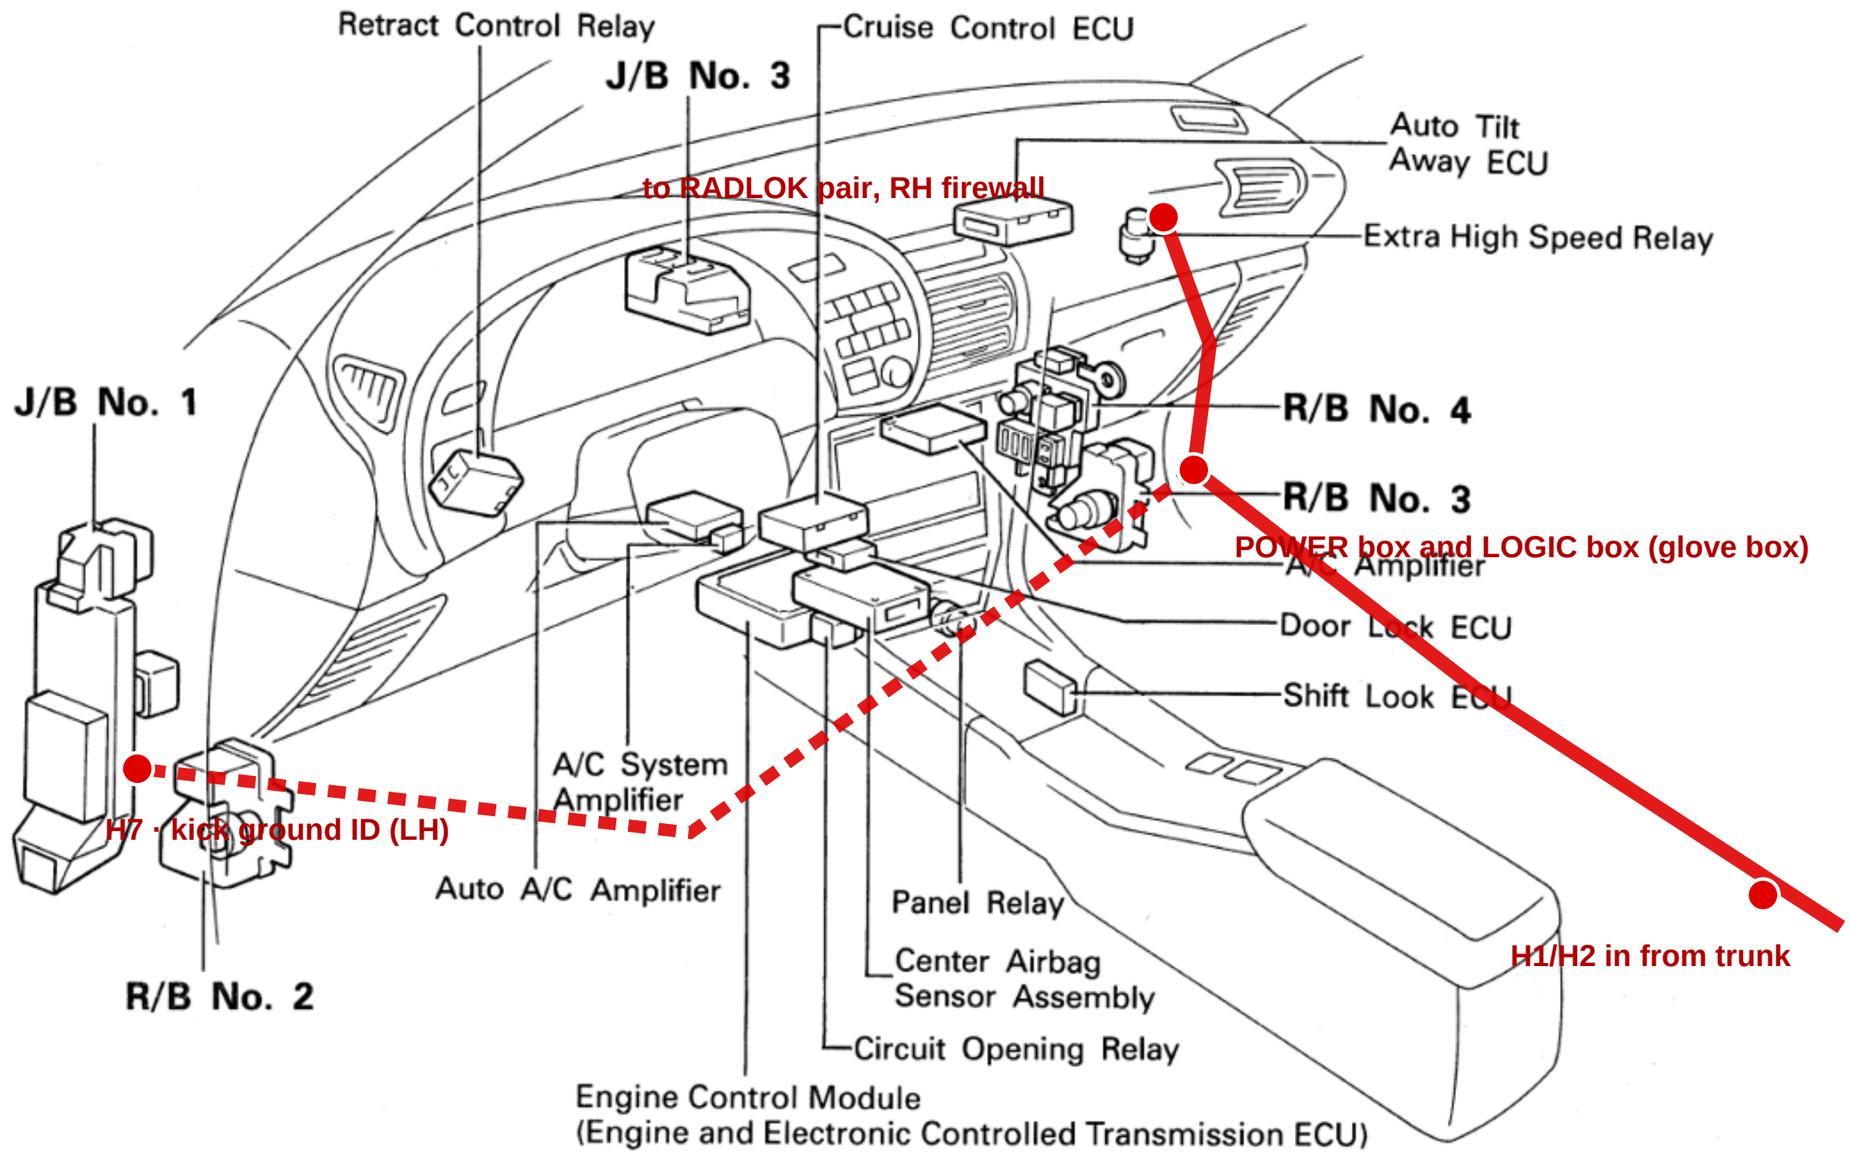

REVISIONS

REV	DATE	BY	DESCRIPTION
C	2026-10-26	DG	A15 lock-sensor input takes a modified tacho: Ign 8 through 4.7 k· to pin 9 (N61 workaround).
D	2026-10-26	DG	Car-check answers: if the ignition-switch black-orange wire is at the engine plug, remove it; A/C s...
E	2026-10-26	DG	C11 is hardware starter interlock only; Aux 8 spare. Oil LED stays on CSB3 L4.
F	2026-10-26	DG	Each grouped section is its own page. A schematic page holds six wires, each in its own line colo...

ST185-harness - every wiring harness of the car, one drawing set


Layout - ST185-HeavyDC - ROUTE-1-HEAVYDC

DRAWING NO.	REV	SHEET	SIZE	DRAWN	DATE
ST185-harness-LAY	F	37 OF 65	432 x 279 mm	DG	2026-10-26

ST185 Celica (living-relation) - generated by docs/harness/tools/build_drawings.py from docs/harness/MASTER-wirelist.csv; not to scale

LAYOUT - ST185-HeavyDC - ROUTE 1 HEAVYDC, as approved (4 of 7)

Top view for the figure above · same route, same colors. Projected from the figure above (approximate); this figure·s part is bright, the rest of the route is faded. Blue squares: B = bulkhead A/B (DRB102, RH firewall), R / L = RH / LH fender pass-throughs (Route 9 rev 2). Top view base: 1993 Celica repair manual RM305U1, Introduction, ·Vehicle Lift and Support Locations·, p. IN·24 (st185-celica-repair-manual\manuals\RM305U1 - Introduction - Ve...

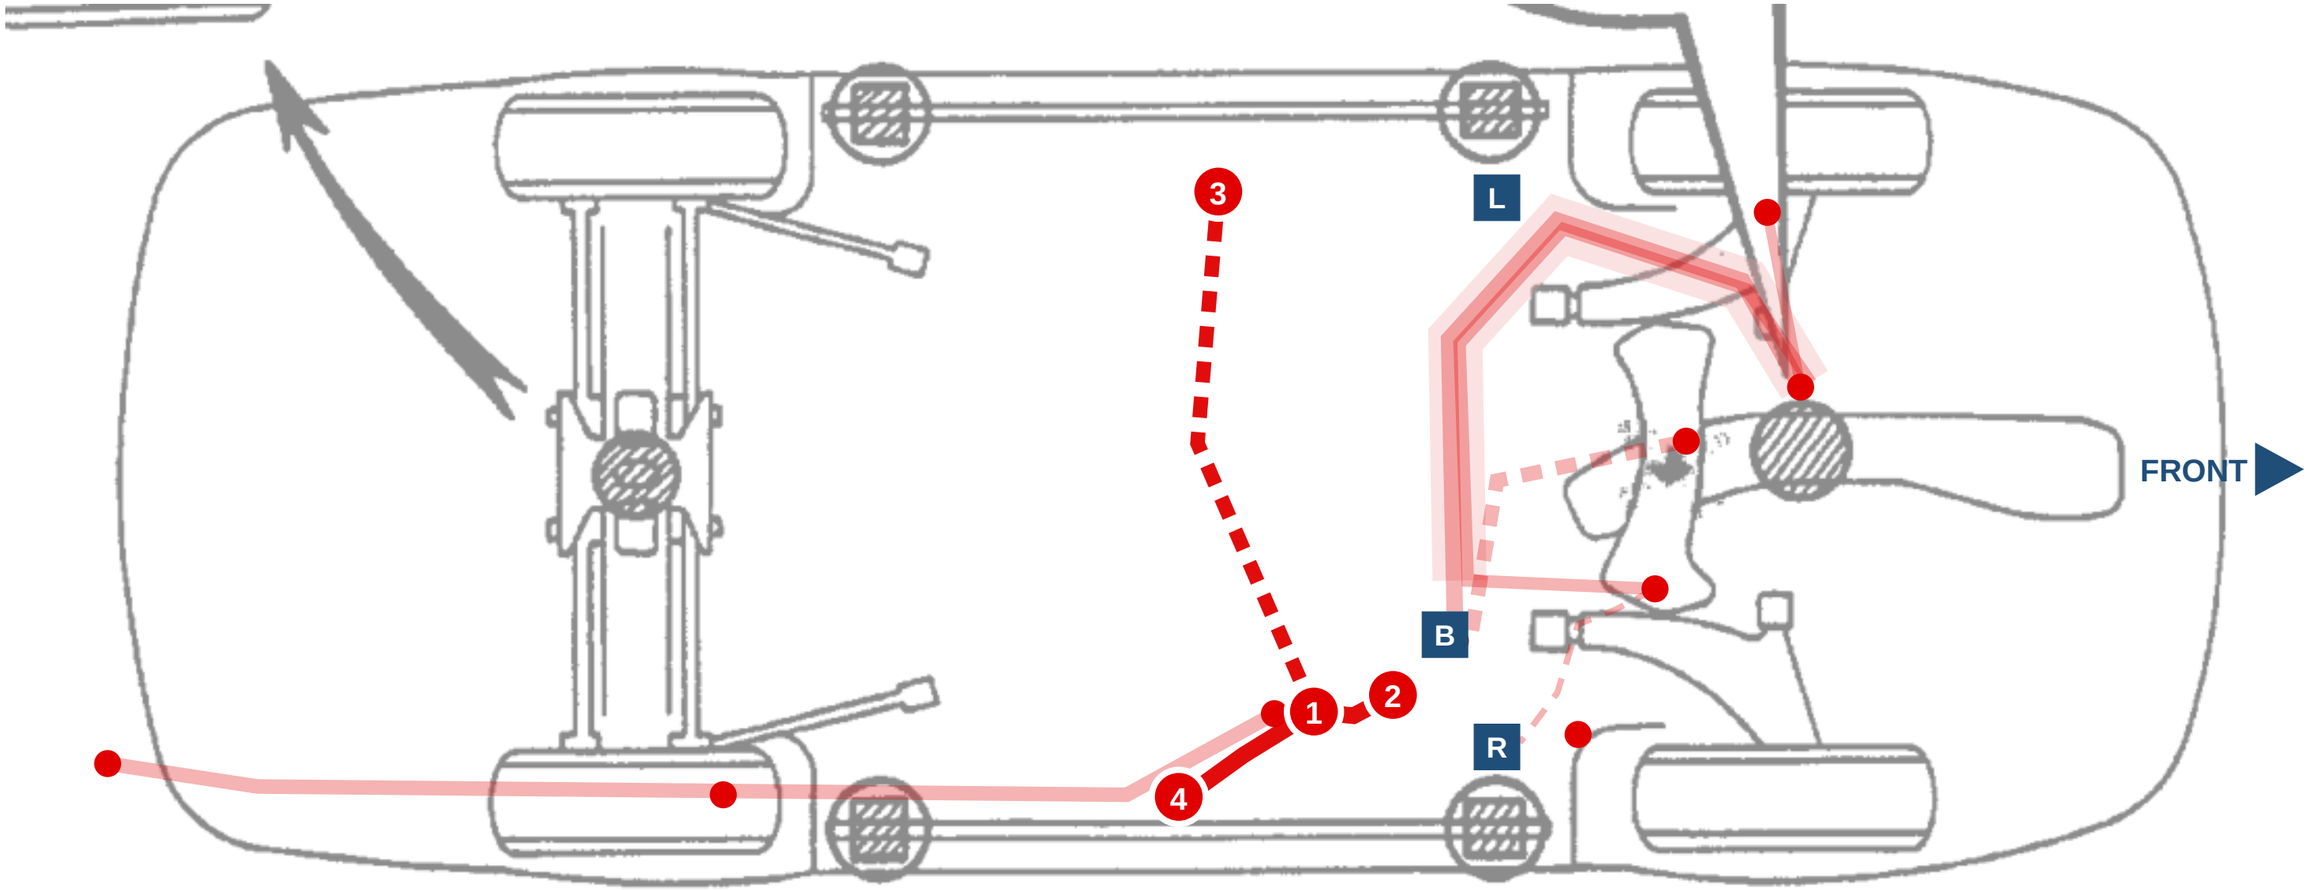

REVISIONS			
REV	DATE	BY	DESCRIPTION
C	2026-10-26	DG	A15 lock-sensor input takes a modified tacho: Ign 8 through 4.7 k· to pin 9 (N61 workaround).
D	2026-10-26	DG	Car-check answers: if the ignition-switch black-orange wire is at the engine plug, remove it; A/C s...
E	2026-10-26	DG	C11 is hardware starter interlock only; Aux 8 spare. Oil LED stays on CSB3 L4.
F	2026-10-26	DG	Each grouped section is its own page. A schematic page holds six wires, each in its own line colo...

ST185-harness - every wiring harness of the car, one drawing set


Layout - ST185-HeavyDC - ROUTE-1-HEAVYDC

DRAWING NO.	REV	SHEET	SIZE	DRAWN	DATE
ST185-harness-LAY	F	38 OF 65	432 x 279 mm	DG	2026-10-26

ST185 Celica (living-relation) - generated by docs/harness/tools/build_drawings.py from docs/harness/MASTER-wirelist.csv; not to scale

LAYOUT - ST185-HeavyDC - ROUTE 1 HEAVYDC, as approved (5 of 7)

Fig. 3 · Rev 4 (Dan·s mark-up): starter moved to where Dan points (lower-middle of the engine); H4 (RADLOK +) and H5 (alternator B+) now run as one bundle (pink band) along the firewall and down to the starter; H8 jump post rerouted from the new starter spot; alternator IG/L/S small wires (rev 4 proposal: spare positions on the B half of the bulkhead · superseded 2026·10·13: they leave through the existing factory RH fender grommet (point 4), s...

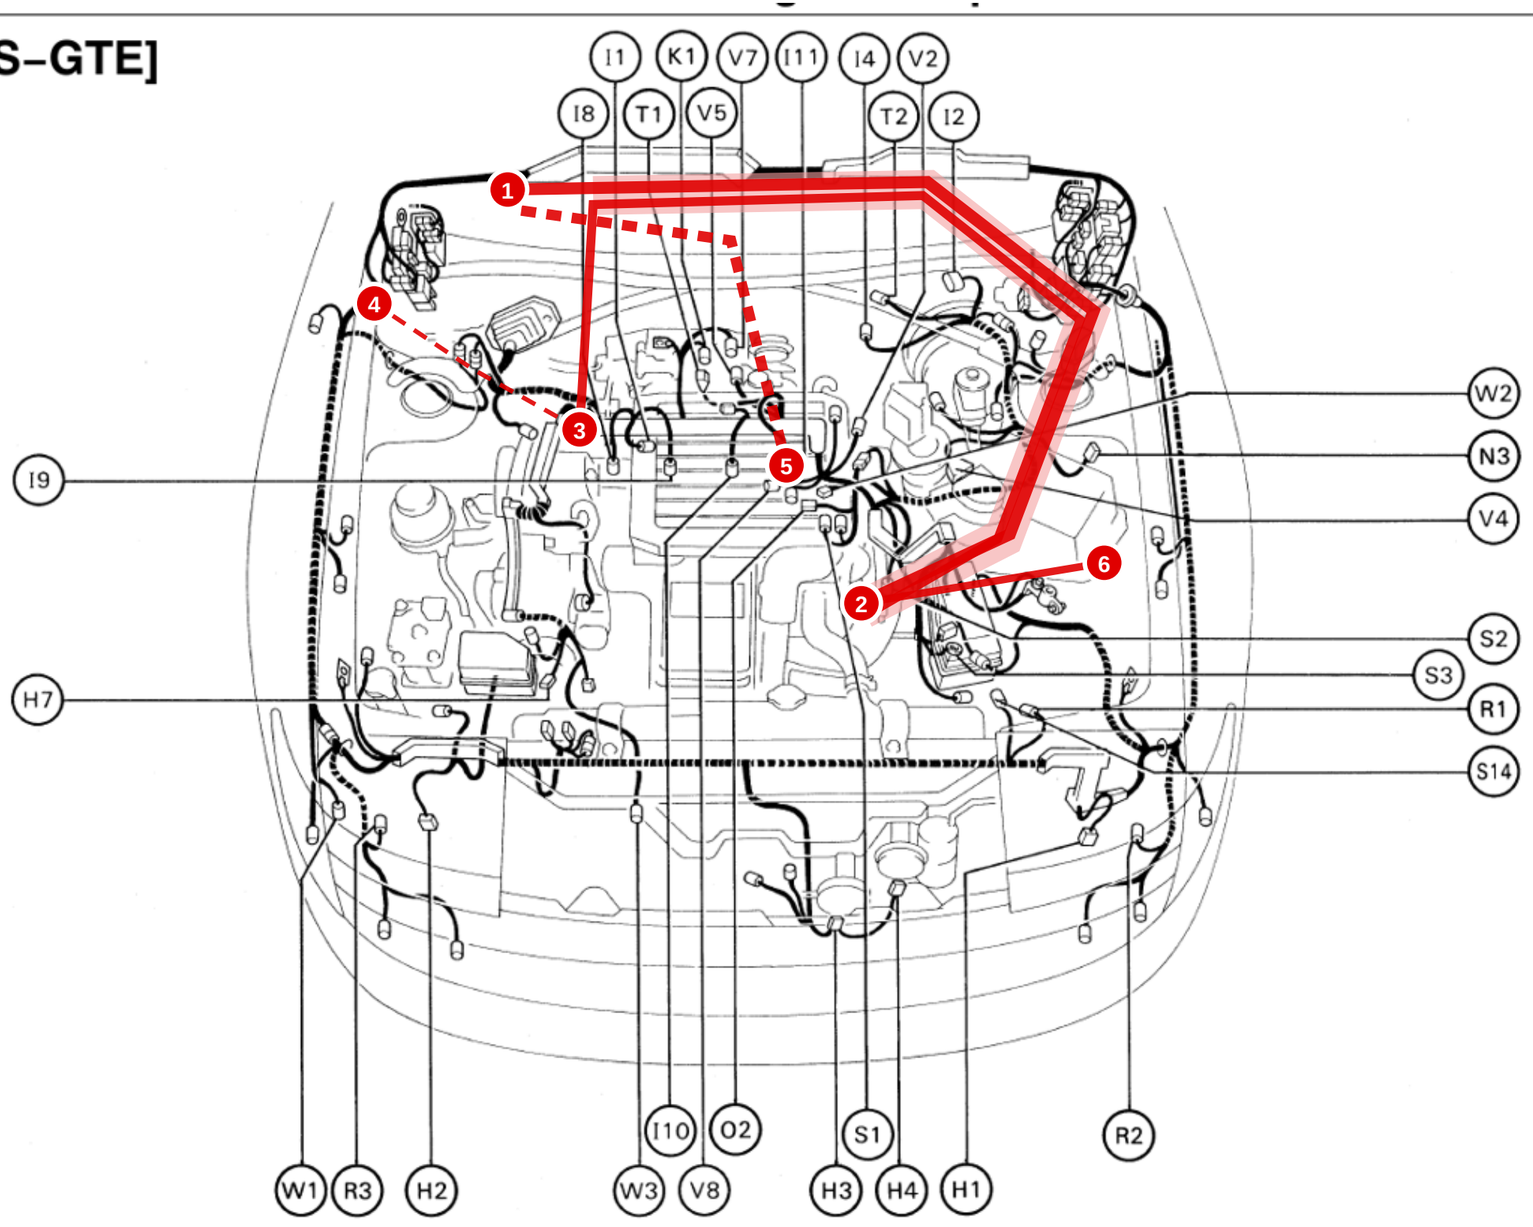

REVISIONS			
REV	DATE	BY	DESCRIPTION
C	2026-10-26	DG	A15 lock-sensor input takes a modified tacho: Ign 8 through 4.7 k· to pin 9 (N61 workaround).
D	2026-10-26	DG	Car-check answers: if the ignition-switch black-orange wire is at the engine plug, remove it; A/C s...
E	2026-10-26	DG	C11 is hardware starter interlock only; Aux 8 spare. Oil LED stays on CSB3 L4.
F	2026-10-26	DG	Each grouped section is its own page. A schematic page holds six wires, each in its own line colo...

ST185-harness - every wiring harness of the car, one drawing set


Layout - ST185-HeavyDC - ROUTE-1-HEAVYDC

DRAWING NO.	REV	SHEET	SIZE	DRAWN	DATE
ST185-harness-LAY	F	39 OF 65	432 x 279 mm	DG	2026-10-26

ST185 Celica (living-relation) - generated by docs/harness/tools/build_drawings.py from docs/harness/MASTER-wirelist.csv; not to scale

LAYOUT - ST185-HeavyDC - ROUTE 1 HEAVYDC, as approved (6 of 7)

Top view for the figure above · same route, same colors. Projected from the figure above (approximate); this figure·s part is bright, the rest of the route is faded. Blue squares: B = bulkhead A/B (DRB102, RH firewall), R / L = RH / LH fender pass-throughs (Route 9 rev 2). Top view base: 1993 Celica repair manual RM305U1, Introduction, ·Vehicle Lift and Support Locations·, p. IN·24 (st185-celica-repair-manual\manuals\RM305U1 - Introduction - Ve...

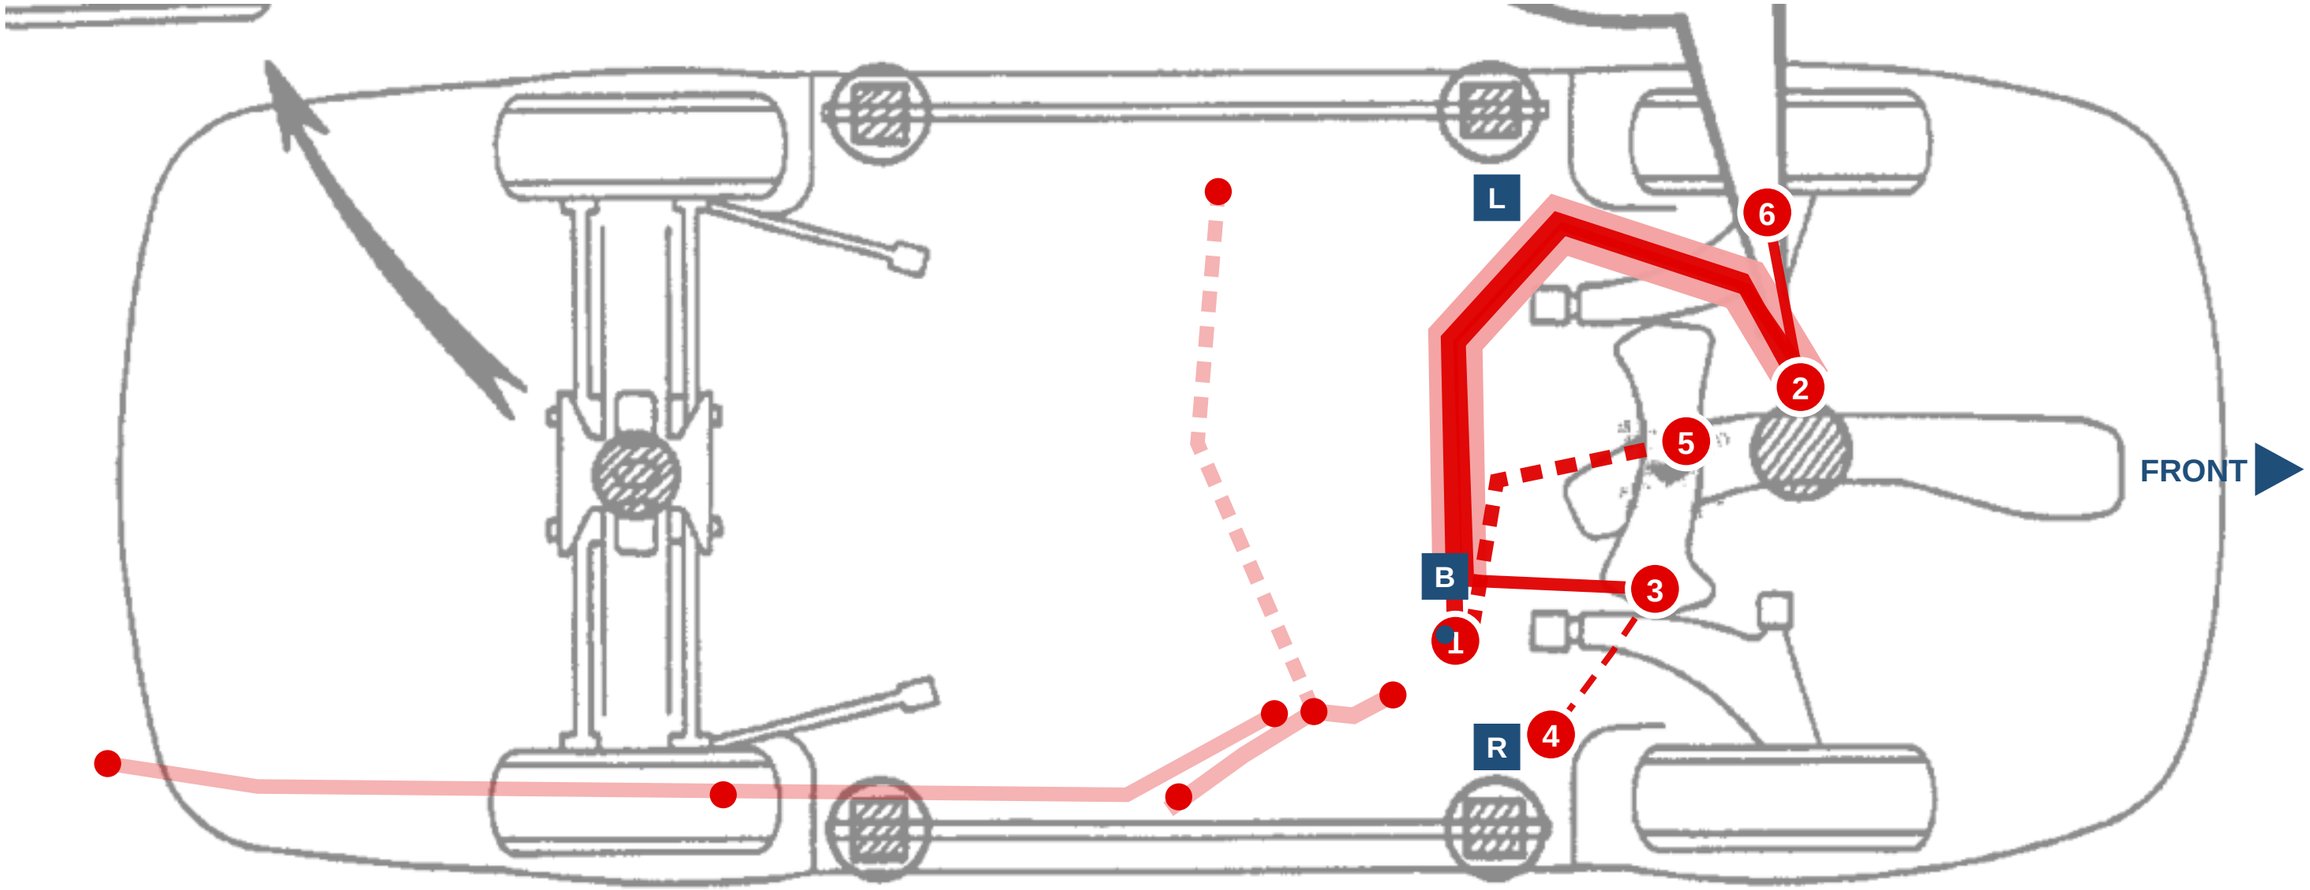

REVISIONS			
REV	DATE	BY	DESCRIPTION
C	2026-10-26	DG	A15 lock-sensor input takes a modified tacho: Ign 8 through 4.7 k· to pin 9 (N61 workaround).
D	2026-10-26	DG	Car-check answers: if the ignition-switch black-orange wire is at the engine plug, remove it; A/C s...
E	2026-10-26	DG	C11 is hardware starter interlock only; Aux 8 spare. Oil LED stays on CSB3 L4.
F	2026-10-26	DG	Each grouped section is its own page. A schematic page holds six wires, each in its own line colo...

ST185-harness - every wiring harness of the car, one drawing set

Layout - ST185-HeavyDC - ROUTE-1-HEAVYDC


DRAWING NO.	REV	SHEET	SIZE	DRAWN	DATE
ST185-harness-LAY	F	40 OF 65	432 x 279 mm	DG	2026-10-26

ST185 Celica (living-relation) - generated by docs/harness/tools/build_drawings.py from docs/harness/MASTER-wirelist.csv; not to scale


LAYOUT - ST185-HeavyDC - ROUTE 1 HEAVYDC, as approved (7 of 7)

Fig. 4 · Alternator connectors, TIS 1993 EWD ·Charging· p.75 (tis1993-charging.pdf, sheet 2). The sheet shows the All-Trac/4WD·s own G2 (A), gray, 3-pin; the harness is drawn for the G2 (B) round 3-pin plug (Toyota 90980-10341 / 90980-11491, DECISIONS S18 / R17), pins in the table below. G1 (C) is the B terminal ring. EWD connector sheet, so no top view: the Fig. 3 top view already shows the alternator (point 3) and its small-wire exit (poin...


.C/4WD) G 2 (A) GRAY

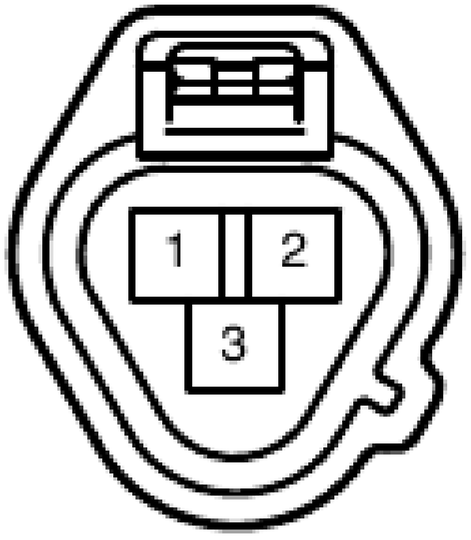

(2WD) G 2 (B) BLACK

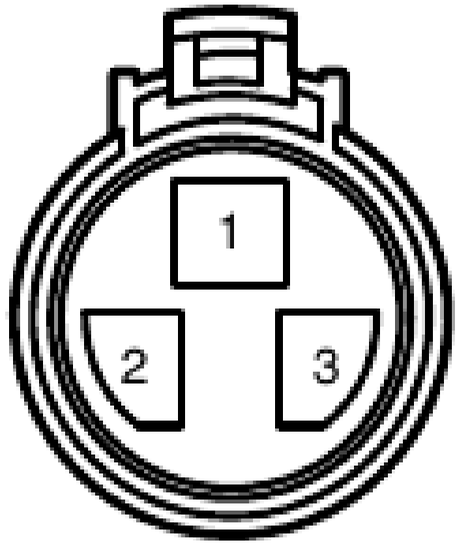

J 3

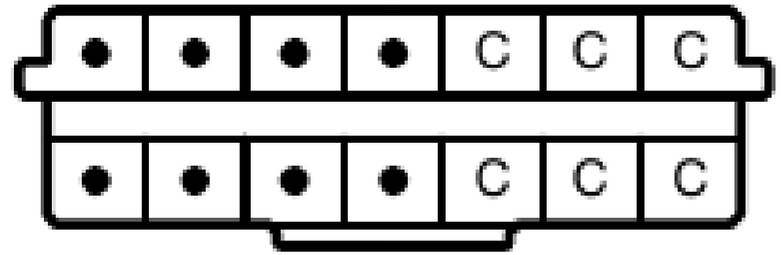

(HINT : SEE PAGE 7)

REVISIONS

REV	DATE	BY	DESCRIPTION
C	2026-10-26	DG	A15 lock-sensor input takes a modified tacho: Ign 8 through 4.7 k· to pin 9 (N61 workaround).
D	2026-10-26	DG	Car-check answers: if the ignition-switch black-orange wire is at the engine plug, remove it; A/C s...
E	2026-10-26	DG	C11 is hardware starter interlock only; Aux 8 spare. Oil LED stays on CSB3 L4.
F	2026-10-26	DG	Each grouped section is its own page. A schematic page holds six wires, each in its own line colo...

ST185-harness - every wiring harness of the car, one drawing set


Layout - ST185-HeavyDC - ROUTE-1-HEAVYDC

DRAWING NO.	REV	SHEET	SIZE	DRAWN	DATE
ST185-harness-LAY	F	41 OF 65	432 x 279 mm	DG	2026-10-26

ST185 Celica (living-relation) - generated by docs/harness/tools/build_drawings.py from docs/harness/MASTER-wirelist.csv; not to scale

LAYOUT - ST185-CAN - ROUTE 8 CAN, as approved (1 of 4)

Fig. 1 · Instrument panel, TIS 1993 EWD ·Relay Locations· p.18 (sheet 1). Red = the CAN trunk as one daisy-chained shielded twisted pair: ECU end (terminated) · CSB3 · center cluster · Pi/RealDash · bulkhead B · CAN-Lambda end (terminated, Fig. 2). Numbers match the key below. Cluster at the old combination-meter spot (J/B No.3 is behind it); CSB3 under the center cluster and the Pi at the center dash (Dan, 2026·10·10). Rev 2 reorders the c

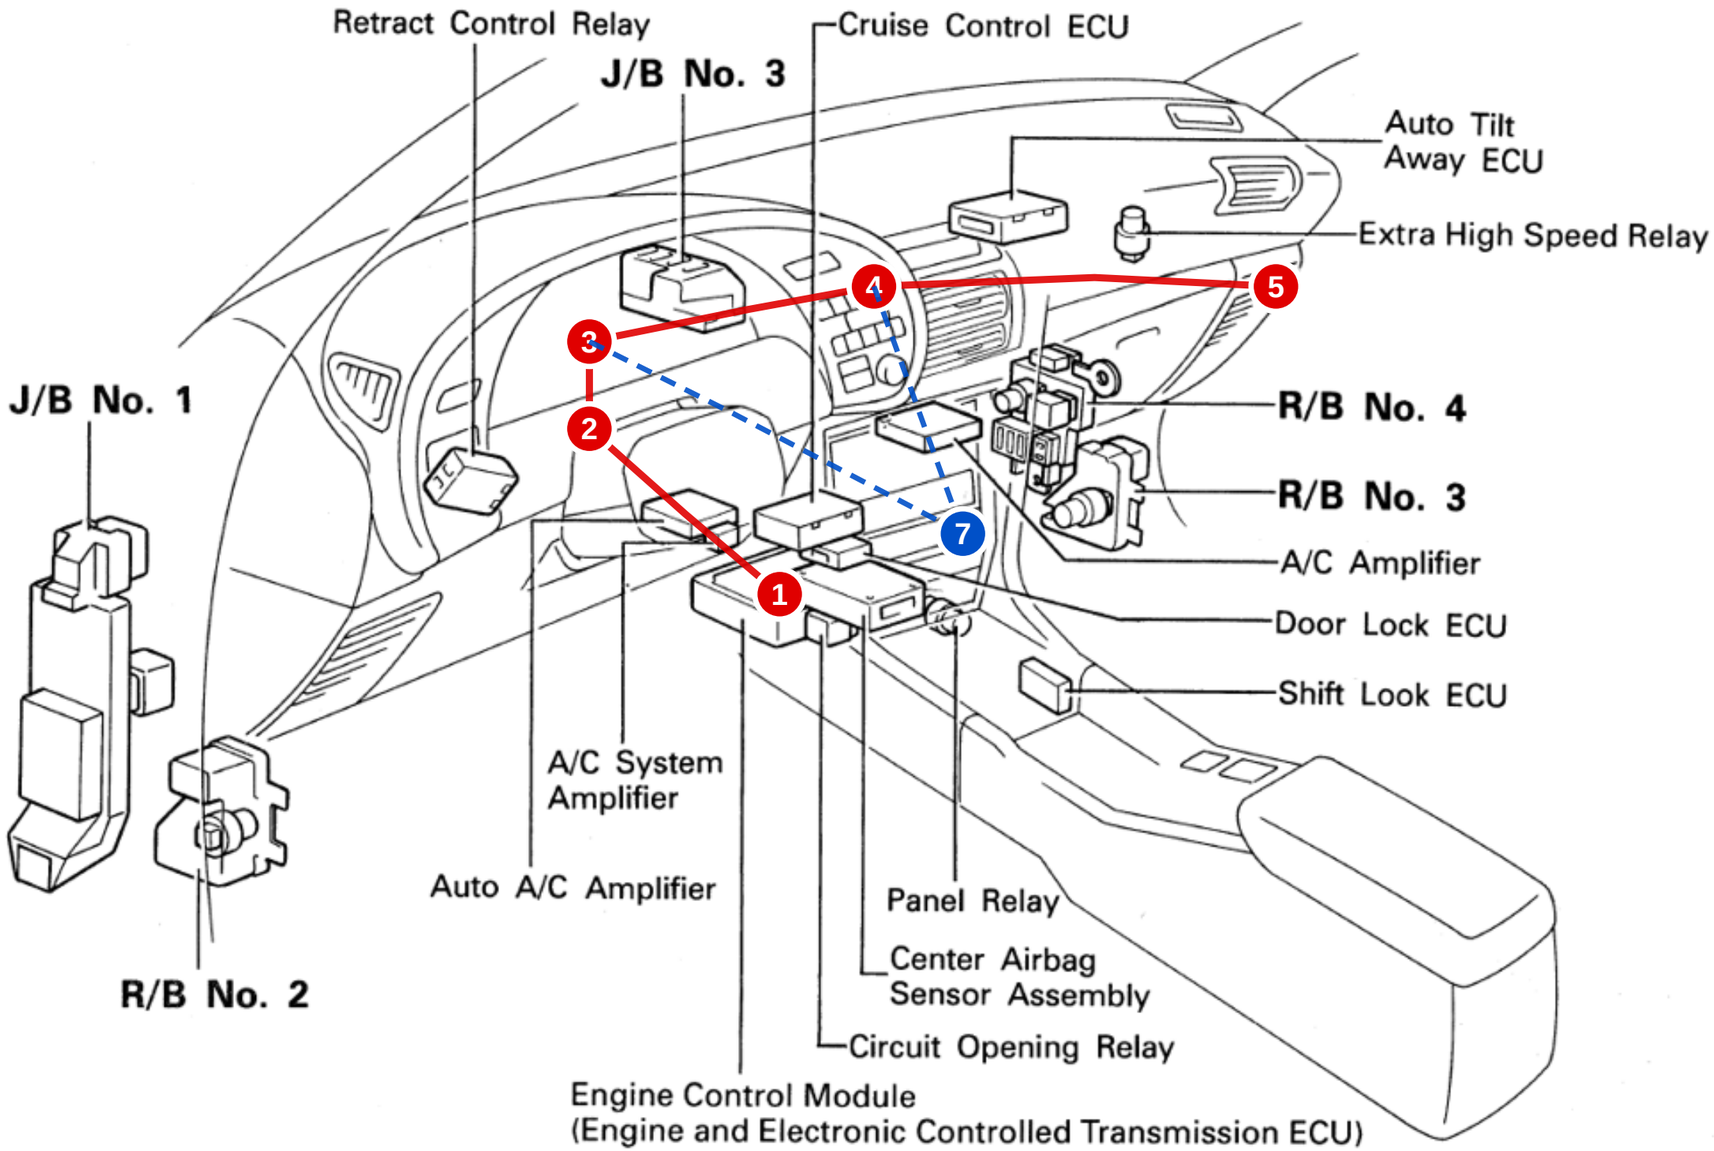

REVISIONS

REV	DATE	BY	DESCRIPTION
C	2026-10-26	DG	A15 lock-sensor input takes a modified tacho: Ign 8 through 4.7 k· to pin 9 (N61 workaround).
D	2026-10-26	DG	Car-check answers: if the ignition-switch black-orange wire is at the engine plug, remove it; A/C s...
E	2026-10-26	DG	C11 is hardware starter interlock only; Aux 8 spare. Oil LED stays on CSB3 L4.
F	2026-10-26	DG	Each grouped section is its own page. A schematic page holds six wires, each in its own line colo...

ST185-harness - every wiring harness of the car, one drawing set

Layout - ST185-CAN - ROUTE-8-CAN


DRAWING NO.	REV	SHEET	SIZE	DRAWN	DATE
ST185-harness-LAY	F	42 OF 65	432 x 279 mm	DG	2026-10-26

ST185 Celica (living-relation) - generated by docs/harness/tools/build_drawings.py from docs/harness/MASTER-wirelist.csv; not to scale

LAYOUT - ST185-CAN - ROUTE 8 CAN, as approved (2 of 4)

Top view for the figure above · same route, same colors. Projected from the figure above (approximate); this figure·s part is bright, the rest of the route is faded. Blue squares: B = bulkhead A/B (DRB102, RH firewall), R / L = RH / LH fender pass-throughs (Route 9 rev 2). Top view base: 1993 Celica repair manual RM305U1, Introduction, ·Vehicle Lift and Support Locations·, p. IN·24 (st185-celica-repair-manual\manuals\RM305U1 - Introduction - Ve...

DRIVER (LH) SIDE

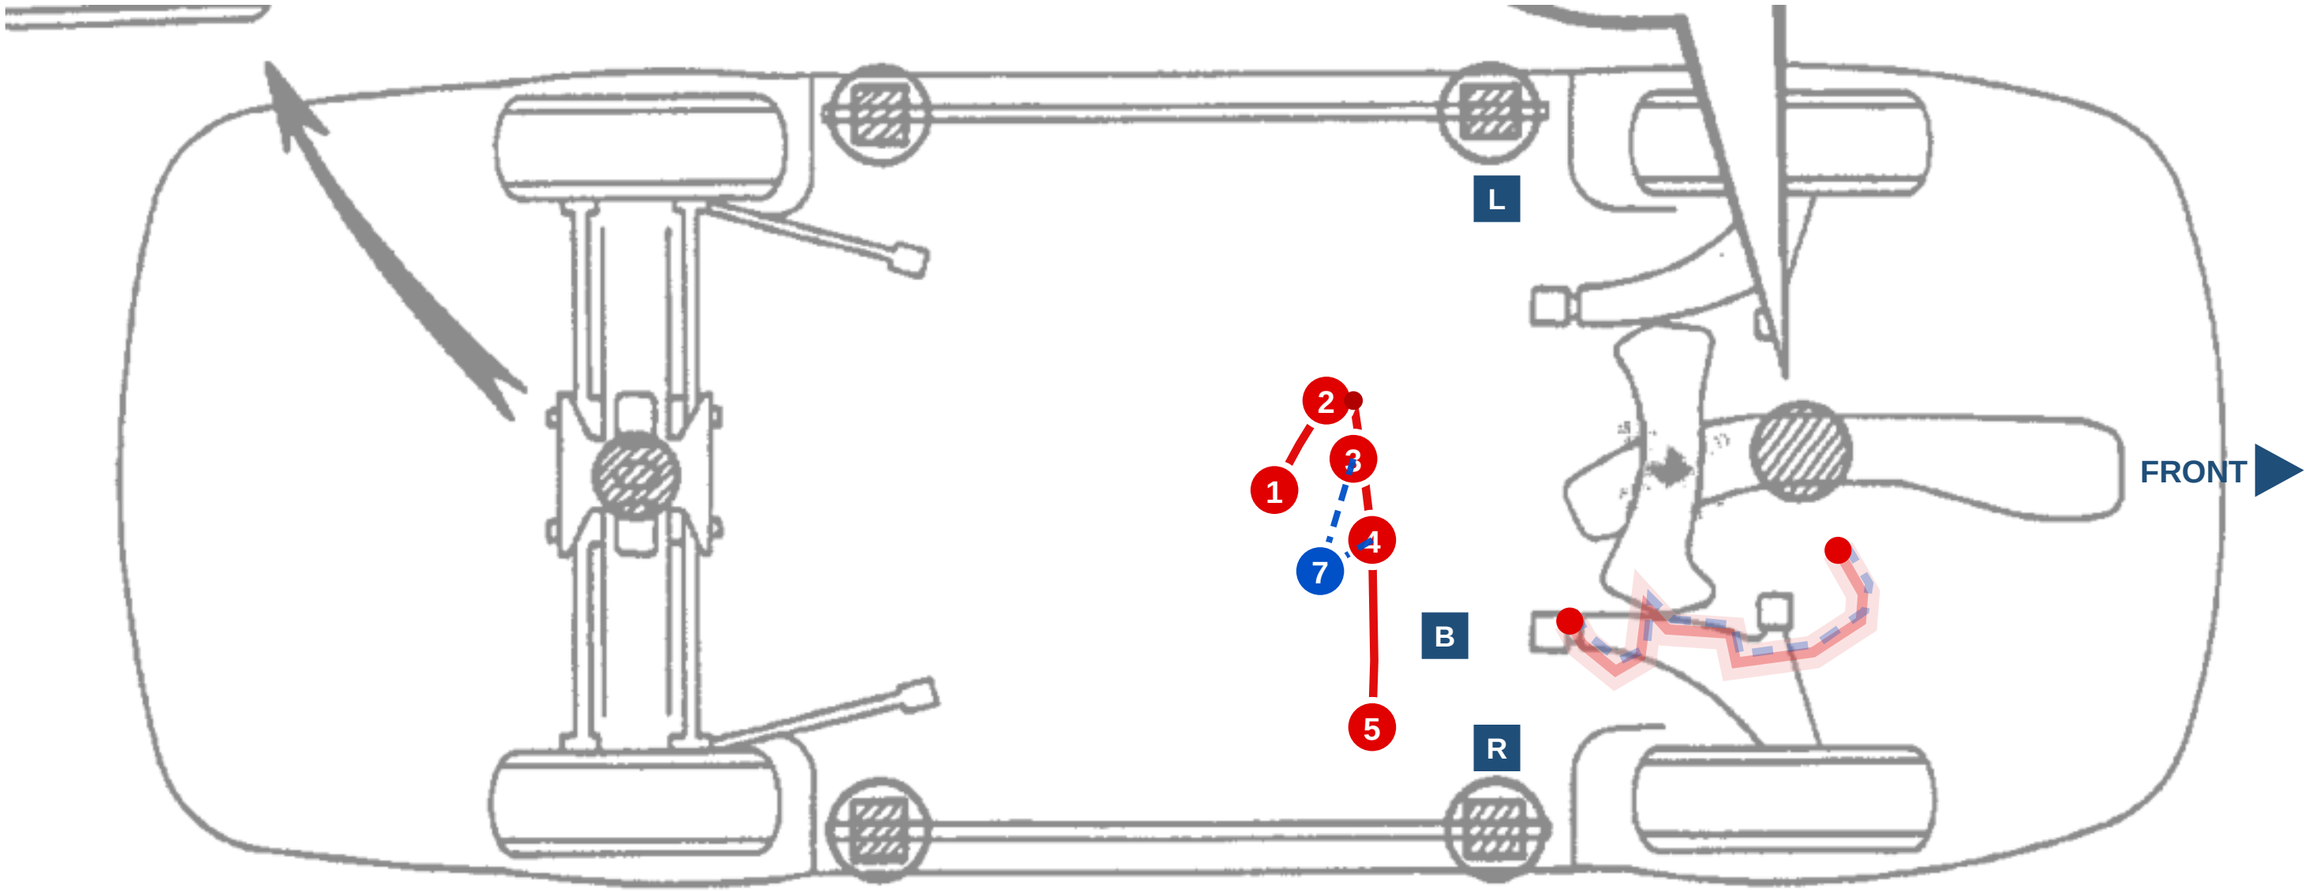

PASSENGER (RH) SIDE

REVISIONS

REV	DATE	BY	DESCRIPTION
C	2026-10-26	DG	A15 lock-sensor input takes a modified tacho: Ign 8 through 4.7 k· to pin 9 (N61 workaround).
D	2026-10-26	DG	Car-check answers: if the ignition-switch black-orange wire is at the engine plug, remove it; A/C s...
E	2026-10-26	DG	C11 is hardware starter interlock only; Aux 8 spare. Oil LED stays on CSB3 L4.
F	2026-10-26	DG	Each grouped section is its own page. A schematic page holds six wires, each in its own line colo...

ST185-harness - every wiring harness of the car, one drawing set


Layout - ST185-CAN - ROUTE-8-CAN

DRAWING NO.	REV	SHEET	SIZE	DRAWN	DATE
ST185-harness-LAY	F	43 OF 65	432 x 279 mm	DG	2026-10-26

ST185 Celica (living-relation) - generated by docs/harness/tools/build_drawings.py from docs/harness/MASTER-wirelist.csv; not to scale

LAYOUT - ST185-CAN - ROUTE 8 CAN, as approved (3 of 4)

Fig. 2 · Engine compartment, 3S-GTE, TIS 1993 EWD p.29 (sheet 2). Firewall at top, driver side on the right. Rev 4 (Dan·s blue mark-up): the CAN-Lambda run leaves bulkhead B (5), drops down along the existing factory harness through the middle of the bay, then turns over to the Link CAN-Lambda (6) · it does not cut straight across. Path is traced from Dan·s mark-up, so it·s approximate. red = CAN H / CAN L shielded twisted pair inside the s...

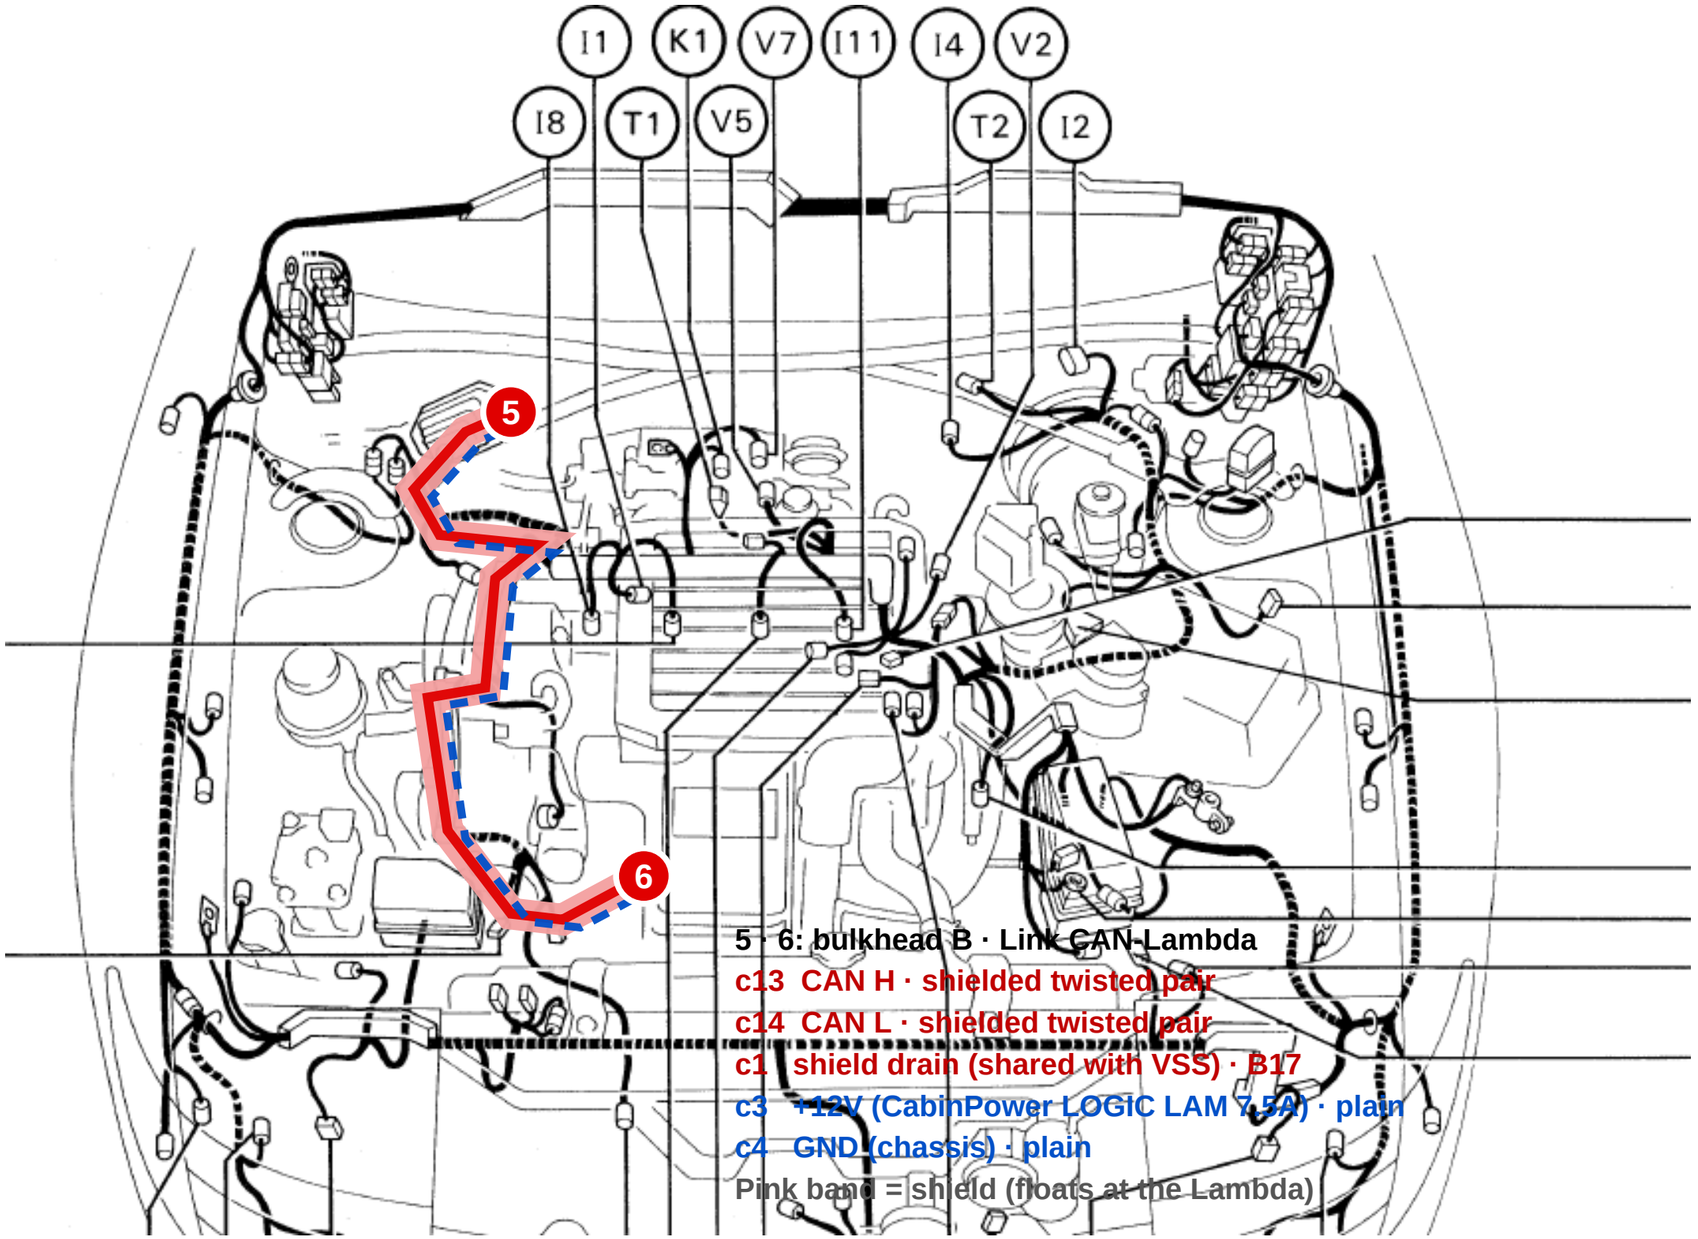

REVISIONS

REV	DATE	BY	DESCRIPTION
C	2026-10-26	DG	A15 lock-sensor input takes a modified tacho: Ign 8 through 4.7 k· to pin 9 (N61 workaround).
D	2026-10-26	DG	Car-check answers: if the ignition-switch black-orange wire is at the engine plug, remove it; A/C s...
E	2026-10-26	DG	C11 is hardware starter interlock only; Aux 8 spare. Oil LED stays on CSB3 L4.
F	2026-10-26	DG	Each grouped section is its own page. A schematic page holds six wires, each in its own line colo...


ST185-harness - every wiring harness of the car, one drawing set

Layout - ST185-CAN - ROUTE-8-CAN

DRAWING NO.	REV	SHEET	SIZE	DRAWN	DATE
ST185-harness-LAY	F	44 OF 65	432 x 279 mm	DG	2026-10-26

LAYOUT - ST185-CAN - ROUTE 8 CAN, as approved (4 of 4)

Top view for the figure above · same route, same colors. Projected from the figure above (approximate); this figure·s part is bright, the rest of the route is faded. Blue squares: B = bulkhead A/B (DRB102, RH firewall), R / L = RH / LH fender pass-throughs (Route 9 rev 2). Top view base: 1993 Celica repair manual RM305U1, Introduction, ·Vehicle Lift and Support Locations·, p. IN·24 (st185-celica-repair-manual\manuals\RM305U1 - Introduction - Ve...

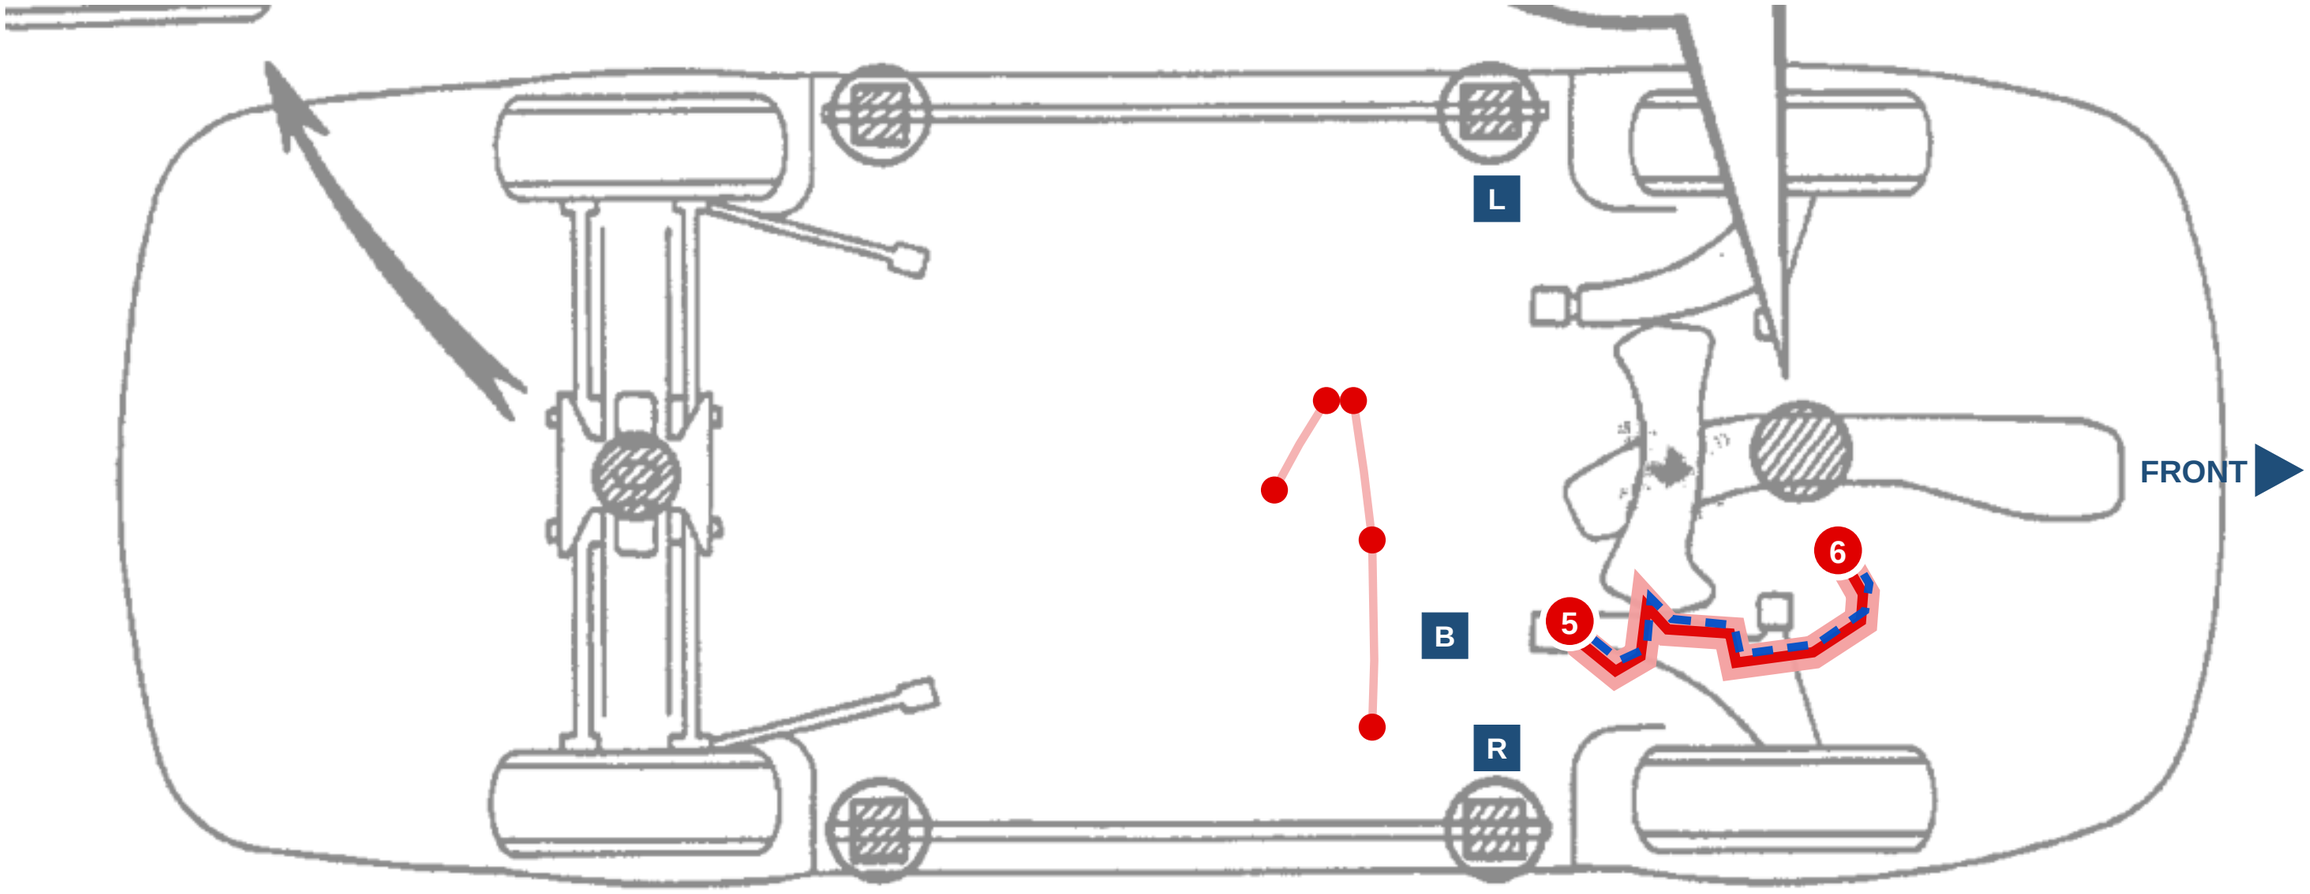

REVISIONS

REV	DATE	BY	DESCRIPTION
C	2026-10-26	DG	A15 lock-sensor input takes a modified tacho: Ign 8 through 4.7 k· to pin 9 (N61 workaround).
D	2026-10-26	DG	Car-check answers: if the ignition-switch black-orange wire is at the engine plug, remove it; A/C s...
E	2026-10-26	DG	C11 is hardware starter interlock only; Aux 8 spare. Oil LED stays on CSB3 L4.
F	2026-10-26	DG	Each grouped section is its own page. A schematic page holds six wires, each in its own line colo...


ST185-harness - every wiring harness of the car, one drawing set

Layout - ST185-CAN - ROUTE-8-CAN

DRAWING NO.	REV	SHEET	SIZE	DRAWN	DATE
ST185-harness-LAY	F	45 OF 65	432 x 279 mm	DG	2026-10-26

LAYOUT - ST185-CSB3 - ROUTE 12 CSB3, as approved (1 of 2)

Fig. 1 · Instrument panel, TIS 1993 EWD ·Relay Locations· p.18 (tis1993-relay-locations.pdf, sheet 1). Driver side left, glove box right. Deleted parts still drawn on this page are not used. Red solid = the CSB3 harness (plug + switch inputs). Dashed = wires that arrive broken off from other harnesses (reverse via bulkhead B, oil LED sink to ClusterLED, +12V / ground, +5V for the cruise ladder). CAN H/L to the CSB3 is in Route 8. The cruise stalk...

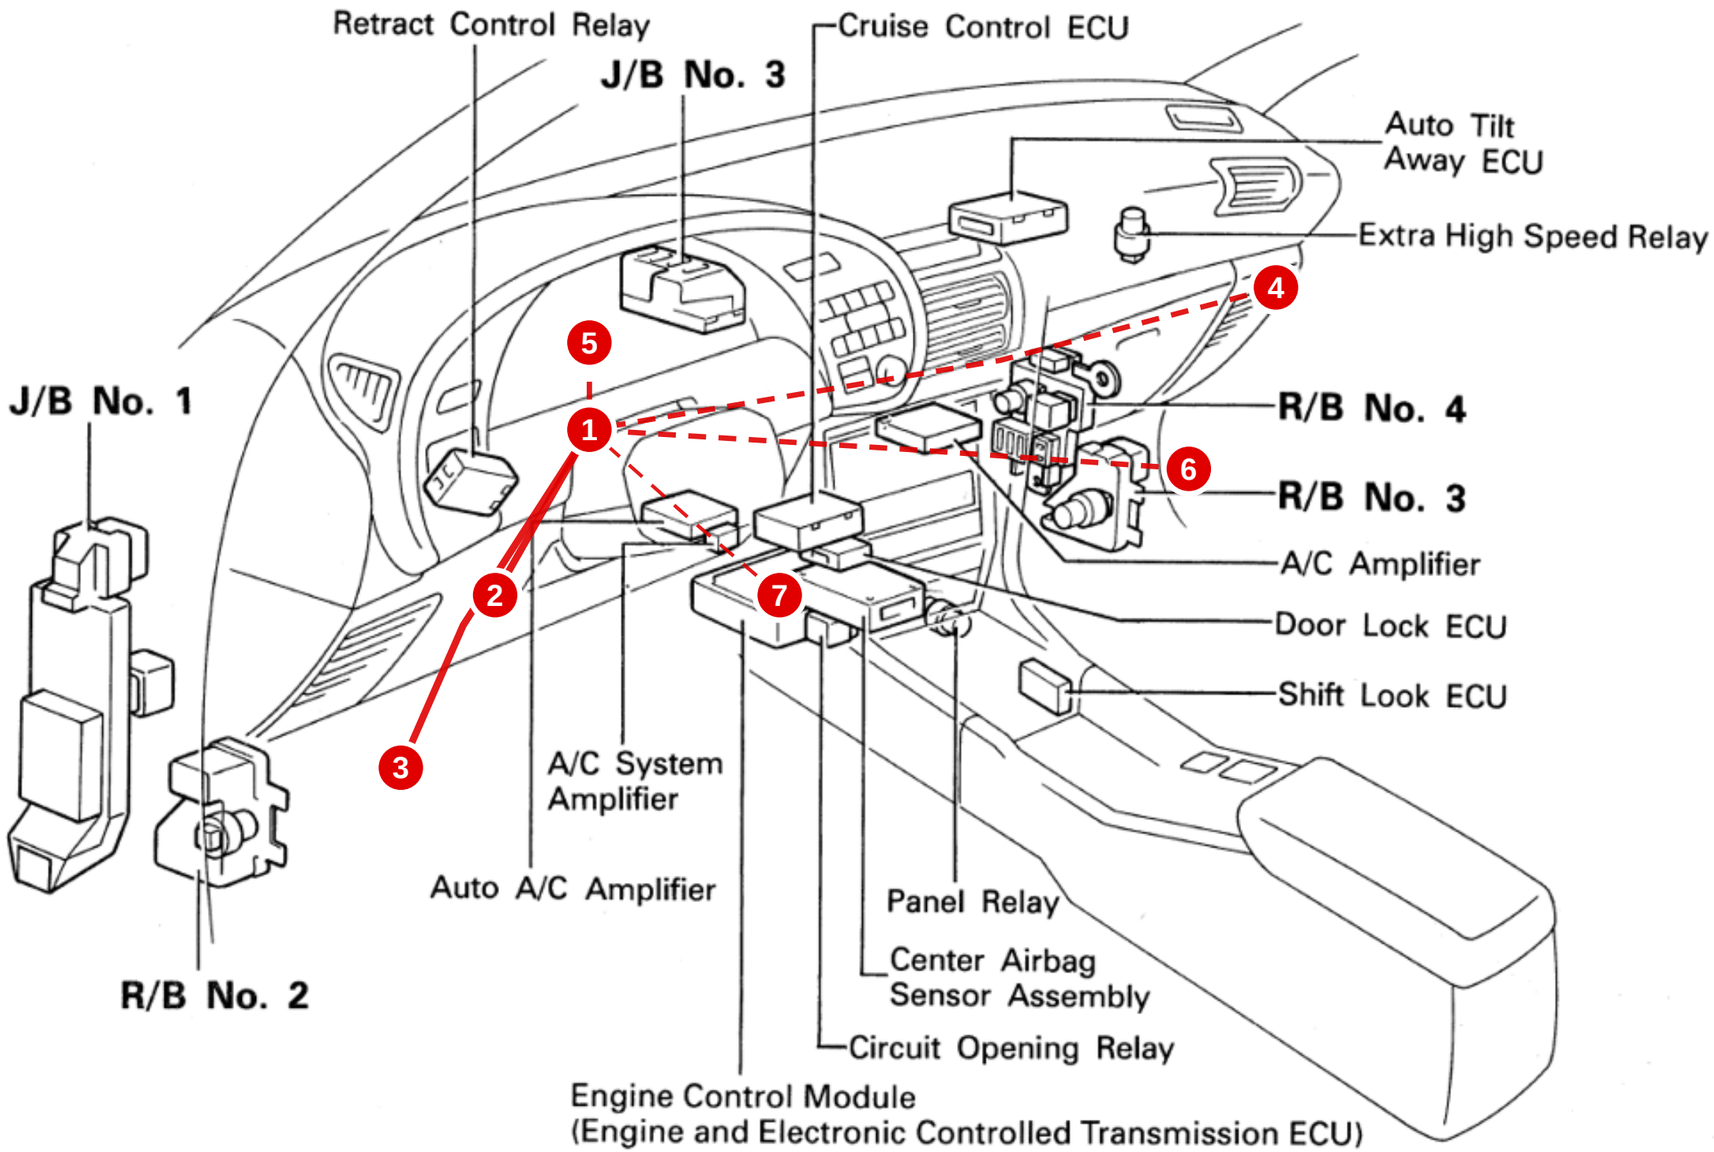

REVISIONS

REV	DATE	BY	DESCRIPTION
C	2026-10-26	DG	A15 lock-sensor input takes a modified tacho: Ign 8 through 4.7 k· to pin 9 (N61 workaround).
D	2026-10-26	DG	Car-check answers: if the ignition-switch black-orange wire is at the engine plug, remove it; A/C s...
E	2026-10-26	DG	C11 is hardware starter interlock only; Aux 8 spare. Oil LED stays on CSB3 L4.
F	2026-10-26	DG	Each grouped section is its own page. A schematic page holds six wires, each in its own line colo...

ST185-harness - every wiring harness of the car, one drawing set

Layout - ST185-CSB3 - ROUTE-12-CSB3


DRAWING NO.	REV	SHEET	SIZE	DRAWN	DATE
ST185-harness-LAY	F	46 OF 65	432 x 279 mm	DG	2026-10-26

ST185 Celica (living-relation) - generated by docs/harness/tools/build_drawings.py from docs/harness/MASTER-wirelist.csv; not to scale

LAYOUT - ST185-CSB3 - ROUTE 12 CSB3, as approved (2 of 2)

Top view for the figure above · same route, same colors. Projected from the figure above (approximate); this figure·s part is bright, the rest of the route is faded. Blue squares: B = bulkhead A/B (DRB102, RH firewall), R / L = RH / LH fender pass-throughs (Route 9 rev 2). Top view base: 1993 Celica repair manual RM305U1, Introduction, ·Vehicle Lift and Support Locations·, p. IN·24 (st185-celica-repair-manual\manuals\RM305U1 - Introduction - Ve...

DRIVER (LH) SIDE

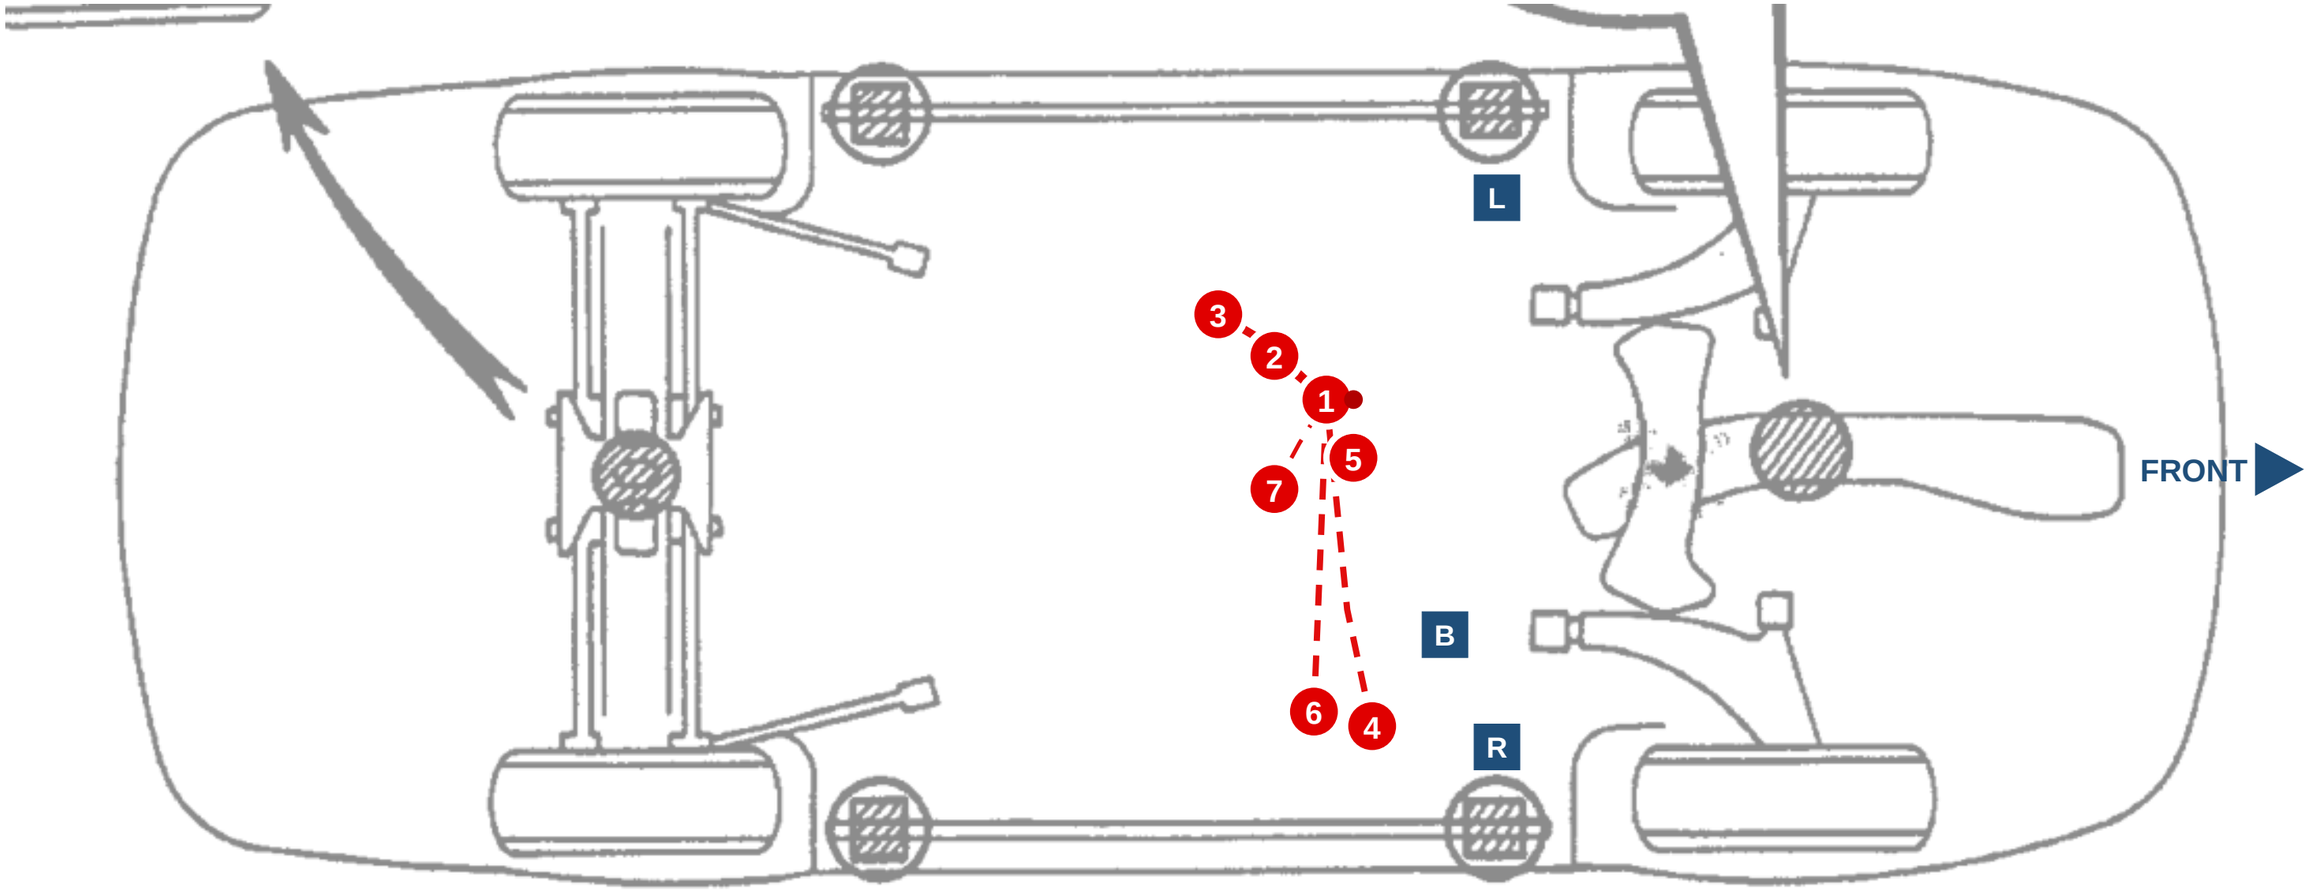

PASSENGER (RH) SIDE

REVISIONS

REV	DATE	BY	DESCRIPTION
C	2026-10-26	DG	A15 lock-sensor input takes a modified tacho: Ign 8 through 4.7 k· to pin 9 (N61 workaround).
D	2026-10-26	DG	Car-check answers: if the ignition-switch black-orange wire is at the engine plug, remove it; A/C s...
E	2026-10-26	DG	C11 is hardware starter interlock only; Aux 8 spare. Oil LED stays on CSB3 L4.
F	2026-10-26	DG	Each grouped section is its own page. A schematic page holds six wires, each in its own line colo...


ST185-harness - every wiring harness of the car, one drawing set

Layout - ST185-CSB3 - ROUTE-12-CSB3

DRAWING NO.	REV	SHEET	SIZE	DRAWN	DATE
ST185-harness-LAY	F	47 OF 65	432 x 279 mm	DG	2026-10-26

LAYOUT - ST185-AntiTheft - ROUTE 14 ANTITHEFT, as approved (1 of 4)

Fig. 1 · Instrument panel, TIS 1993 EWD ·Relay Locations· p.18 (tis1993-relay-locations.pdf, sheet 1). Driver side left, glove box right. Deleted parts still drawn on this page are not used. Rev 2 (Dan·s answers, 2026·10·10): alarm module in the center dash just left of the ECU (1); immobiliser to ECU B27 (2); power from the glove-box LOGIC box (3); siren + hood-pin leads out through the existing factory RH fender grommet (harness C) (4, decided); s

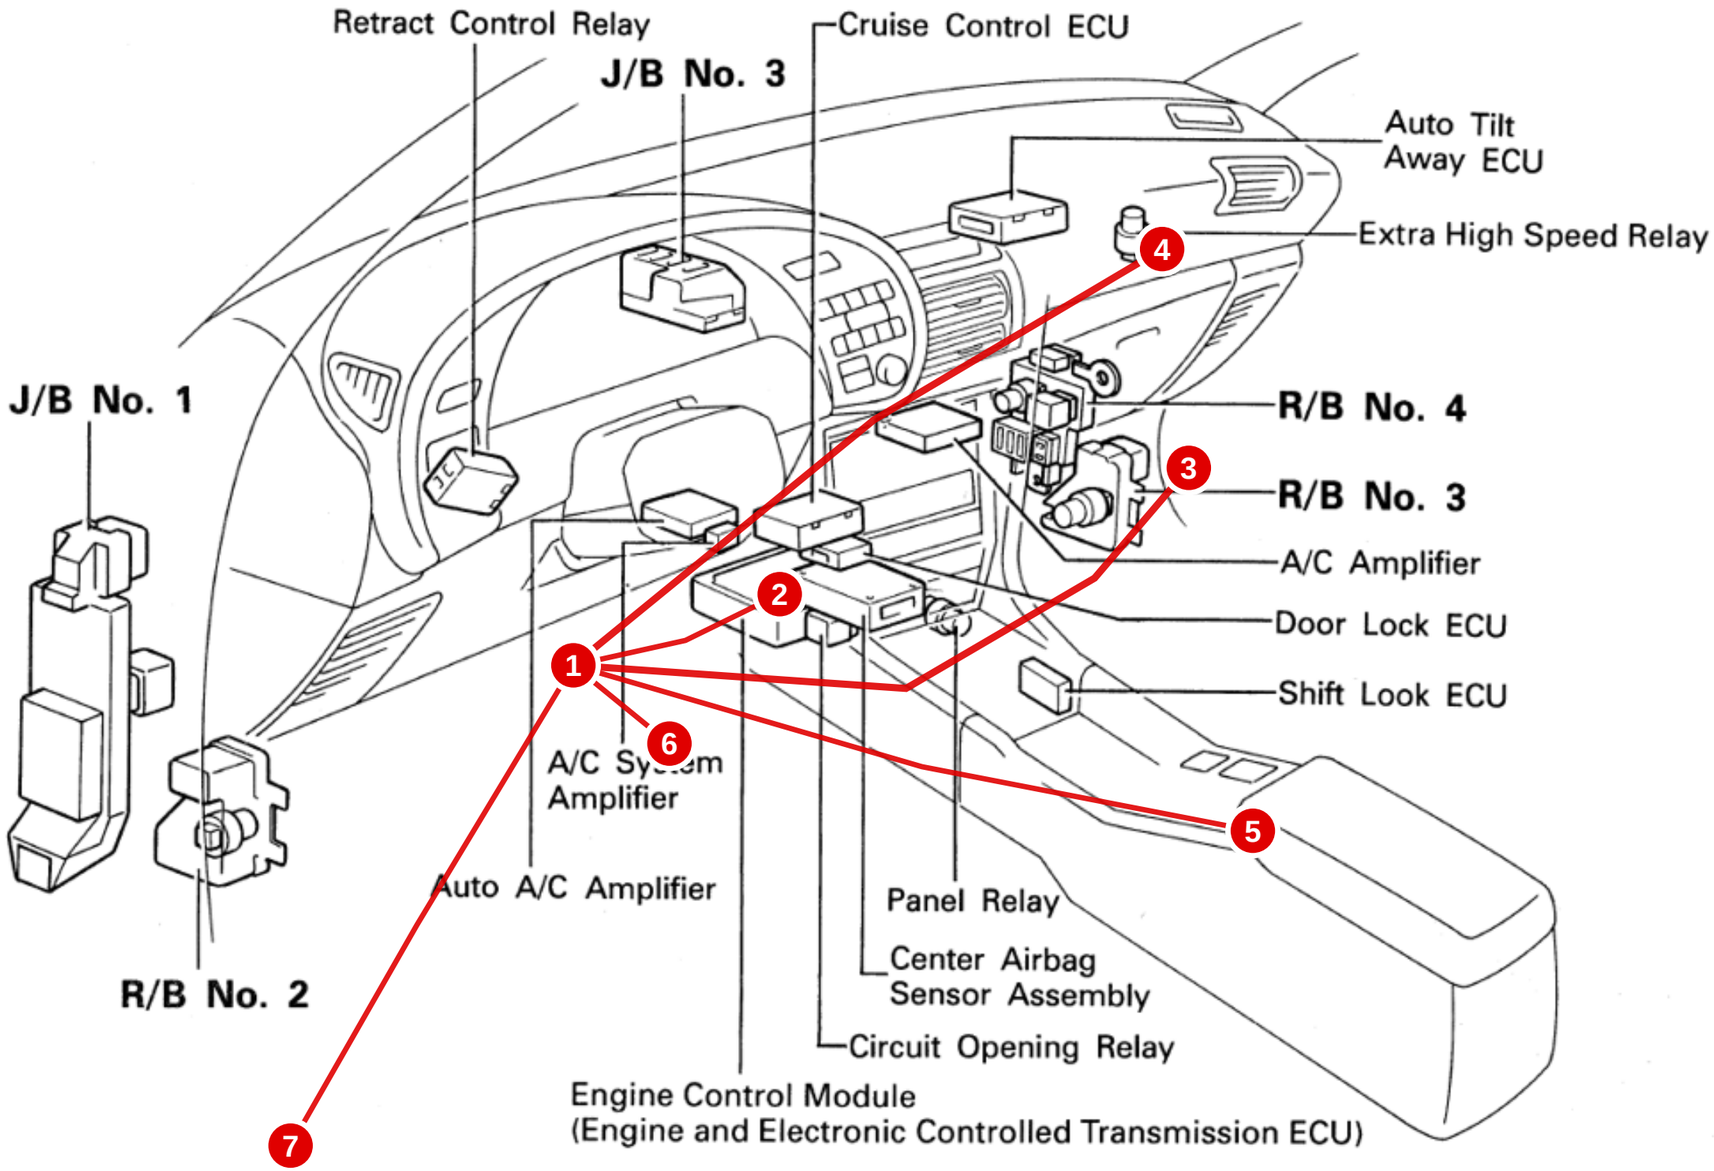

REVISIONS

REV	DATE	BY	DESCRIPTION
C	2026-10-26	DG	A15 lock-sensor input takes a modified tacho: Ign 8 through 4.7 k· to pin 9 (N61 workaround).
D	2026-10-26	DG	Car-check answers: if the ignition-switch black-orange wire is at the engine plug, remove it; A/C s...
E	2026-10-26	DG	C11 is hardware starter interlock only; Aux 8 spare. Oil LED stays on CSB3 L4.
F	2026-10-26	DG	Each grouped section is its own page. A schematic page holds six wires, each in its own line colo...

ST185-harness - every wiring harness of the car, one drawing set

Layout - ST185-AntiTheft - ROUTE-14-ANTITHEFT


DRAWING NO.	REV	SHEET	SIZE	DRAWN	DATE
ST185-harness-LAY	F	48 OF 65	432 x 279 mm	DG	2026-10-26

ST185 Celica (living-relation) - generated by docs/harness/tools/build_drawings.py from docs/harness/MASTER-wirelist.csv; not to scale

LAYOUT - ST185-AntiTheft - ROUTE 14 ANTITHEFT, as approved (2 of 4)

Top view for the figure above · same route, same colors. Projected from the figure above (approximate); this figure·s part is bright, the rest of the route is faded. Blue squares: B = bulkhead A/B (DRB102, RH firewall), R / L = RH / LH fender pass-throughs (Route 9 rev 2). Top view base: 1993 Celica repair manual RM305U1, Introduction, ·Vehicle Lift and Support Locations·, p. IN·24 (st185-celica-repair-manual\manuals\RM305U1 - Introduction - Ve...

DRIVER (LH) SIDE

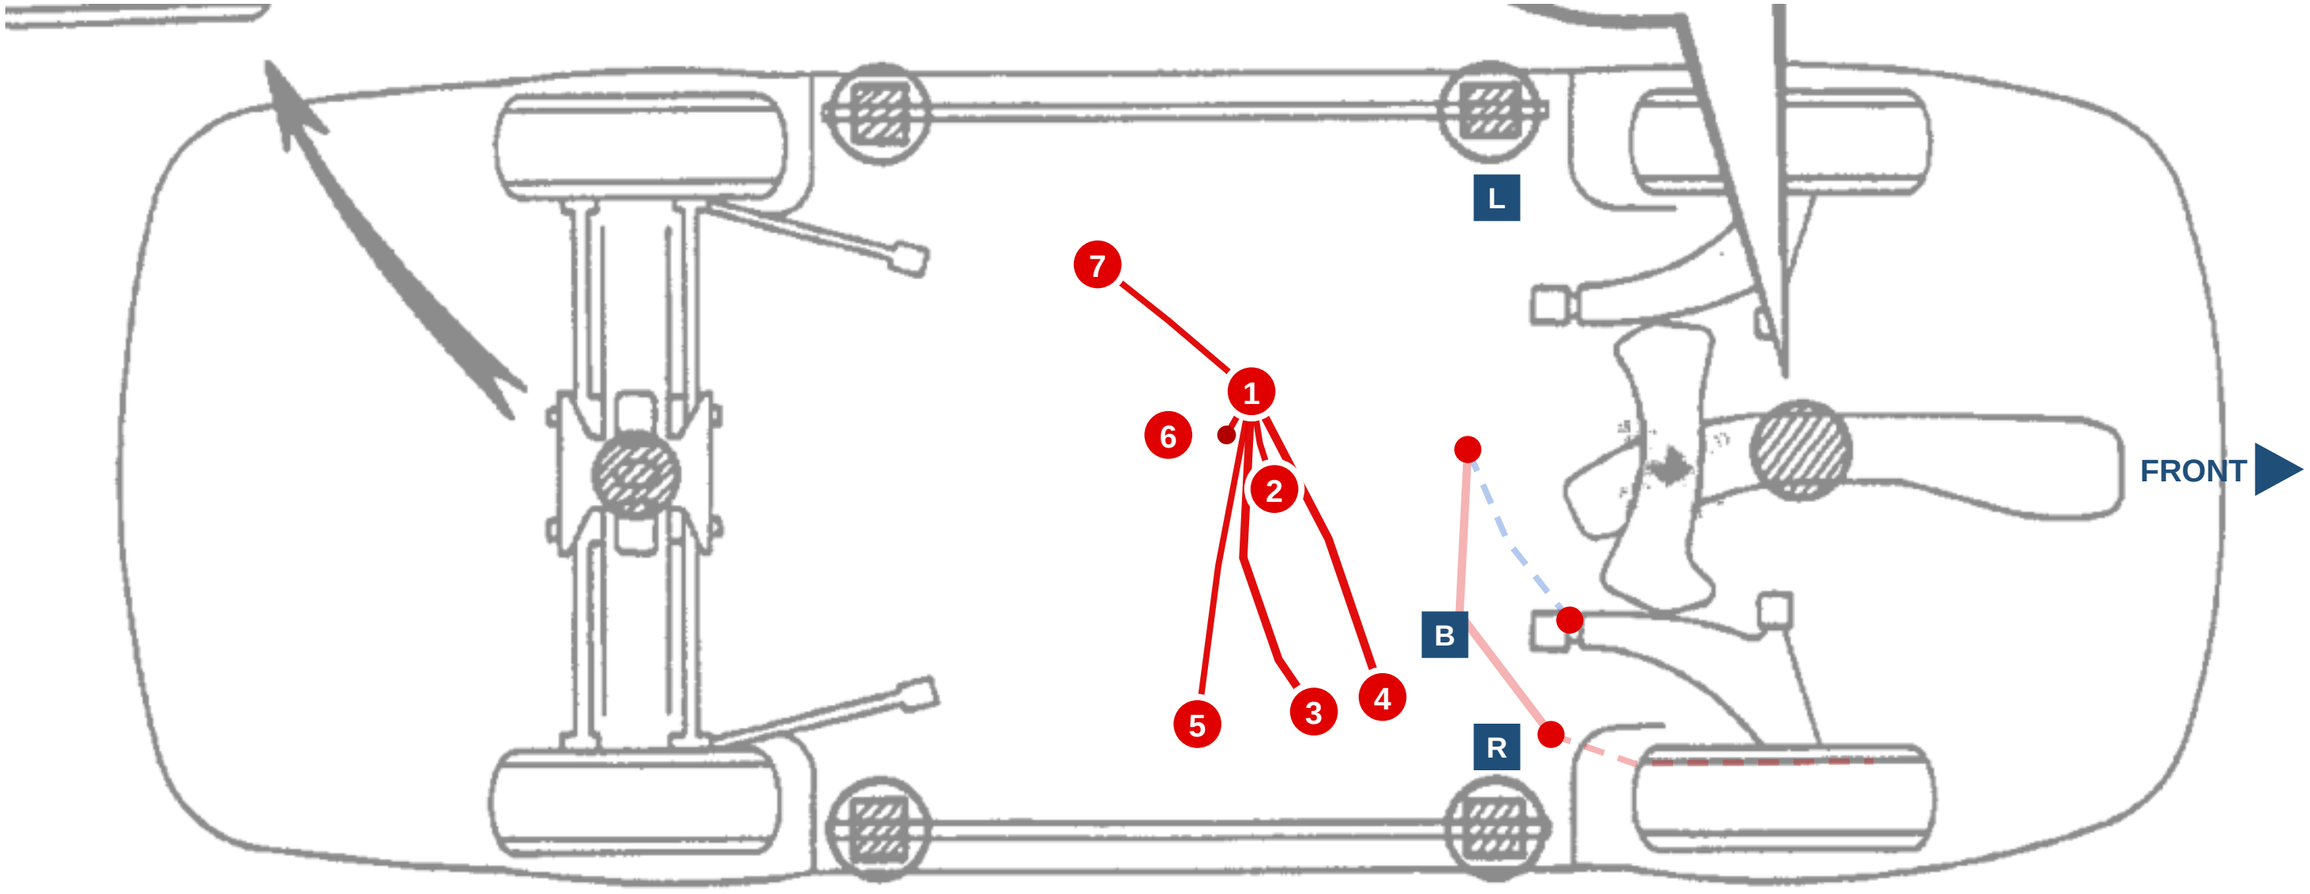

PASSENGER (RH) SIDE

REVISIONS

REV	DATE	BY	DESCRIPTION
C	2026-10-26	DG	A15 lock-sensor input takes a modified tacho: Ign 8 through 4.7 k· to pin 9 (N61 workaround).
D	2026-10-26	DG	Car-check answers: if the ignition-switch black-orange wire is at the engine plug, remove it; A/C s...
E	2026-10-26	DG	C11 is hardware starter interlock only; Aux 8 spare. Oil LED stays on CSB3 L4.
F	2026-10-26	DG	Each grouped section is its own page. A schematic page holds six wires, each in its own line colo...


ST185-harness - every wiring harness of the car, one drawing set

Layout - ST185-AntiTheft - ROUTE-14-ANTITHEFT

DRAWING NO.	REV	SHEET	SIZE	DRAWN	DATE
ST185-harness-LAY	F	49 OF 65	432 x 279 mm	DG	2026-10-26

LAYOUT - ST185-AntiTheft - ROUTE 14 ANTITHEFT, as approved (3 of 4)

Fig. 2 · Engine compartment, 3S-GTE, TIS 1993 EWD p.29 (tis1993-wiring-routing.pdf, sheet 2). Firewall at top, driver side on the right. Red solid = siren leads: in through the existing factory RH fender grommet (harness C) (4, top of the RH fender by the strut tower; decided, Dan: ·2. do it·), then along the firewall to the siren at the center of the firewall behind the engine (8). Red dashed = hood-pin lead riding harness C down the RH inner fend...

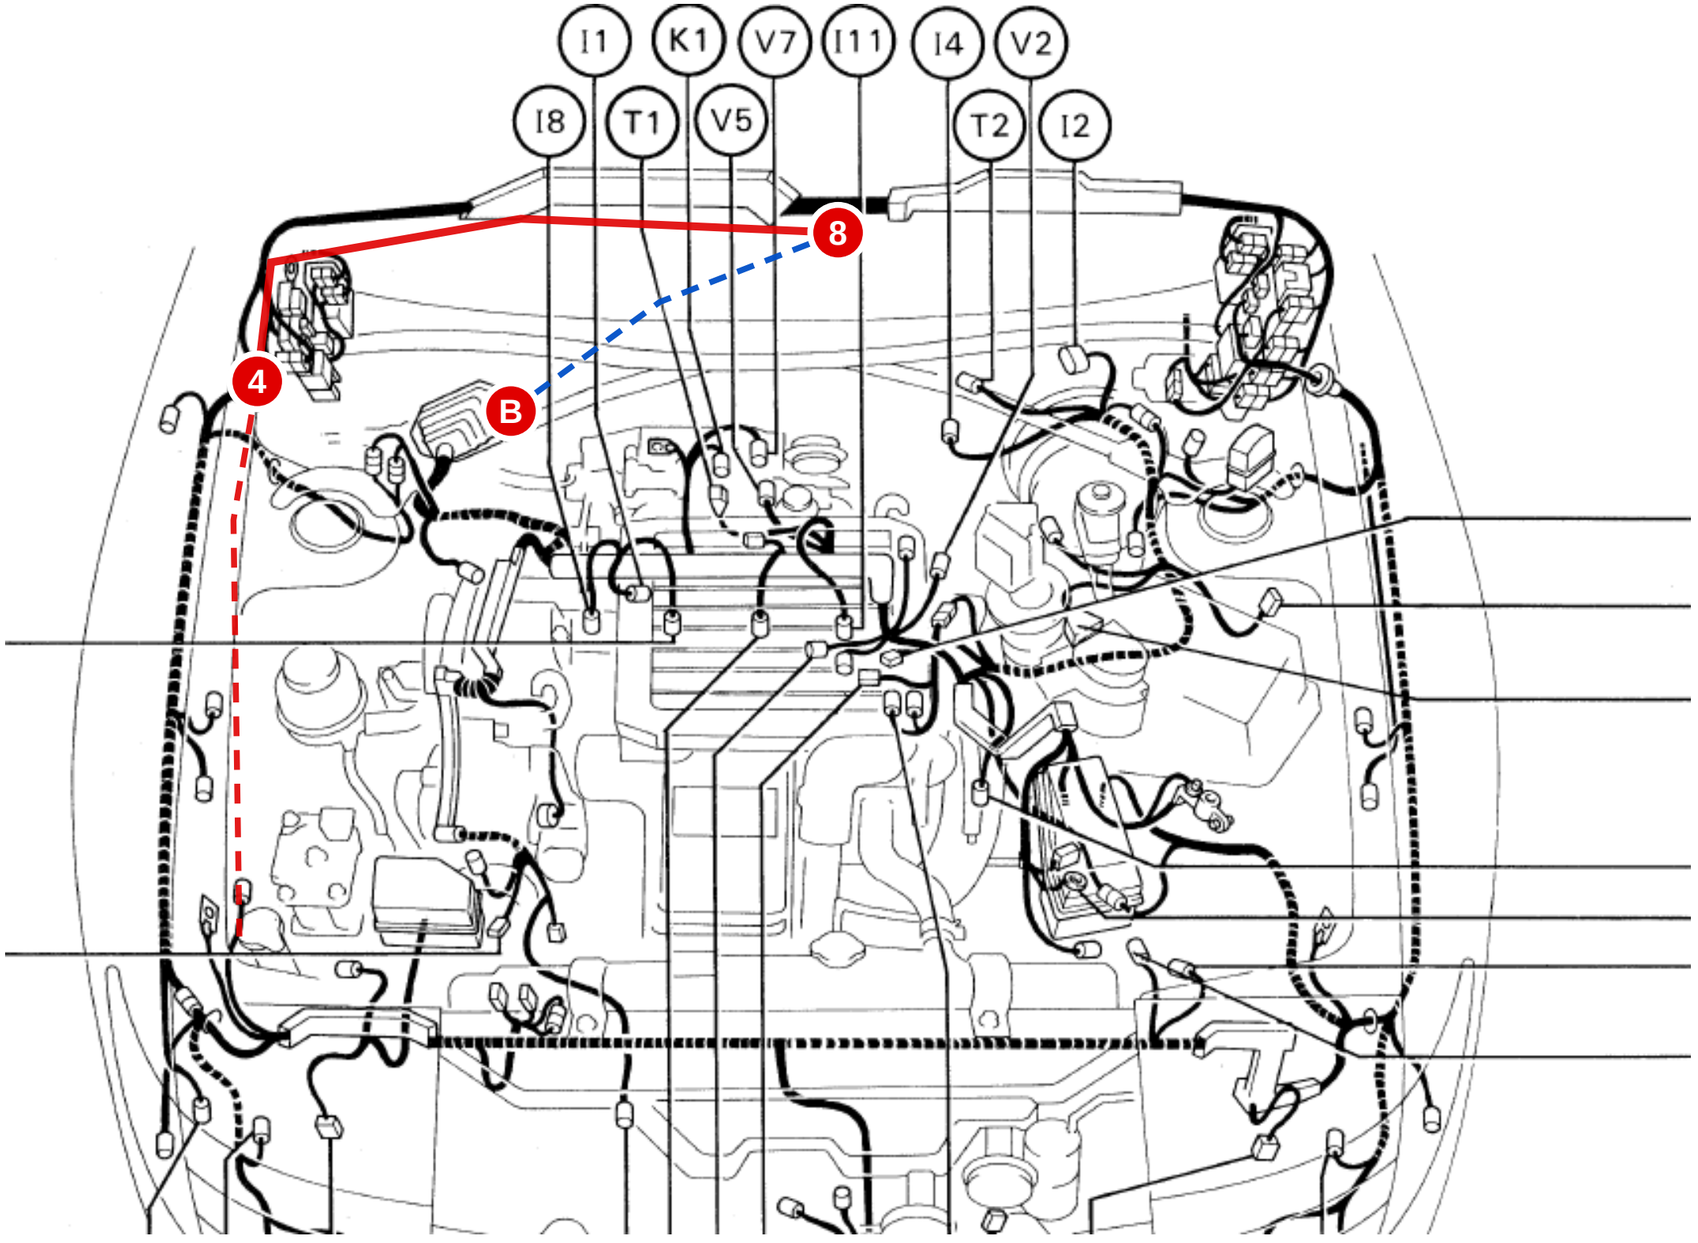

REVISIONS

REV	DATE	BY	DESCRIPTION
C	2026-10-26	DG	A15 lock-sensor input takes a modified tacho: Ign 8 through 4.7 k· to pin 9 (N61 workaround).
D	2026-10-26	DG	Car-check answers: if the ignition-switch black-orange wire is at the engine plug, remove it; A/C s...
E	2026-10-26	DG	C11 is hardware starter interlock only; Aux 8 spare. Oil LED stays on CSB3 L4.
F	2026-10-26	DG	Each grouped section is its own page. A schematic page holds six wires, each in its own line colo...

ST185-harness - every wiring harness of the car, one drawing set

Layout - ST185-AntiTheft - ROUTE-14-ANTITHEFT


DRAWING NO.	REV	SHEET	SIZE	DRAWN	DATE
ST185-harness-LAY	F	50 OF 65	432 x 279 mm	DG	2026-10-26

ST185 Celica (living-relation) - generated by docs/harness/tools/build_drawings.py from docs/harness/MASTER-wirelist.csv; not to scale

LAYOUT - ST185-AntiTheft - ROUTE 14 ANTITHEFT, as approved (4 of 4)

Top view for the figure above · same route, same colors. Projected from the figure above (approximate); this figure·s part is bright, the rest of the route is faded. Blue squares: B = bulkhead A/B (DRB102, RH firewall), R / L = RH / LH fender pass-throughs (Route 9 rev 2). Top view base: 1993 Celica repair manual RM305U1, Introduction, ·Vehicle Lift and Support Locations·, p. IN·24 (st185-celica-repair-manual\manuals\RM305U1 - Introduction - Ve...

DRIVER (LH) SIDE

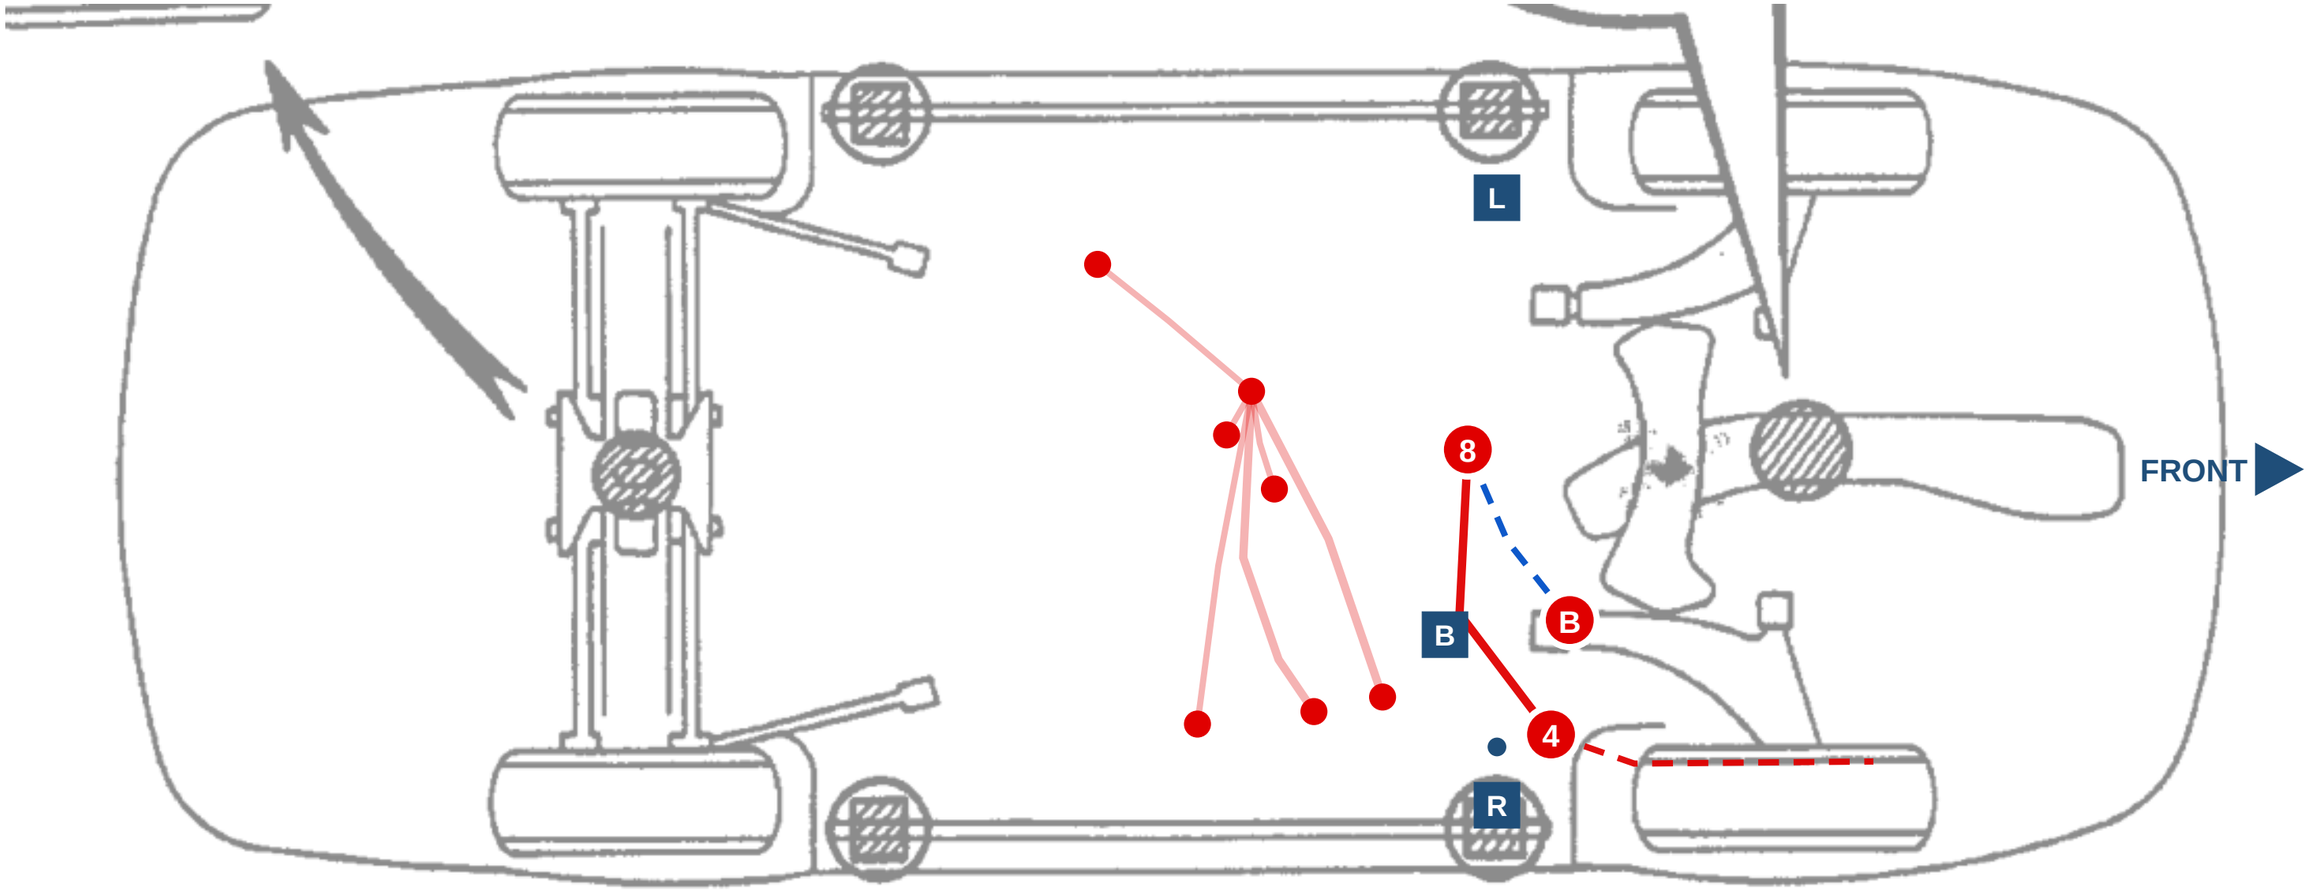

PASSENGER (RH) SIDE

REVISIONS

REV	DATE	BY	DESCRIPTION
C	2026-10-26	DG	A15 lock-sensor input takes a modified tacho: Ign 8 through 4.7 k· to pin 9 (N61 workaround).
D	2026-10-26	DG	Car-check answers: if the ignition-switch black-orange wire is at the engine plug, remove it; A/C s...
E	2026-10-26	DG	C11 is hardware starter interlock only; Aux 8 spare. Oil LED stays on CSB3 L4.
F	2026-10-26	DG	Each grouped section is its own page. A schematic page holds six wires, each in its own line colo...

ST185-harness - every wiring harness of the car, one drawing set


Layout - ST185-AntiTheft - ROUTE-14-ANTITHEFT

DRAWING NO.	REV	SHEET	SIZE	DRAWN	DATE
ST185-harness-LAY	F	51 OF 65	432 x 279 mm	DG	2026-10-26

ST185 Celica (living-relation) - generated by docs/harness/tools/build_drawings.py from docs/harness/MASTER-wirelist.csv; not to scale

LAYOUT - ST185-ClusterLED - ROUTE 13 CLUSTERLED, as approved (1 of 2)

Fig. 1 · Instrument panel, TIS 1993 EWD ·Relay Locations· p.18 (tis1993-relay-locations.pdf, sheet 1). Driver side left, glove box right. Deleted parts still drawn on this page are not used. Red solid = ClusterLED: the LED board at the old combination-meter spot (center cluster), tapping the factory meter connectors C11 / C12 with flying leads, and the LED common return to OEM ground ID at the left kick panel. Dashed = the oil-pressure LED sig...

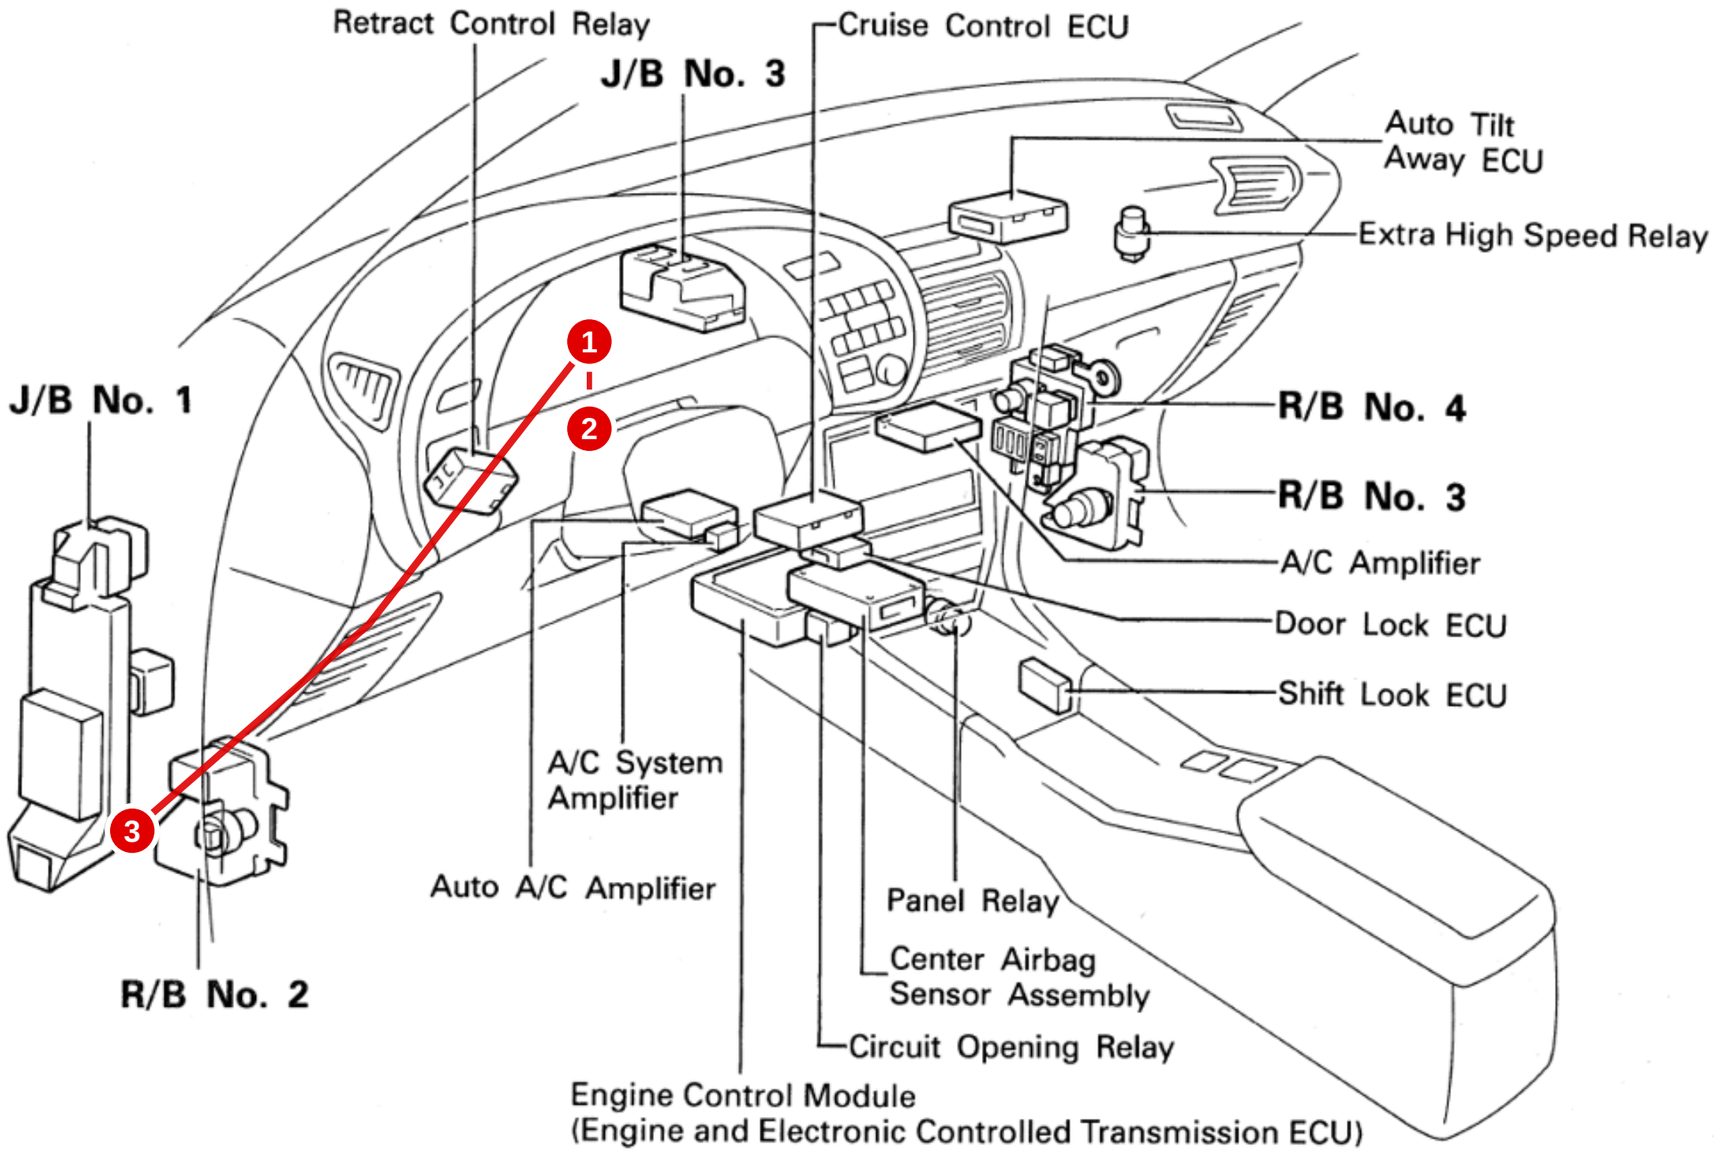

REVISIONS			
REV	DATE	BY	DESCRIPTION
C	2026-10-26	DG	A15 lock-sensor input takes a modified tacho: Ign 8 through 4.7 k· to pin 9 (N61 workaround).
D	2026-10-26	DG	Car-check answers: if the ignition-switch black-orange wire is at the engine plug, remove it; A/C s...
E	2026-10-26	DG	C11 is hardware starter interlock only; Aux 8 spare. Oil LED stays on CSB3 L4.
F	2026-10-26	DG	Each grouped section is its own page. A schematic page holds six wires, each in its own line colo...

ST185-harness - every wiring harness of the car, one drawing set

Layout - ST185-ClusterLED - ROUTE-13-CLUSTERLED


DRAWING NO.	REV	SHEET	SIZE	DRAWN	DATE
ST185-harness-LAY	F	52 OF 65	432 x 279 mm	DG	2026-10-26

ST185 Celica (living-relation) - generated by docs/harness/tools/build_drawings.py from docs/harness/MASTER-wirelist.csv; not to scale

LAYOUT - ST185-ClusterLED - ROUTE 13 CLUSTERLED, as approved (2 of 2)

Top view for the figure above · same route, same colors. Projected from the figure above (approximate); this figure·s part is bright, the rest of the route is faded. Blue squares: B = bulkhead A/B (DRB102, RH firewall), R / L = RH / LH fender pass-throughs (Route 9 rev 2). Top view base: 1993 Celica repair manual RM305U1, Introduction, ·Vehicle Lift and Support Locations·, p. IN·24 (st185-celica-repair-manual\manuals\RM305U1 - Introduction - Ve...

DRIVER (LH) SIDE

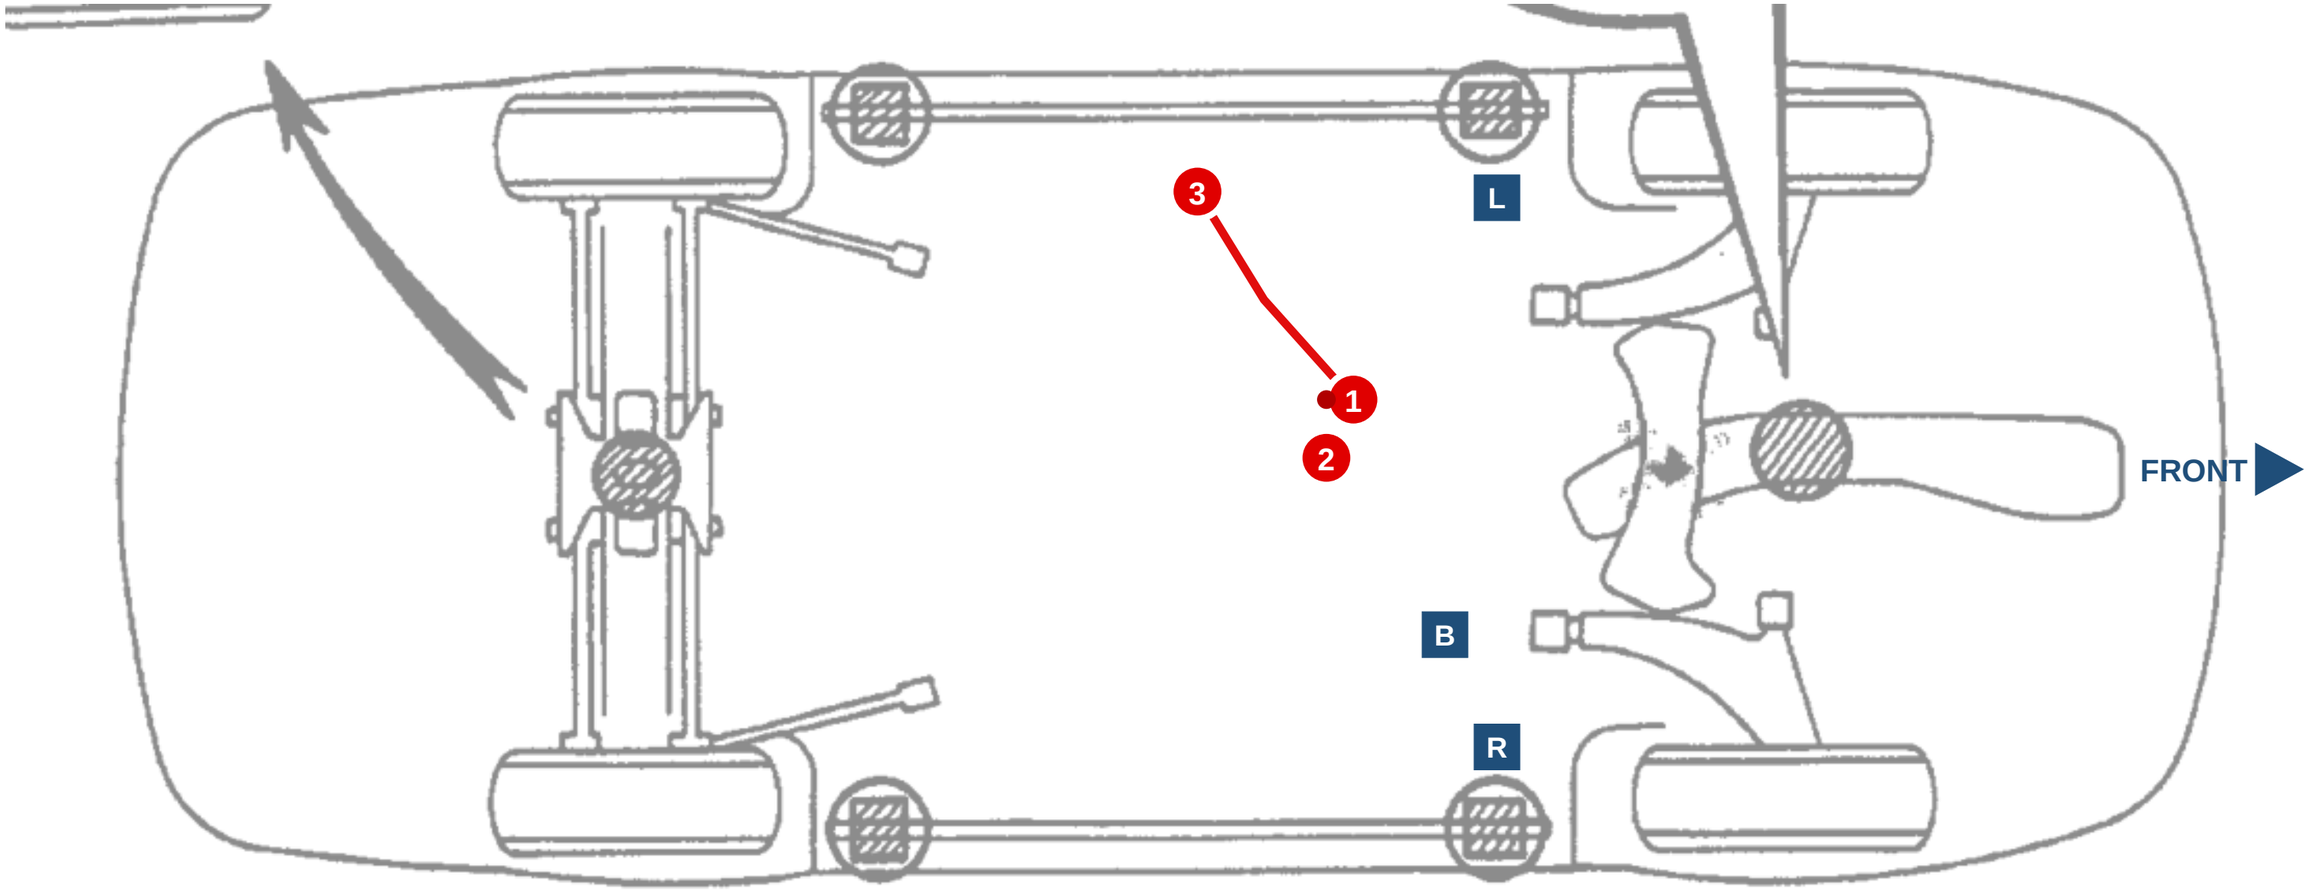

PASSENGER (RH) SIDE

REVISIONS

REV	DATE	BY	DESCRIPTION
C	2026-10-26	DG	A15 lock-sensor input takes a modified tacho: Ign 8 through 4.7 k· to pin 9 (N61 workaround).
D	2026-10-26	DG	Car-check answers: if the ignition-switch black-orange wire is at the engine plug, remove it; A/C s...
E	2026-10-26	DG	C11 is hardware starter interlock only; Aux 8 spare. Oil LED stays on CSB3 L4.
F	2026-10-26	DG	Each grouped section is its own page. A schematic page holds six wires, each in its own line colo...

ST185-harness - every wiring harness of the car, one drawing set


Layout - ST185-ClusterLED - ROUTE-13-CLUSTERLED

DRAWING NO.	REV	SHEET	SIZE	DRAWN	DATE
ST185-harness-LAY	F	53 OF 65	432 x 279 mm	DG	2026-10-26

ST185 Celica (living-relation) - generated by docs/harness/tools/build_drawings.py from docs/harness/MASTER-wirelist.csv; not to scale

LAYOUT - ST185-WheelSpeed-Front - ROUTE 9 WHEELSPEED FRONT, as approved (1 of 4)

Fig. 2 · Engine compartment, 3S-GTE, TIS 1993 EWD ·Position of Parts in Engine Compartment· p.28 (tis1993-wiring-routing.pdf, sheet 1). Firewall at top, driver side on the right. Rev 2 (Dan·s blue mark-up): each fender pass-through is at the top of the fender near the firewall, at the connector cluster by the strut tower (2 driver side, 4 passenger side). From there each sensor cable runs down along the existing fender harness (the dashed factory ...

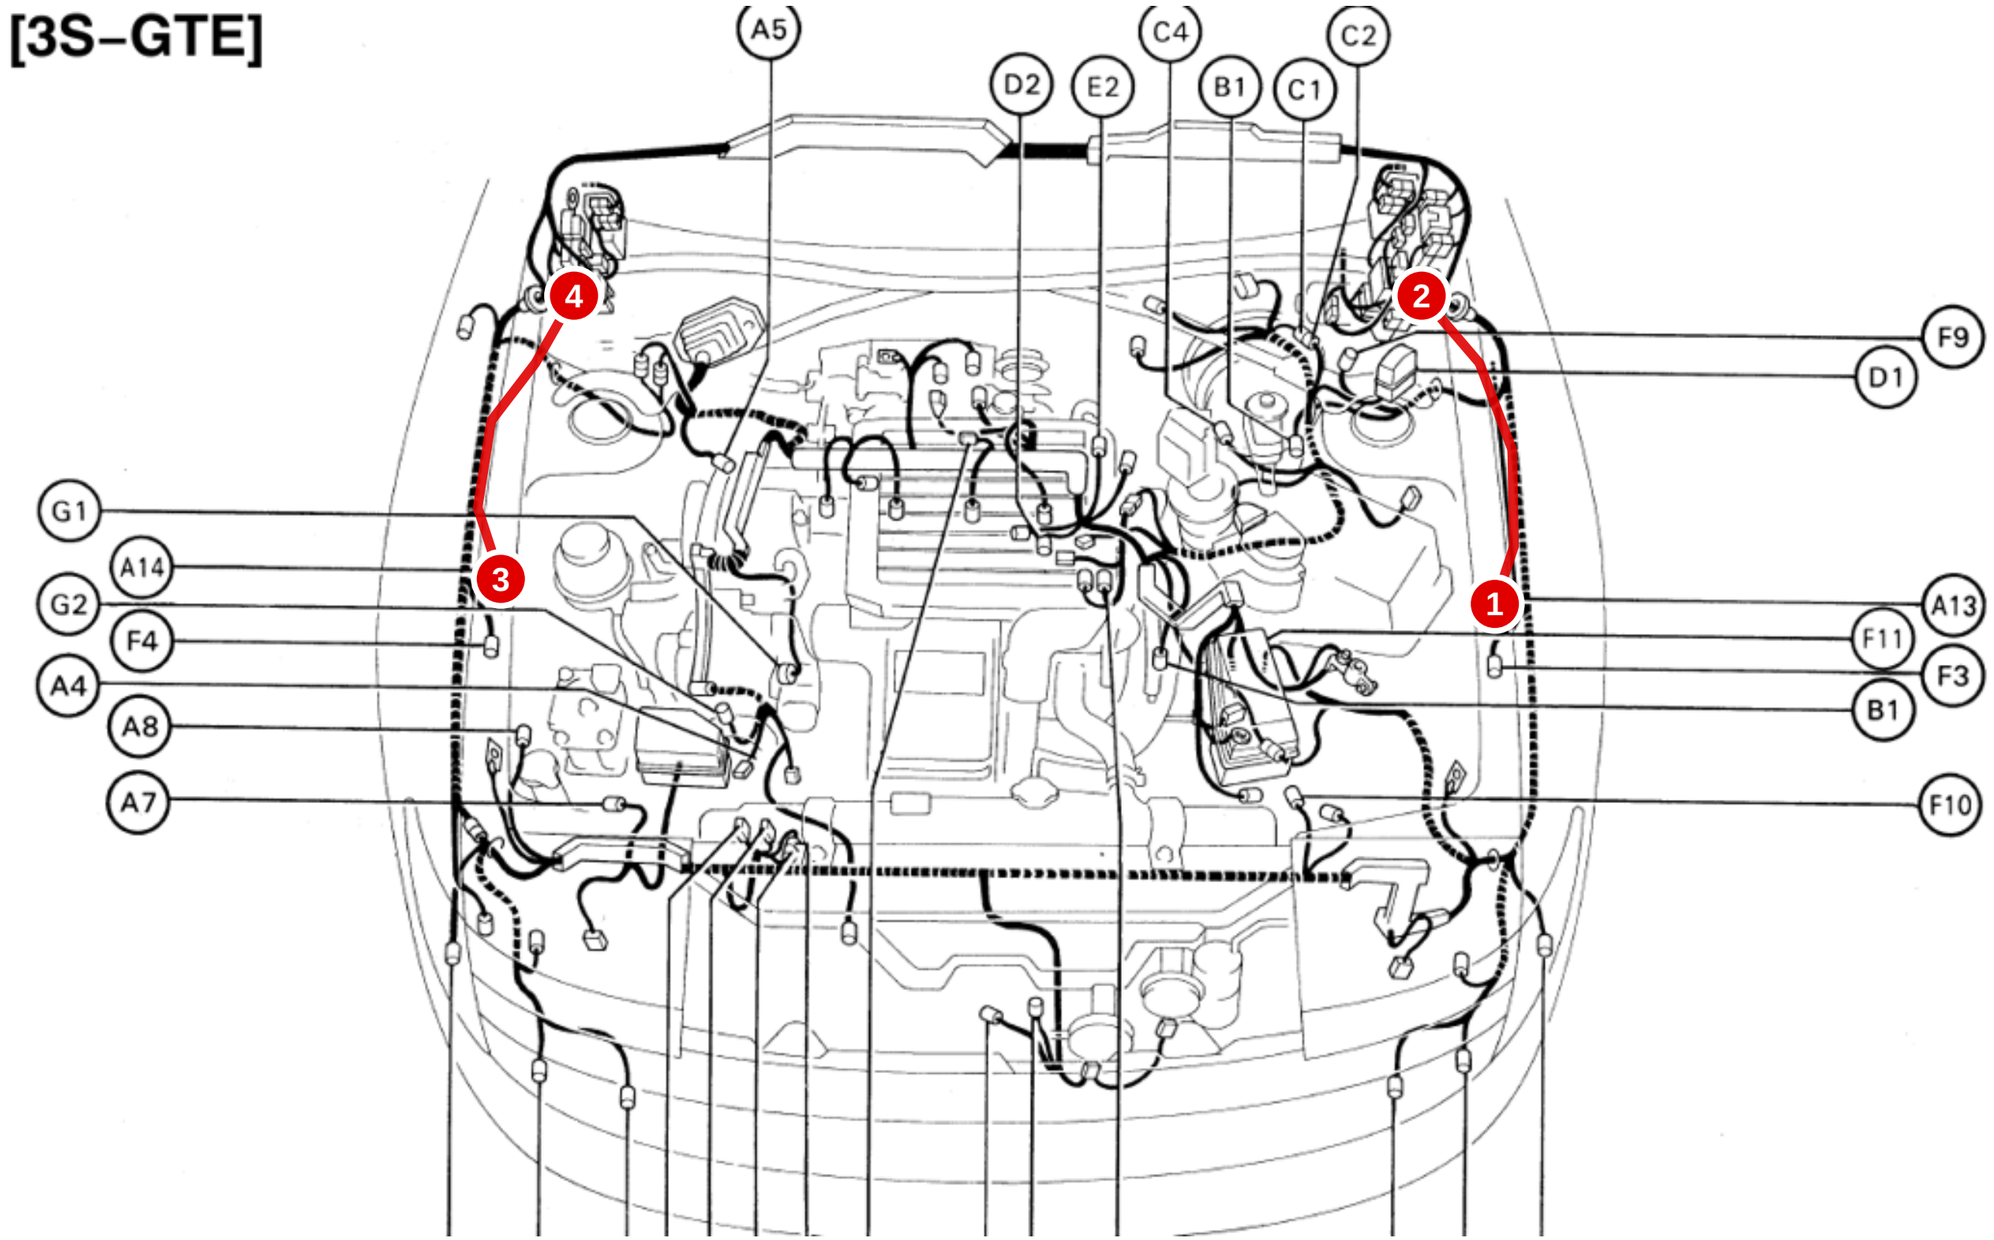

REVISIONS			
REV	DATE	BY	DESCRIPTION
C	2026-10-26	DG	A15 lock-sensor input takes a modified tacho: Ign 8 through 4.7 k· to pin 9 (N61 workaround).
D	2026-10-26	DG	Car-check answers: if the ignition-switch black-orange wire is at the engine plug, remove it; A/C s...
E	2026-10-26	DG	C11 is hardware starter interlock only; Aux 8 spare. Oil LED stays on CSB3 L4.
F	2026-10-26	DG	Each grouped section is its own page. A schematic page holds six wires, each in its own line colo...

ST185-harness - every wiring harness of the car, one drawing set


Layout - ST185-WheelSpeed-Front - ROUTE-9-WHEELSPEED-FRONT

DRAWING NO.	REV	SHEET	SIZE	DRAWN	DATE
ST185-harness-LAY	F	54 OF 65	432 x 279 mm	DG	2026-10-26

LAYOUT - ST185-WheelSpeed-Front - ROUTE 9 WHEELSPEED FRONT, as approved (2 of 4)

Top view for the figure above · same route, same colors. Projected from the figure above (approximate); this figure·s part is bright, the rest of the route is faded. Blue squares: B = bulkhead A/B (DRB102, RH firewall), R / L = RH / LH fender pass-throughs (Route 9 rev 2). Top view base: 1993 Celica repair manual RM305U1, Introduction, ·Vehicle Lift and Support Locations·, p. IN·24 (st185-celica-repair-manual\manuals\RM305U1 - Introduction - Ve...

DRIVER (LH) SIDE

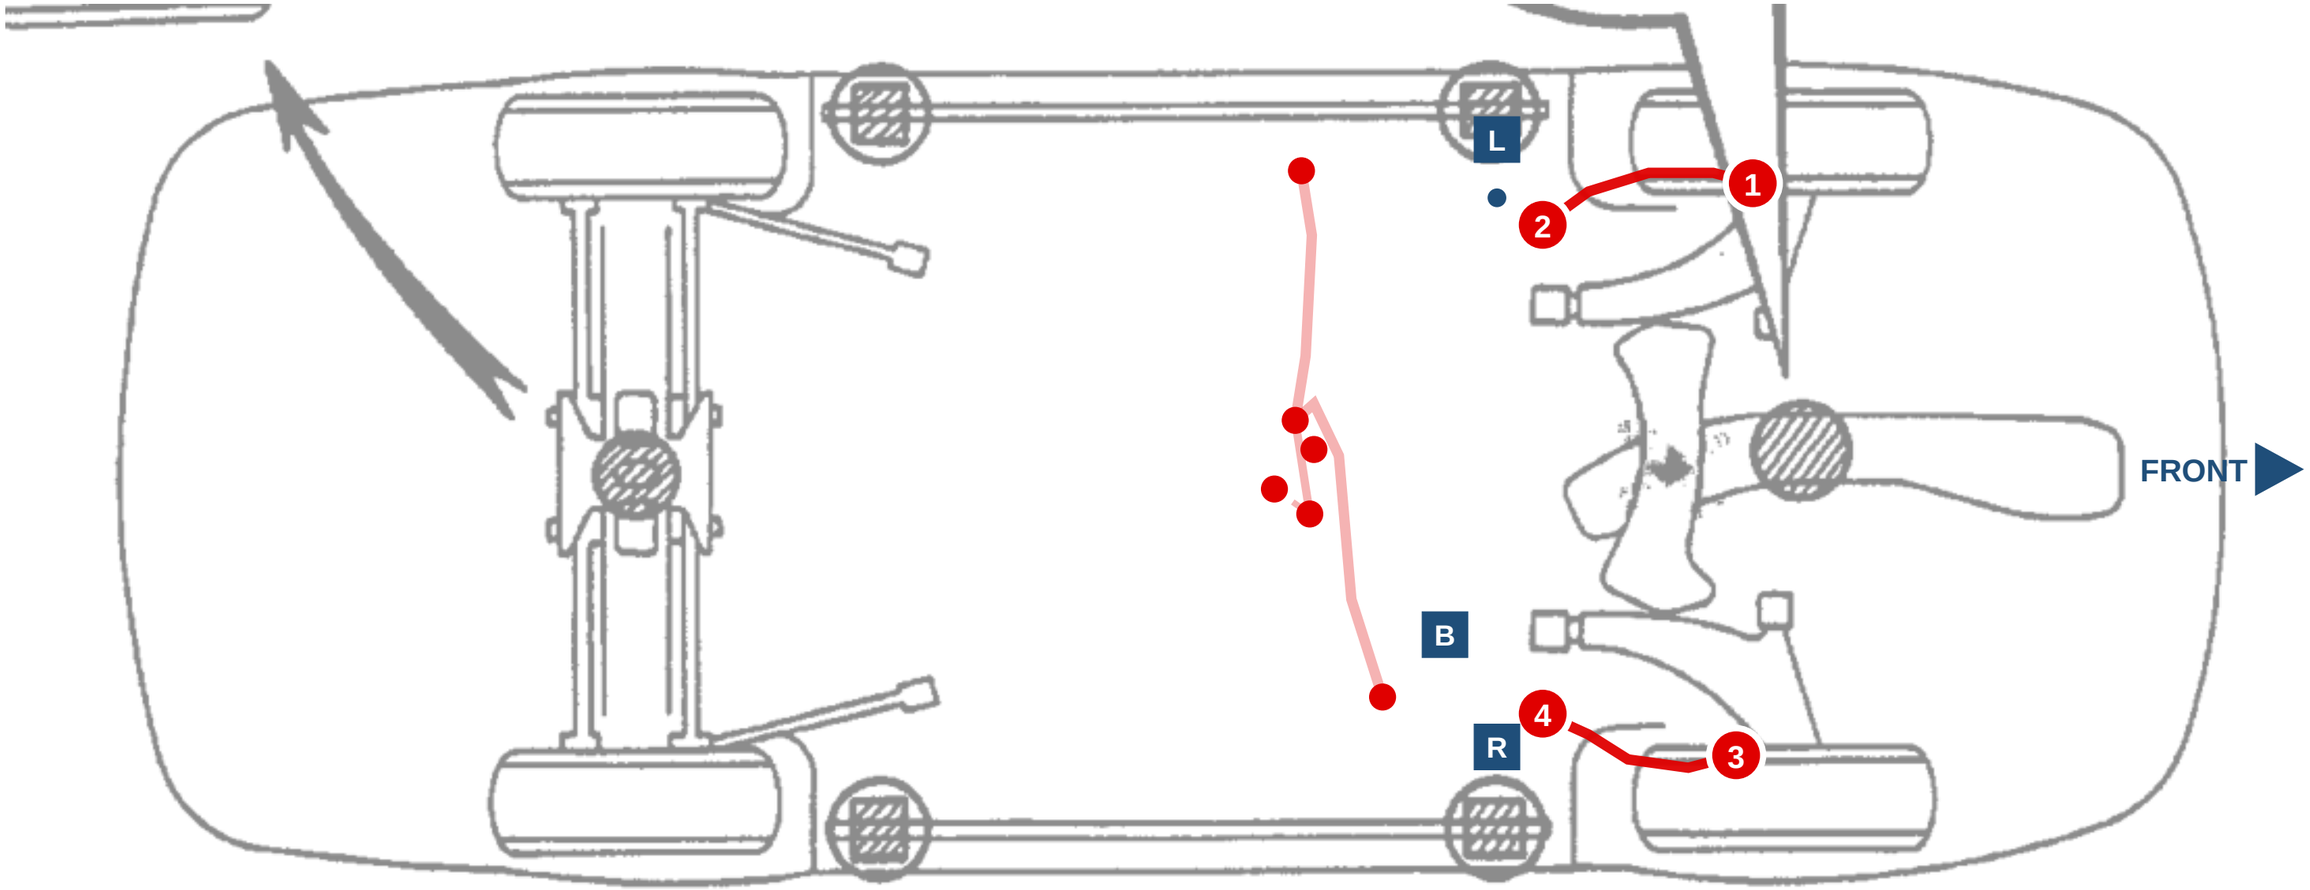

PASSENGER (RH) SIDE

REVISIONS

REV	DATE	BY	DESCRIPTION
C	2026-10-26	DG	A15 lock-sensor input takes a modified tacho: Ign 8 through 4.7 k· to pin 9 (N61 workaround).
D	2026-10-26	DG	Car-check answers: if the ignition-switch black-orange wire is at the engine plug, remove it; A/C s...
E	2026-10-26	DG	C11 is hardware starter interlock only; Aux 8 spare. Oil LED stays on CSB3 L4.
F	2026-10-26	DG	Each grouped section is its own page. A schematic page holds six wires, each in its own line colo...

ST185-harness - every wiring harness of the car, one drawing set


Layout - ST185-WheelSpeed-Front - ROUTE-9-WHEELSPEED-FRONT

DRAWING NO.	REV	SHEET	SIZE	DRAWN	DATE
ST185-harness-LAY	F	55 OF 65	432 x 279 mm	DG	2026-10-26

ST185 Celica (living-relation) - generated by docs/harness/tools/build_drawings.py from docs/harness/MASTER-wirelist.csv; not to scale

LAYOUT - ST185-WheelSpeed-Front - ROUTE 9 WHEELSPEED FRONT, as approved (3 of 4)

Fig. 1 · Instrument panel, TIS 1993 EWD ·Relay Locations· p.18 (sheet 1). Driver side left. Rev 2 (Dan·s mark-up; blue arrows with black labels = where the part sits): the FL cable comes into the cabin at the driver kick panel by J/B No.1 (2) and runs up past J/B1 and across under the dash; the FR cable comes in on the passenger side by the Extra High Speed relay / R/B No.4 area (4) and runs across to the center. Both end at the front VRC (5). ...

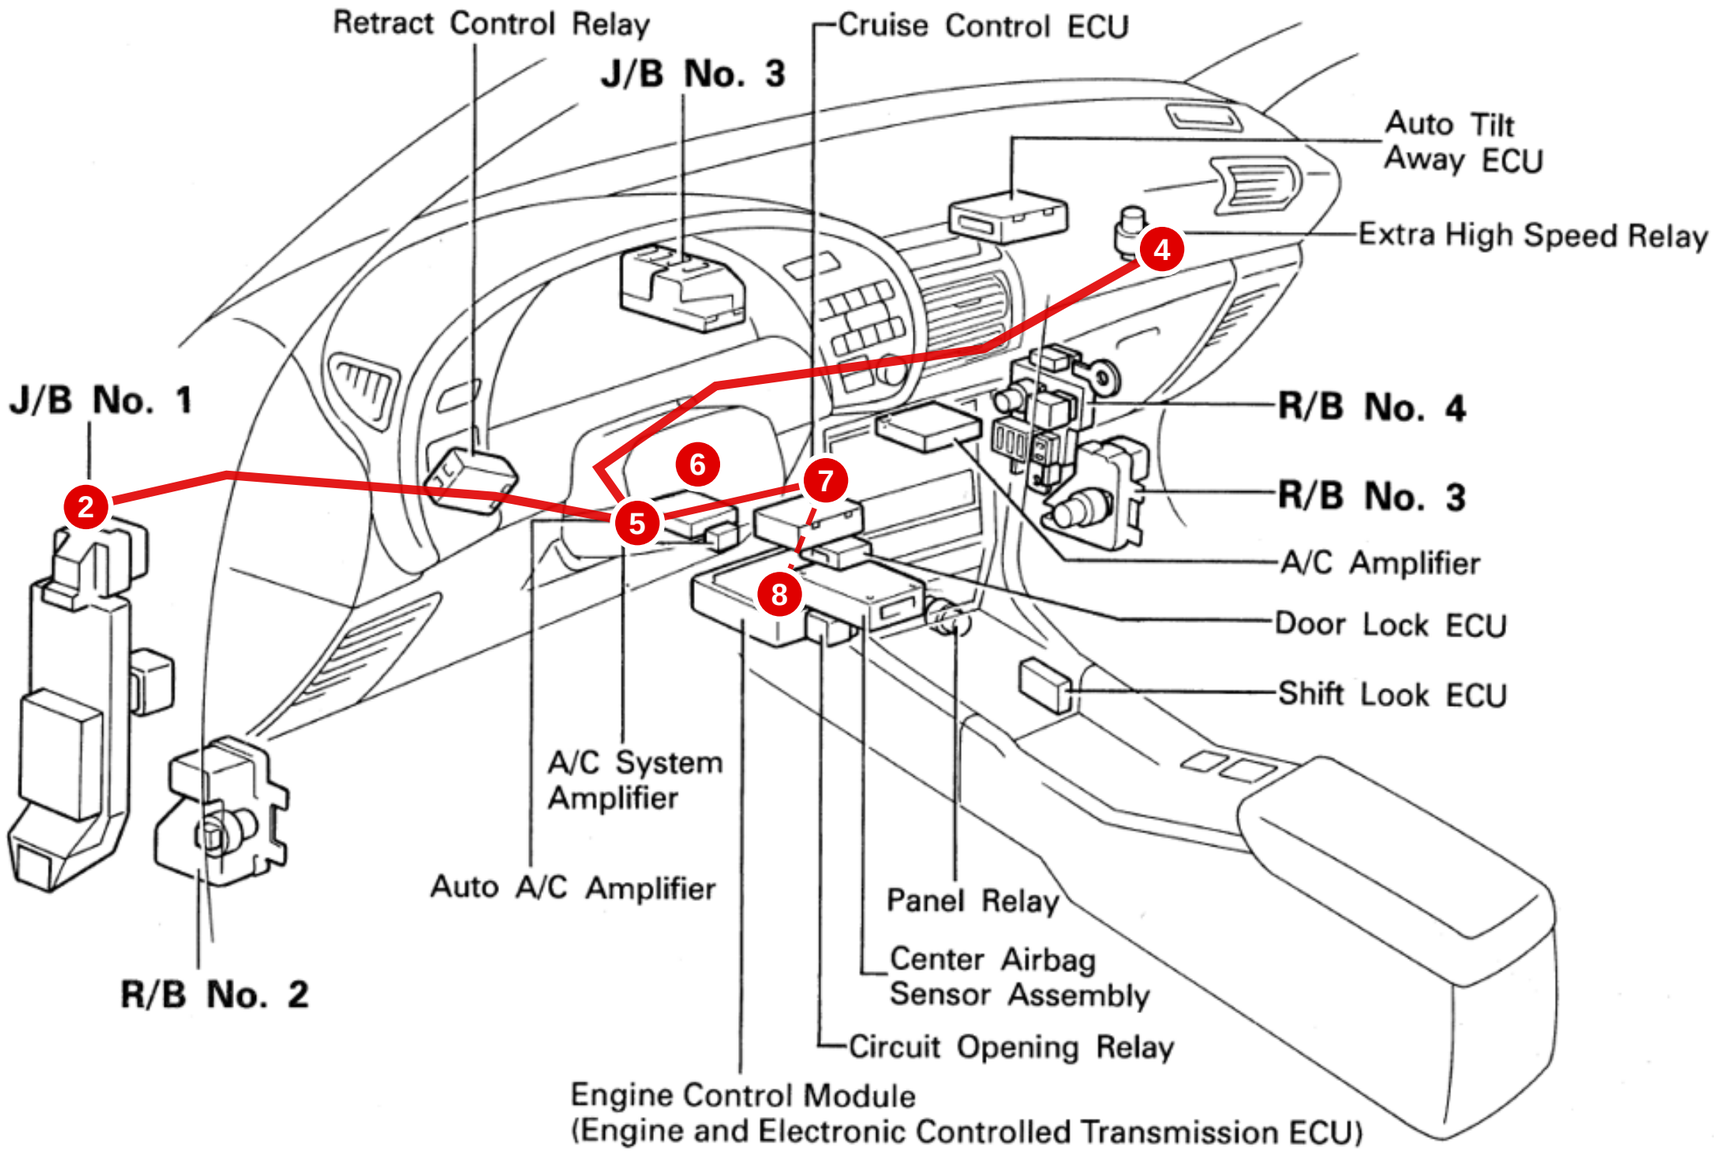

REVISIONS

REV	DATE	BY	DESCRIPTION
C	2026-10-26	DG	A15 lock-sensor input takes a modified tacho: Ign 8 through 4.7 k· to pin 9 (N61 workaround).
D	2026-10-26	DG	Car-check answers: if the ignition-switch black-orange wire is at the engine plug, remove it; A/C s...
E	2026-10-26	DG	C11 is hardware starter interlock only; Aux 8 spare. Oil LED stays on CSB3 L4.
F	2026-10-26	DG	Each grouped section is its own page. A schematic page holds six wires, each in its own line colo...

ST185-harness - every wiring harness of the car, one drawing set

Layout - ST185-WheelSpeed-Front - ROUTE-9-WHEELSPEED-FRONT


DRAWING NO.	REV	SHEET	SIZE	DRAWN	DATE
ST185-harness-LAY	F	56 OF 65	432 x 279 mm	DG	2026-10-26

ST185 Celica (living-relation) - generated by docs/harness/tools/build_drawings.py from docs/harness/MASTER-wirelist.csv; not to scale

LAYOUT - ST185-WheelSpeed-Front - ROUTE 9 WHEELSPEED FRONT, as approved (4 of 4)

Top view for the figure above · same route, same colors. Projected from the figure above (approximate); this figure·s part is bright, the rest of the route is faded. Blue squares: B = bulkhead A/B (DRB102, RH firewall), R / L = RH / LH fender pass-throughs (Route 9 rev 2). Top view base: 1993 Celica repair manual RM305U1, Introduction, ·Vehicle Lift and Support Locations·, p. IN·24 (st185-celica-repair-manual\manuals\RM305U1 - Introduction - Ve...

DRIVER (LH) SIDE

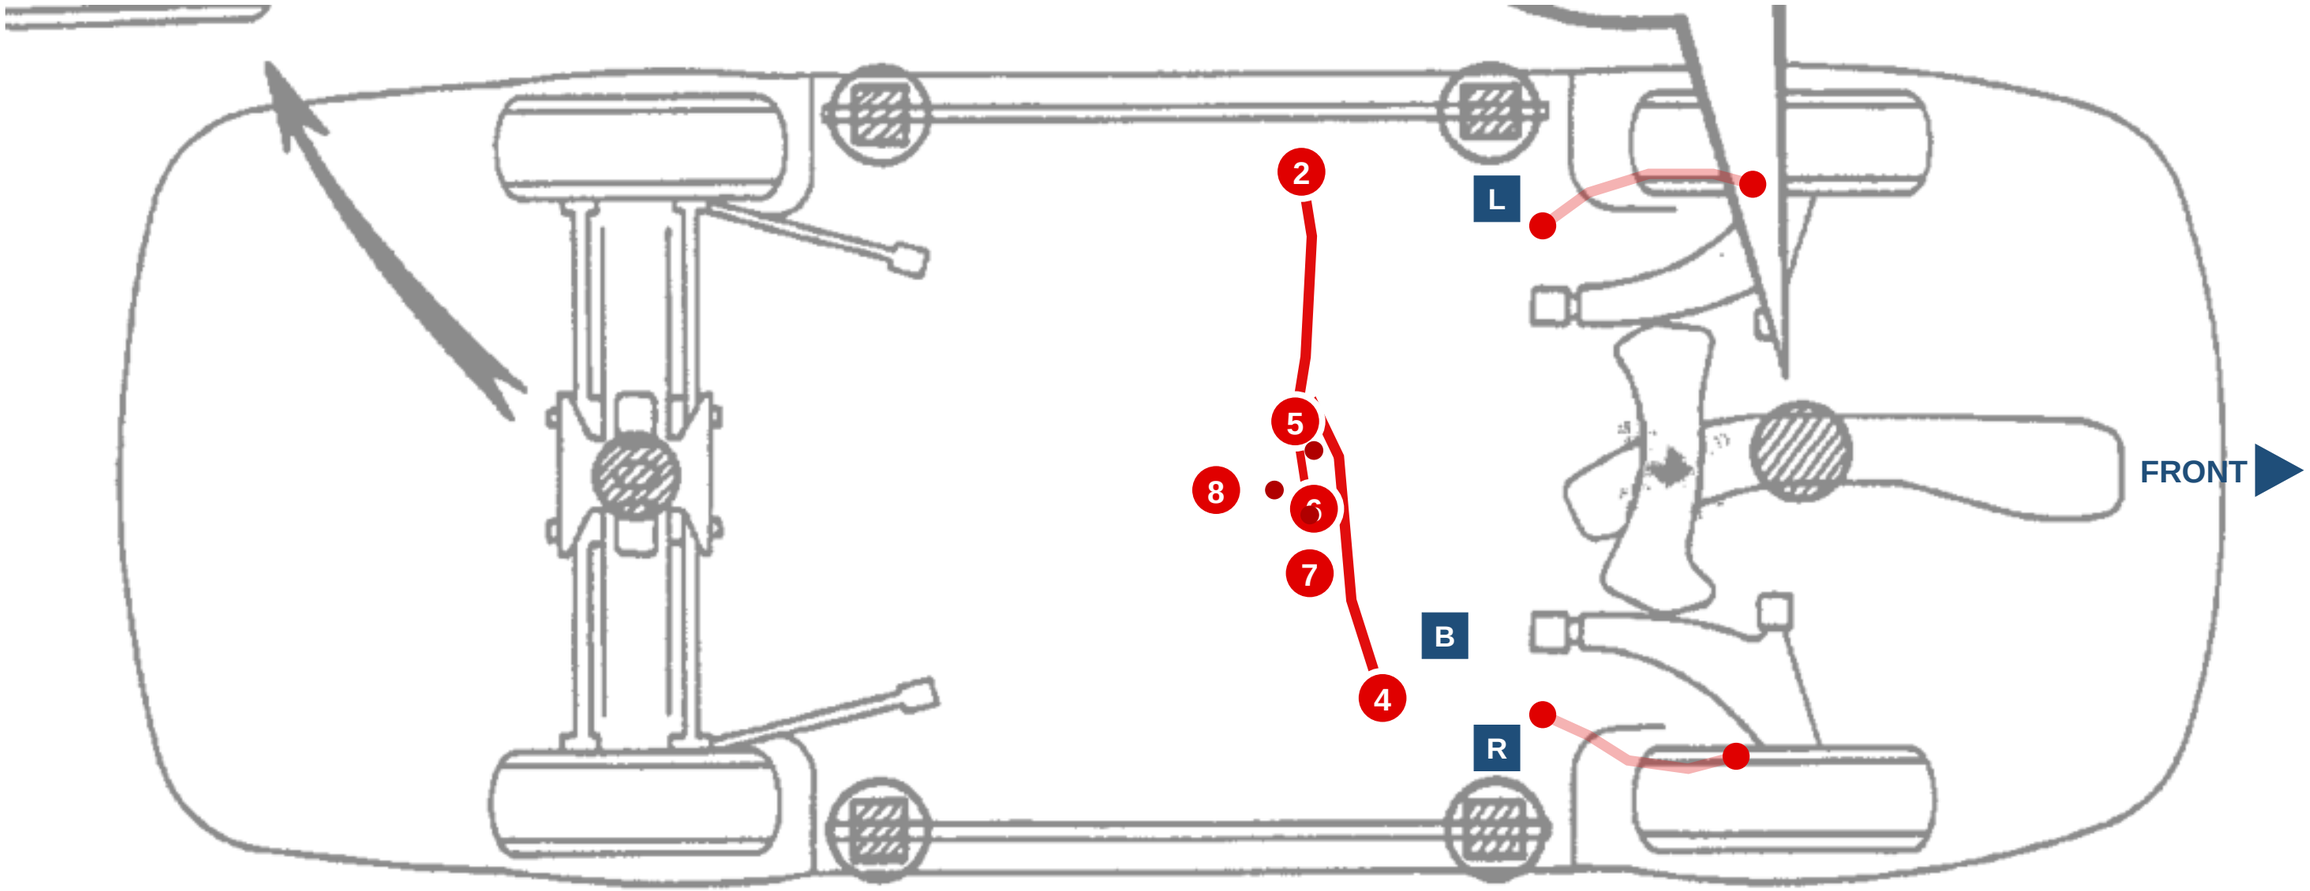

PASSENGER (RH) SIDE

REVISIONS

REV	DATE	BY	DESCRIPTION
C	2026-10-26	DG	A15 lock-sensor input takes a modified tacho: Ign 8 through 4.7 k· to pin 9 (N61 workaround).
D	2026-10-26	DG	Car-check answers: if the ignition-switch black-orange wire is at the engine plug, remove it; A/C s...
E	2026-10-26	DG	C11 is hardware starter interlock only; Aux 8 spare. Oil LED stays on CSB3 L4.
F	2026-10-26	DG	Each grouped section is its own page. A schematic page holds six wires, each in its own line colo...

ST185-harness - every wiring harness of the car, one drawing set


Layout - ST185-WheelSpeed-Front - ROUTE-9-WHEELSPEED-FRONT

DRAWING NO.	REV	SHEET	SIZE	DRAWN	DATE
ST185-harness-LAY	F	57 OF 65	432 x 279 mm	DG	2026-10-26

ST185 Celica (living-relation) - generated by docs/harness/tools/build_drawings.py from docs/harness/MASTER-wirelist.csv; not to scale

LAYOUT - ST185-WheelSpeed-Rear - ROUTE 10 WHEELSPEED REAR, as approved (1 of 4)

Fig. 1 · Body, liftback, TIS 1993 EWD p.46 (tis1993-wiring-routing-2.pdf, sheet 11). Car front on the left; the near side is the driver (LH) side. Rev 2: the rear VRC is no longer back here. The RL sensor cable (1) and the RR sensor cable (2, dashed · far side, hidden in this view) come into the cabin and meet under the rear seat on the driver side (3), then both run forward along the LH sill with the factory Floor Wire (which carried the old ABS re...

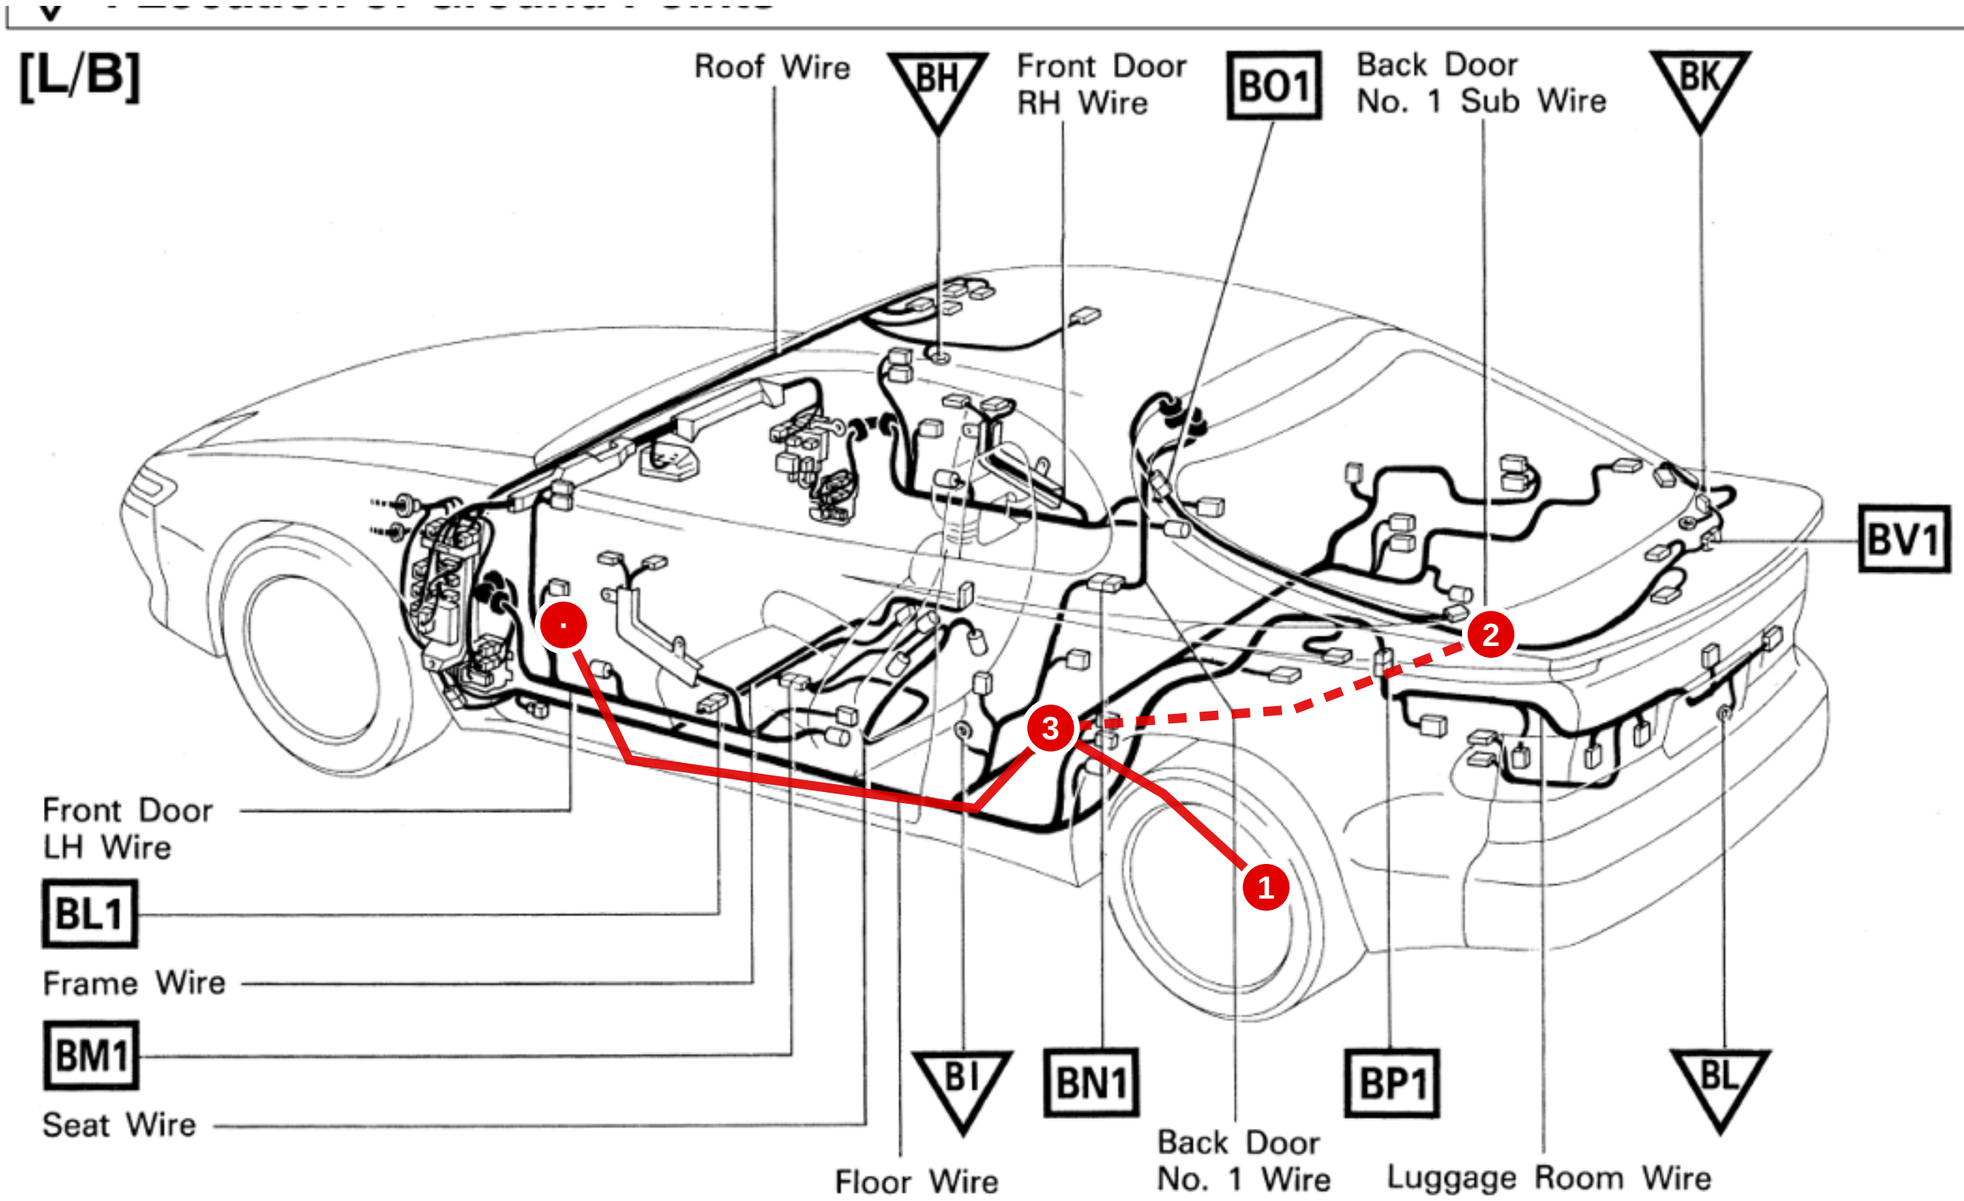

REVISIONS

REV	DATE	BY	DESCRIPTION
C	2026-10-26	DG	A15 lock-sensor input takes a modified tacho: Ign 8 through 4.7 k· to pin 9 (N61 workaround).
D	2026-10-26	DG	Car-check answers: if the ignition-switch black-orange wire is at the engine plug, remove it; A/C s...
E	2026-10-26	DG	C11 is hardware starter interlock only; Aux 8 spare. Oil LED stays on CSB3 L4.
F	2026-10-26	DG	Each grouped section is its own page. A schematic page holds six wires, each in its own line colo...

ST185-harness - every wiring harness of the car, one drawing set


Layout - ST185-WheelSpeed-Rear - ROUTE-10-WHEELSPEED-REAR

DRAWING NO.	REV	SHEET	SIZE	DRAWN	DATE
ST185-harness-LAY	F	58 OF 65	432 x 279 mm	DG	2026-10-26

LAYOUT - ST185-WheelSpeed-Rear - ROUTE 10 WHEELSPEED REAR, as approved (2 of 4)

Top view for the figure above · same route, same colors. Drawn to match the figure above (approximate); this figure·s part is bright, the rest of the route is faded. Blue squares: B = bulkhead A/B (DRB102, RH firewall), R / L = RH / LH fender pass-throughs (Route 9 rev 2). Top view base: 1993 Celica repair manual RM305U1, Introduction, ·Vehicle Lift and Support Locations·, p. IN·24 (st185-celica-repair-manual\manuals\RM305U1 - Introduction - V...

DRIVER (LH) SIDE

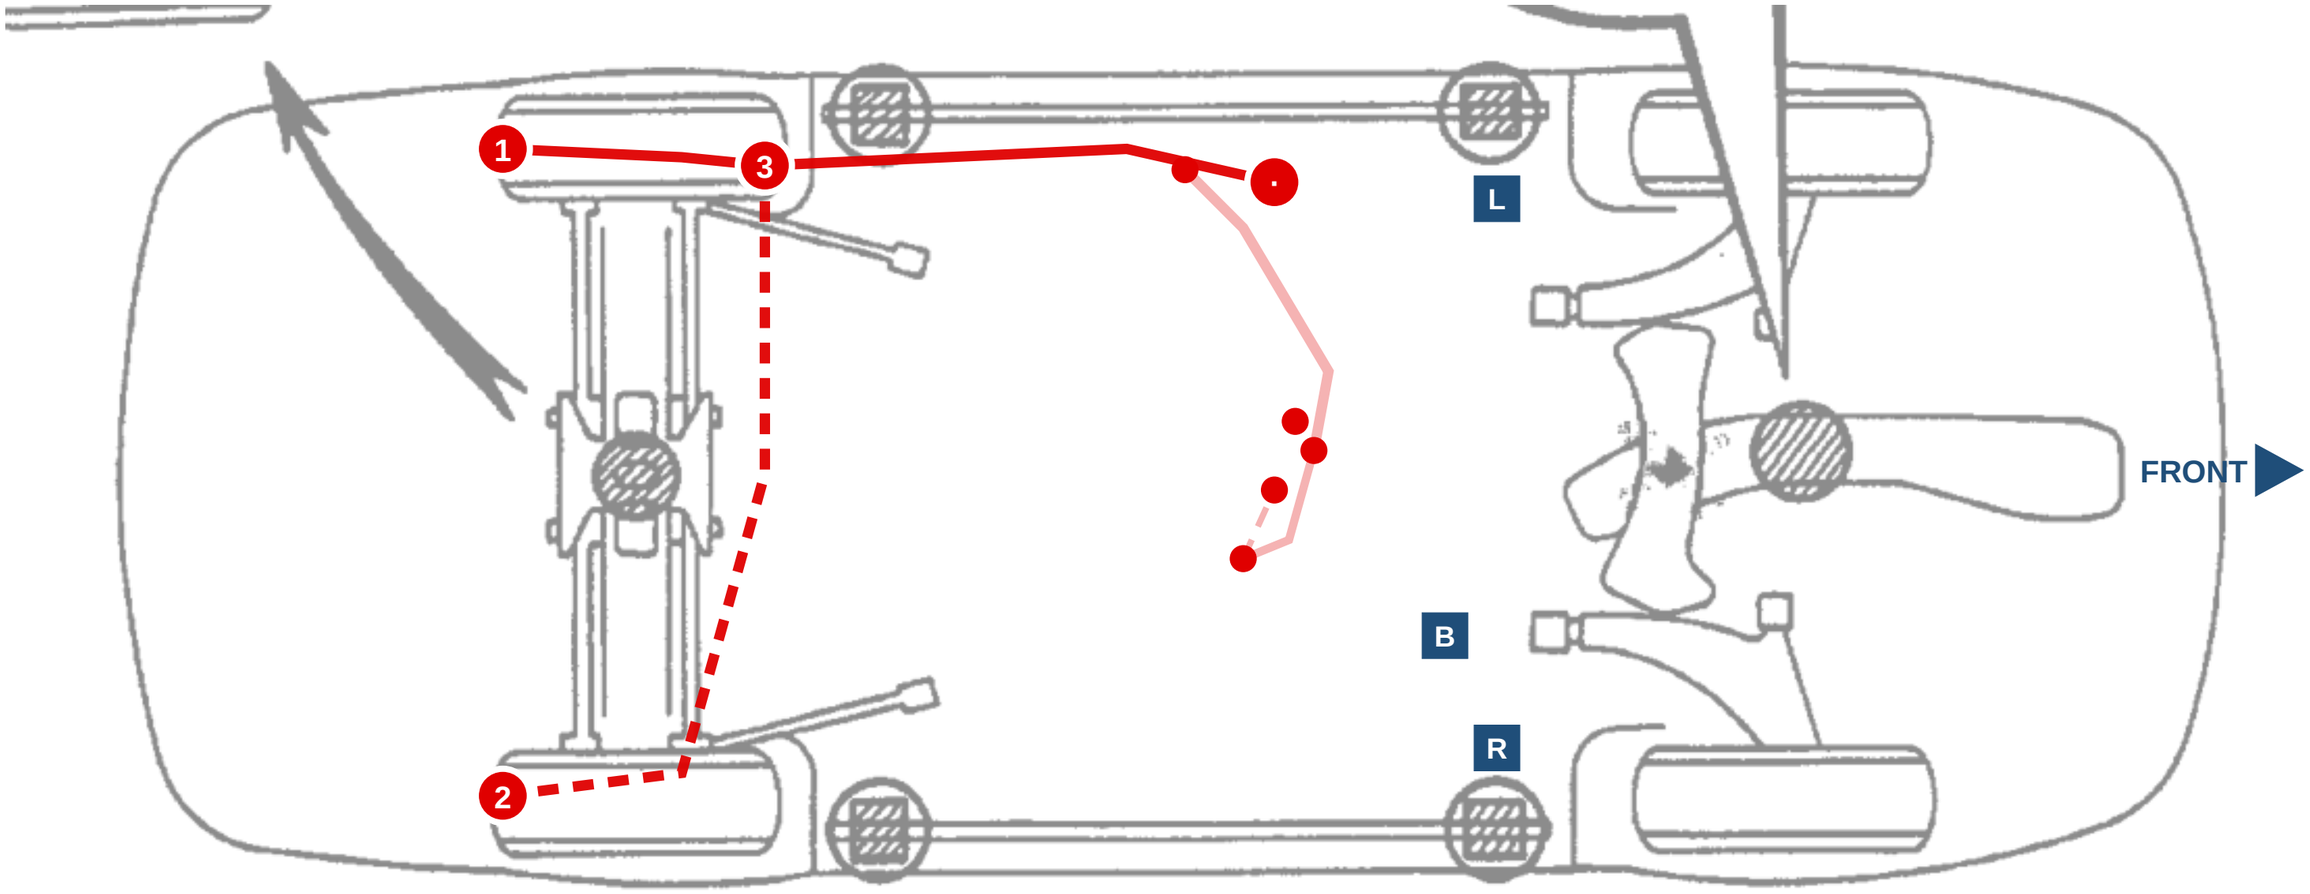

PASSENGER (RH) SIDE

REVISIONS

REV	DATE	BY	DESCRIPTION
C	2026-10-26	DG	A15 lock-sensor input takes a modified tacho: Ign 8 through 4.7 k· to pin 9 (N61 workaround).
D	2026-10-26	DG	Car-check answers: if the ignition-switch black-orange wire is at the engine plug, remove it; A/C s...
E	2026-10-26	DG	C11 is hardware starter interlock only; Aux 8 spare. Oil LED stays on CSB3 L4.
F	2026-10-26	DG	Each grouped section is its own page. A schematic page holds six wires, each in its own line colo...


ST185-harness - every wiring harness of the car, one drawing set

Layout - ST185-WheelSpeed-Rear - ROUTE-10-WHEELSPEED-REAR

DRAWING NO.	REV	SHEET	SIZE	DRAWN	DATE
ST185-harness-LAY	F	59 OF 65	432 x 279 mm	DG	2026-10-26

LAYOUT - ST185-WheelSpeed-Rear - ROUTE 10 WHEELSPEED REAR, as approved (3 of 4)

Fig. 2 · Instrument panel, TIS 1993 EWD ·Relay Locations· p.18 (sheet 1). Driver side left. Rev 2 (Dan: ·vrc x2·): the RL/RR sensor cables come up from the LH sill at the driver kick panel (4) and run across under the dash to the rear VRC (5), mid-dash right above the ECU beside the front VRC (6, Route 9). The VRC output is now a short run to IX_WS_REAR (7) next to the ECU; the spur to ECU B (8) is B-cabin (Route 6, dashed). Deleted parts st...

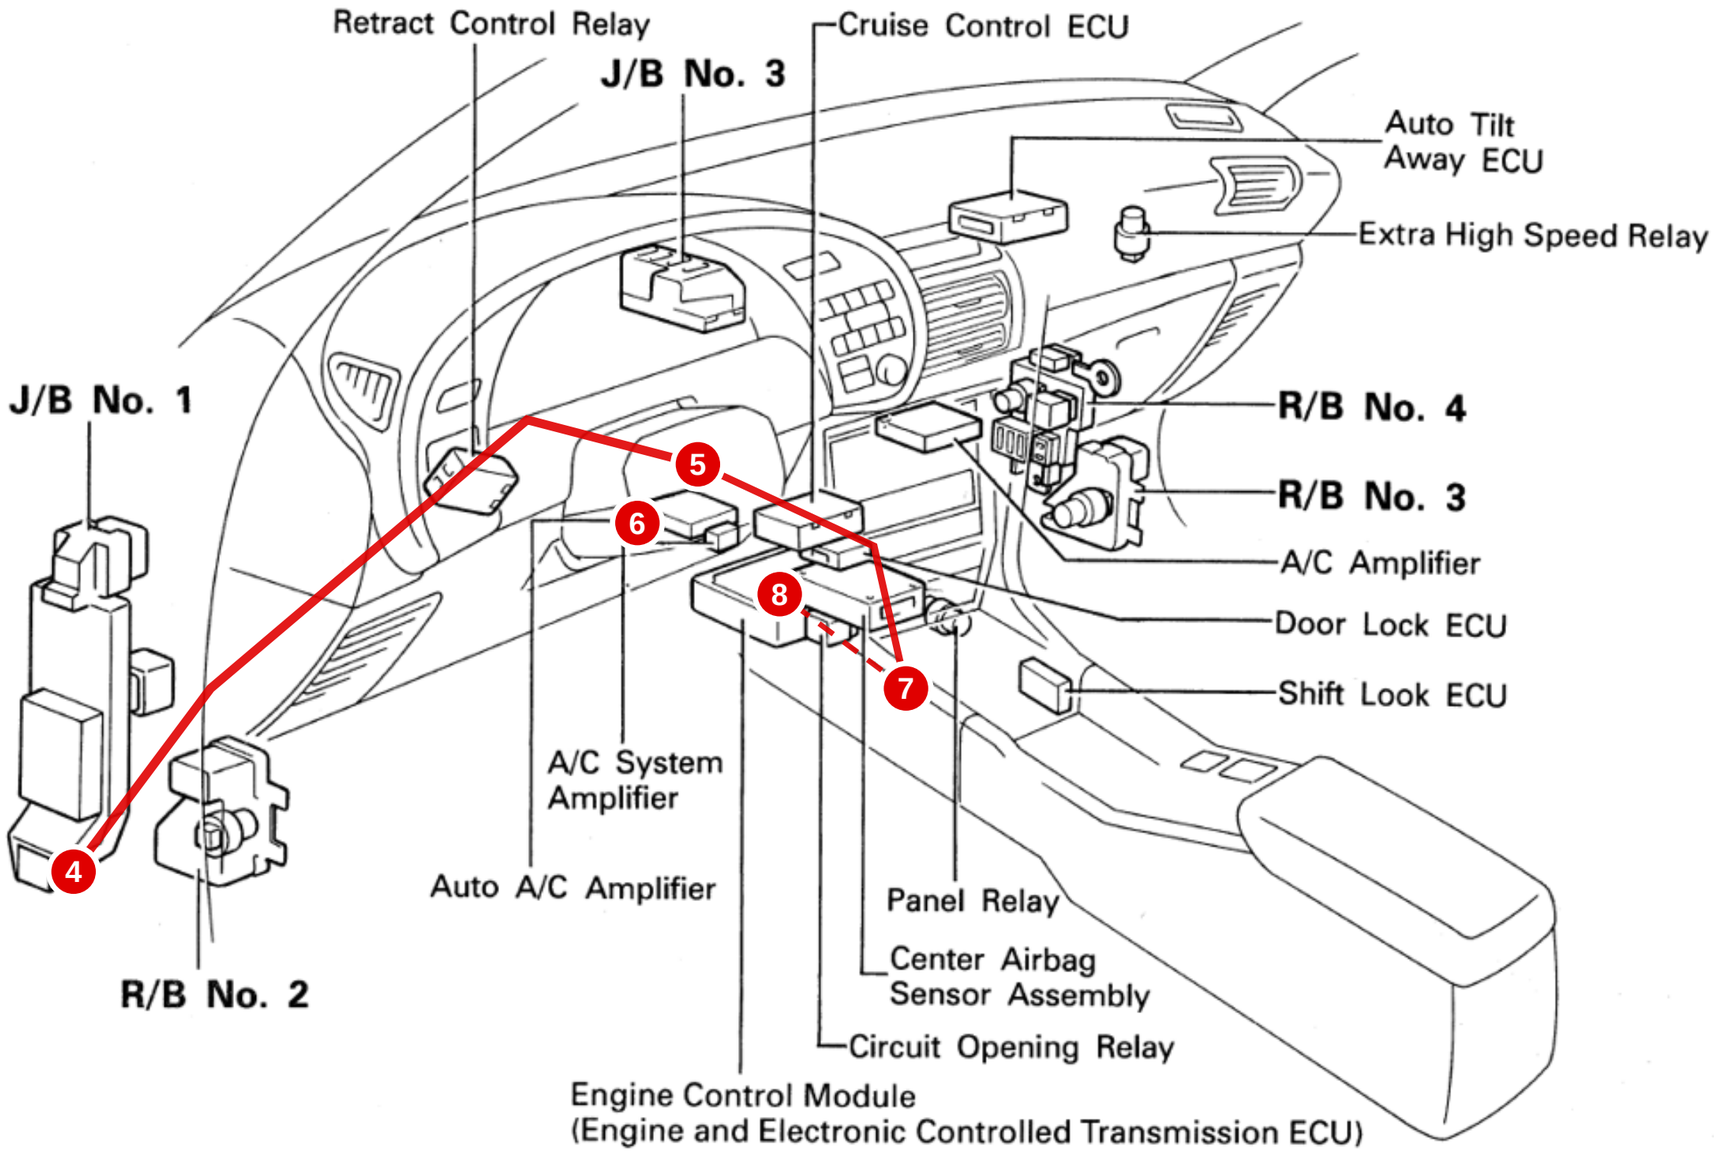

REVISIONS			
REV	DATE	BY	DESCRIPTION
C	2026-10-26	DG	A15 lock-sensor input takes a modified tacho: Ign 8 through 4.7 k· to pin 9 (N61 workaround).
D	2026-10-26	DG	Car-check answers: if the ignition-switch black-orange wire is at the engine plug, remove it; A/C s...
E	2026-10-26	DG	C11 is hardware starter interlock only; Aux 8 spare. Oil LED stays on CSB3 L4.
F	2026-10-26	DG	Each grouped section is its own page. A schematic page holds six wires, each in its own line colo...

ST185-harness - every wiring harness of the car, one drawing set

Layout - ST185-WheelSpeed-Rear - ROUTE-10-WHEELSPEED-REAR


DRAWING NO.	REV	SHEET	SIZE	DRAWN	DATE
ST185-harness-LAY	F	60 OF 65	432 x 279 mm	DG	2026-10-26

ST185 Celica (living-relation) - generated by docs/harness/tools/build_drawings.py from docs/harness/MASTER-wirelist.csv; not to scale

LAYOUT - ST185-WheelSpeed-Rear - ROUTE 10 WHEELSPEED REAR, as approved (4 of 4)

Top view for the figure above · same route, same colors. Projected from the figure above (approximate); this figure·s part is bright, the rest of the route is faded. Blue squares: B = bulkhead A/B (DRB102, RH firewall), R / L = RH / LH fender pass-throughs (Route 9 rev 2). Top view base: 1993 Celica repair manual RM305U1, Introduction, ·Vehicle Lift and Support Locations·, p. IN·24 (st185-celica-repair-manual\manuals\RM305U1 - Introduction - Ve...

DRIVER (LH) SIDE

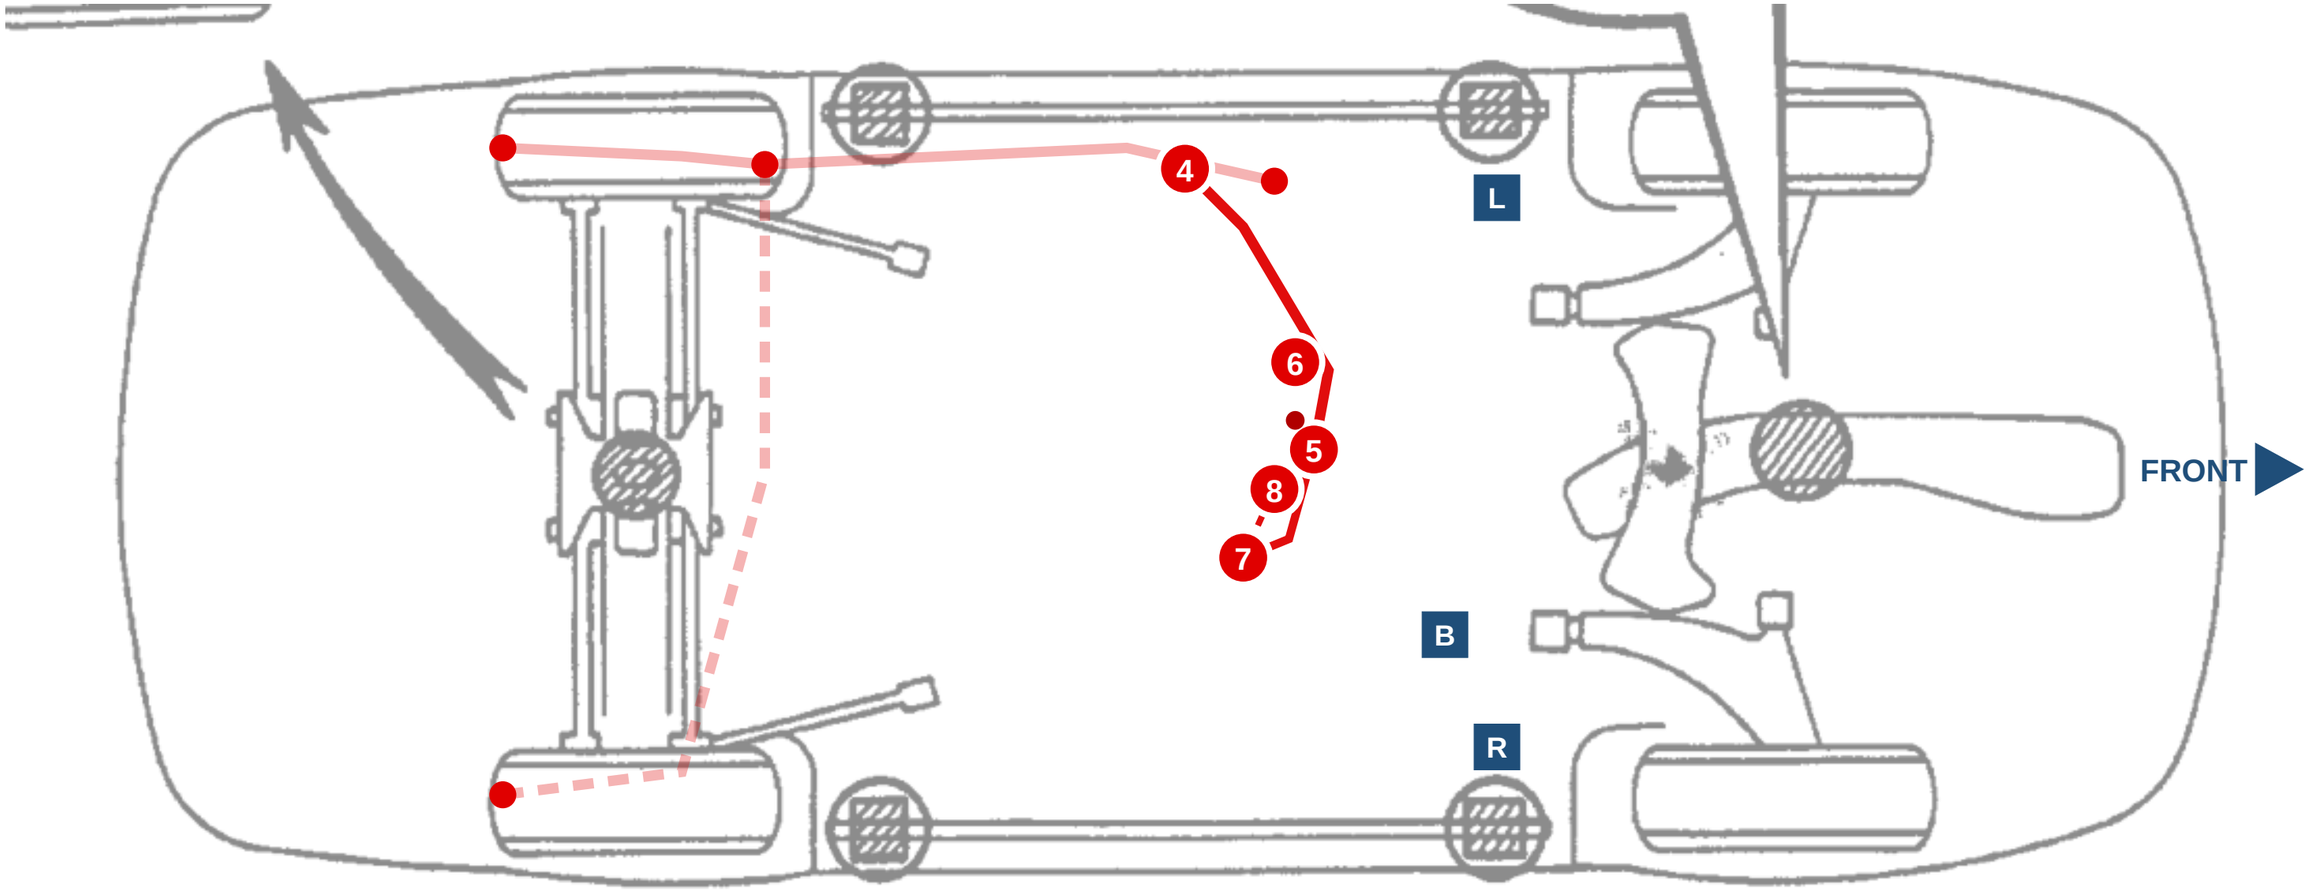

PASSENGER (RH) SIDE

REVISIONS

REV	DATE	BY	DESCRIPTION
C	2026-10-26	DG	A15 lock-sensor input takes a modified tacho: Ign 8 through 4.7 k· to pin 9 (N61 workaround).
D	2026-10-26	DG	Car-check answers: if the ignition-switch black-orange wire is at the engine plug, remove it; A/C s...
E	2026-10-26	DG	C11 is hardware starter interlock only; Aux 8 spare. Oil LED stays on CSB3 L4.
F	2026-10-26	DG	Each grouped section is its own page. A schematic page holds six wires, each in its own line colo...


ST185-harness - every wiring harness of the car, one drawing set

Layout - ST185-WheelSpeed-Rear - ROUTE-10-WHEELSPEED-REAR

DRAWING NO.	REV	SHEET	SIZE	DRAWN	DATE
ST185-harness-LAY	F	61 OF 65	432 x 279 mm	DG	2026-10-26

LAYOUT - ST185-RearFuel - ROUTE 11 REARFUEL, as approved (1 of 4)

Fig. 1 · Instrument panel, TIS 1993 EWD ·Relay Locations· p.18 (tis1993-relay-locations.pdf, sheet 1). Driver side left, glove box right. Deleted parts still drawn on this page are not used. Dashed = the runs that leave the dash for the rear but belong to other harnesses: the fuel level lead B24 and the k_fp coil · wire A19 (both from the ECU; B-cabin Route 6 / A-cabin Route 5) and the k_fp coil + wire SW12 (CabinPower, Route 7), all leaving down th...

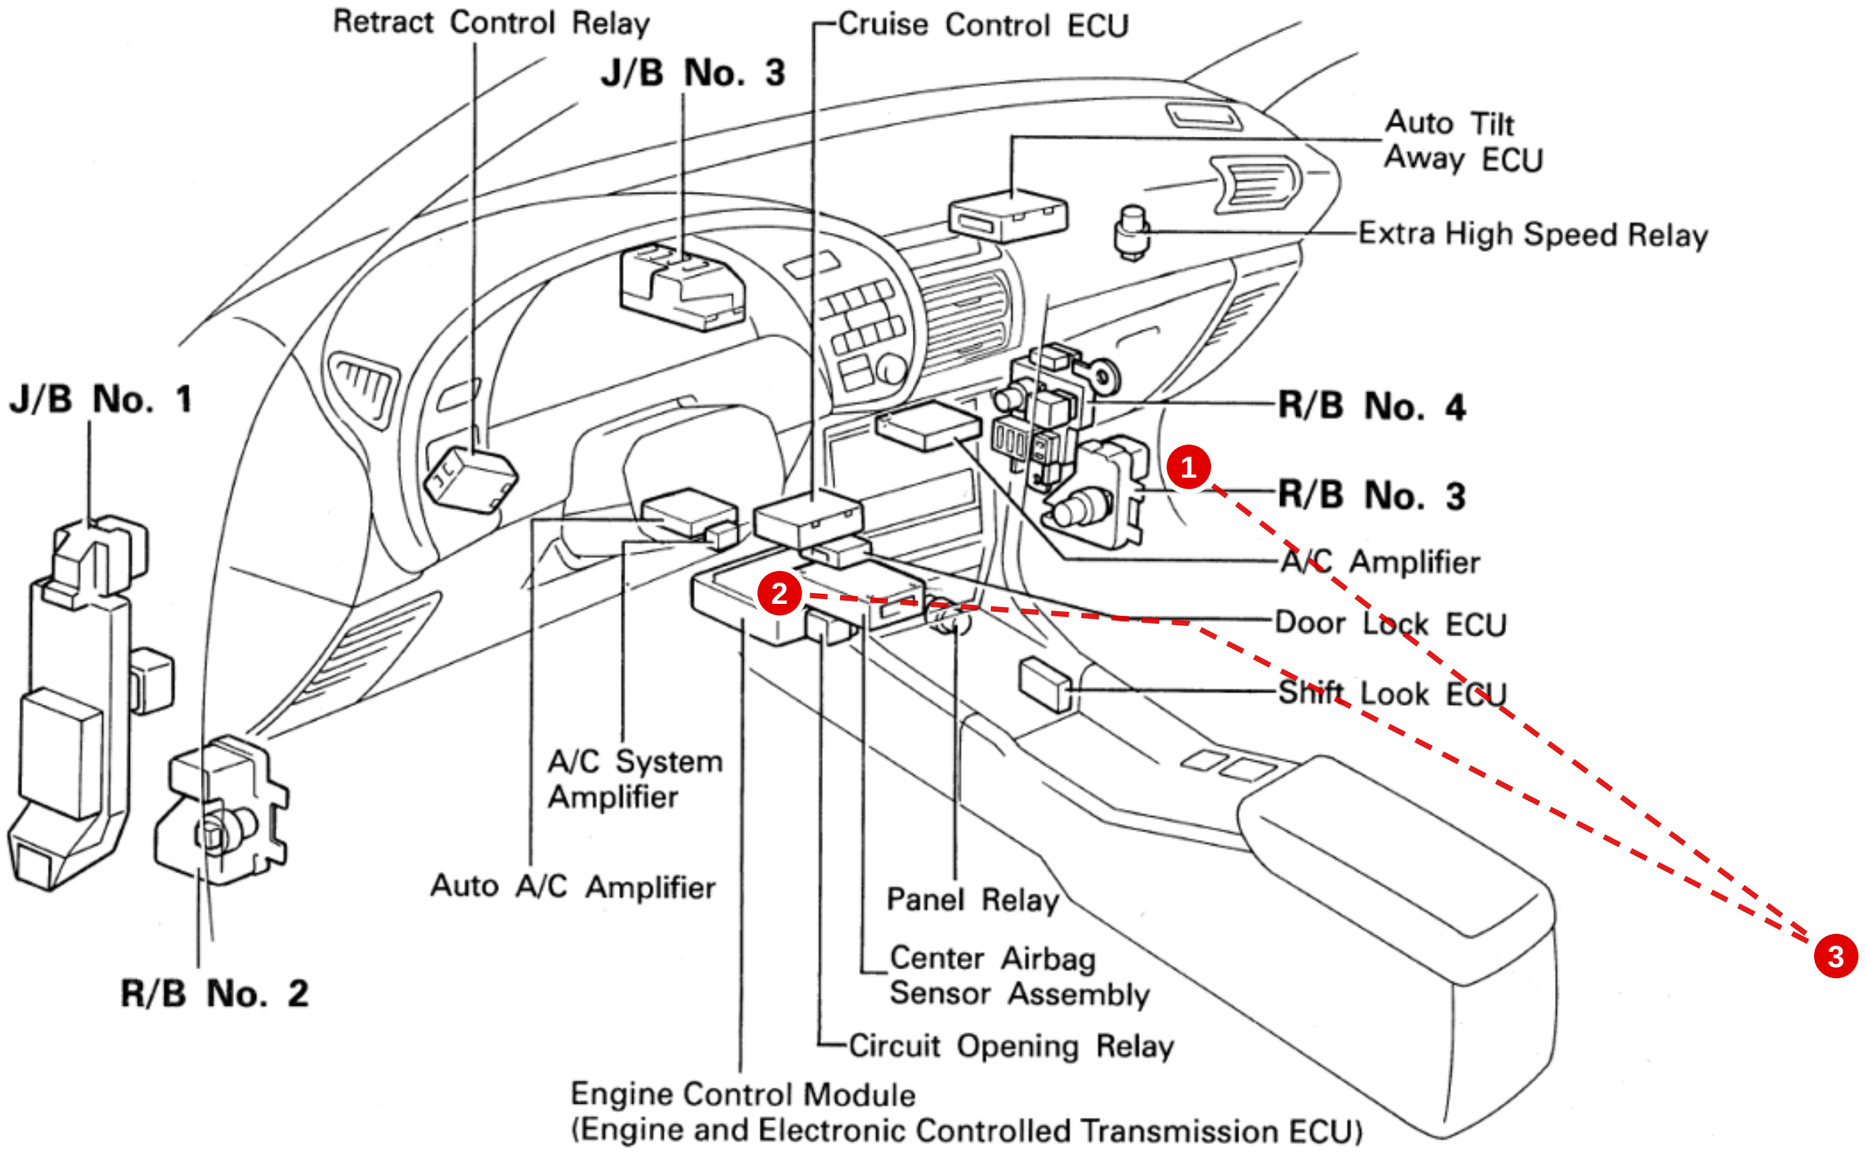

REVISIONS			
REV	DATE	BY	DESCRIPTION
C	2026-10-26	DG	A15 lock-sensor input takes a modified tacho: Ign 8 through 4.7 k· to pin 9 (N61 workaround).
D	2026-10-26	DG	Car-check answers: if the ignition-switch black-orange wire is at the engine plug, remove it; A/C s...
E	2026-10-26	DG	C11 is hardware starter interlock only; Aux 8 spare. Oil LED stays on CSB3 L4.
F	2026-10-26	DG	Each grouped section is its own page. A schematic page holds six wires, each in its own line colo...

ST185-harness - every wiring harness of the car, one drawing set


Layout - ST185-RearFuel - ROUTE-11-REARFUEL

DRAWING NO.	REV	SHEET	SIZE	DRAWN	DATE
ST185-harness-LAY	F	62 OF 65	432 x 279 mm	DG	2026-10-26

ST185 Celica (living-relation) - generated by docs/harness/tools/build_drawings.py from docs/harness/MASTER-wirelist.csv; not to scale

LAYOUT - ST185-RearFuel - ROUTE 11 REARFUEL, as approved (2 of 4)

Top view for the figure above · same route, same colors. Projected from the figure above (approximate); this figure·s part is bright, the rest of the route is faded. Blue squares: B = bulkhead A/B (DRB102, RH firewall), R / L = RH / LH fender pass-throughs (Route 9 rev 2). Top view base: 1993 Celica repair manual RM305U1, Introduction, ·Vehicle Lift and Support Locations·, p. IN·24 (st185-celica-repair-manual\manuals\RM305U1 - Introduction - Ve...

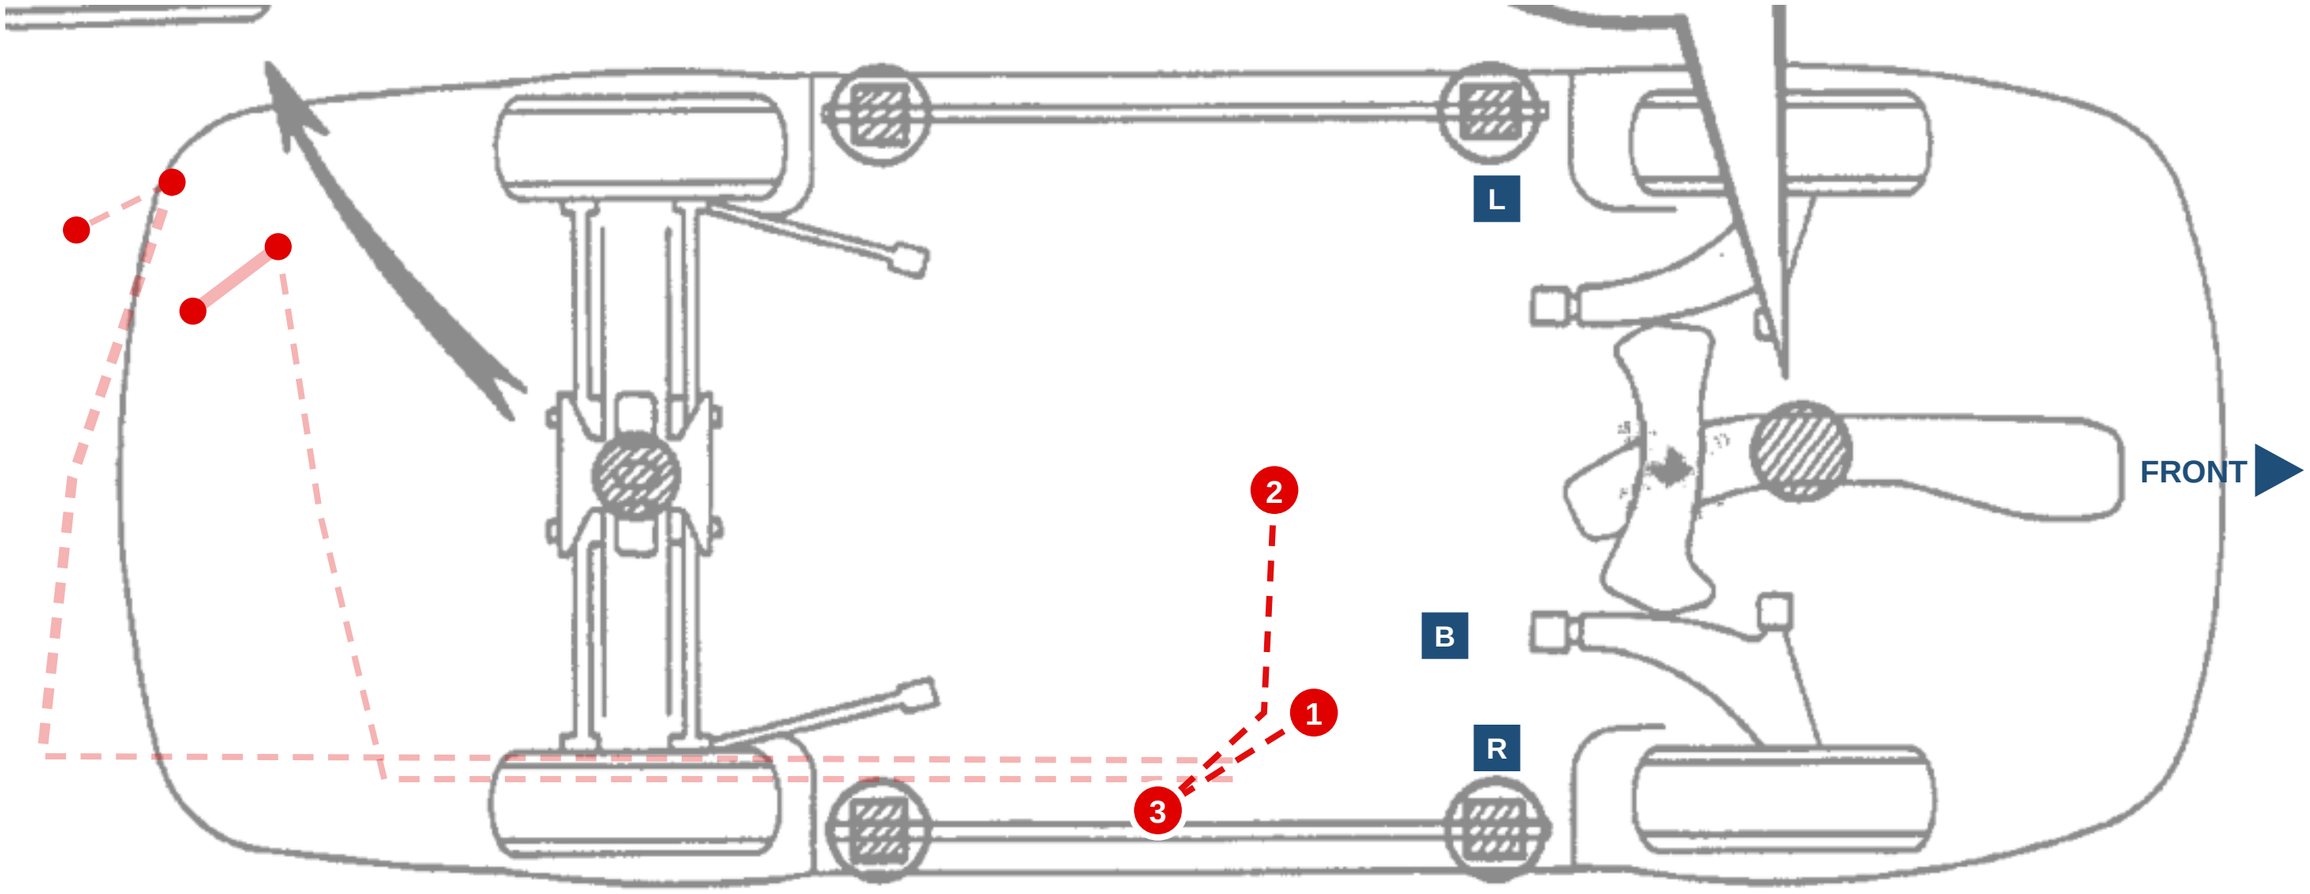

REVISIONS

REV	DATE	BY	DESCRIPTION
C	2026-10-26	DG	A15 lock-sensor input takes a modified tacho: Ign 8 through 4.7 k· to pin 9 (N61 workaround).
D	2026-10-26	DG	Car-check answers: if the ignition-switch black-orange wire is at the engine plug, remove it; A/C s...
E	2026-10-26	DG	C11 is hardware starter interlock only; Aux 8 spare. Oil LED stays on CSB3 L4.
F	2026-10-26	DG	Each grouped section is its own page. A schematic page holds six wires, each in its own line colo...


ST185-harness - every wiring harness of the car, one drawing set

Layout - ST185-RearFuel - ROUTE-11-REARFUEL

DRAWING NO.	REV	SHEET	SIZE	DRAWN	DATE
ST185-harness-LAY	F	63 OF 65	432 x 279 mm	DG	2026-10-26

LAYOUT - ST185-RearFuel - ROUTE 11 REARFUEL, as approved (3 of 4)

Fig. 2 · Body, liftback, TIS 1993 EWD p.46 (tis1993-wiring-routing-2.pdf, sheet 11). Car front on the left; the near side is the driver side, so the passenger-side runs are on the far side (drawn approximately). Red solid = RearFuel itself: the short lead from IX_FUEL_LVL (4) to the fuel level sender (5). Dashed = the fuel level lead (B-cabin) and the k_fp coil wires (Route 7, Route 5) coming down the passenger side, and the pump feed (HeavyD...

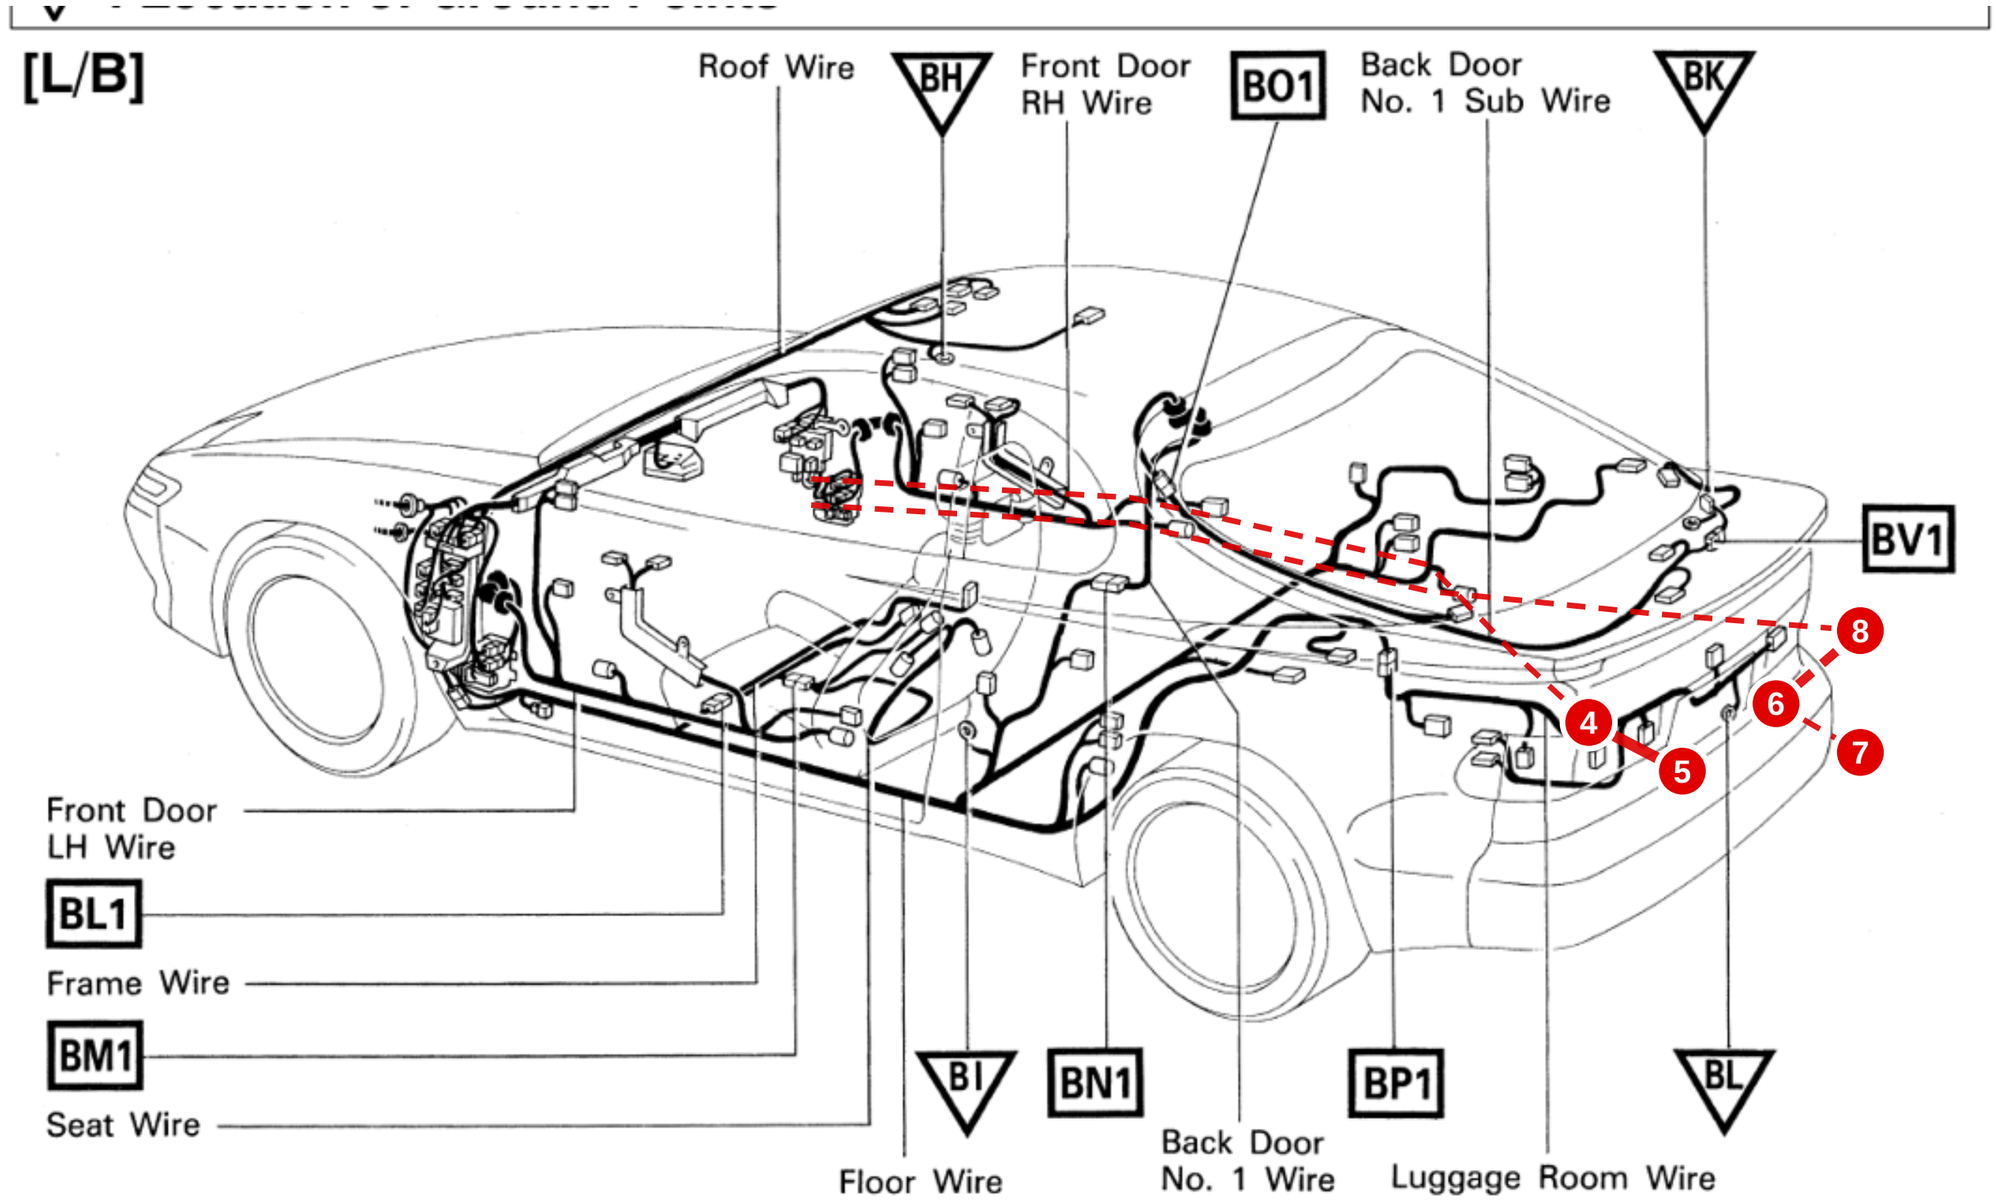

REVISIONS

REV	DATE	BY	DESCRIPTION
C	2026-10-26	DG	A15 lock-sensor input takes a modified tacho: Ign 8 through 4.7 k· to pin 9 (N61 workaround).
D	2026-10-26	DG	Car-check answers: if the ignition-switch black-orange wire is at the engine plug, remove it; A/C s...
E	2026-10-26	DG	C11 is hardware starter interlock only; Aux 8 spare. Oil LED stays on CSB3 L4.
F	2026-10-26	DG	Each grouped section is its own page. A schematic page holds six wires, each in its own line colo...

ST185-harness - every wiring harness of the car, one drawing set

Layout - ST185-RearFuel - ROUTE-11-REARFUEL


DRAWING NO.	REV	SHEET	SIZE	DRAWN	DATE
ST185-harness-LAY	F	64 OF 65	432 x 279 mm	DG	2026-10-26

ST185 Celica (living-relation) - generated by docs/harness/tools/build_drawings.py from docs/harness/MASTER-wirelist.csv; not to scale

LAYOUT - ST185-RearFuel - ROUTE 11 REARFUEL, as approved (4 of 4)

Top view for the figure above · same route, same colors. Drawn to match the figure above (approximate); this figure·s part is bright, the rest of the route is faded. Blue squares: B = bulkhead A/B (DRB102, RH firewall), R / L = RH / LH fender pass-throughs (Route 9 rev 2). Top view base: 1993 Celica repair manual RM305U1, Introduction, ·Vehicle Lift and Support Locations·, p. IN·24 (st185-celica-repair-manual\manuals\RM305U1 - Introduction - V...

DRIVER (LH) SIDE

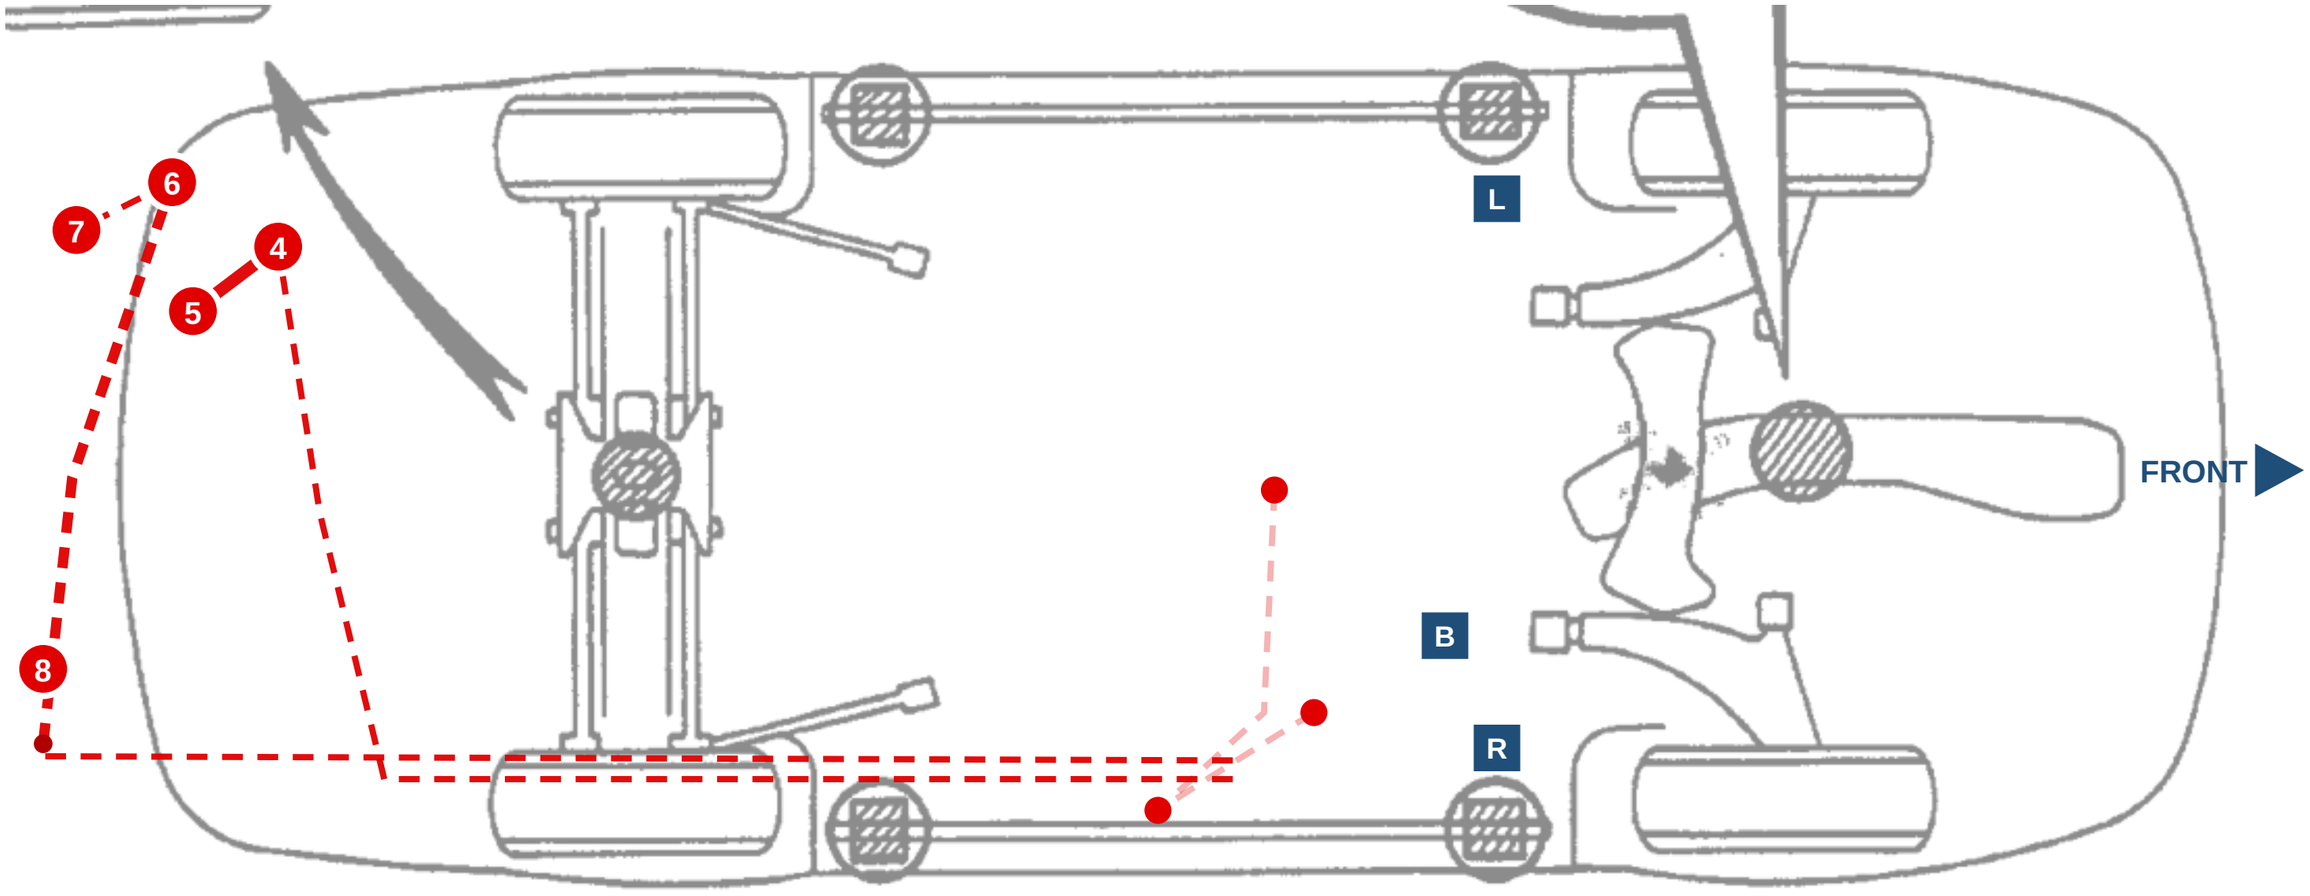

PASSENGER (RH) SIDE

REVISIONS

REV	DATE	BY	DESCRIPTION
C	2026-10-26	DG	A15 lock-sensor input takes a modified tacho: Ign 8 through 4.7 k· to pin 9 (N61 workaround).
D	2026-10-26	DG	Car-check answers: if the ignition-switch black-orange wire is at the engine plug, remove it; A/C s...
E	2026-10-26	DG	C11 is hardware starter interlock only; Aux 8 spare. Oil LED stays on CSB3 L4.
F	2026-10-26	DG	Each grouped section is its own page. A schematic page holds six wires, each in its own line colo...

ST185-harness - every wiring harness of the car, one drawing set

Layout - ST185-RearFuel - ROUTE-11-REARFUEL

DRAWING NO.	REV	SHEET	SIZE	DRAWN	DATE
ST185-harness-LAY	F	65 OF 65	432 x 279 mm	DG	2026-10-26